



| FED. ROAD DIST. NO. | STATE | PROJ. NO.   | FISCAL YEAR | SHEET NO. | TOTAL SHEETS |
|---------------------|-------|-------------|-------------|-----------|--------------|
| HAWAII              | HAW.  | 360AB-01-84 | 1984        | 3         | 29           |

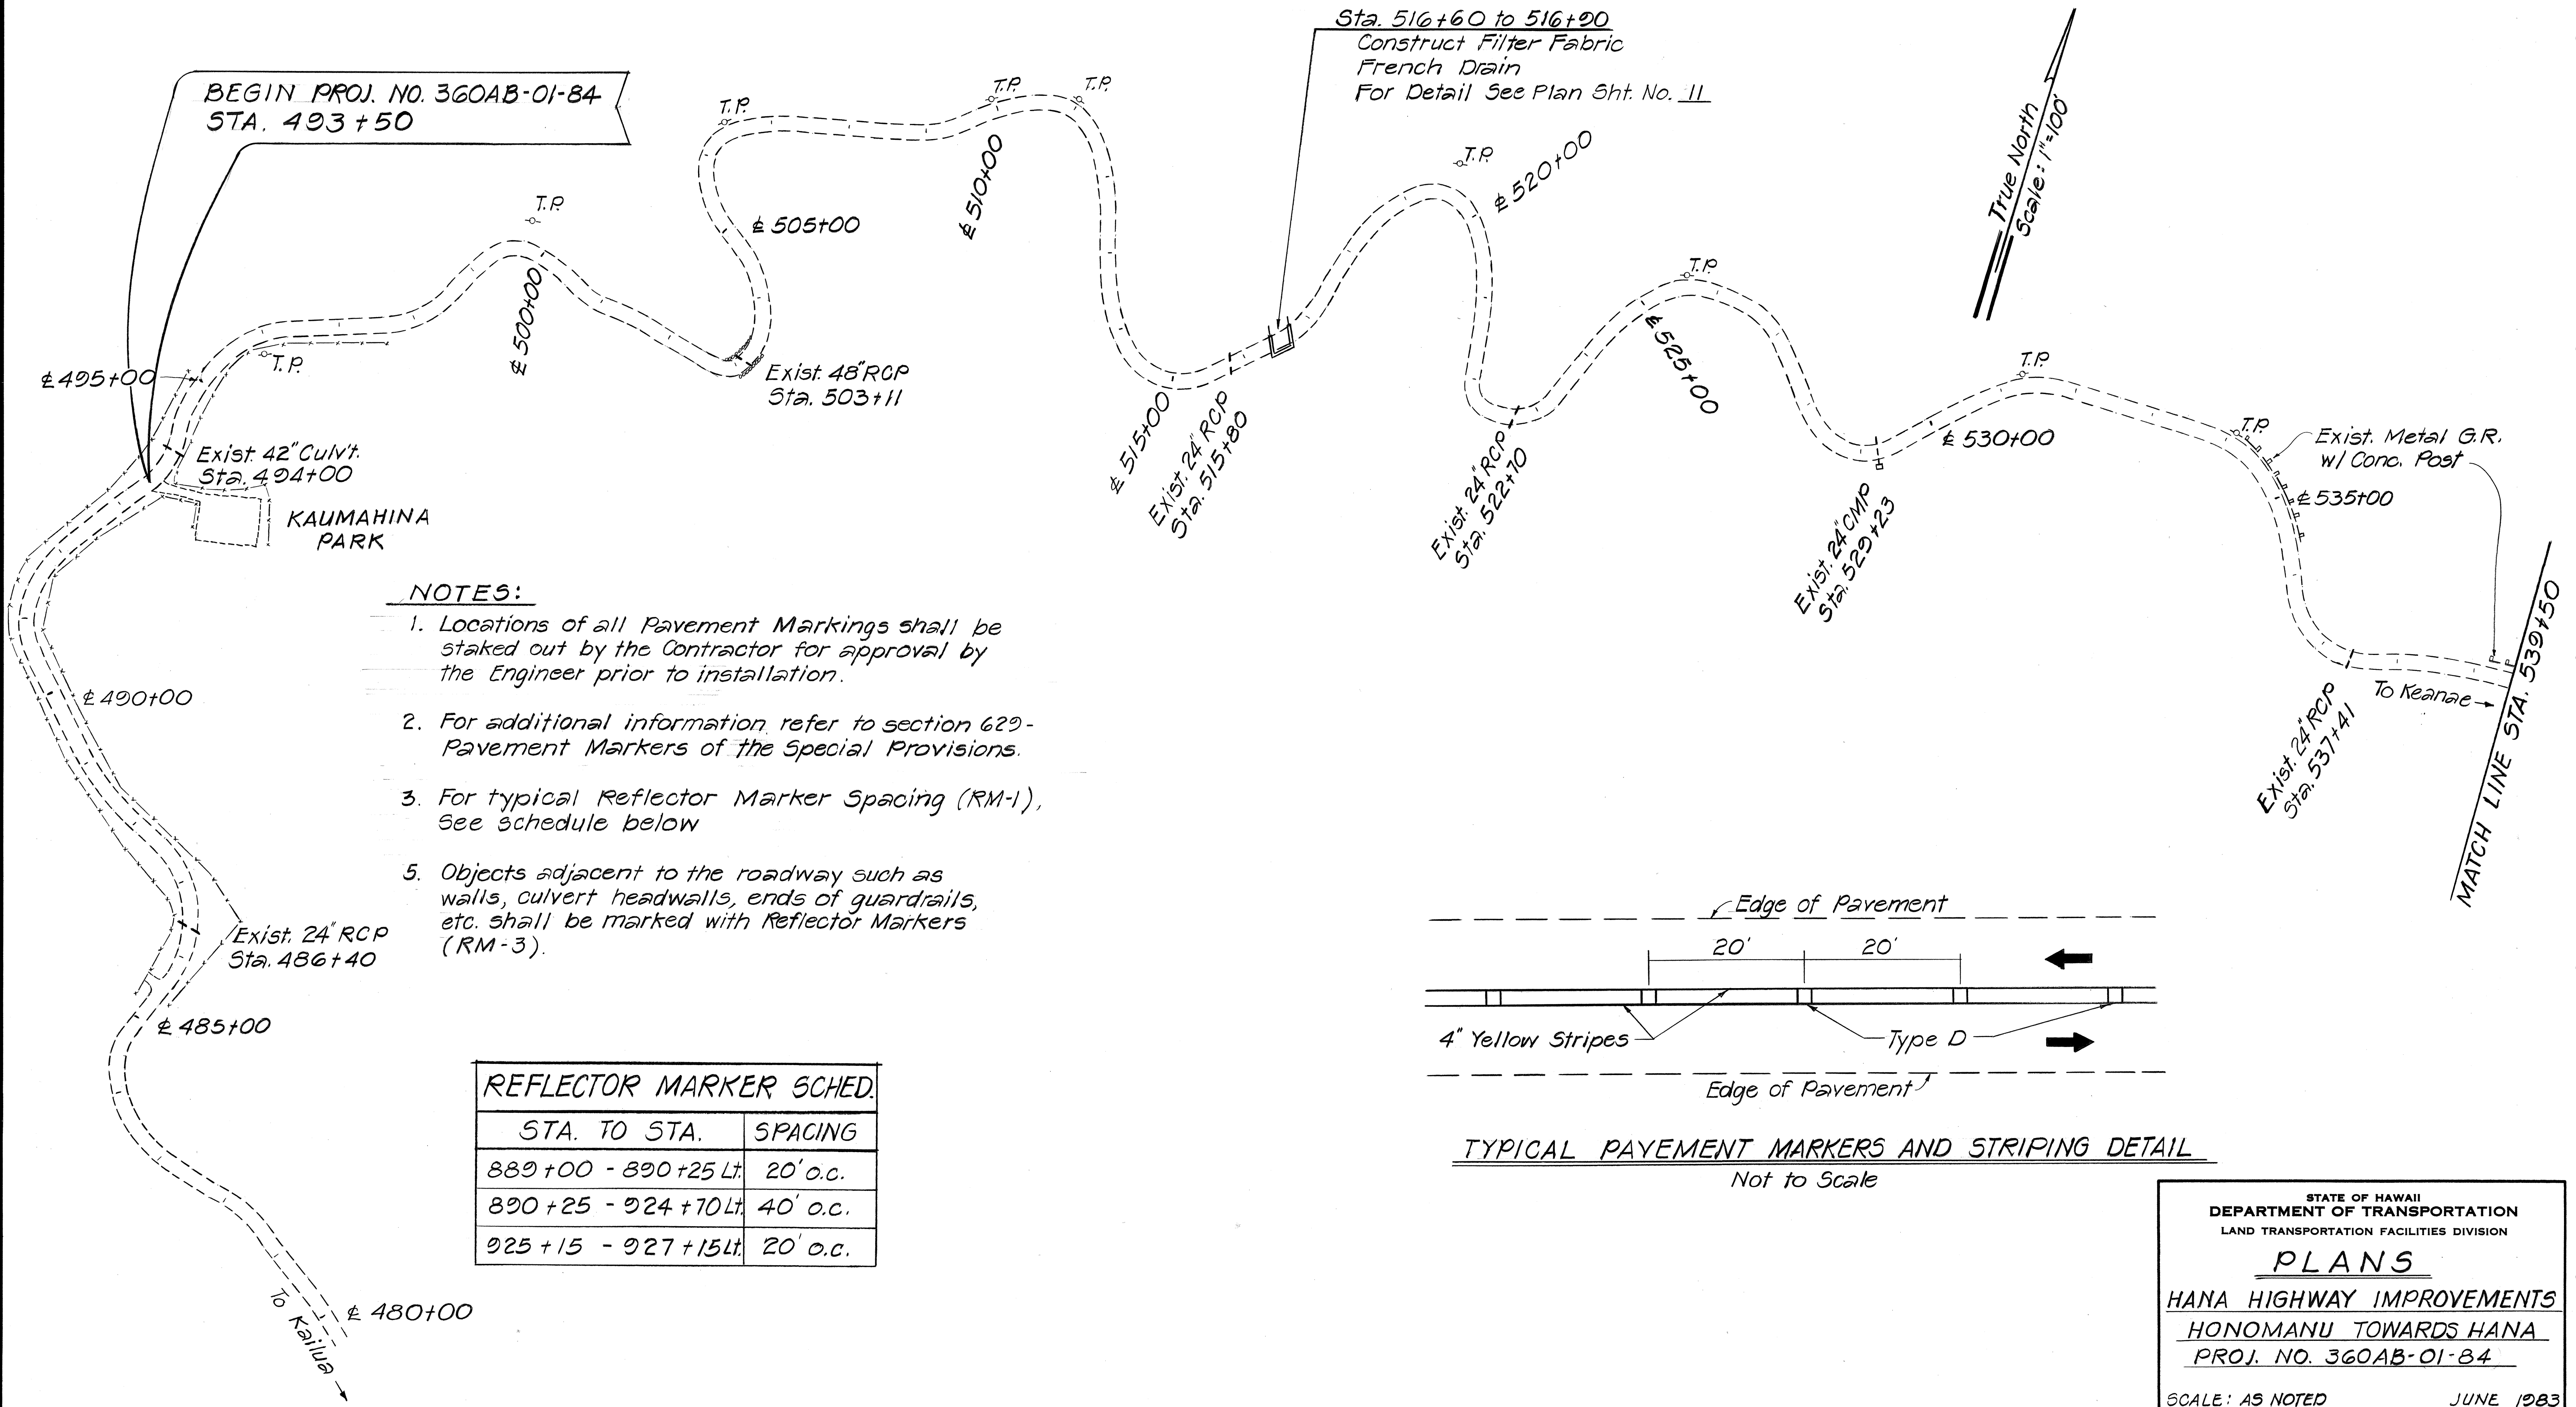

**NOTES:**

1. Locations of all Pavement Markings shall be staked out by the Contractor for approval by the Engineer prior to installation.
2. For additional information refer to section 629- Pavement Markers of the Special Provisions.
3. For typical Reflector Marker Spacing (RM-1), See schedule below
5. Objects adjacent to the roadway such as walls, culvert headwalls, ends of guardrails, etc. shall be marked with Reflector Markers (RM-3).

| REFLECTOR MARKER SCHED. |          |  |
|-------------------------|----------|--|
| STA. TO STA.            | SPACING  |  |
| 889+00 - 890+25 Lt.     | 20' o.c. |  |
| 890+25 - 924+70 Lt.     | 40' o.c. |  |
| 925+15 - 927+15 Lt.     | 20' o.c. |  |

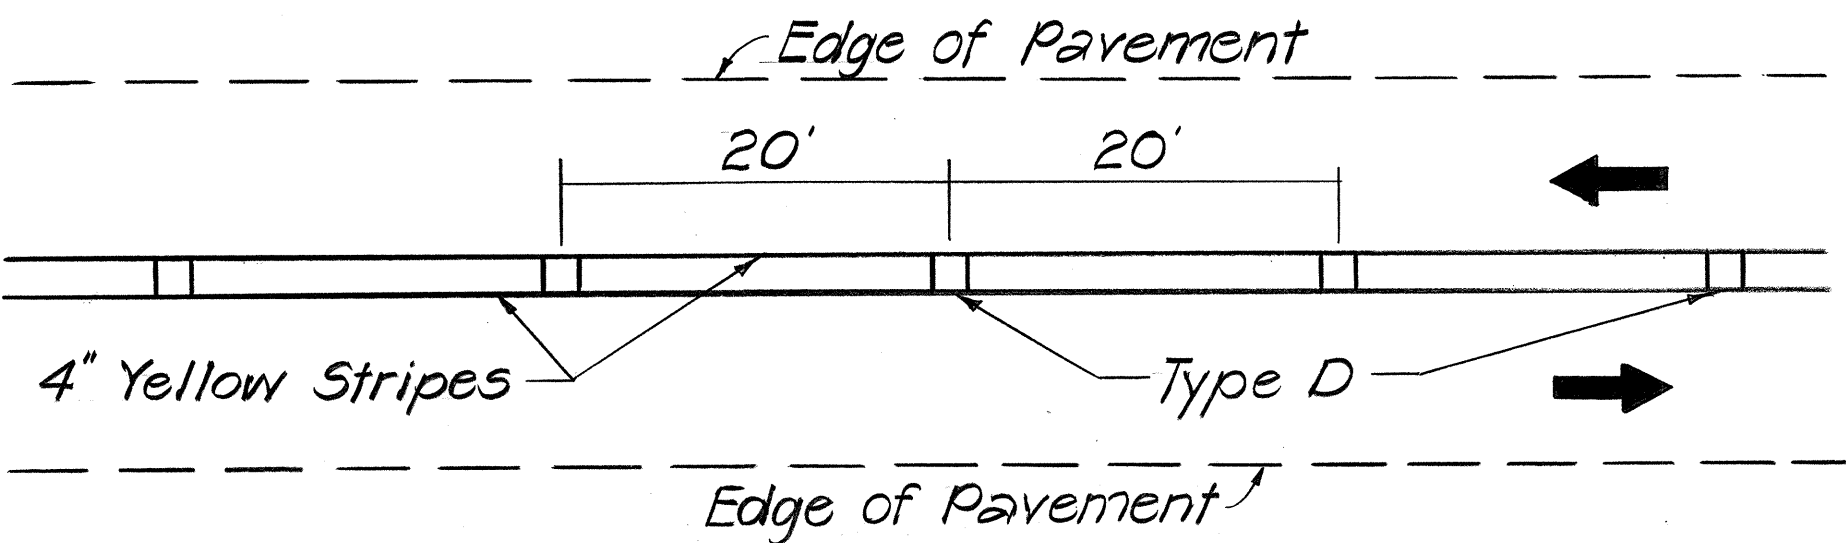

**TYPICAL PAVEMENT MARKERS AND STRIPING DETAIL**  
Not to Scale


STATE OF HAWAII  
DEPARTMENT OF TRANSPORTATION  
LAND TRANSPORTATION FACILITIES DIVISION

**PLANS**  
HANA HIGHWAY IMPROVEMENTS  
HONOMANU TOWARDS HANA  
PROJ. NO. 360AB-01-84  
SCALE: AS NOTED  
JUNE 1983

SHEET NO. 1 OF 4 SHEETS

|                   |       |
|-------------------|-------|
| DATE              | _____ |
| SURVEY PLOTTED BY | _____ |
| DESIGNED BY       | _____ |
| QUANTITIES BY     | _____ |
| CHECKED BY        | _____ |
| NOTE BOOK         | _____ |
| NO.               | _____ |

| FED. ROAD DIST. NO. | STATE | PROJ. NO.   | FISCAL YEAR | SHEET NO. | TOTAL SHEETS |
|---------------------|-------|-------------|-------------|-----------|--------------|
| HAWAII              | HAW.  | 360AB-01-84 | 1984        | 4         | 29           |

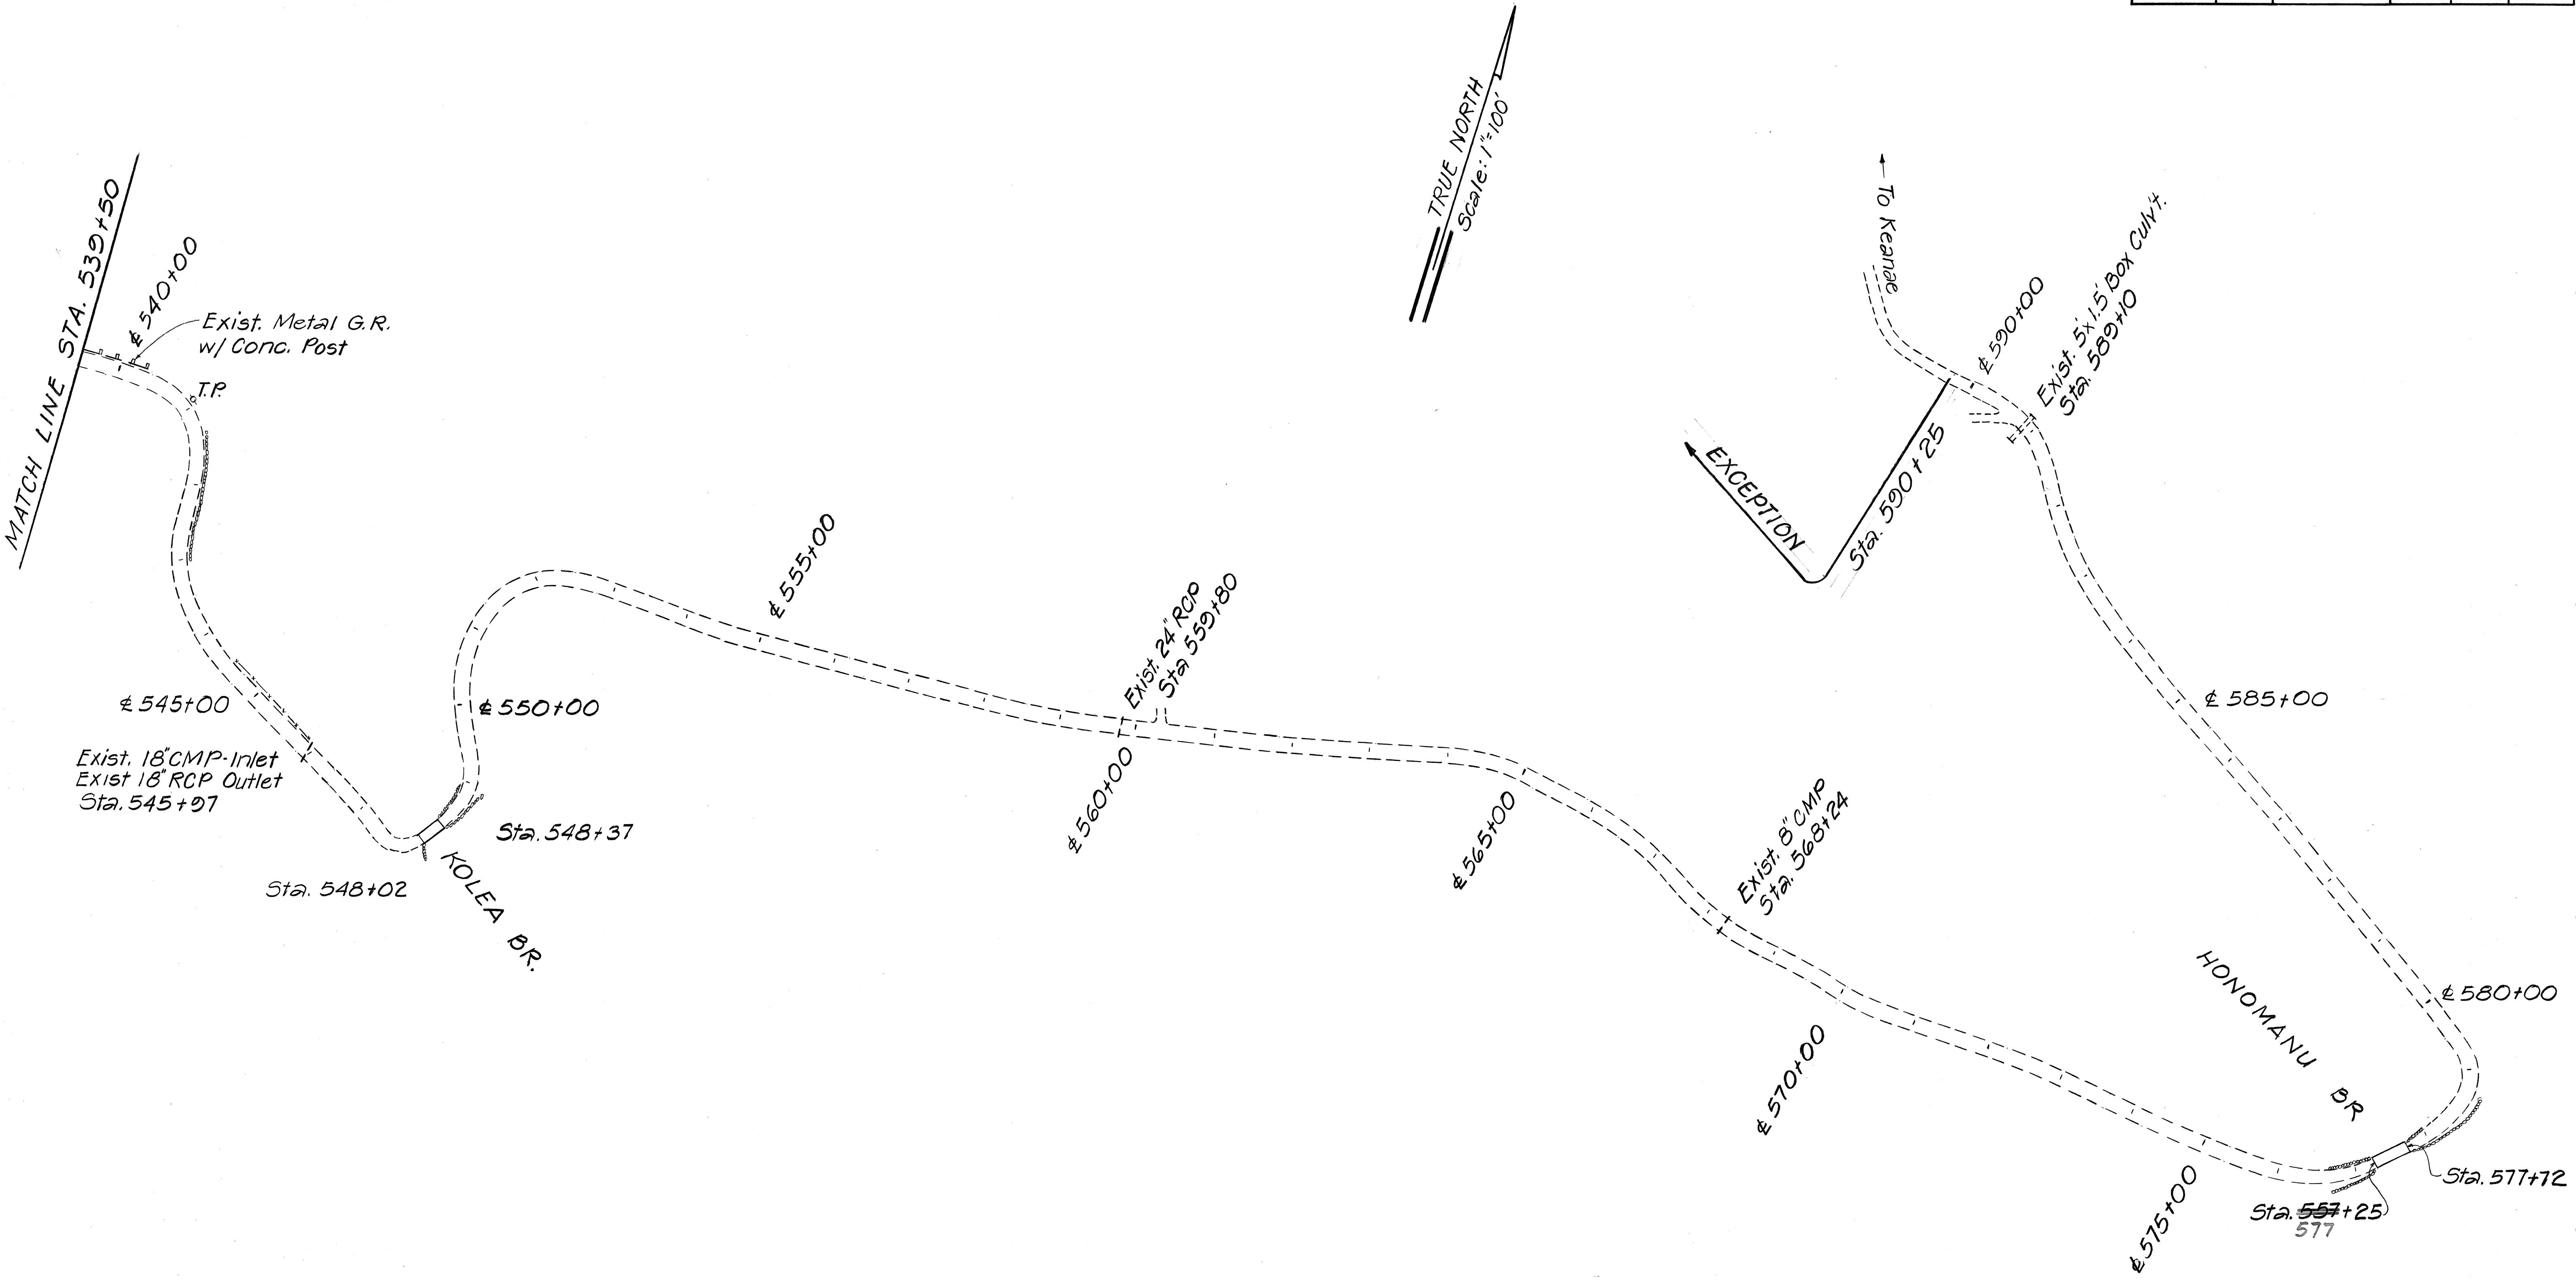

TRUE NORTH  
Scale: 1"=100'

EXCEPTION

To Keanae

HONOMANU BR

STATE OF HAWAII  
DEPARTMENT OF TRANSPORTATION  
LAND TRANSPORTATION FACILITIES DIVISION


### PLANS

HANA HIGHWAY IMPROVEMENTS  
HONOMANU TOWARDS HANA  
PROJ. NO. 360AB-01-84

SCALE: AS NOTED  
JUNE 1983  
SHEET NO. 2 OF 4 SHEETS

|               |      |
|---------------|------|
| ORIGINAL PLAN | DATE |
| DESIGNED BY   |      |
| NOTED BY      |      |
| CHECKED BY    |      |

| FED. ROAD DIST. NO. | STATE | PROJ. NO.   | FISCAL YEAR | SHEET NO. | TOTAL SHEETS |
|---------------------|-------|-------------|-------------|-----------|--------------|
| HAWAII              | HAW.  | 360AB-01-84 | 1984        | 5         | 29           |

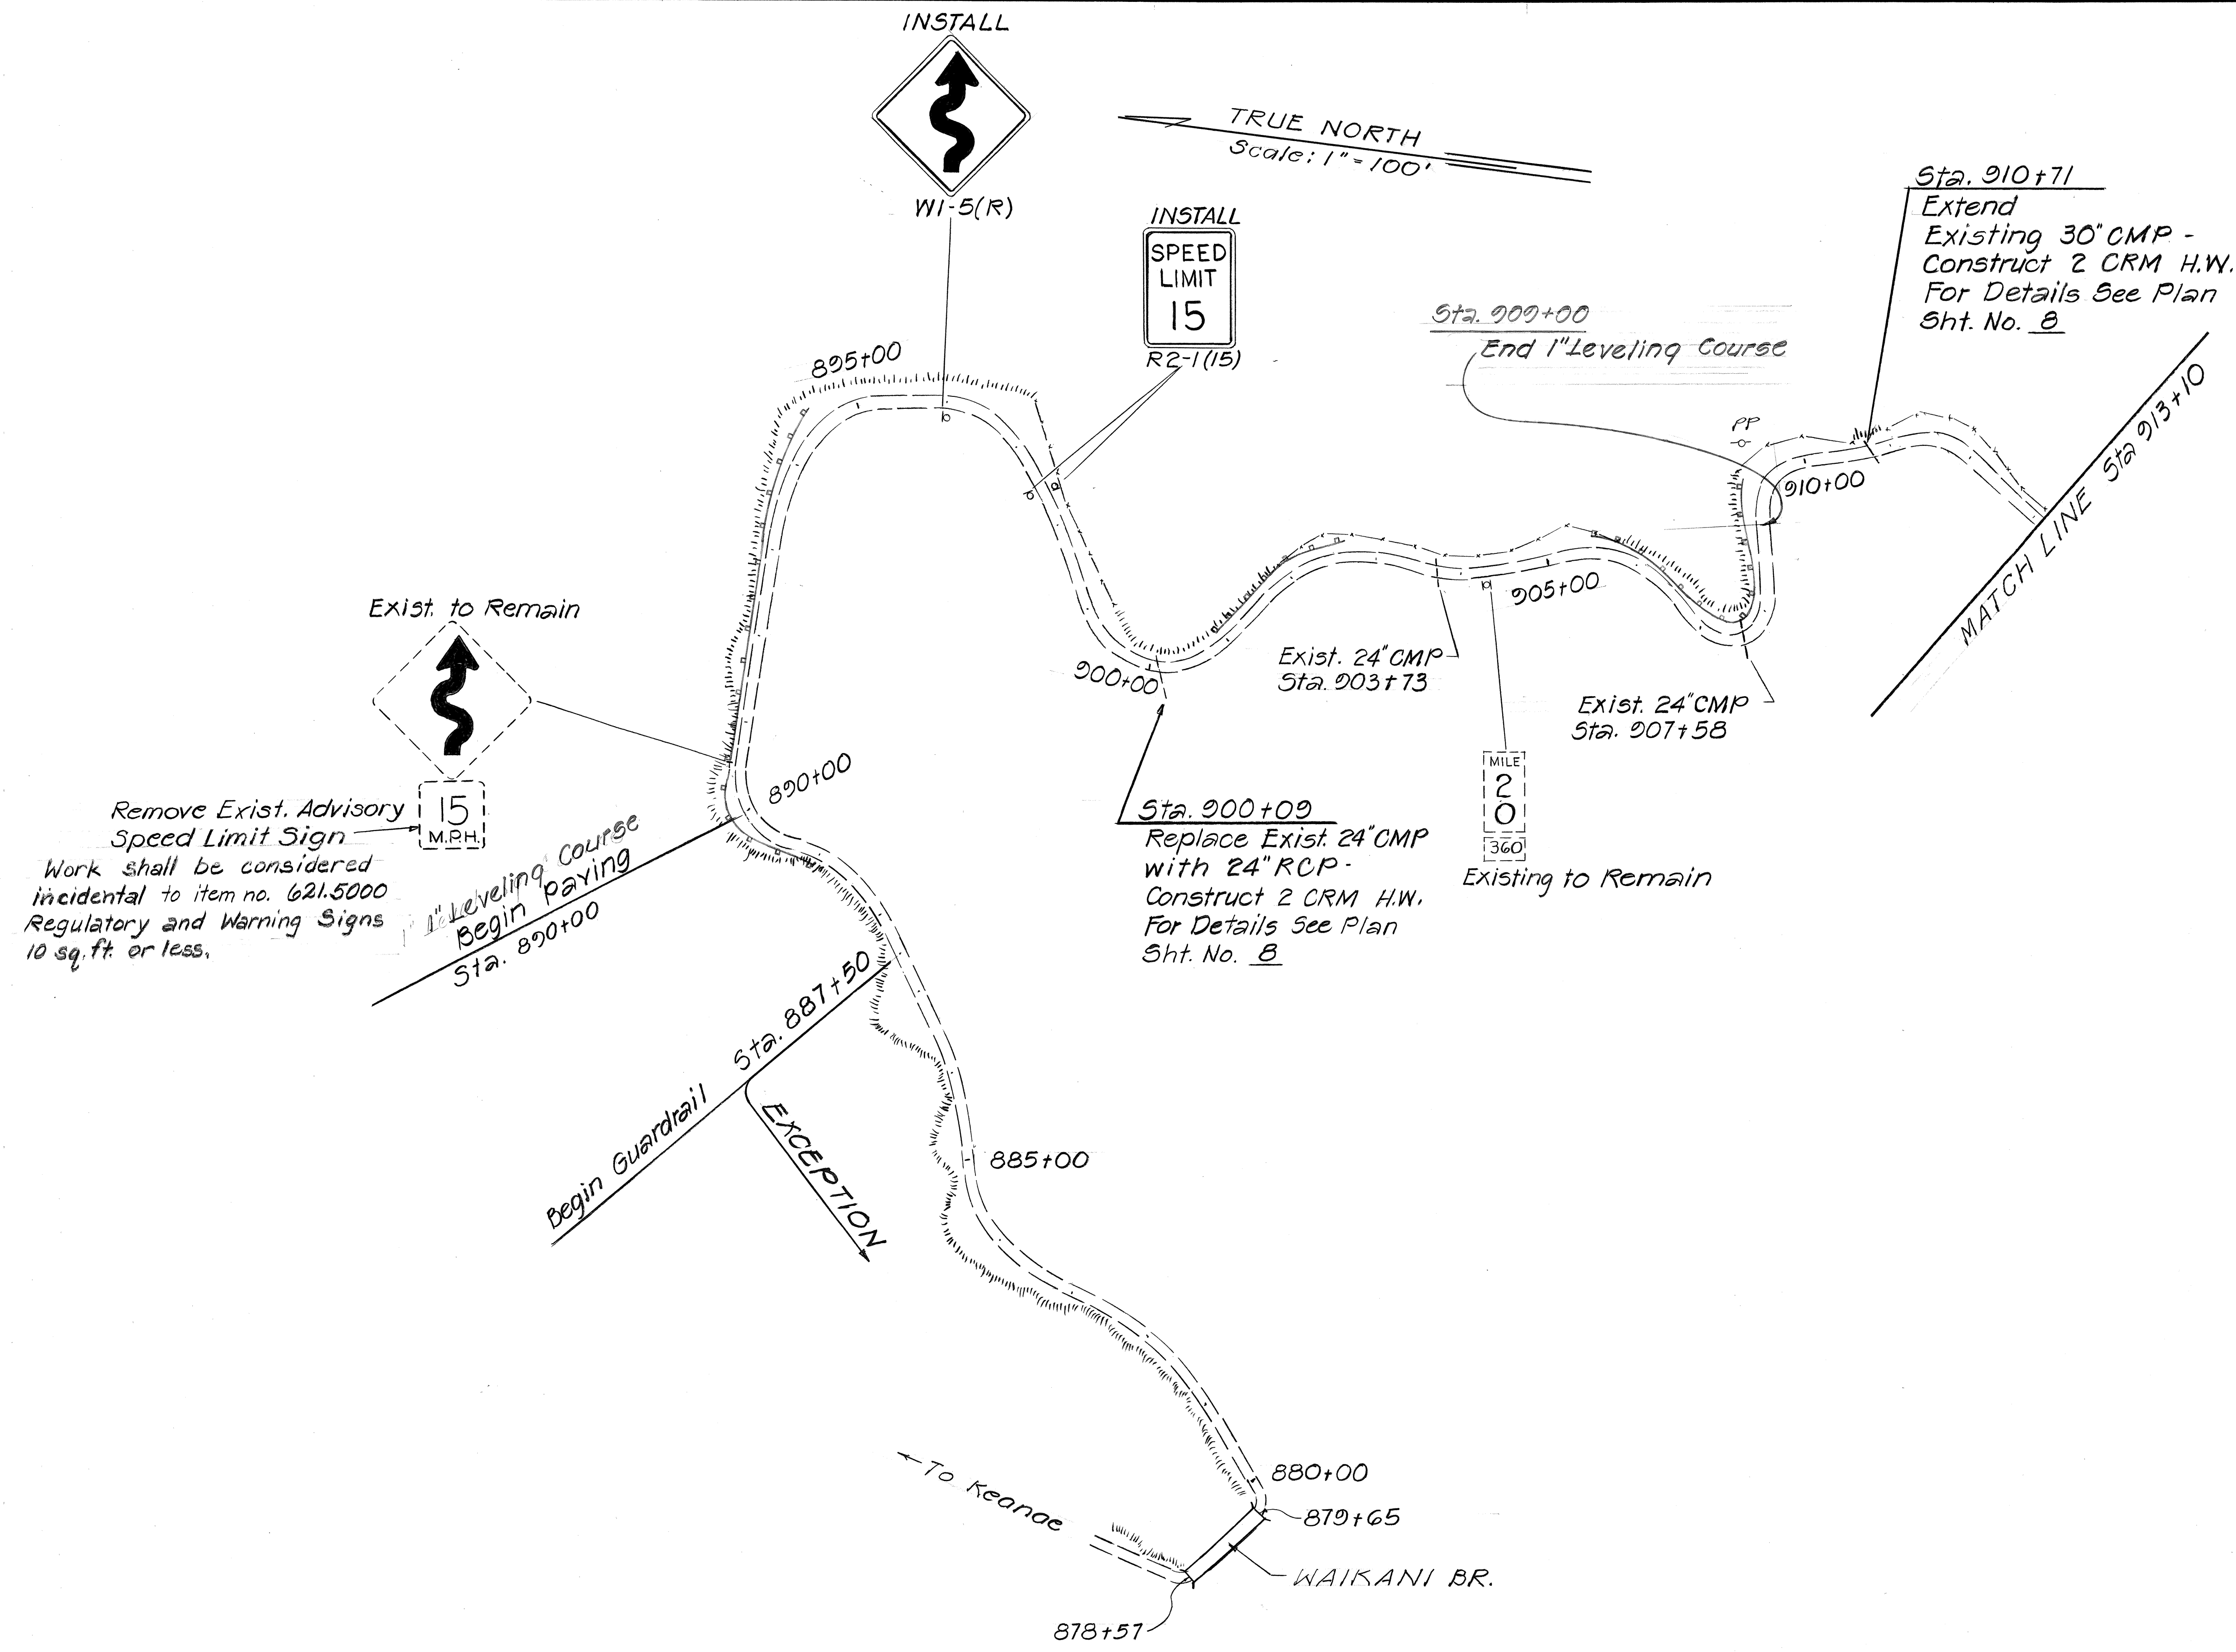

STATE OF HAWAII  
DEPARTMENT OF TRANSPORTATION  
LAND TRANSPORTATION FACILITIES DIVISION


**PLANS**

HANA HIGHWAY IMPROVEMENTS  
HONOMANU TOWARDS HANA  
PROJ. NO. 360AB-01-84

SCALE: AS NOTED JUNE 1983  
SHEET No. 3 OF 4 SHEETS

|               |      |
|---------------|------|
| ORIGINAL PLAN | DATE |
| DESIGNED BY   |      |
| TRACED BY     |      |
| QUANTITIES BY |      |
| CHECKED BY    |      |
| NO.           |      |

| FED. ROAD DIST. NO. | STATE | PROJ. NO.   | FISCAL YEAR | SHEET NO. | TOTAL SHEETS |
|---------------------|-------|-------------|-------------|-----------|--------------|
| HAWAII              | HAW.  | 360AB-01-84 | 1984        | 6         | 29           |

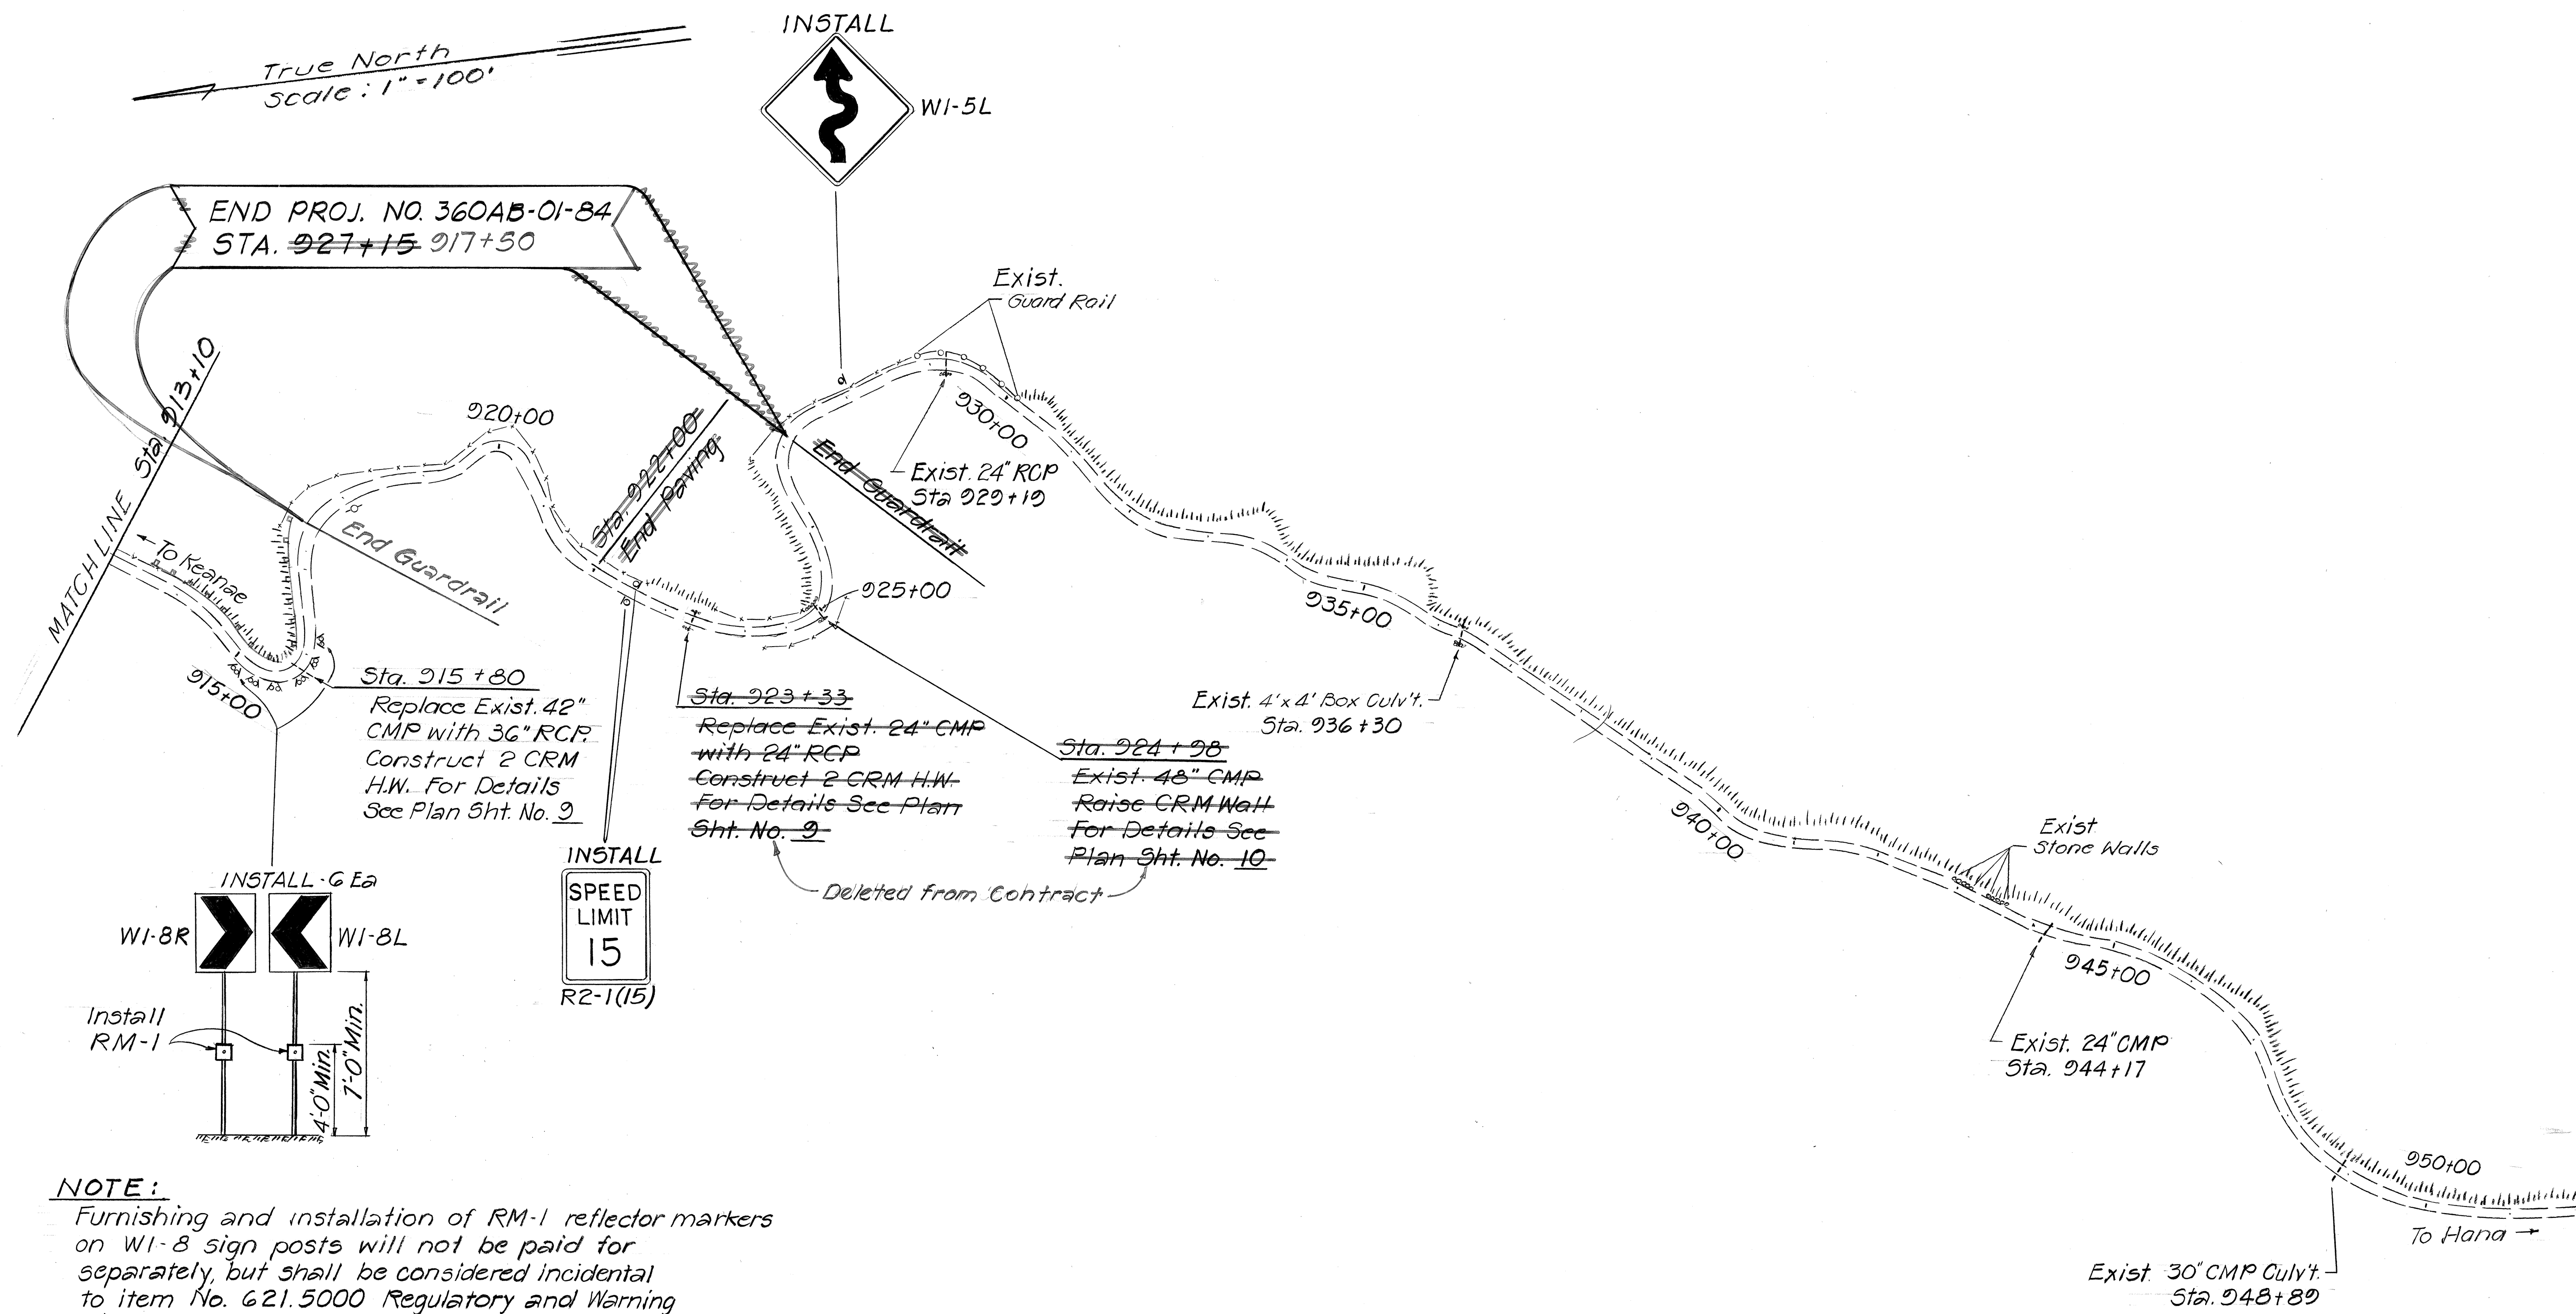

**NOTE:**  
 Furnishing and installation of RM-1 reflector markers on W1-8 sign posts will not be paid for separately, but shall be considered incidental to item No. 621.5000 Regulatory and Warning signs (10 sq. ft. or less) with posts.

STATE OF HAWAII  
 DEPARTMENT OF TRANSPORTATION  
 LAND TRANSPORTATION FACILITIES DIVISION

### PLANS

HANA HIGHWAY IMPROVEMENTS  
 HONOMANU TOWARDS HANA  
 PROJ. NO. 360AB-01-84

SCALE: AS NOTED
 

JUNE 1983

SHEET No. 4 OF 4 SHEETS

|               |      |
|---------------|------|
| ORIGINAL PLAN | DATE |
| DESIGNED BY   |      |
| TRACED BY     |      |
| QUANTITIES BY |      |
| CHECKED BY    |      |
| NO.           |      |