

INDEX TO DRAWINGS	
SHEET NO.	DESCRIPTION
1	TITLE SHEET
2	TYPICAL SECTIONS & GEN. NOTES
3-6	PLANS
*7-13	DRAINAGE SCHEDULE & DETAILS
14	PAV'T. WIDTH, CRM, SIGNS, RM'S, PAV'T. MARKINGS, GUARD RAILS SCHEDULES & SUMMARIES
15-19	GUARD RAIL DETAILS
20-29	TRAFFIC SIGNS, RM'S, PAV'T. MARKINGS & BARRICADES, STANDARD DETAILS
CO IIS-1	FRENCH DRAIN & GENERAL NOTES

STATE OF HAWAII

DEPARTMENT OF TRANSPORTATION

HIGHWAYS DIVISION

"AS-BUILT"

PLANS OF

HANA HIGHWAY IMPROVEMENTS




HONOMANU TOWARDS HANA

PROJECT NO. 360AB-01-84

DISTRICT OF HANA

ISLAND OF MAUI

FED. ROAD DIST. NO.	STATE	PROJ. NO.	FISCAL YEAR	SHEET NO.	TOTAL SHEETS
HAWAII	HAW.	360AB-01-84	1984	1	29

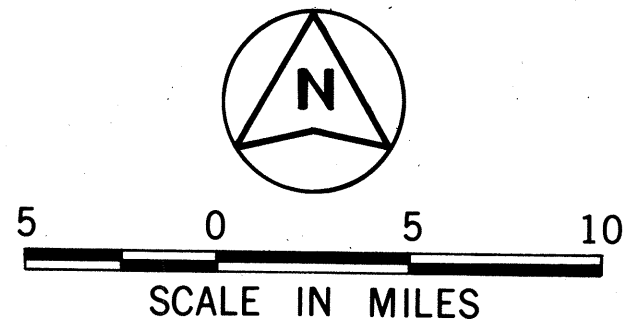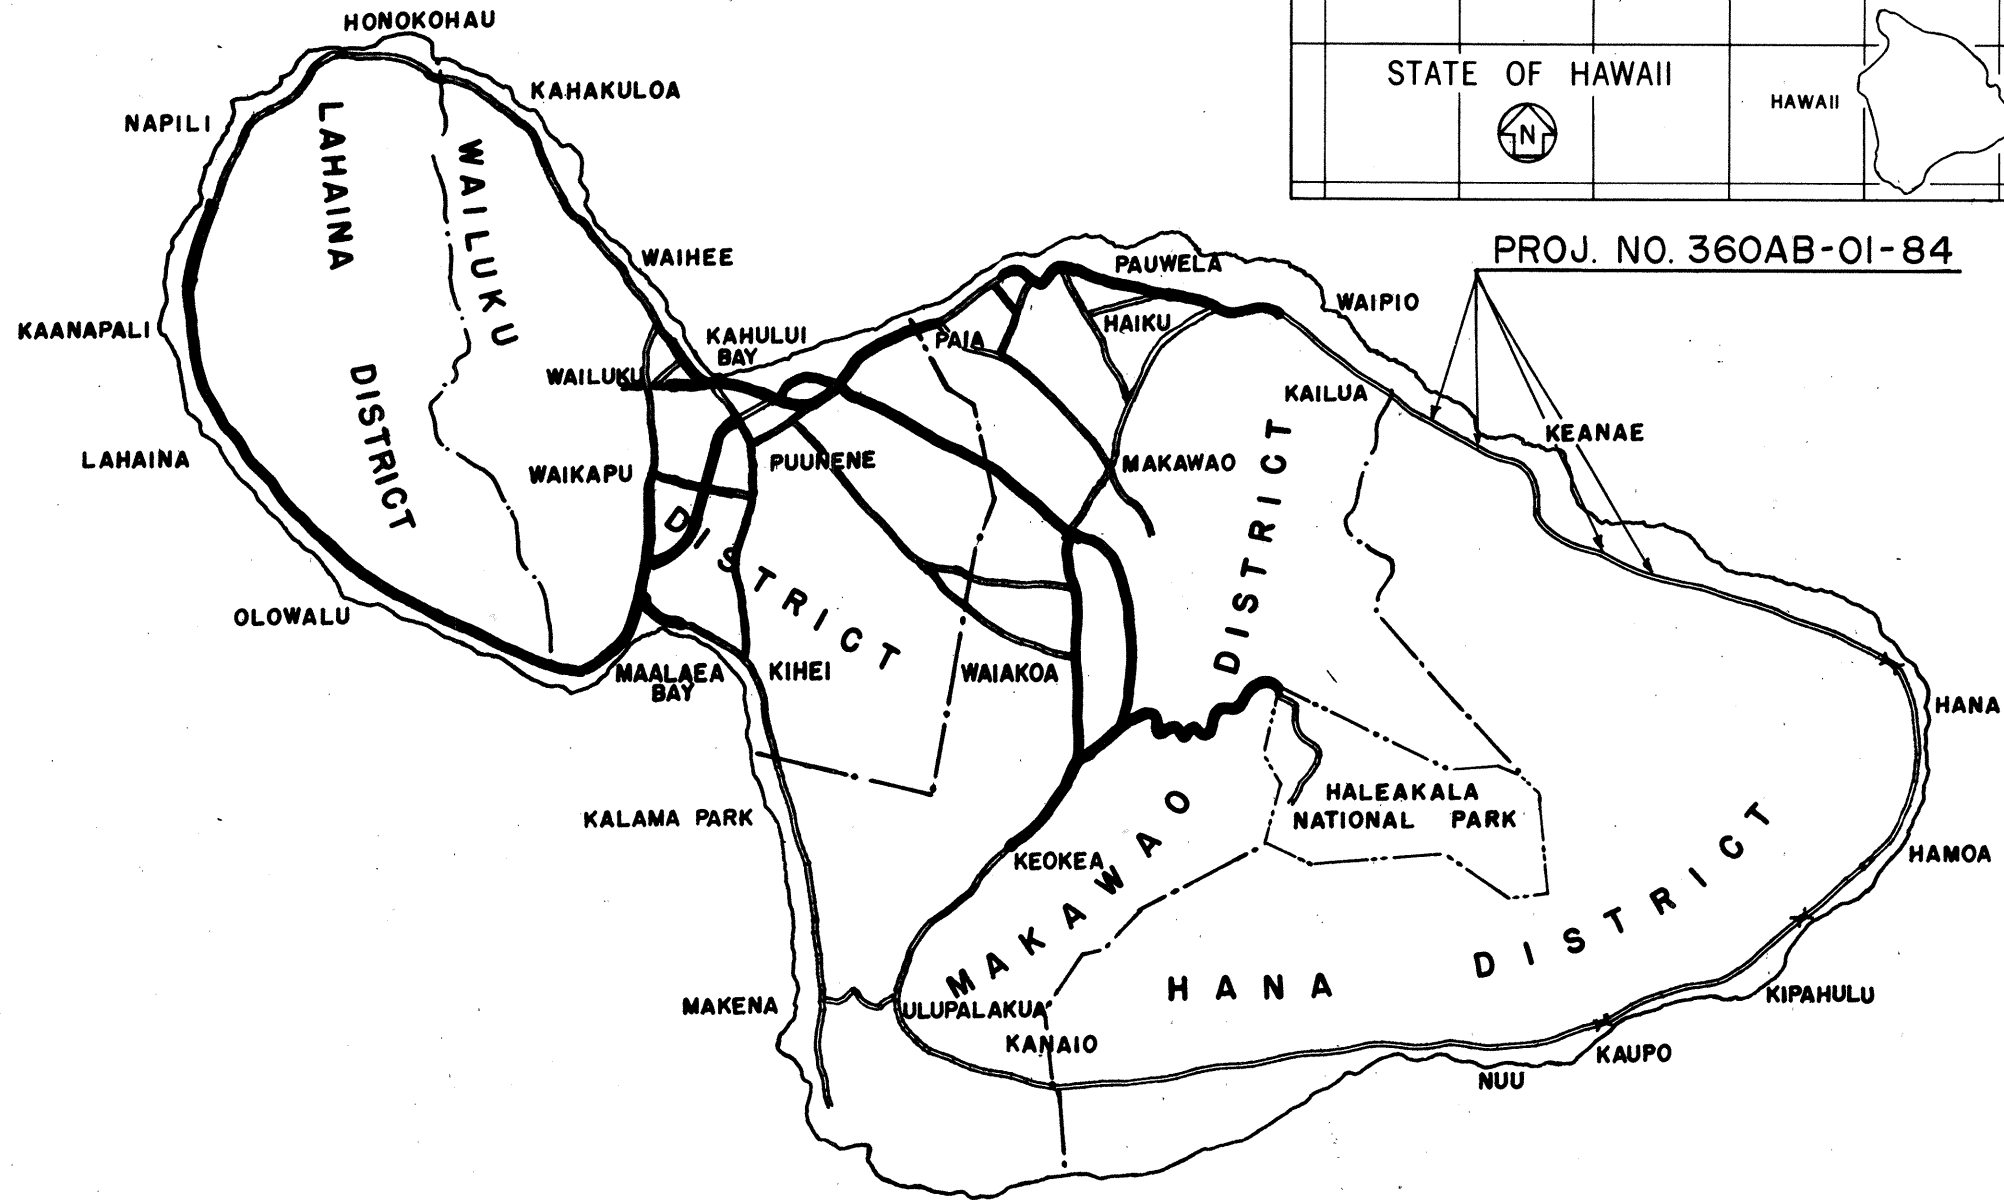
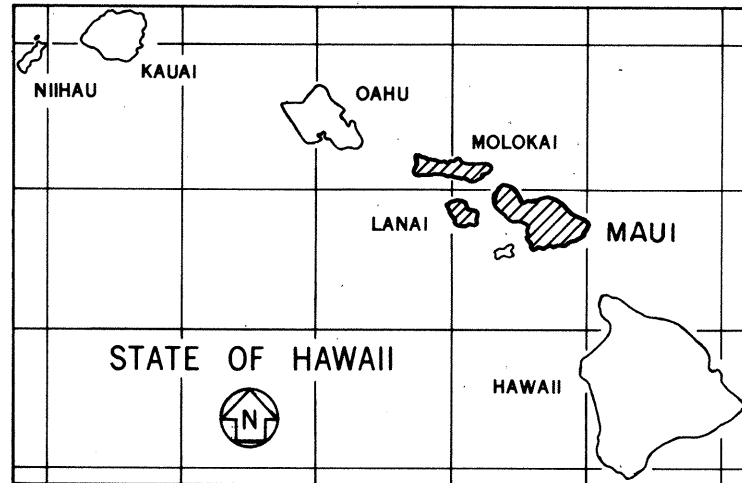


FEDERAL AID PROJECTS PREVIOUSLY CONSTRUCTED OR UNDER CONSTRUCTION

CHANGES MADE DURING CONSTRUCTION HAVE BEEN INCORPORATED ON THESE PLANS EXCEPT CHANGES IN THE ORIGINAL THEORETICAL QUANTITIES. FOR ACTUAL QUANTITIES, REFER TO PROJECT LEDGER AND/OR COMPUTATION BOOK.

Cory Yamashita
 RESIDENT ENGINEER

6-6-84
 DATE

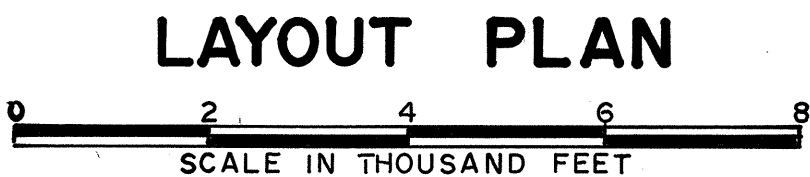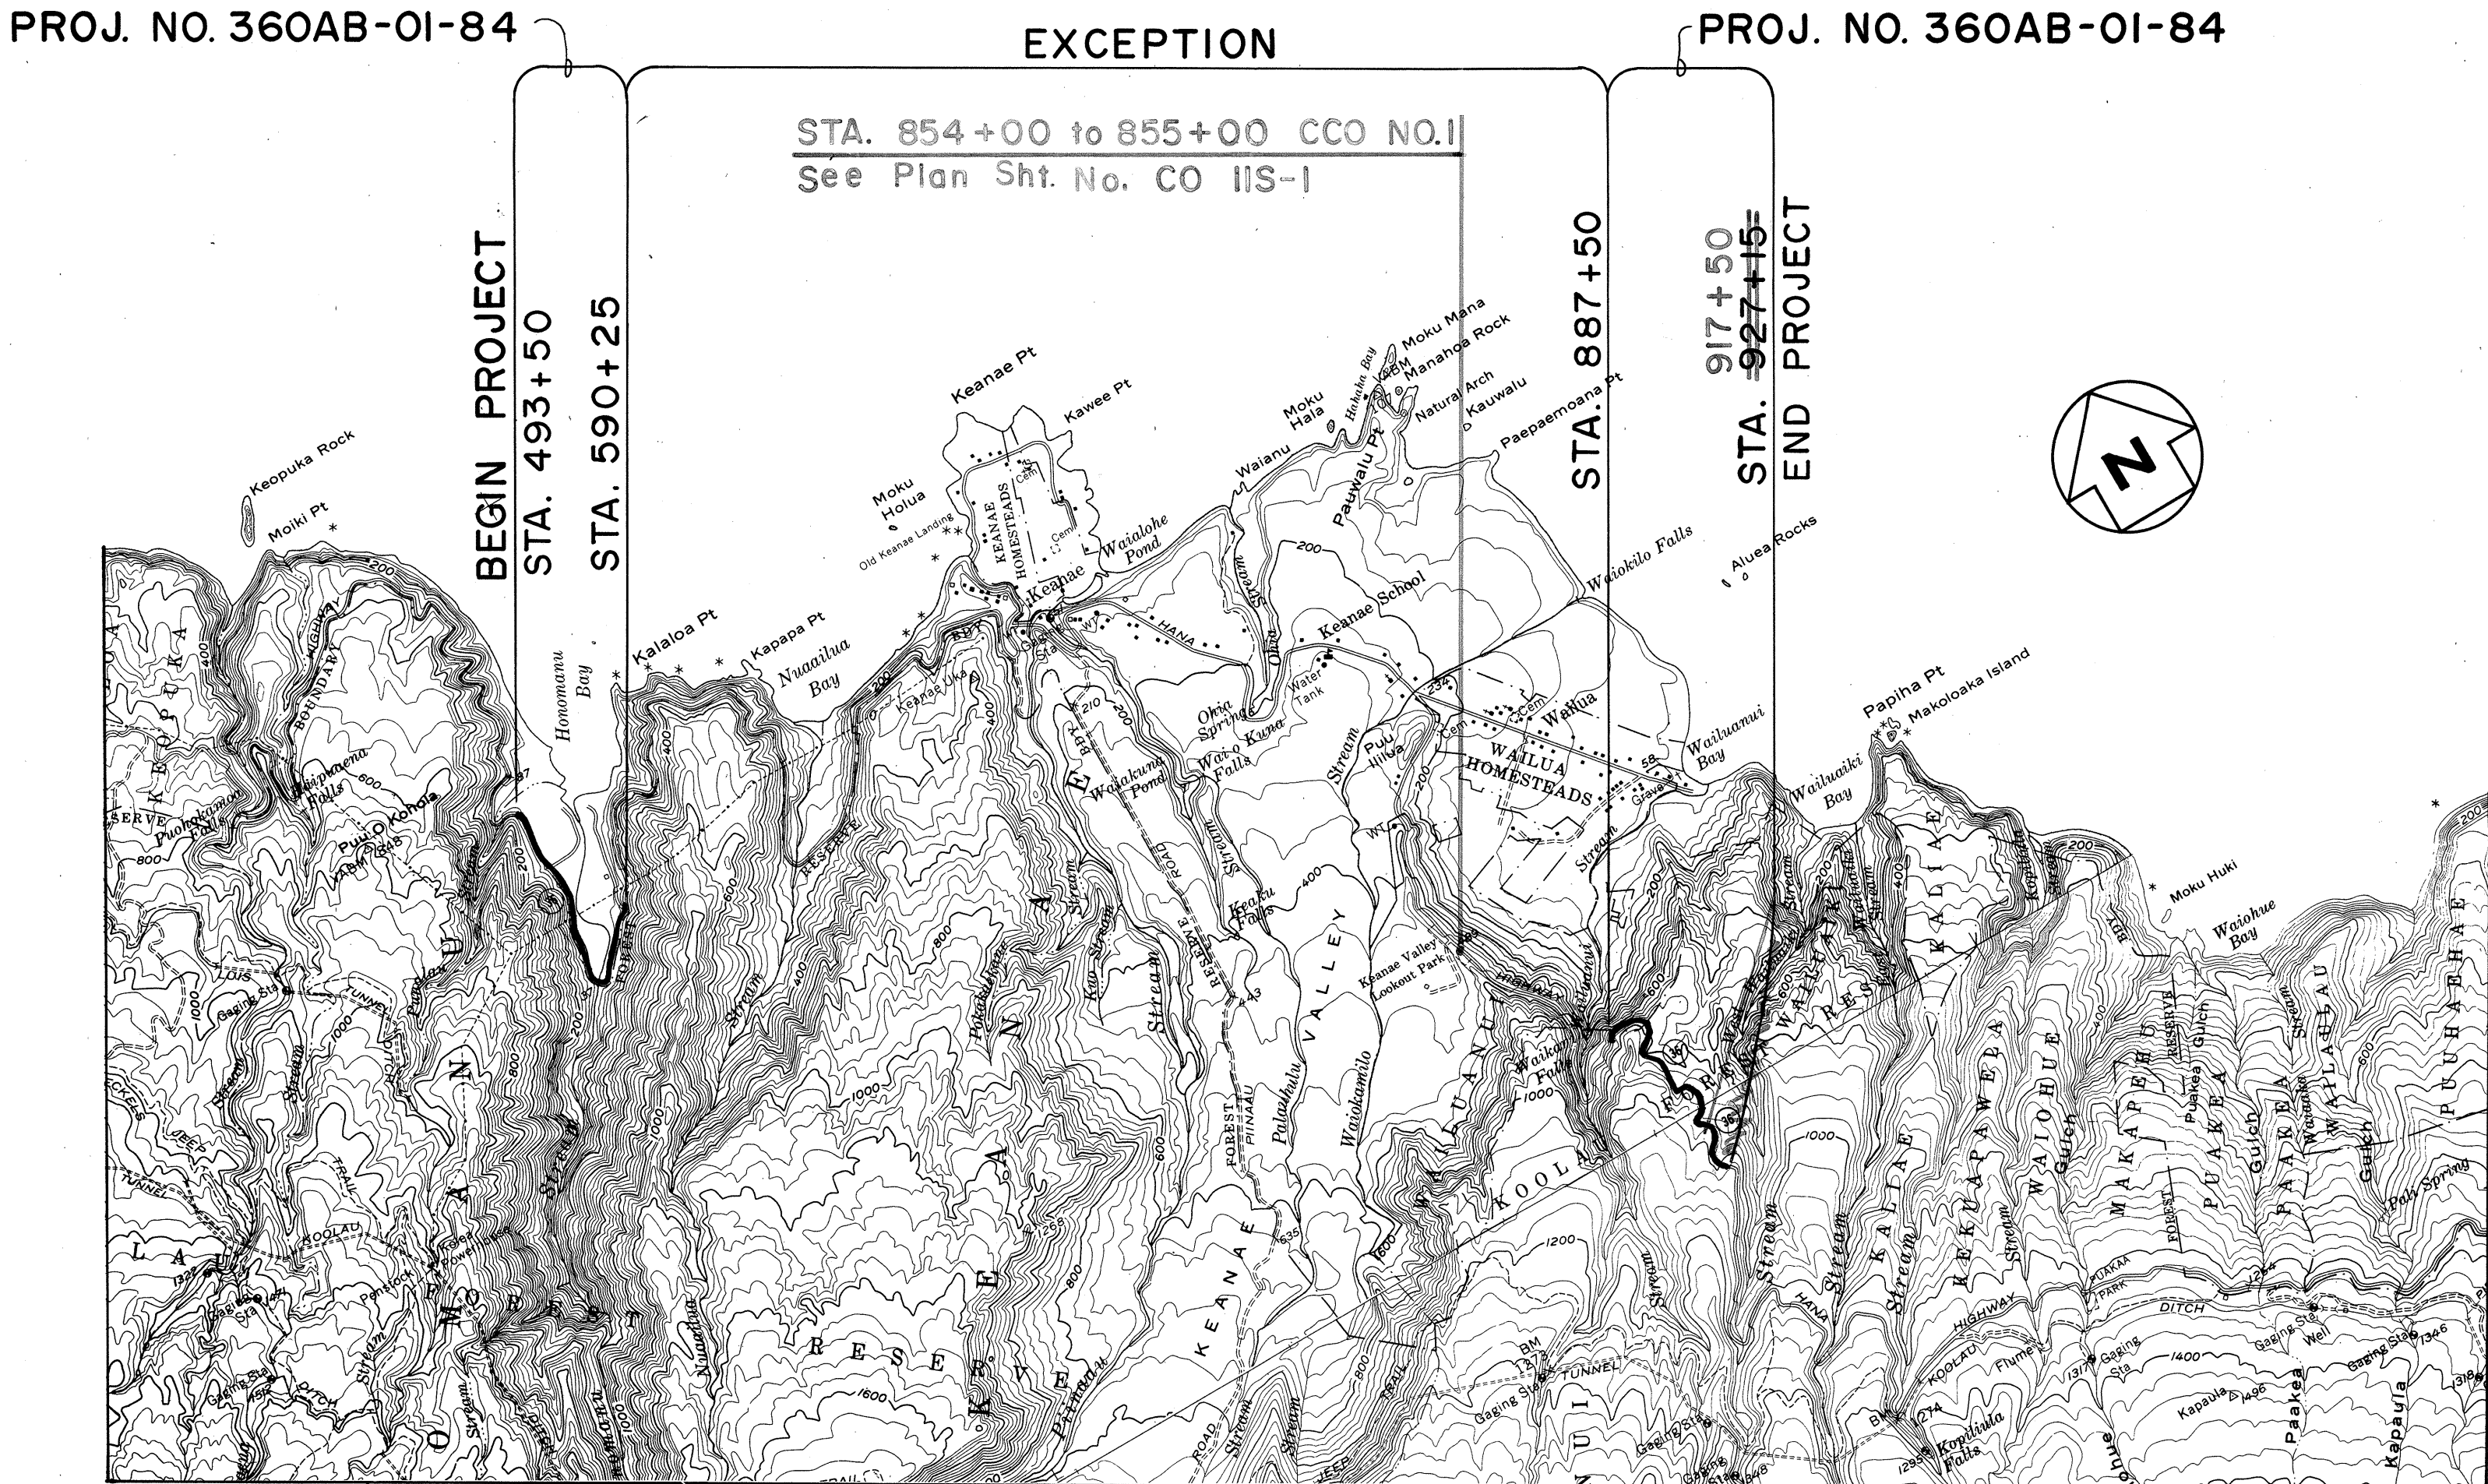

GROSS LENGTH OF PROJECT	8.213	MILES
EXCEPTION	5.630	MILES
NET LENGTH OF PROJECT	2.583	MILES

DEPARTMENT OF TRANSPORTATION STATE OF HAWAII	
APPROVED:	
<i>Charles A. Boon</i> DIR. OF TRANSPORTATION	8/8/85 DATE

MAUI DISTRICT
 DESIGNED BY
 R. TSUZUKI
 P. S. & E. BY
 548-2456
 AUG. 1983
 DATE
 PHONE