


FED. ROAD DIST. NO.	STATE	PROJ. NO.	FISCAL YEAR	SHEET NO.	TOTAL SHEETS
HAWAII	HAW.	360B-01-85	1985	3	41

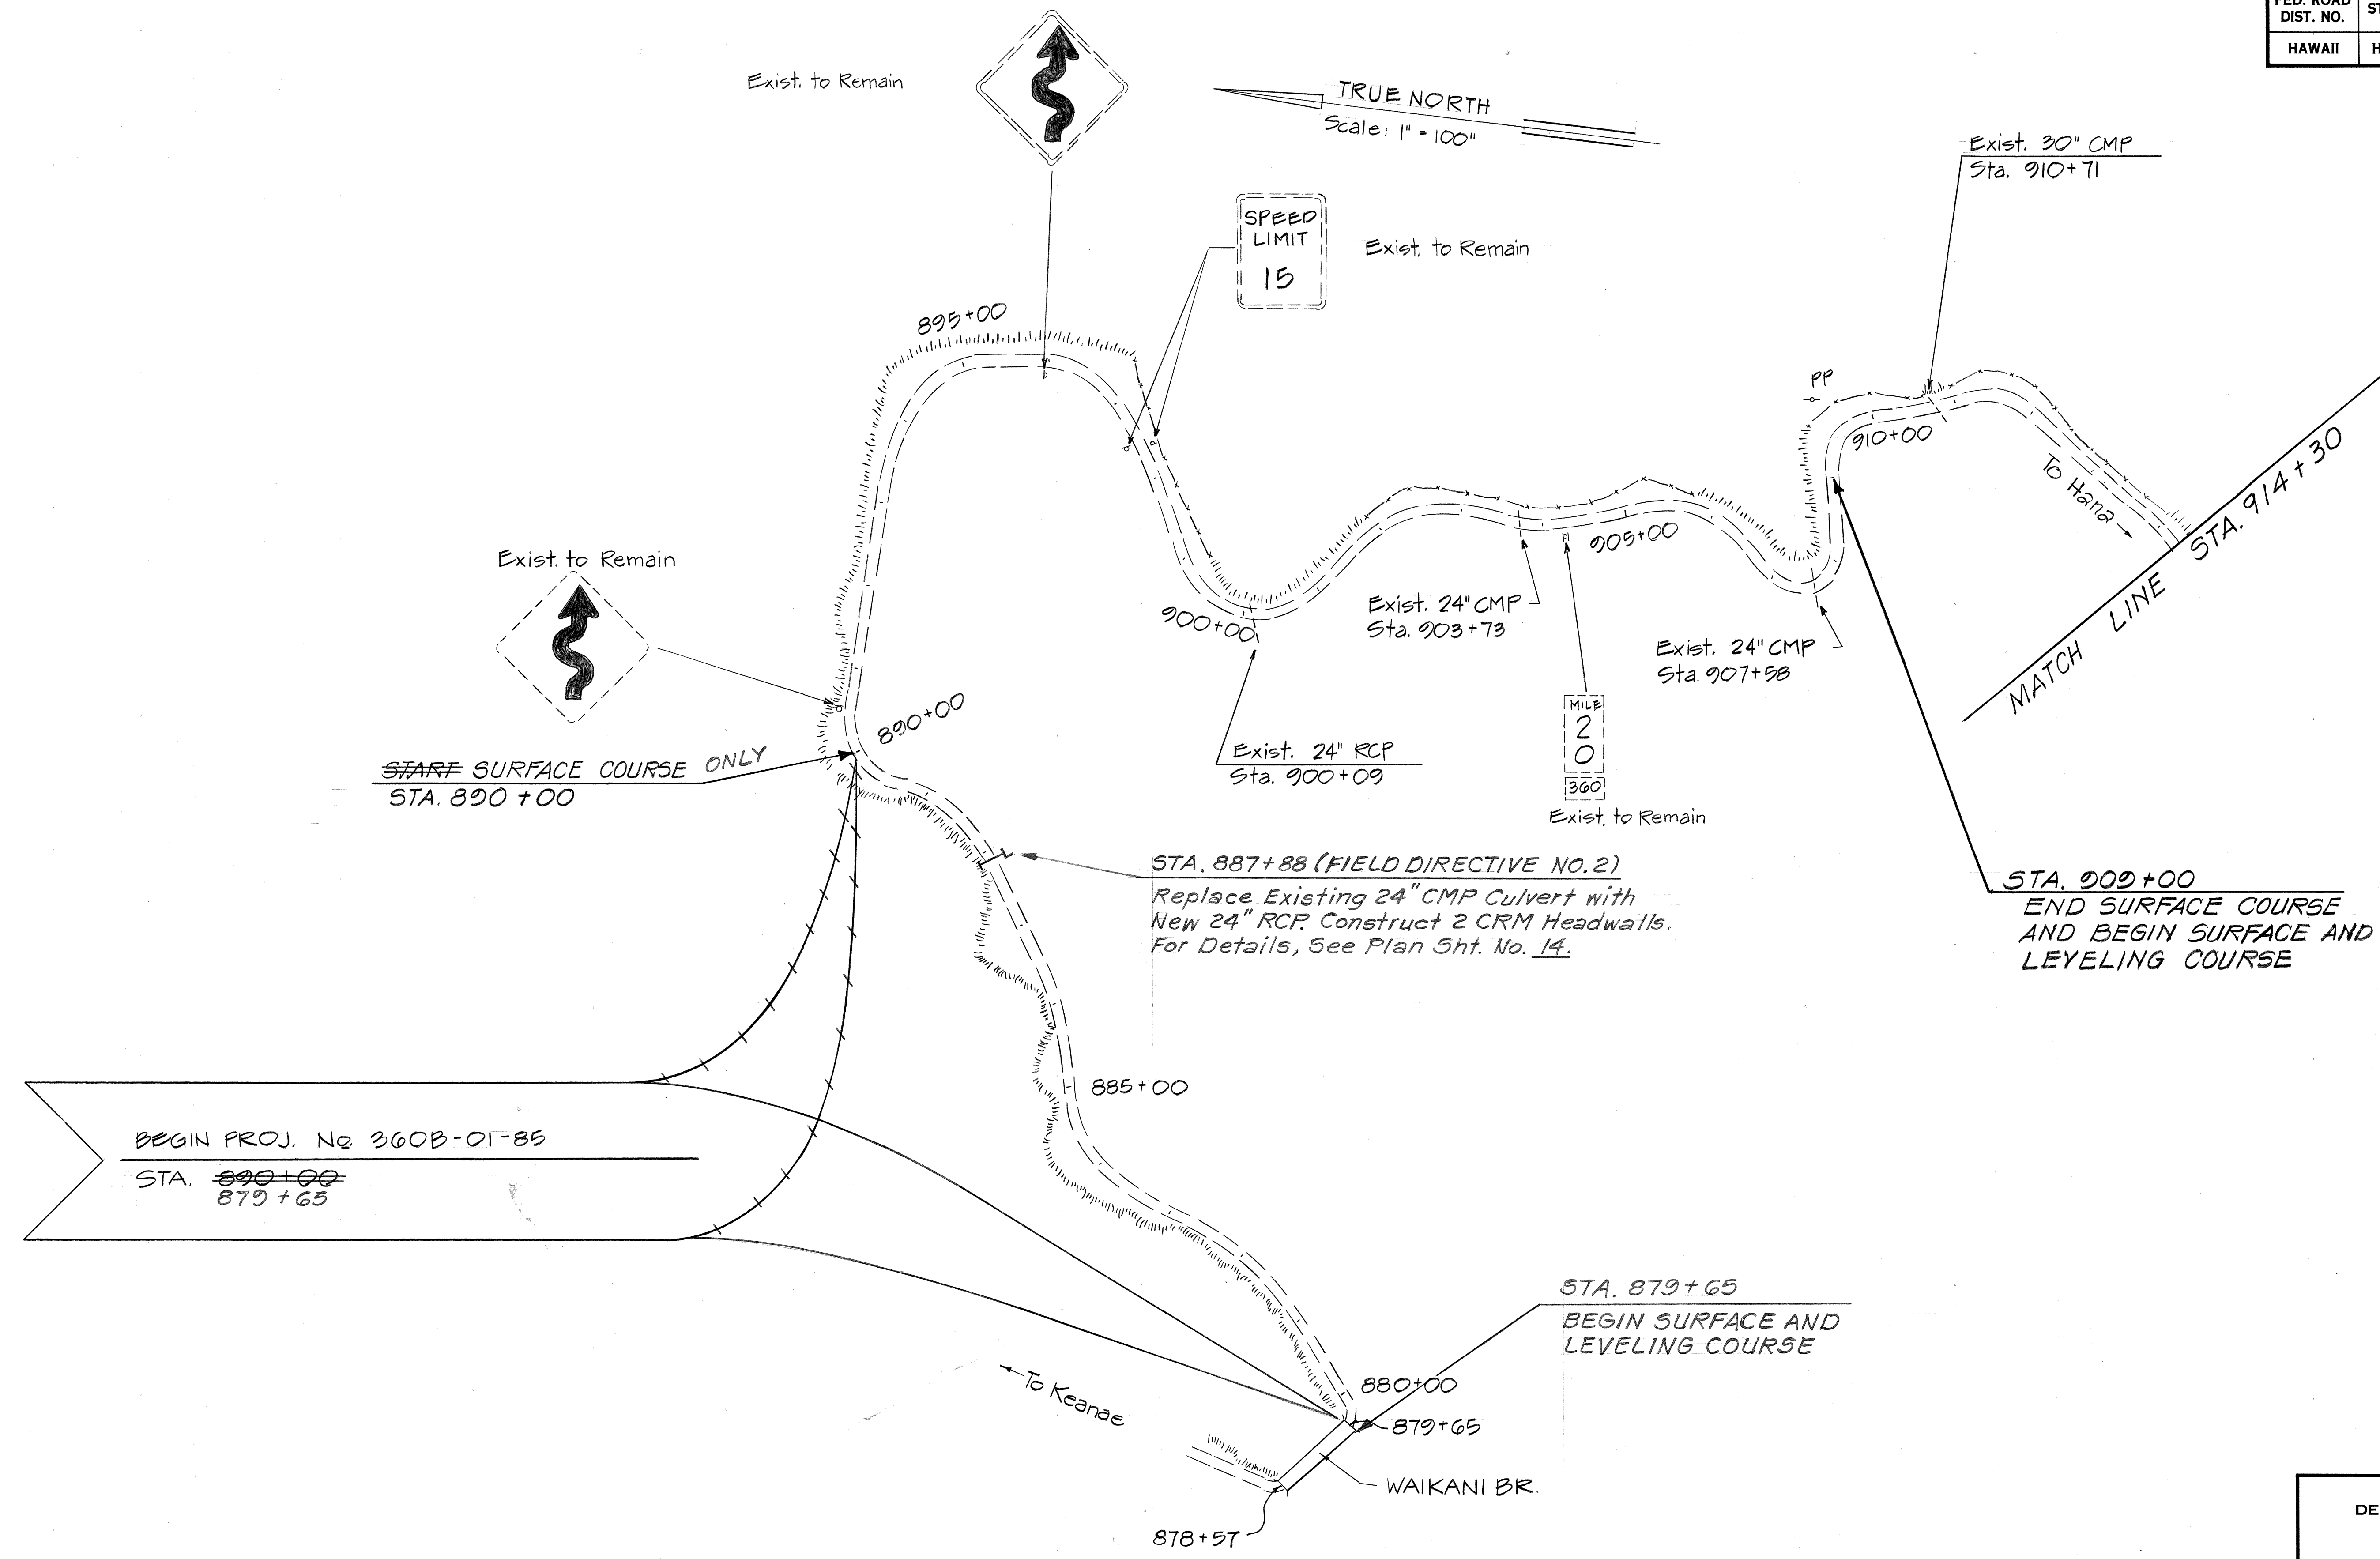

SURVEY PLOTTED BY	DATE
DRAWN BY	
DESIGNED BY	
QUANTITIES BY	
CHECKED BY	
ORIGINAL PLAN	
NOTE BOOK	
No.	

STATE OF HAWAII
DEPARTMENT OF TRANSPORTATION
HIGHWAYS DIVISION


PLANS

HANA HIGHWAY IMPROVEMENTS
WAILUA TOWARDS HANA, PHASE I
PROJ. No. 360B-01-85

SCALE: AS NOTED OCT. 1984

SHEET NO. 1 OF 6 SHEETS

FED. ROAD DIST. NO.	STATE	PROJ. NO.	FISCAL YEAR	SHEET NO.	TOTAL SHEETS
HAWAII	HAW.	360B-01-85	1985	4	41

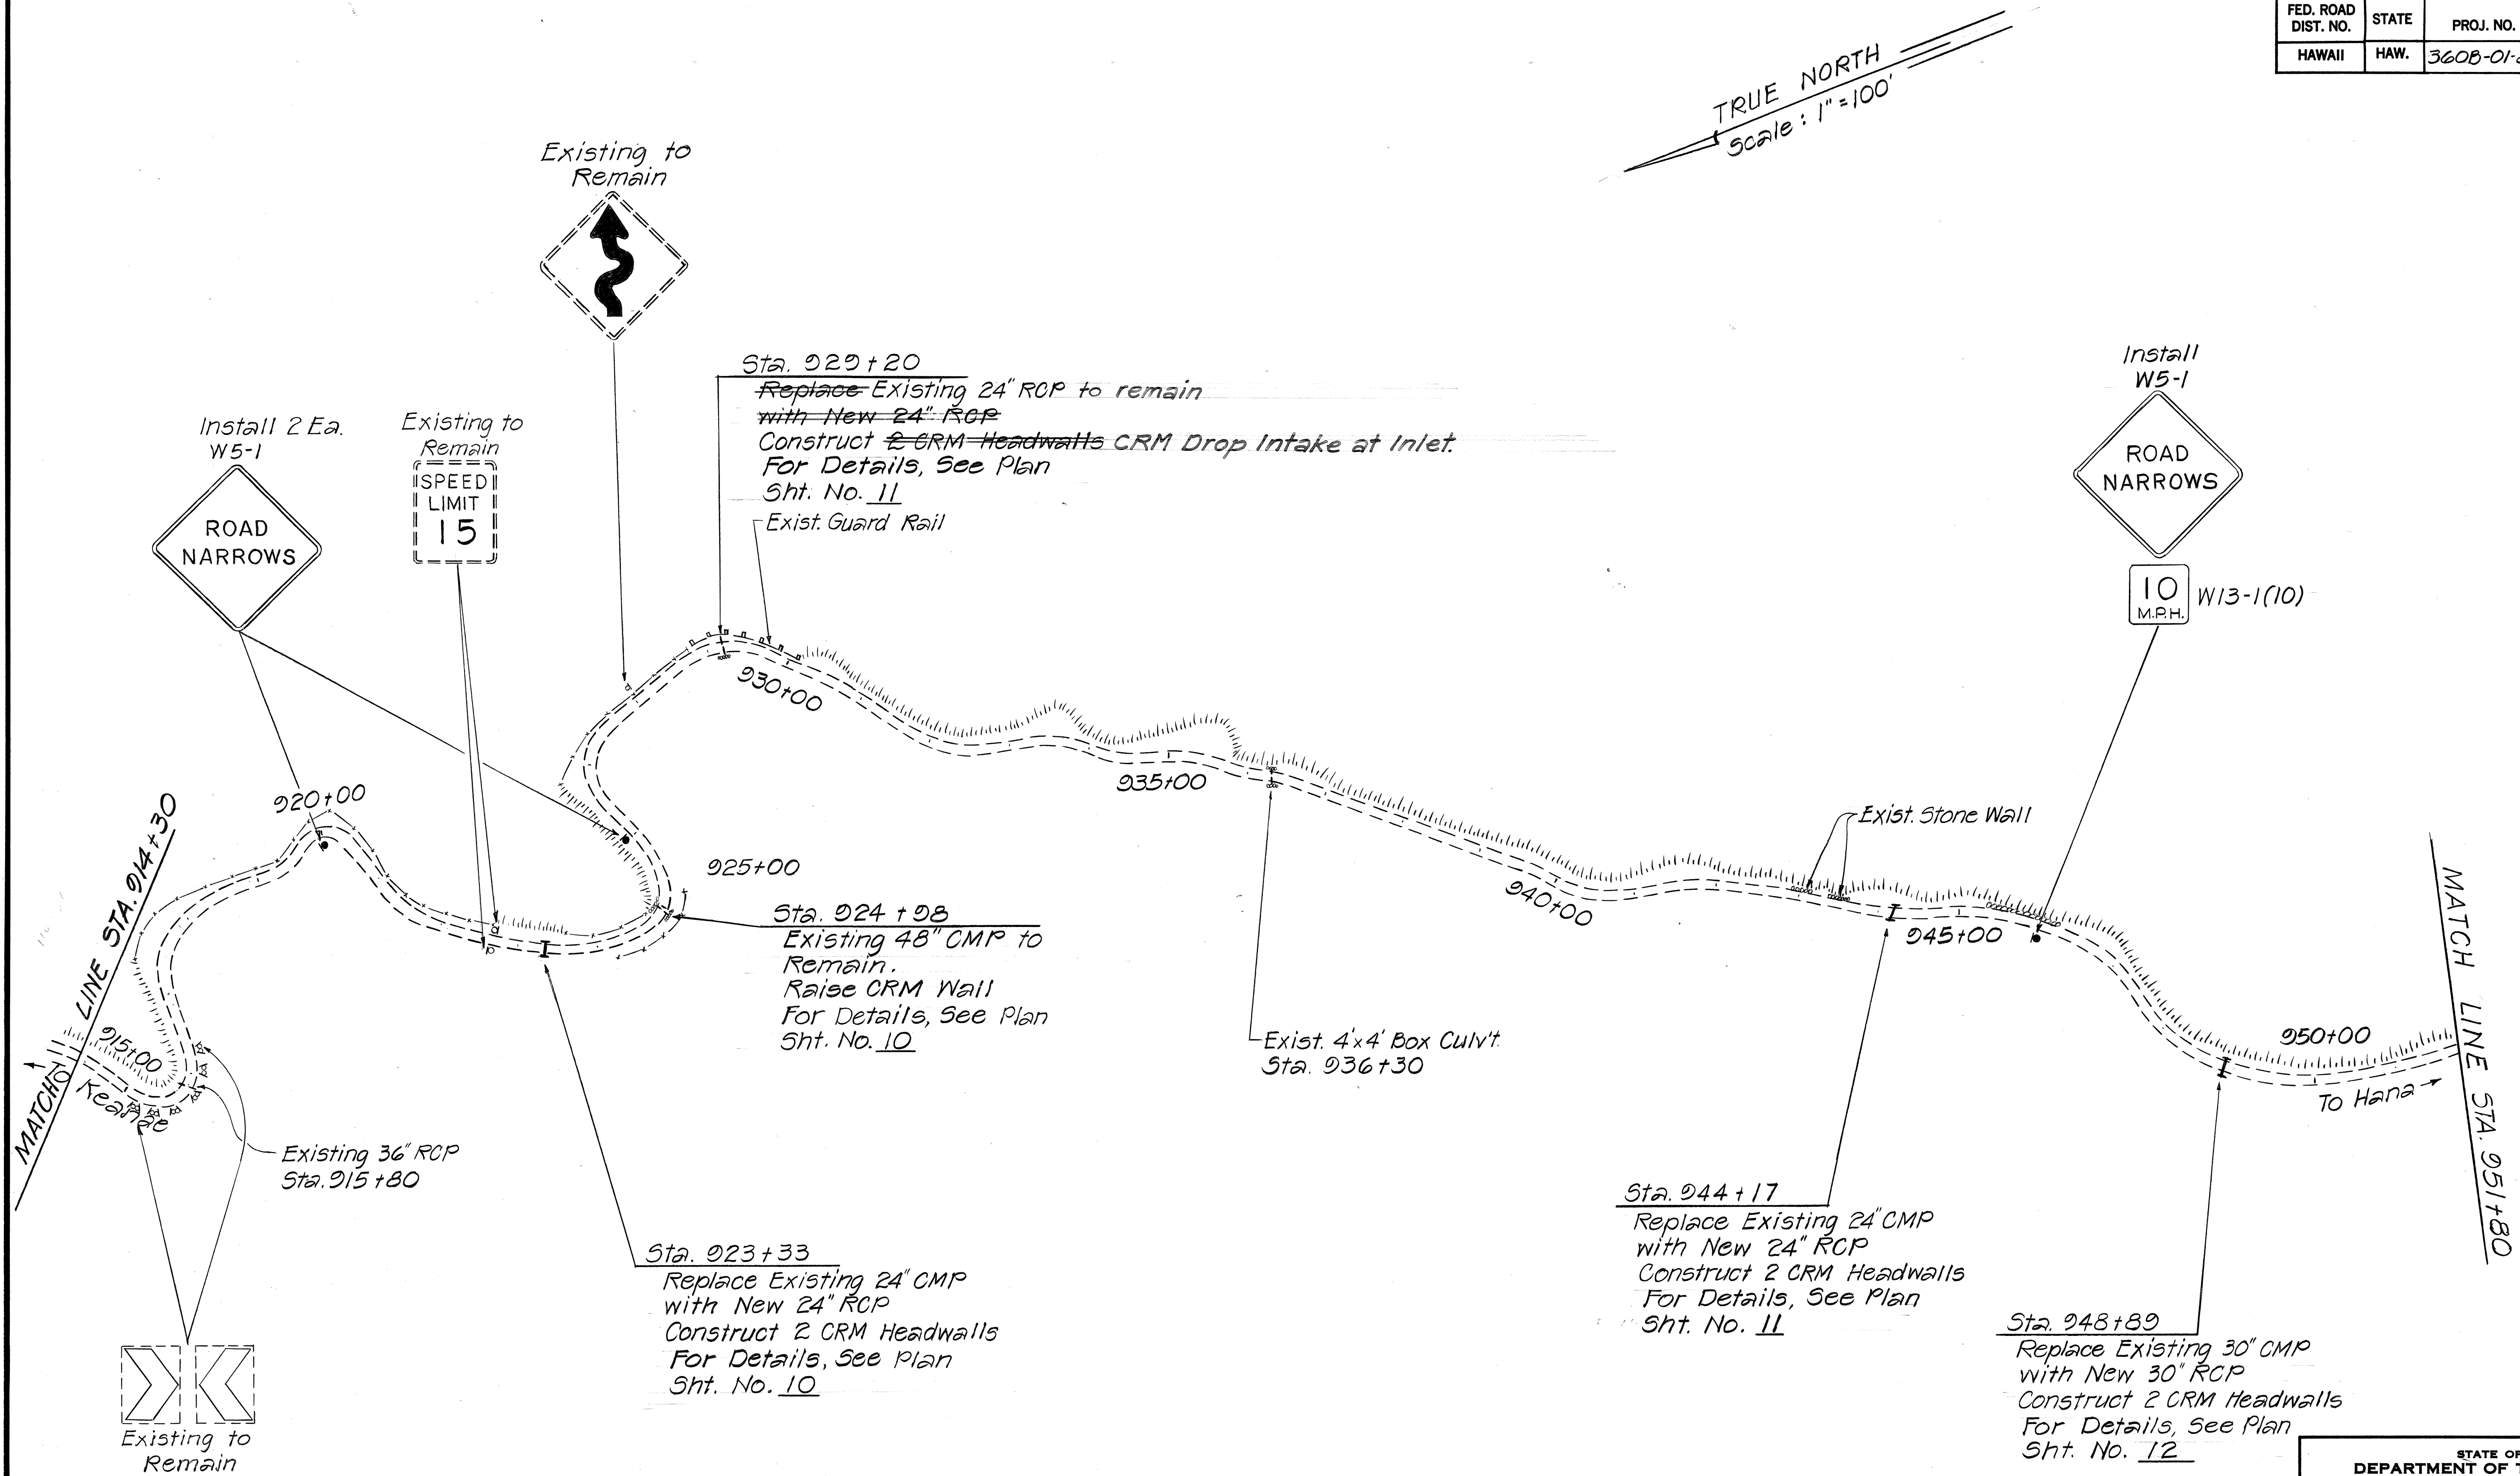


STATE OF HAWAII
DEPARTMENT OF TRANSPORTATION
LAND TRANSPORTATION FACILITIES DIVISION

PLANS

HANA HIGHWAY IMPROVEMENTS
WAILUA TOWARDS HANA, PHASE I
PROJ. NO. 360B-01-85

SCALE : AS SHOWN DATE: OCT. 1984
SHEET NO. 2 OF 4 SHEETS

FED. ROAD DIST. NO.	STATE	PROJ. NO.	FISCAL YEAR	SHEET NO.	TOTAL SHEETS
HAWAII	HAW.	360B-01-85	1985	5	41

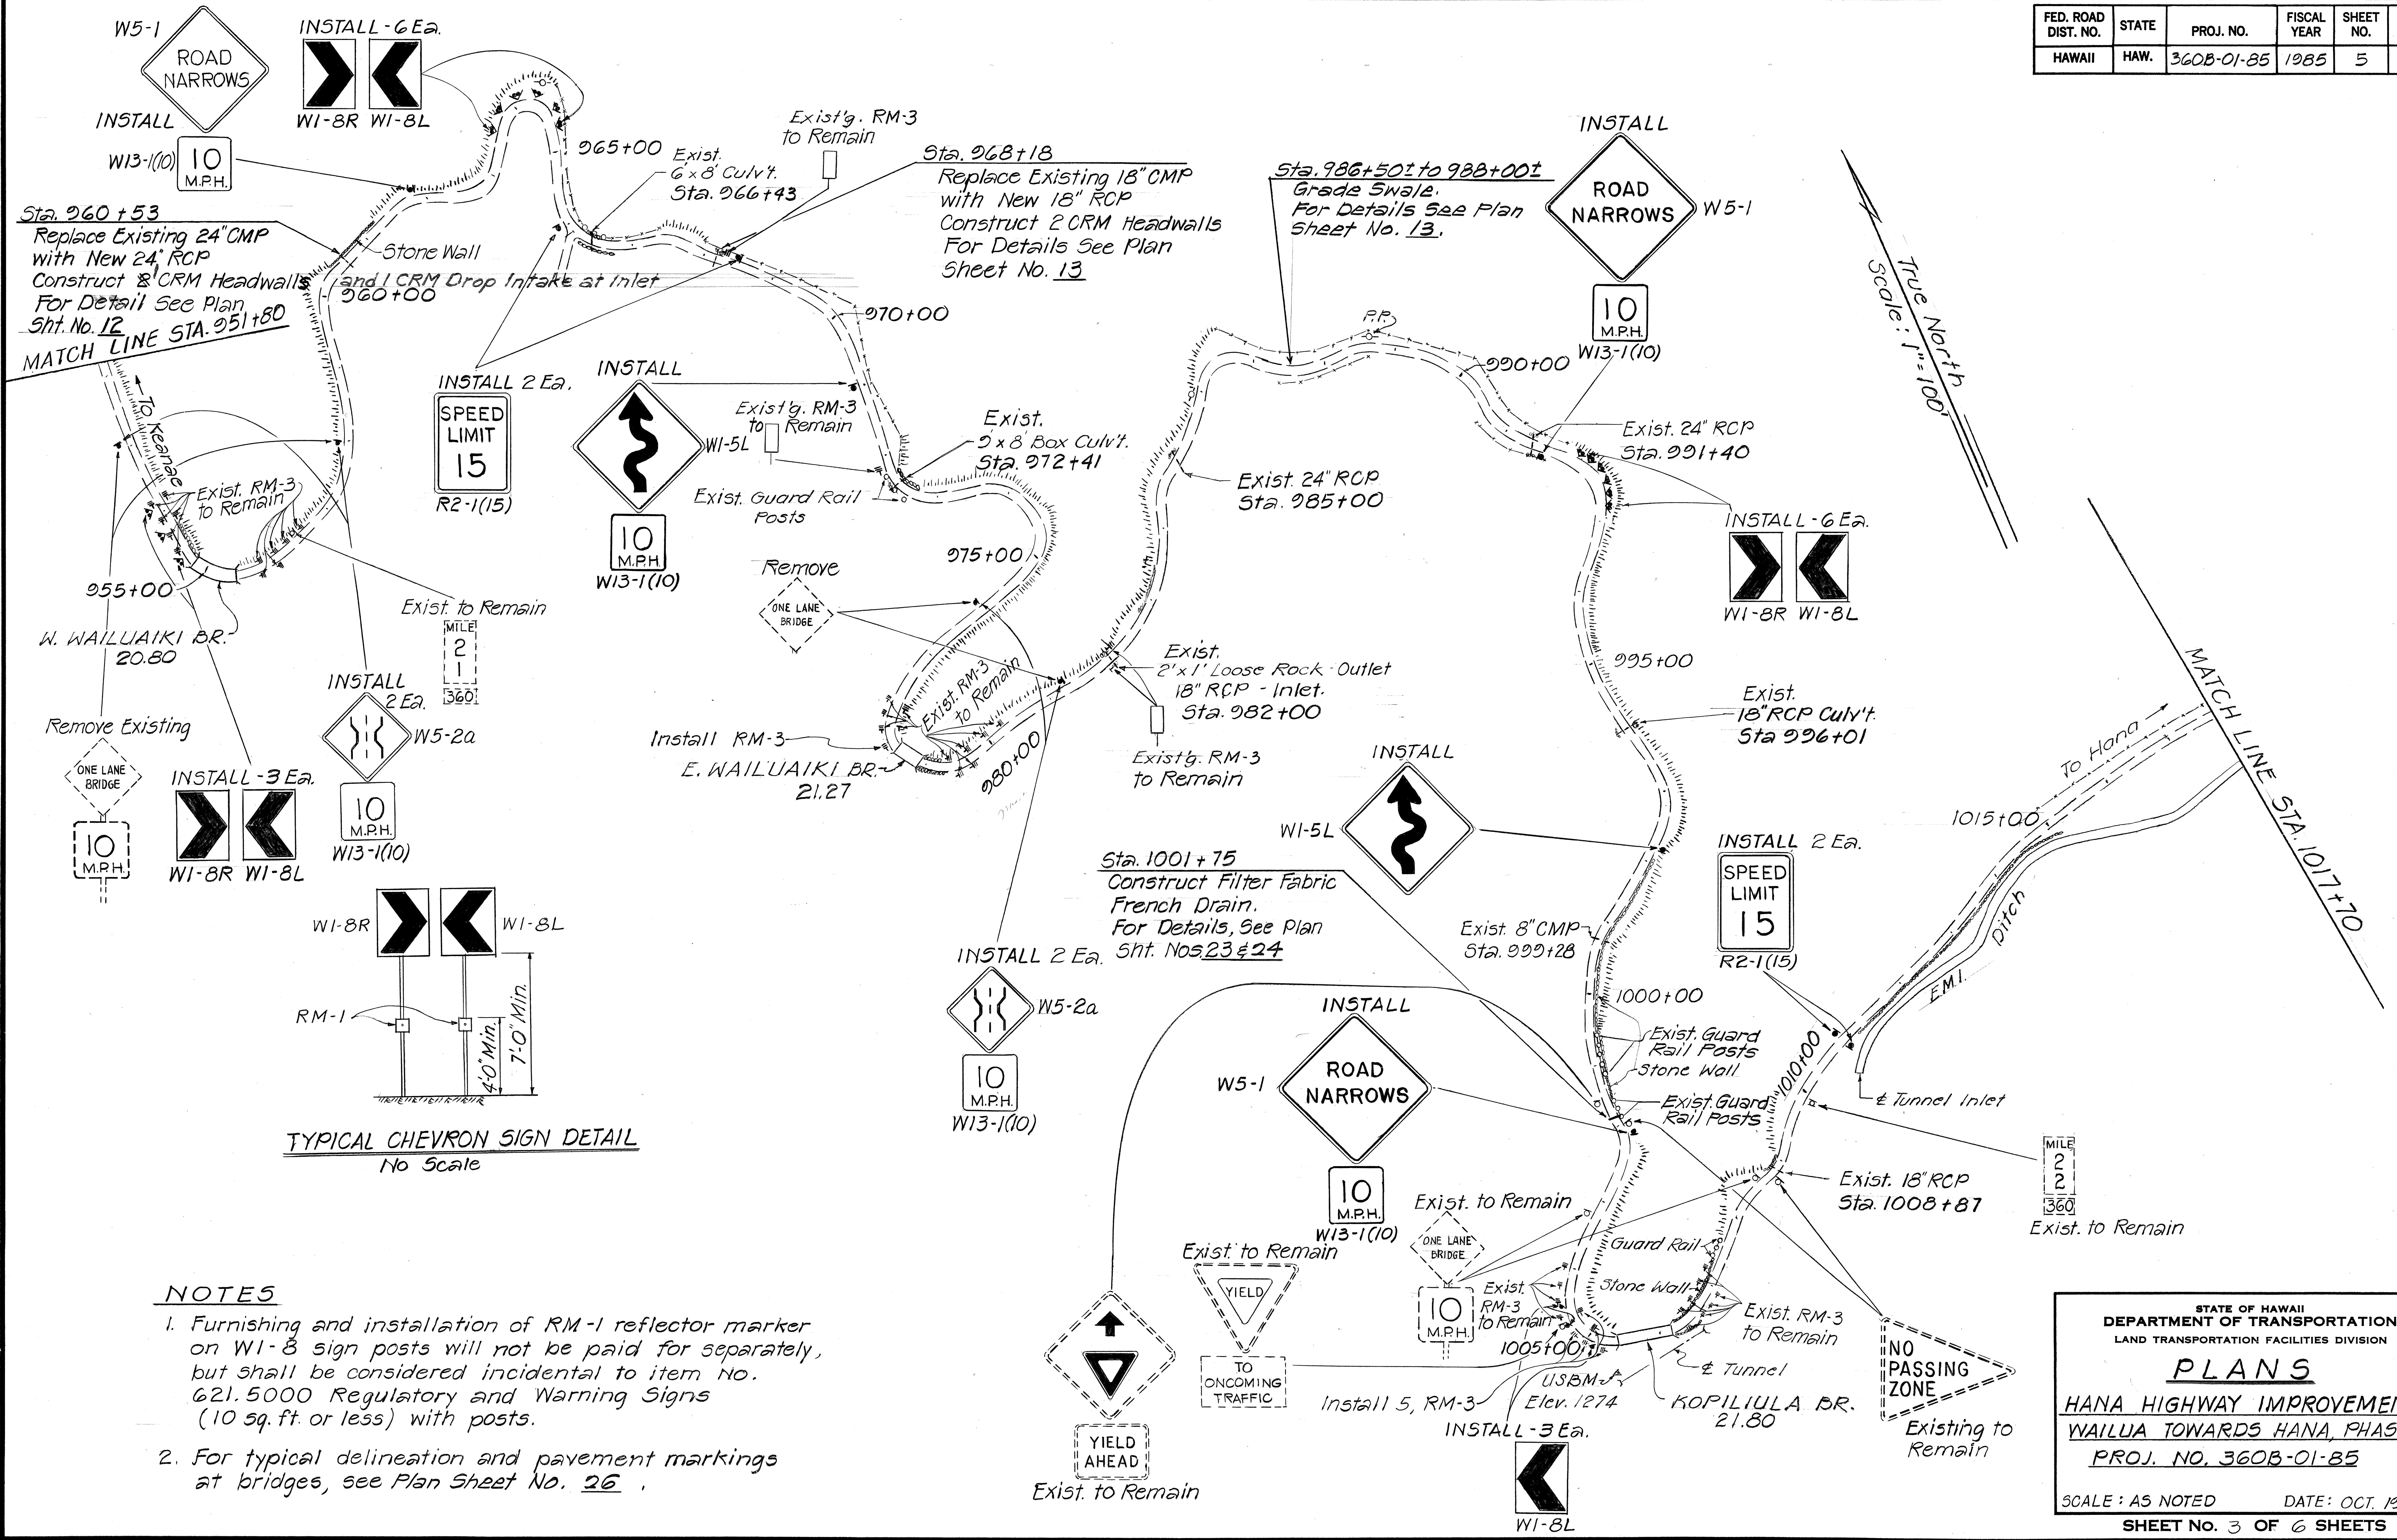

TYPICAL CHEVRON SIGN DETAIL
No Scale

- NOTES**
- Furnishing and installation of RM-1 reflector marker on W1-3 sign posts will not be paid for separately, but shall be considered incidental to item No. 621.5000 Regulatory and Warning Signs (10 sq. ft. or less) with posts.
 - For typical delineation and pavement markings at bridges, see Plan Sheet No. 26.

STATE OF HAWAII

DEPARTMENT OF TRANSPORTATION

LAND TRANSPORTATION FACILITIES DIVISION

PLANS

HANA HIGHWAY IMPROVEMENTS

WAILUA TOWARDS HANA, PHASE I

PROJ. NO. 360B-01-85

SCALE: AS NOTED

DATE: OCT. 1984

SHEET NO. 3 OF 6 SHEETS

SURVEY PLOTTED BY	DATE
DRAWN BY	
TRACED BY	
NOTED BY	
CHECKED BY	
ORIGINAL PLAN	
NOTE BOOK	
No.	

STATE OF HAWAII
DEPARTMENT OF TRANSPORTATION
LAND TRANSPORTATION FACILITIES DIVISION

PLANS

HANA HIGHWAY IMPROVEMENTS
WAILUA TOWARDS HANA, PHASE I
PROJ. NO. 360B-01-85

SCALE: AS SHOWN DATE: OCT. 1984

SHEET No. 4 OF 6 SHEETS

