
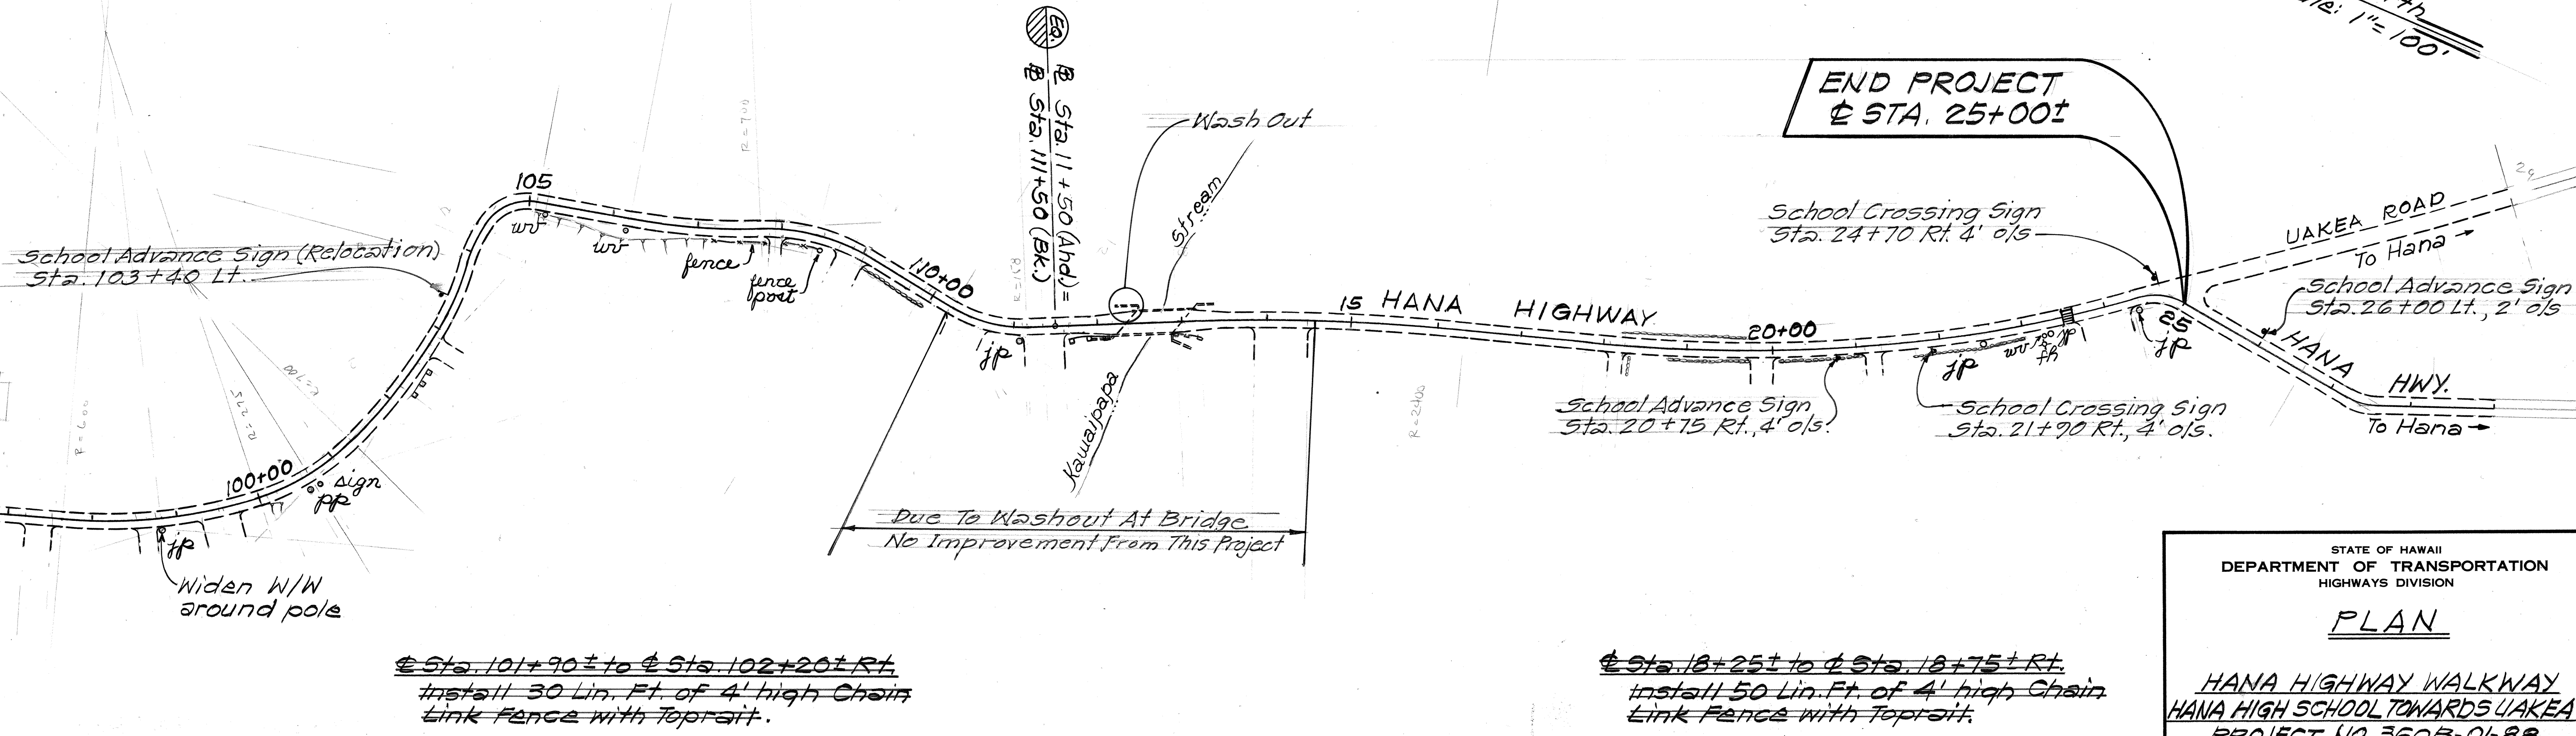


FED. ROAD DIST. NO.	STATE	PROJ. NO.	FISCAL YEAR	SHEET NO.	TOTAL SHEETS
HAWAII	HAW.	360B-01-88	1988	5	7

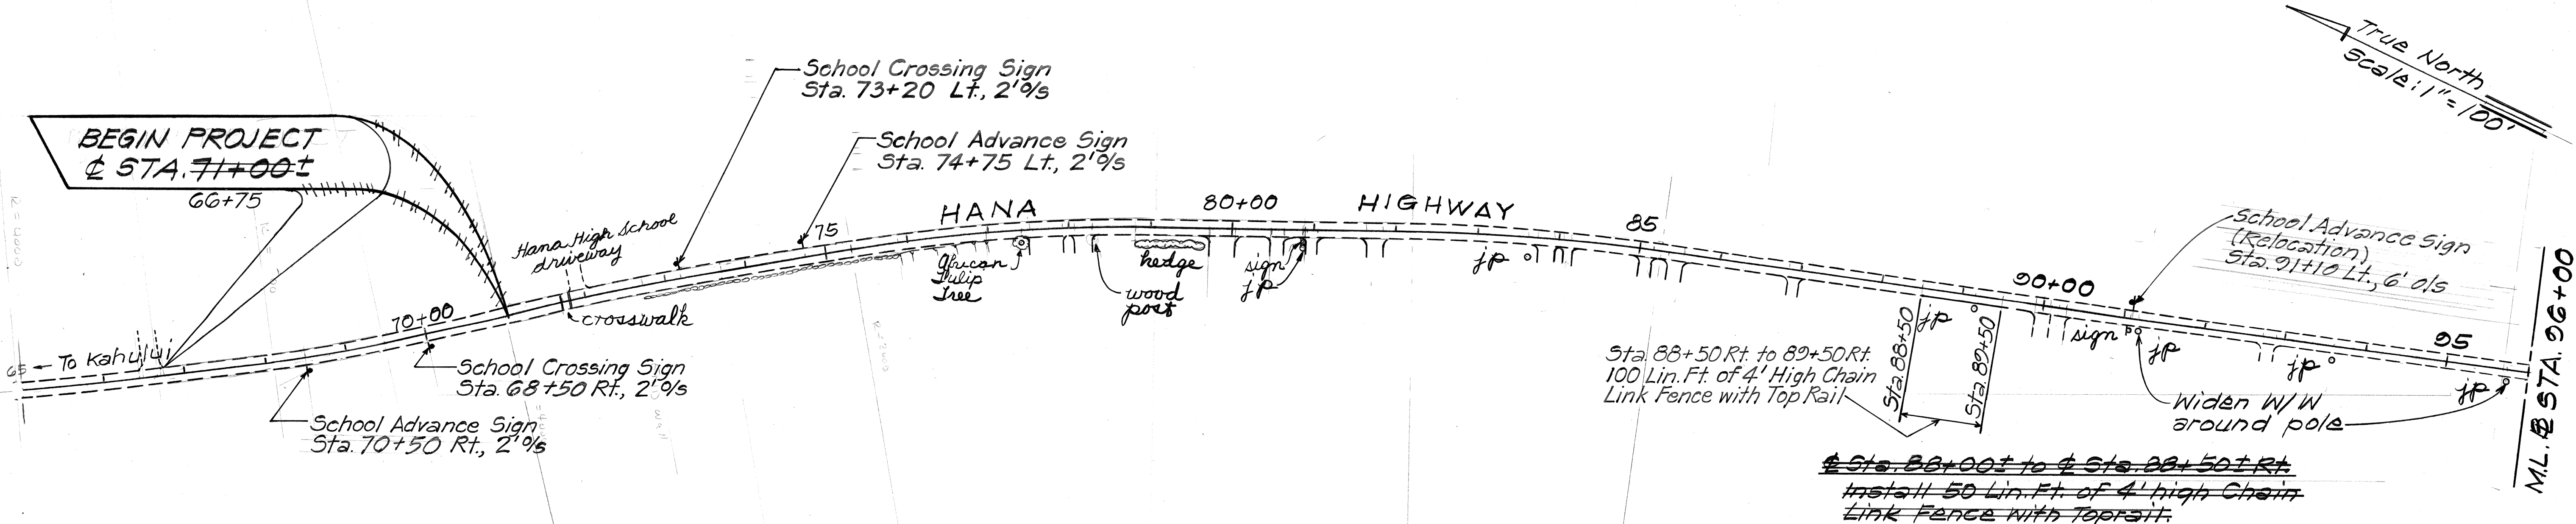

SURVEY PLOTTED BY	DATE
DRAWN BY	
CHECKED BY	
NOTED BY	
NO.	

STATE OF HAWAII
DEPARTMENT OF TRANSPORTATION
HIGHWAYS DIVISION

PLAN

HANA HIGHWAY WALKWAY HANA HIGH SCHOOL TOWARDS UAKA RD

PROJECT No. 360B-01-88
Scale: 1"=100' Date: Dec/1987
SHEET No. 1 OF 1 SHEETS