
	,
	INDEX TO DRAWINGS
SHEET NO.	DESCRIPTION
l	TITLE SHEET
2	STANDARD PLANS SUMMARY
3	GENERAL NOTES AND SCHEDULE
4	TYPICAL SECTIONS AND DETAILS
5	PLAN
6-7	SIGNING AND PAVEMENT MARKING PLAN AND DETAILS
	•
<u></u>	•
•	

STATE OF HAWAII

DEPARTMENT OF TRANSPORTATION HIGHWAYS DIVISION HONOLULU, HAWAII "AS-BUILT" PLANS FOR

HANA HIGHWAY WALKWAY HANA HIGH SCHOOL TO UAKEA ROAD PROJECT NO. 360B - 01 - 88

> DISTRICT OF HANA ISLAND OF MAUI

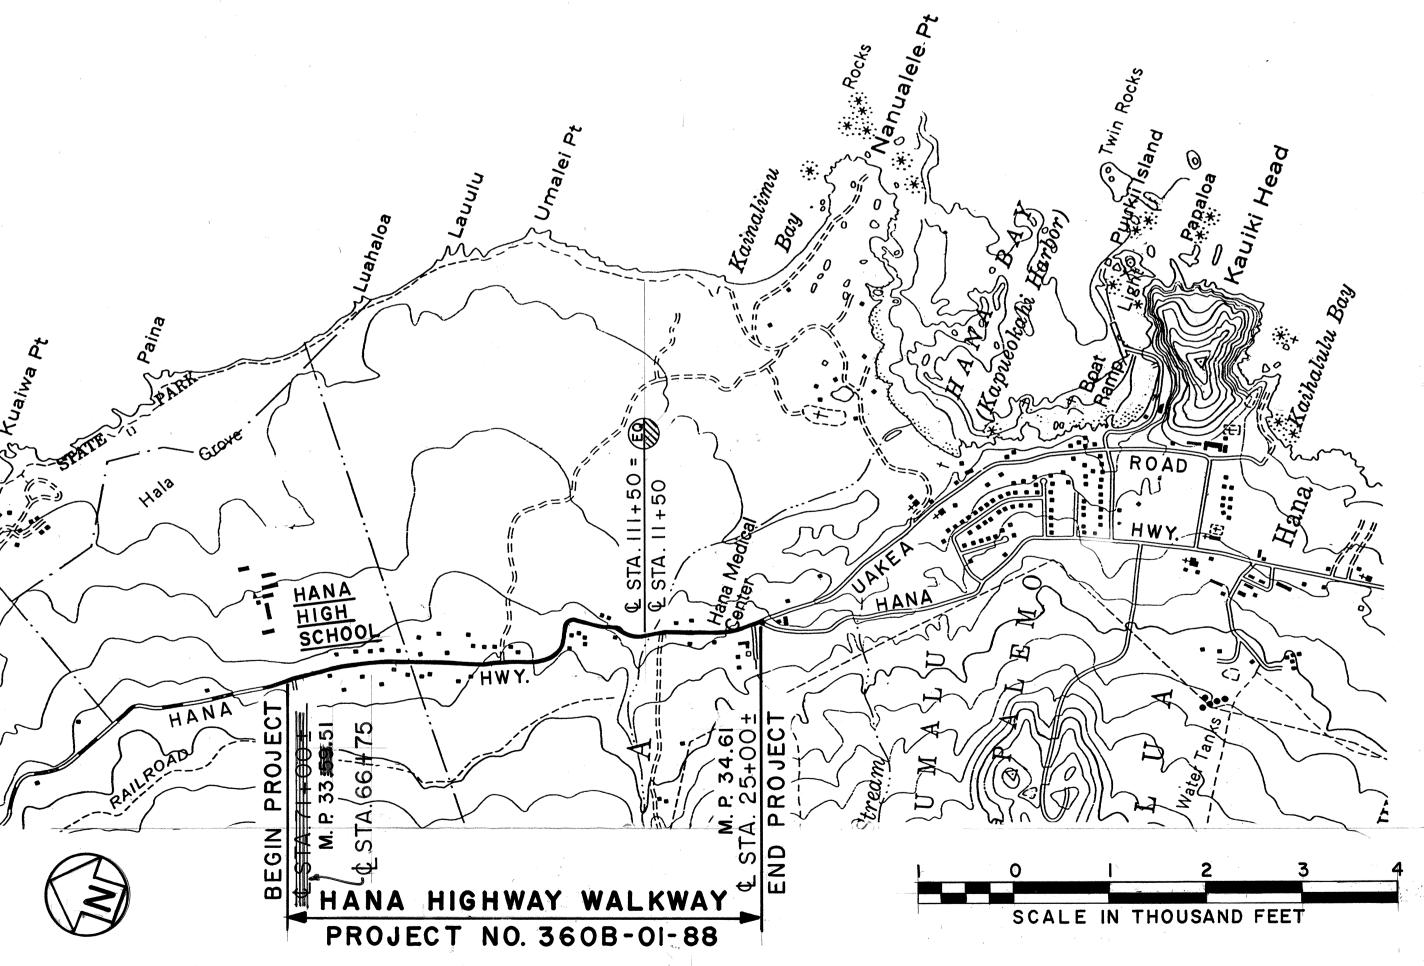

STATE OF HAWAII (N) LOCATION OF PROJECT/

FED. ROAD DIST. NO.

FEDERAL AID PROJECTS PREVIOUSLY CONSTRUCTED OR UNDER CONSTRUCTION

SCALE IN MILES

CHANGES MADE DURING CONSTRUCTION HAVE BEEN INCORPORATED ON THESE PLANS EXCEPT CHANGES IN THE ORIGINAL THEORETICAL QUANTITIES. FOR ACTUAL QUANTITIES, REFER TO PROJECT LEDGER AND/OR COMPUTATION BOOK.

RESIDENT ENGINEER

2/1/89 DATE

DEPARTMENT OF TRANSPORTATION STATE OF HAWAII

FISCAL SHEET TOTAL YEAR NO. SHEETS

1988

PROJ. NO.

360B-01-88

LAYOUT PLAN

LENGTH OF PROJECT....I.02 MILES