


FED. ROAD DIST. NO.	STATE	PROJ. NO.	FISCAL YEAR	SHEET NO.	TOTAL SHEETS
HAWAII	HAW.	360AB-01-88	1988	8	35

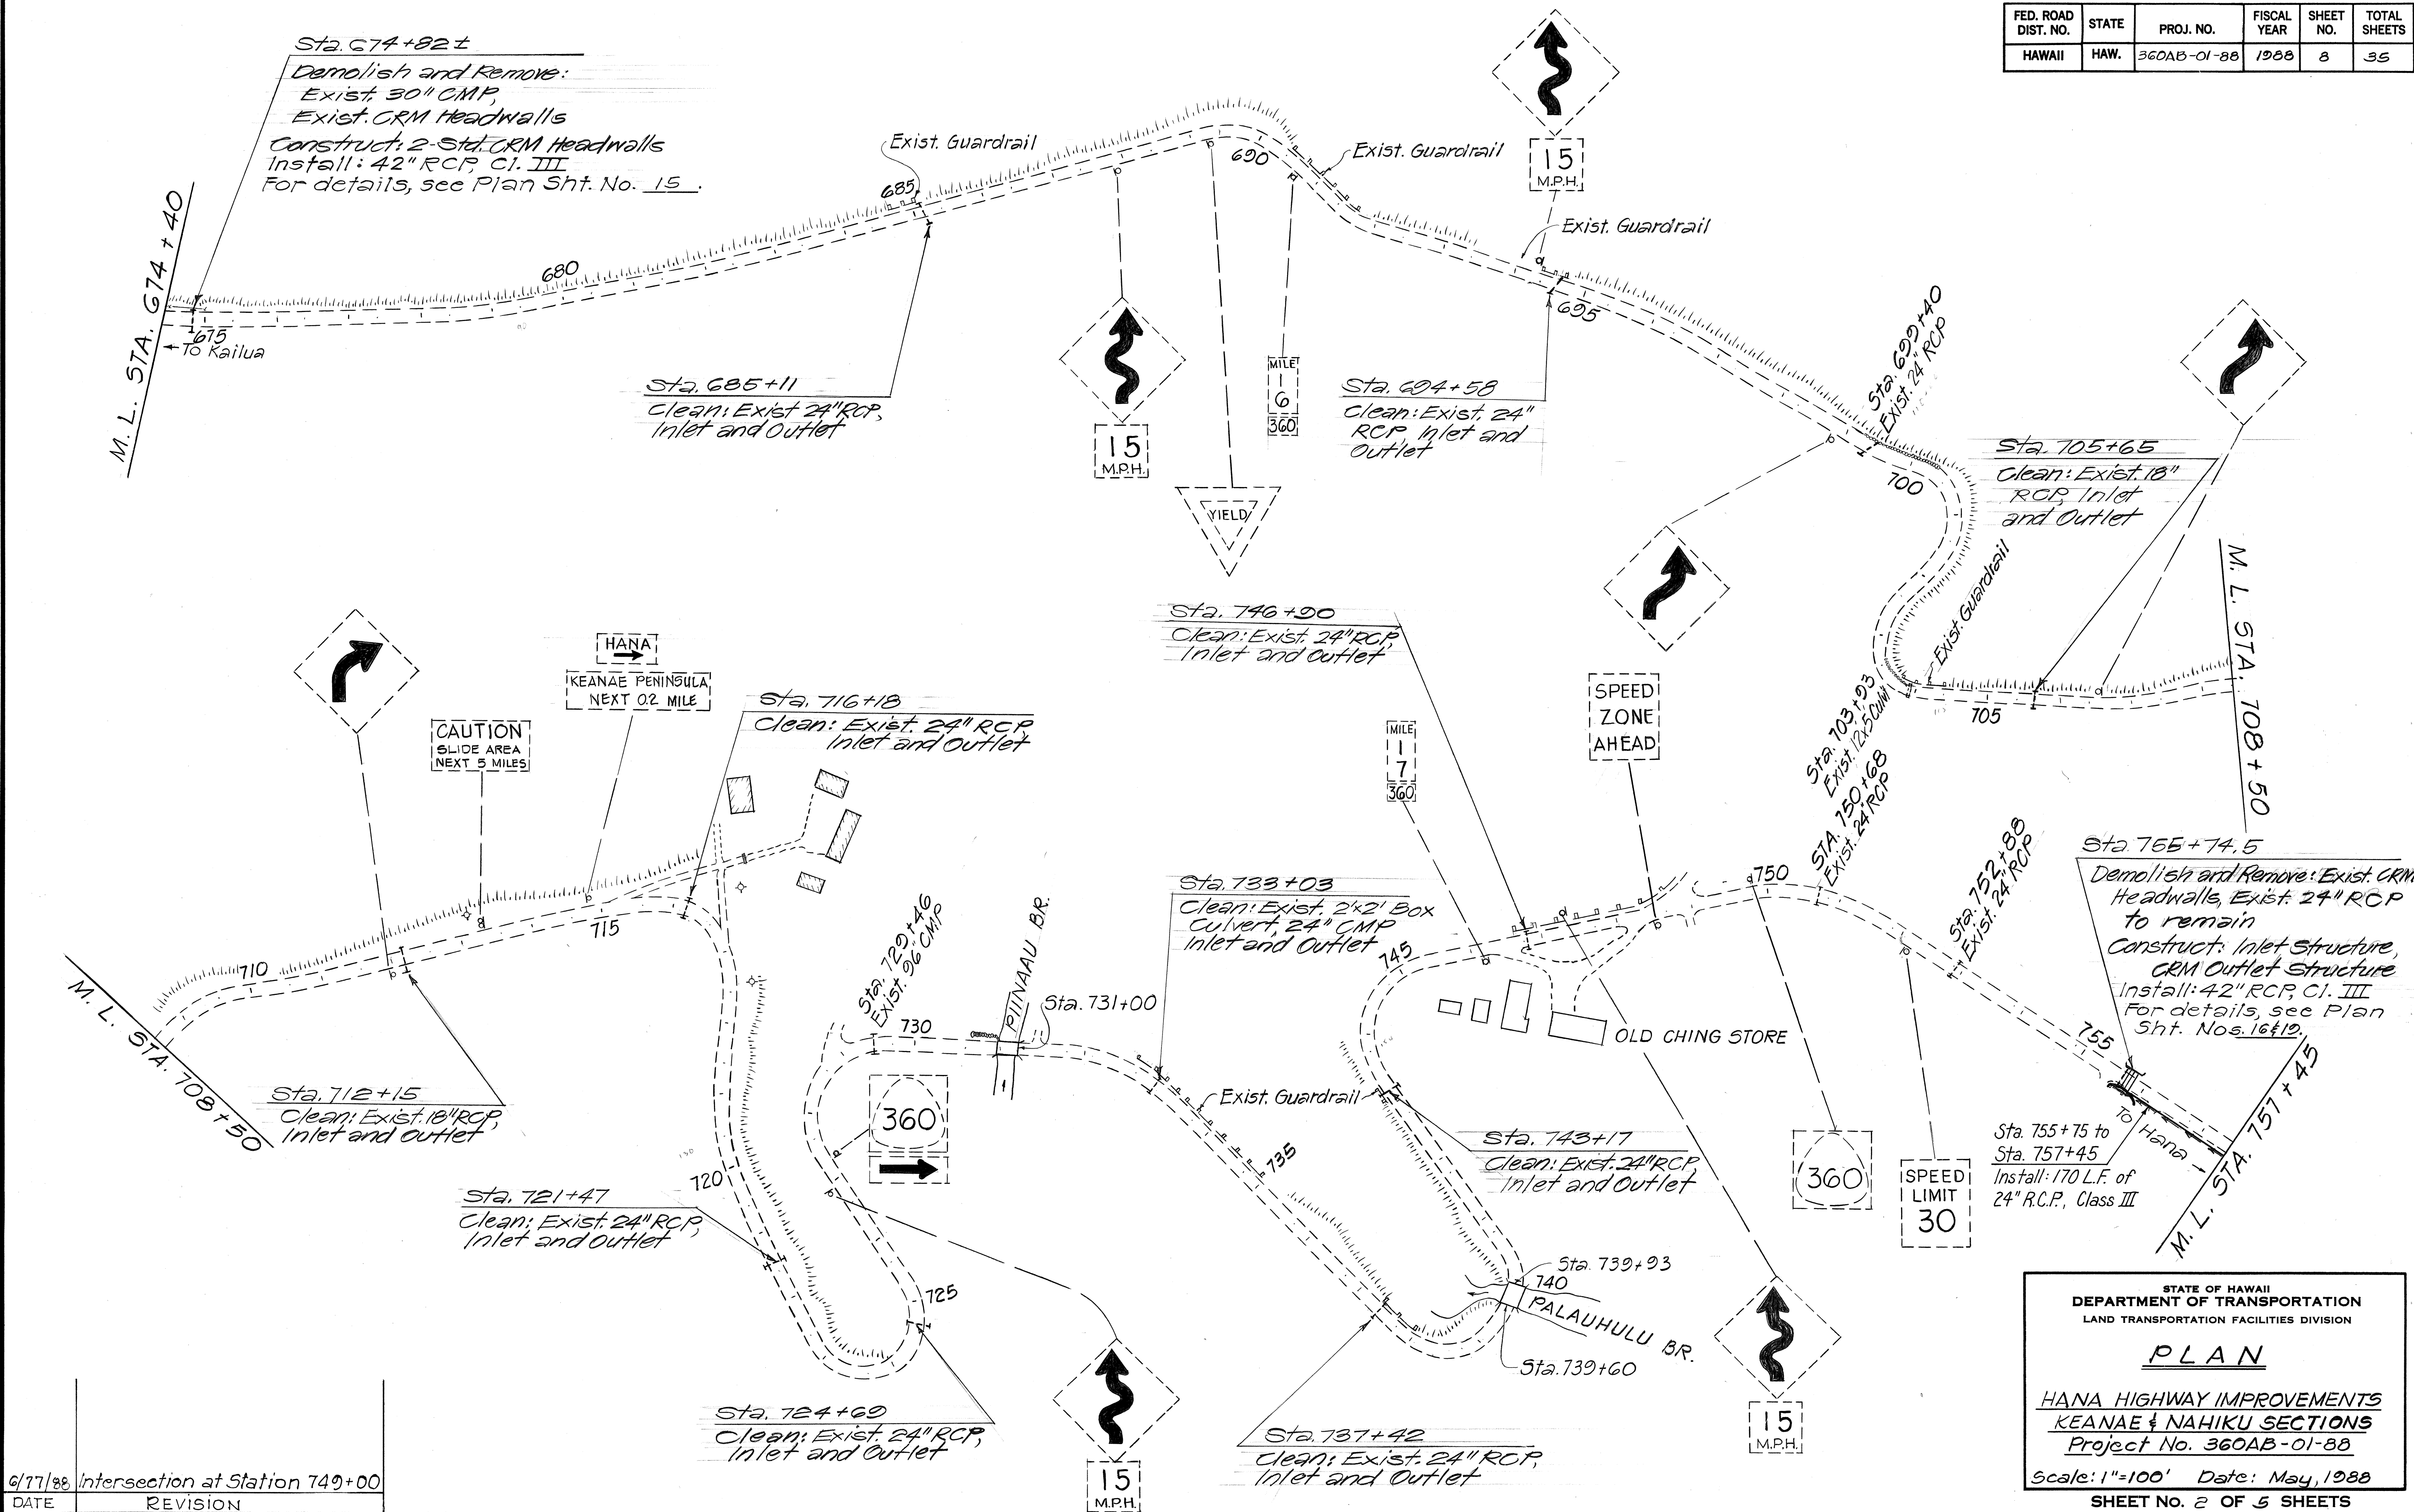

STATE OF HAWAII
DEPARTMENT OF TRANSPORTATION
LAND TRANSPORTATION FACILITIES DIVISION


PLAN

HANA HIGHWAY IMPROVEMENTS
KEANAE & NAHIKU SECTIONS
Project No. 360AB-01-88

Scale: 1"=100' Date: May, 1988
SHEET NO. 2 OF 5 SHEETS

6/77/88	Intersection at Station 749+00
DATE	REVISION

FED. ROAD DIST. NO.	STATE	PROJ. NO.	FISCAL YEAR	SHEET NO.	TOTAL SHEETS
HAWAII	HAW.	360AB-01-88	1988	9	35

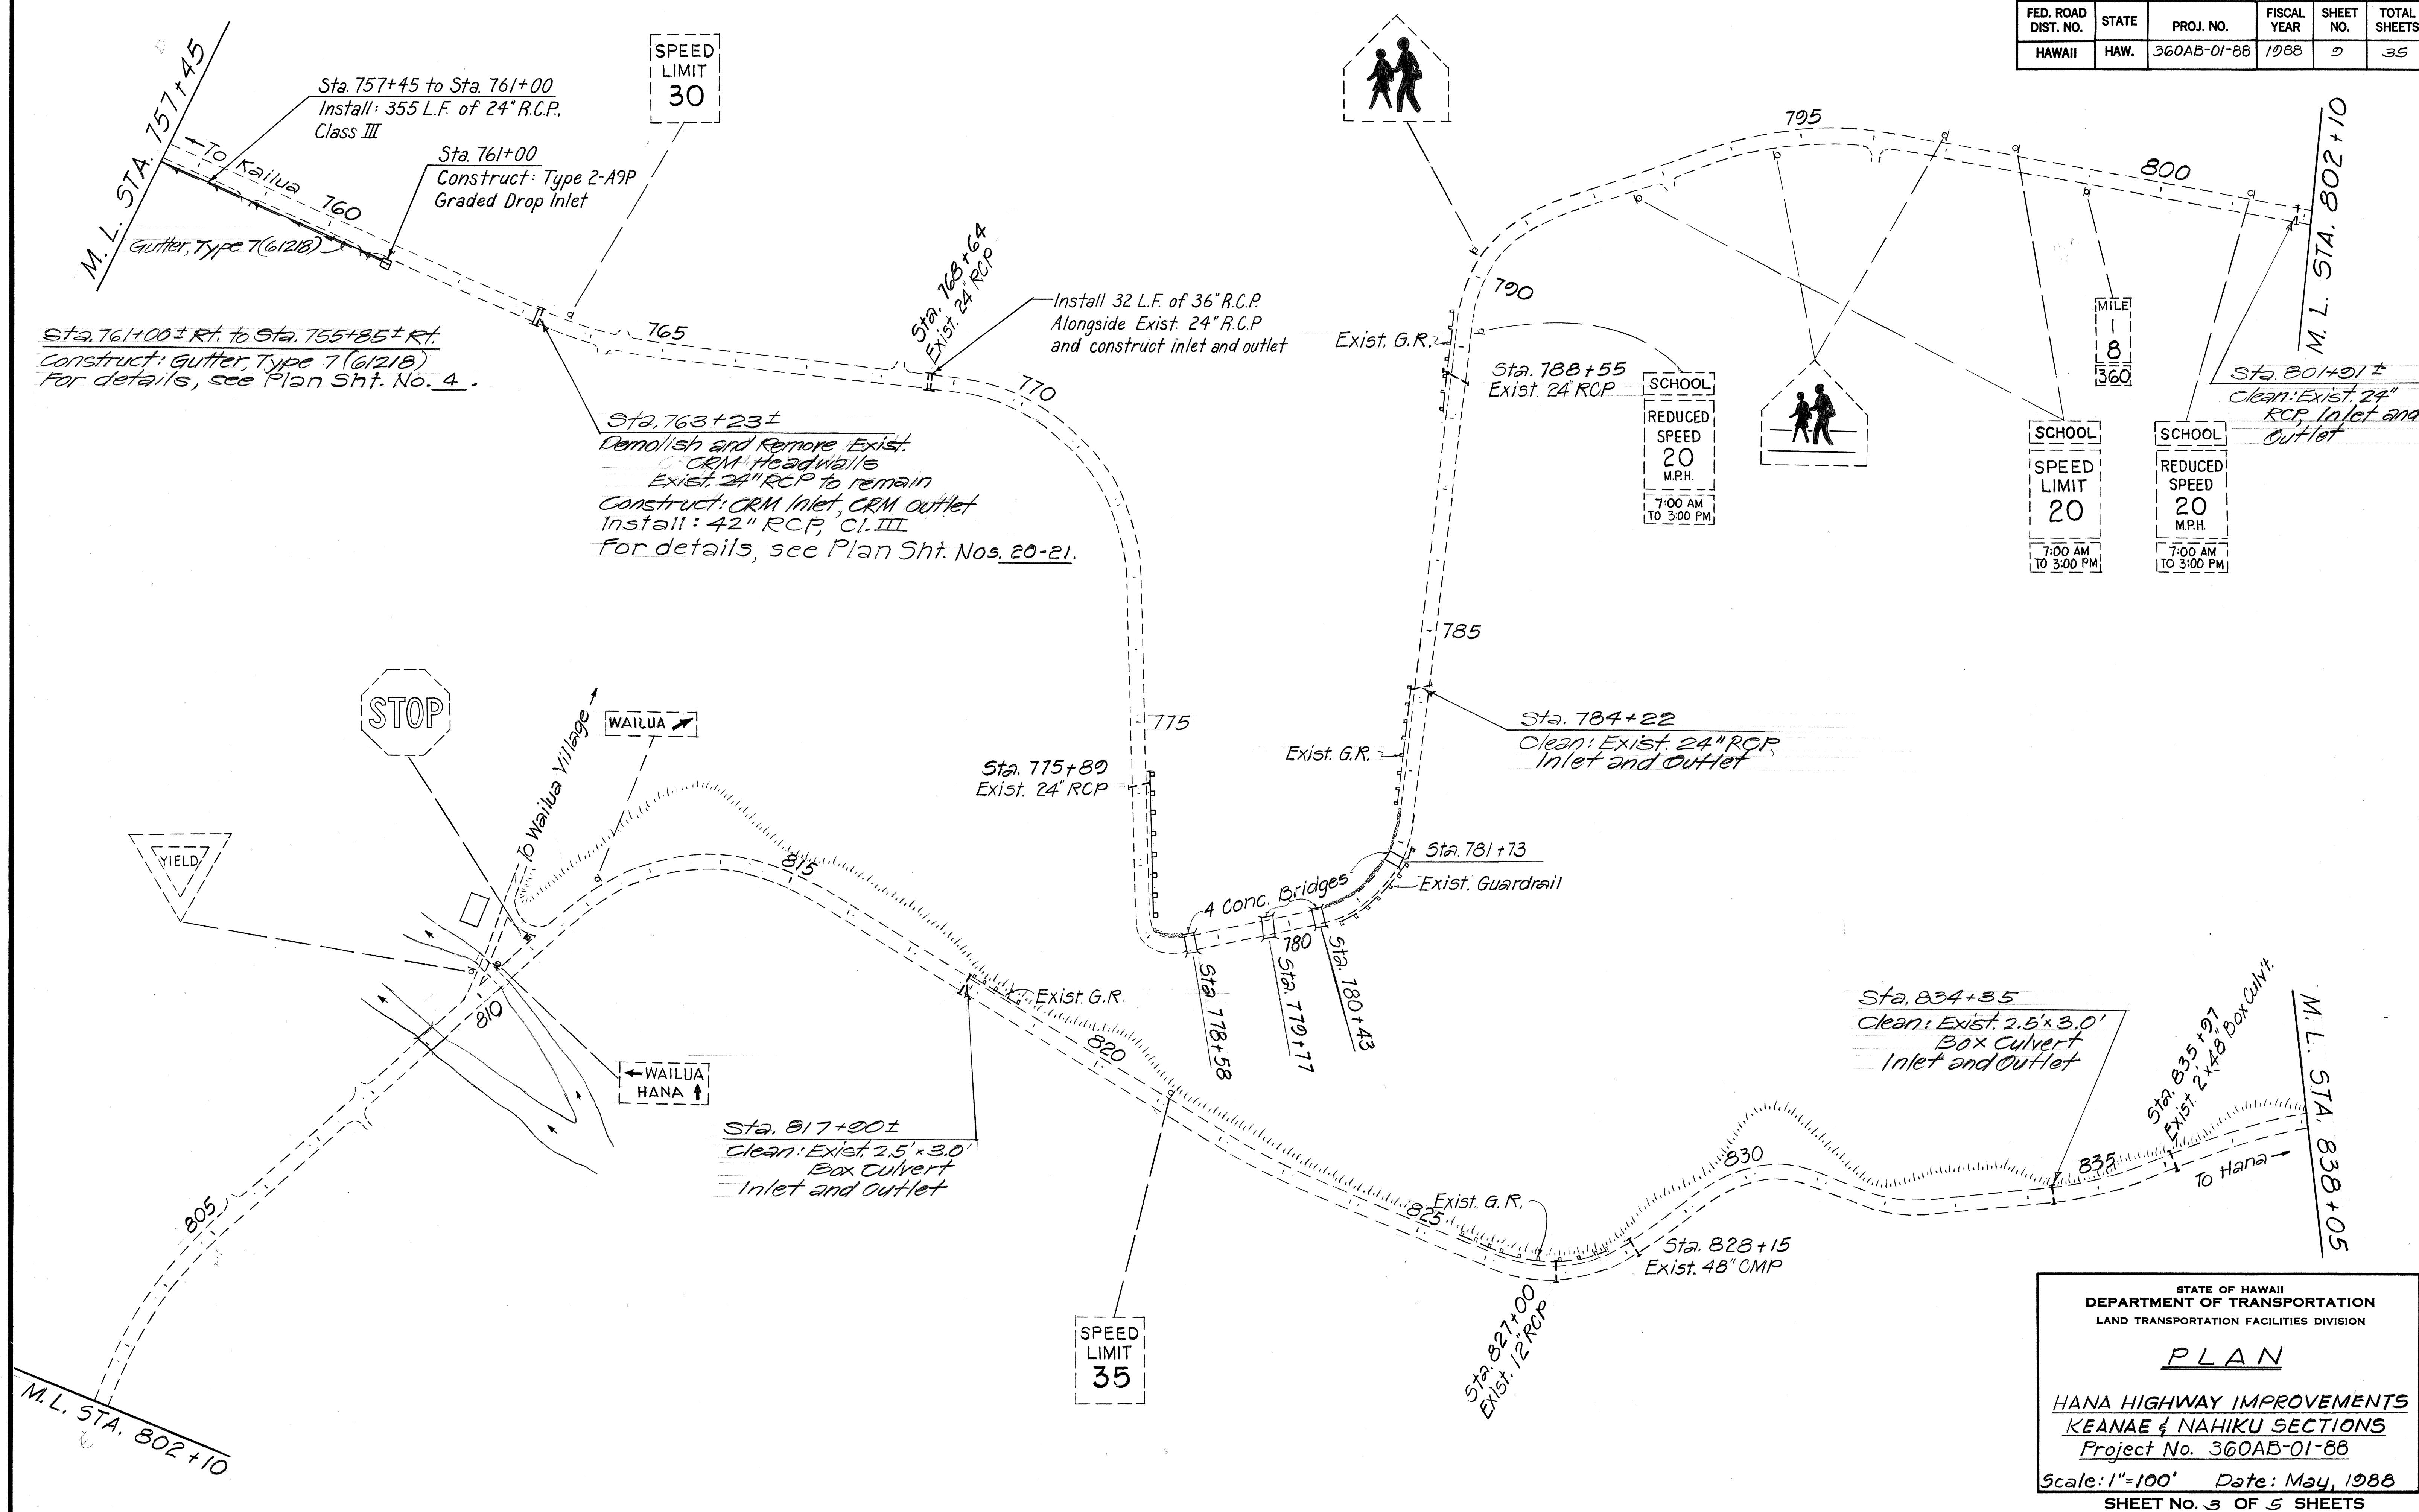

DATE	_____
DESIGNED BY	_____
CHECKED BY	_____
NOTED BY	_____
QUANTITIES BY	_____
ORIGINAL PLAN	_____


STATE OF HAWAII
DEPARTMENT OF TRANSPORTATION
LAND TRANSPORTATION FACILITIES DIVISION

PLAN

**HANA HIGHWAY IMPROVEMENTS
KEANAE & NAHIKU SECTIONS**
Project No. 360AB-01-88

Scale: 1"=100' Date: May, 1988
SHEET NO. 3 OF 5 SHEETS

FED. ROAD DIST. NO.	STATE	PROJ. NO.	FISCAL YEAR	SHEET NO.	TOTAL SHEETS
HAWAII	HAW.	360AB-01-88	1988	10	35

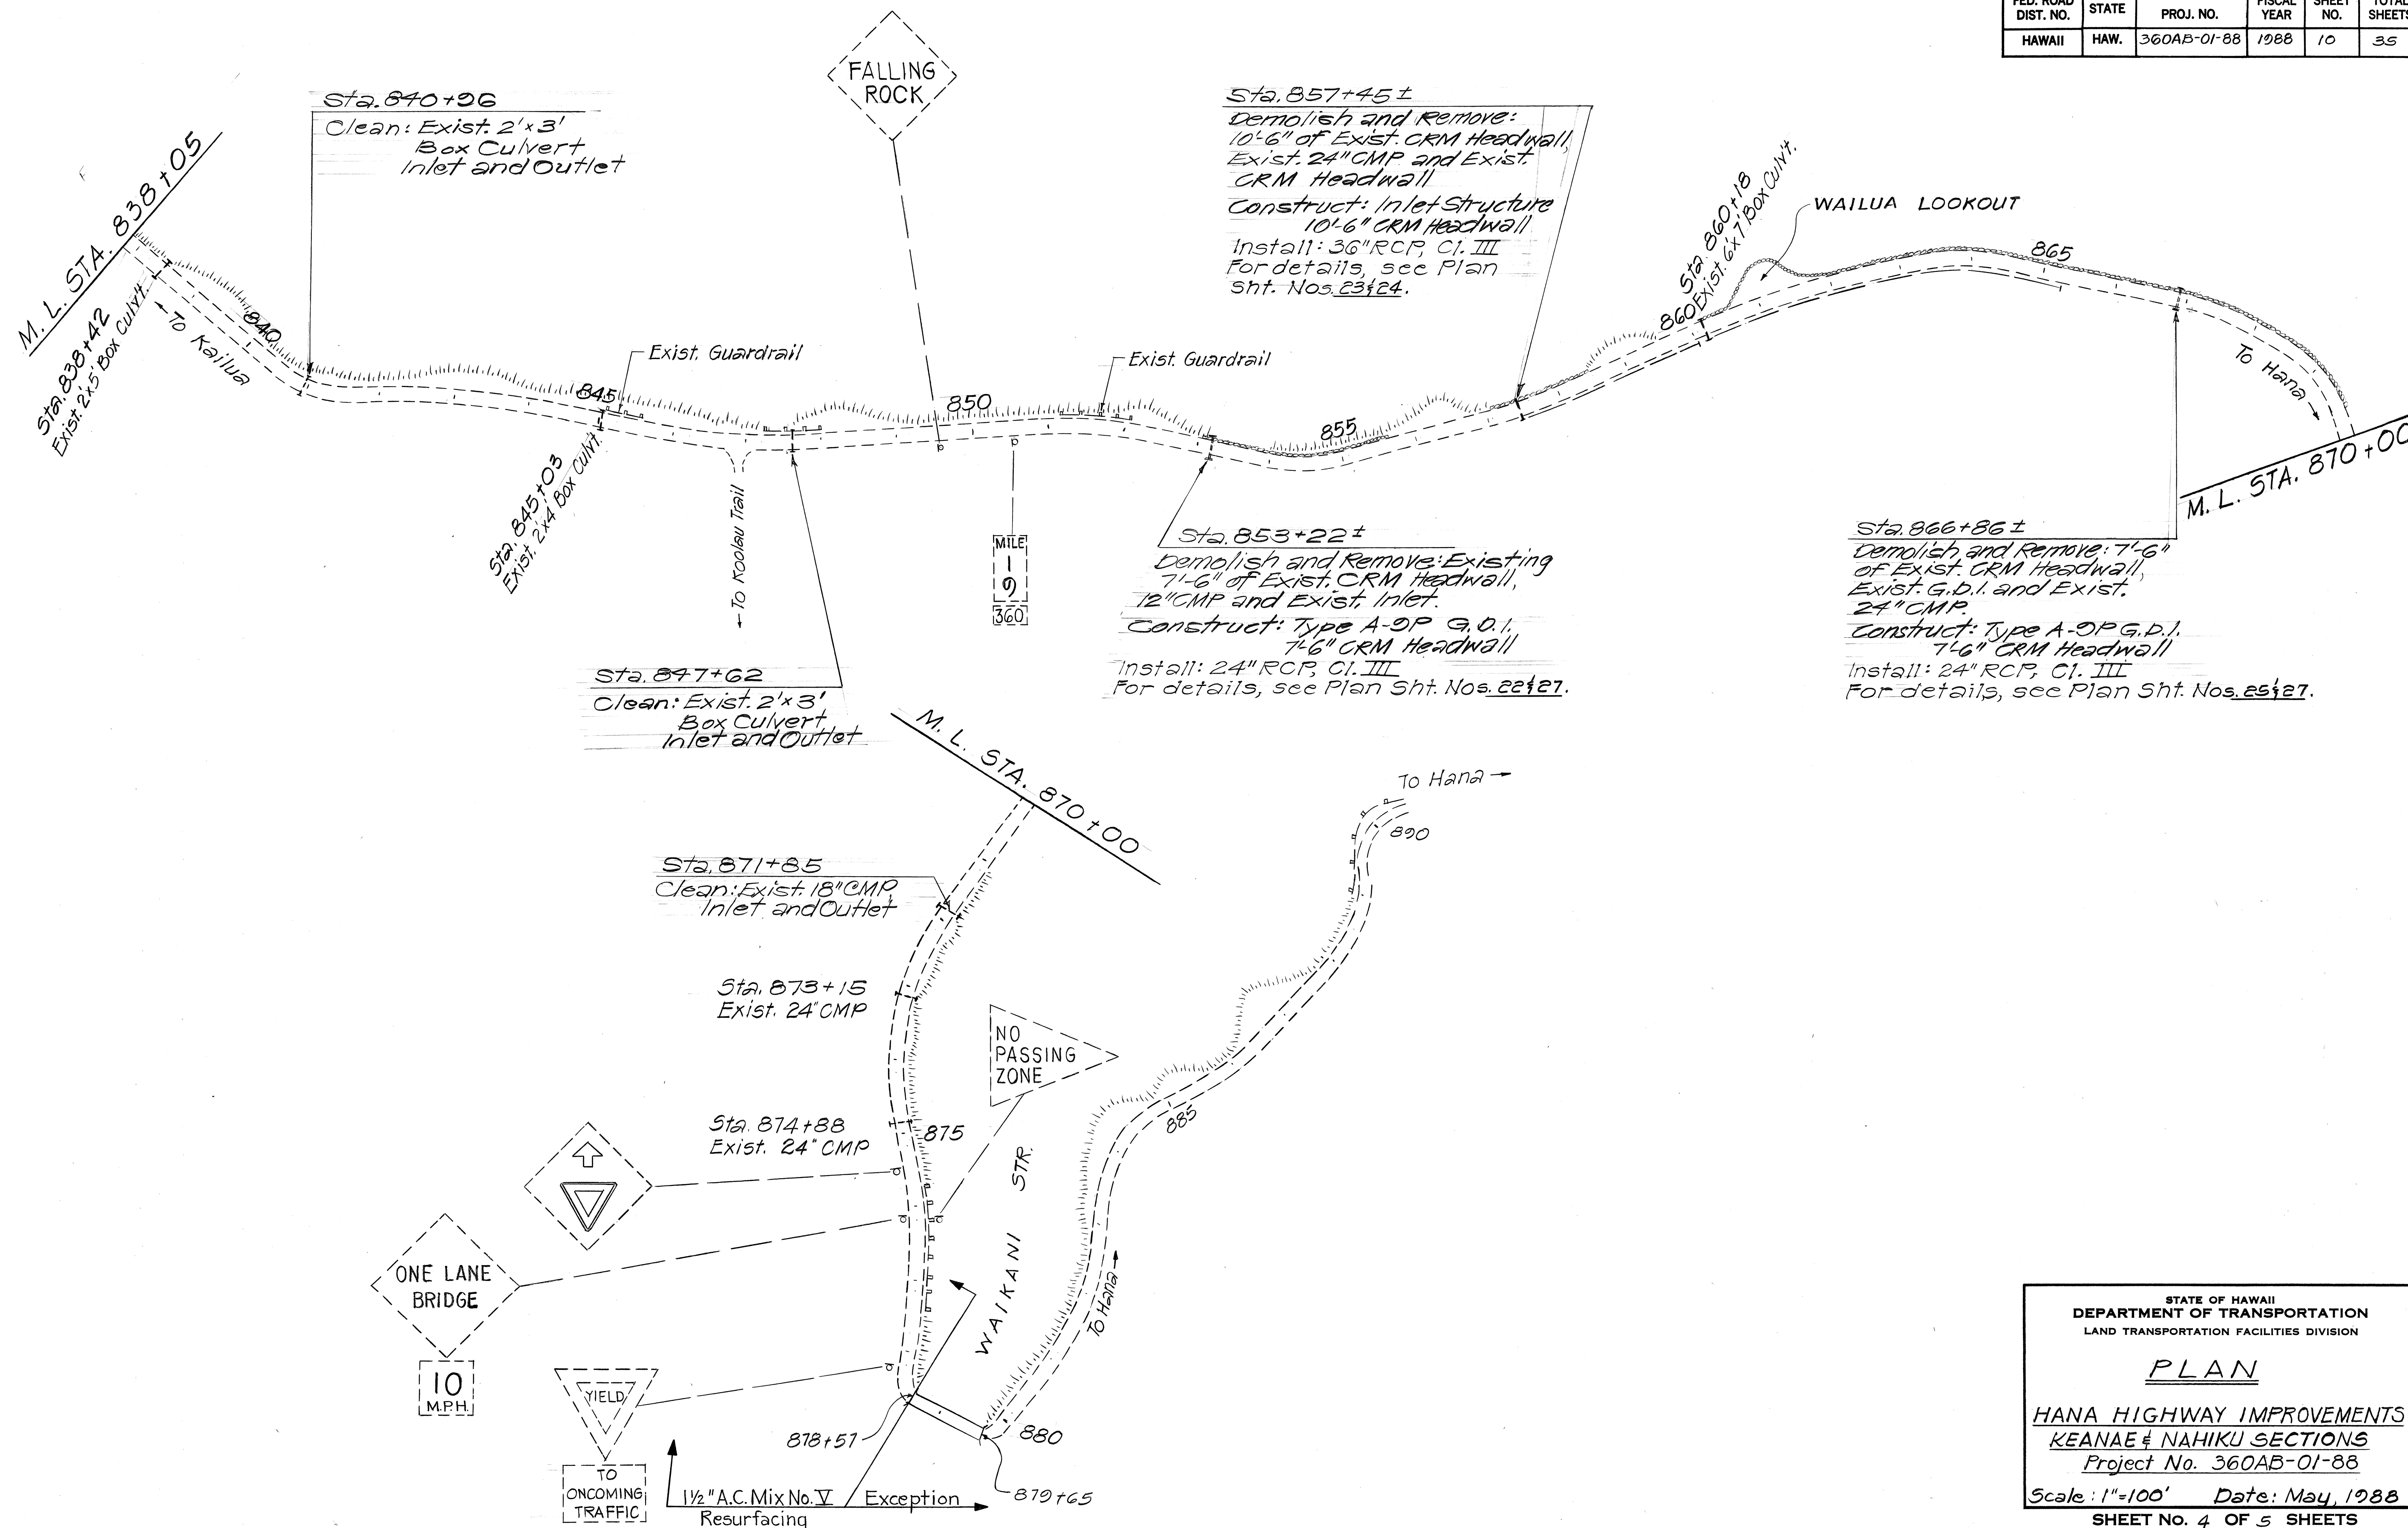

STATE OF HAWAII
DEPARTMENT OF TRANSPORTATION
LAND TRANSPORTATION FACILITIES DIVISION


PLAN

HANA HIGHWAY IMPROVEMENTS
KEANAE & NAHIKU SECTIONS
Project No. 360AB-01-88

Scale: 1"=100' Date: May, 1988

SHEET No. 4 OF 5 SHEETS

FED. ROAD DIST. NO.	STATE	PROJ. NO.	FISCAL YEAR	SHEET NO.	TOTAL SHEETS
HAWAII	HAW.	360AB-01-88	1988	11	35

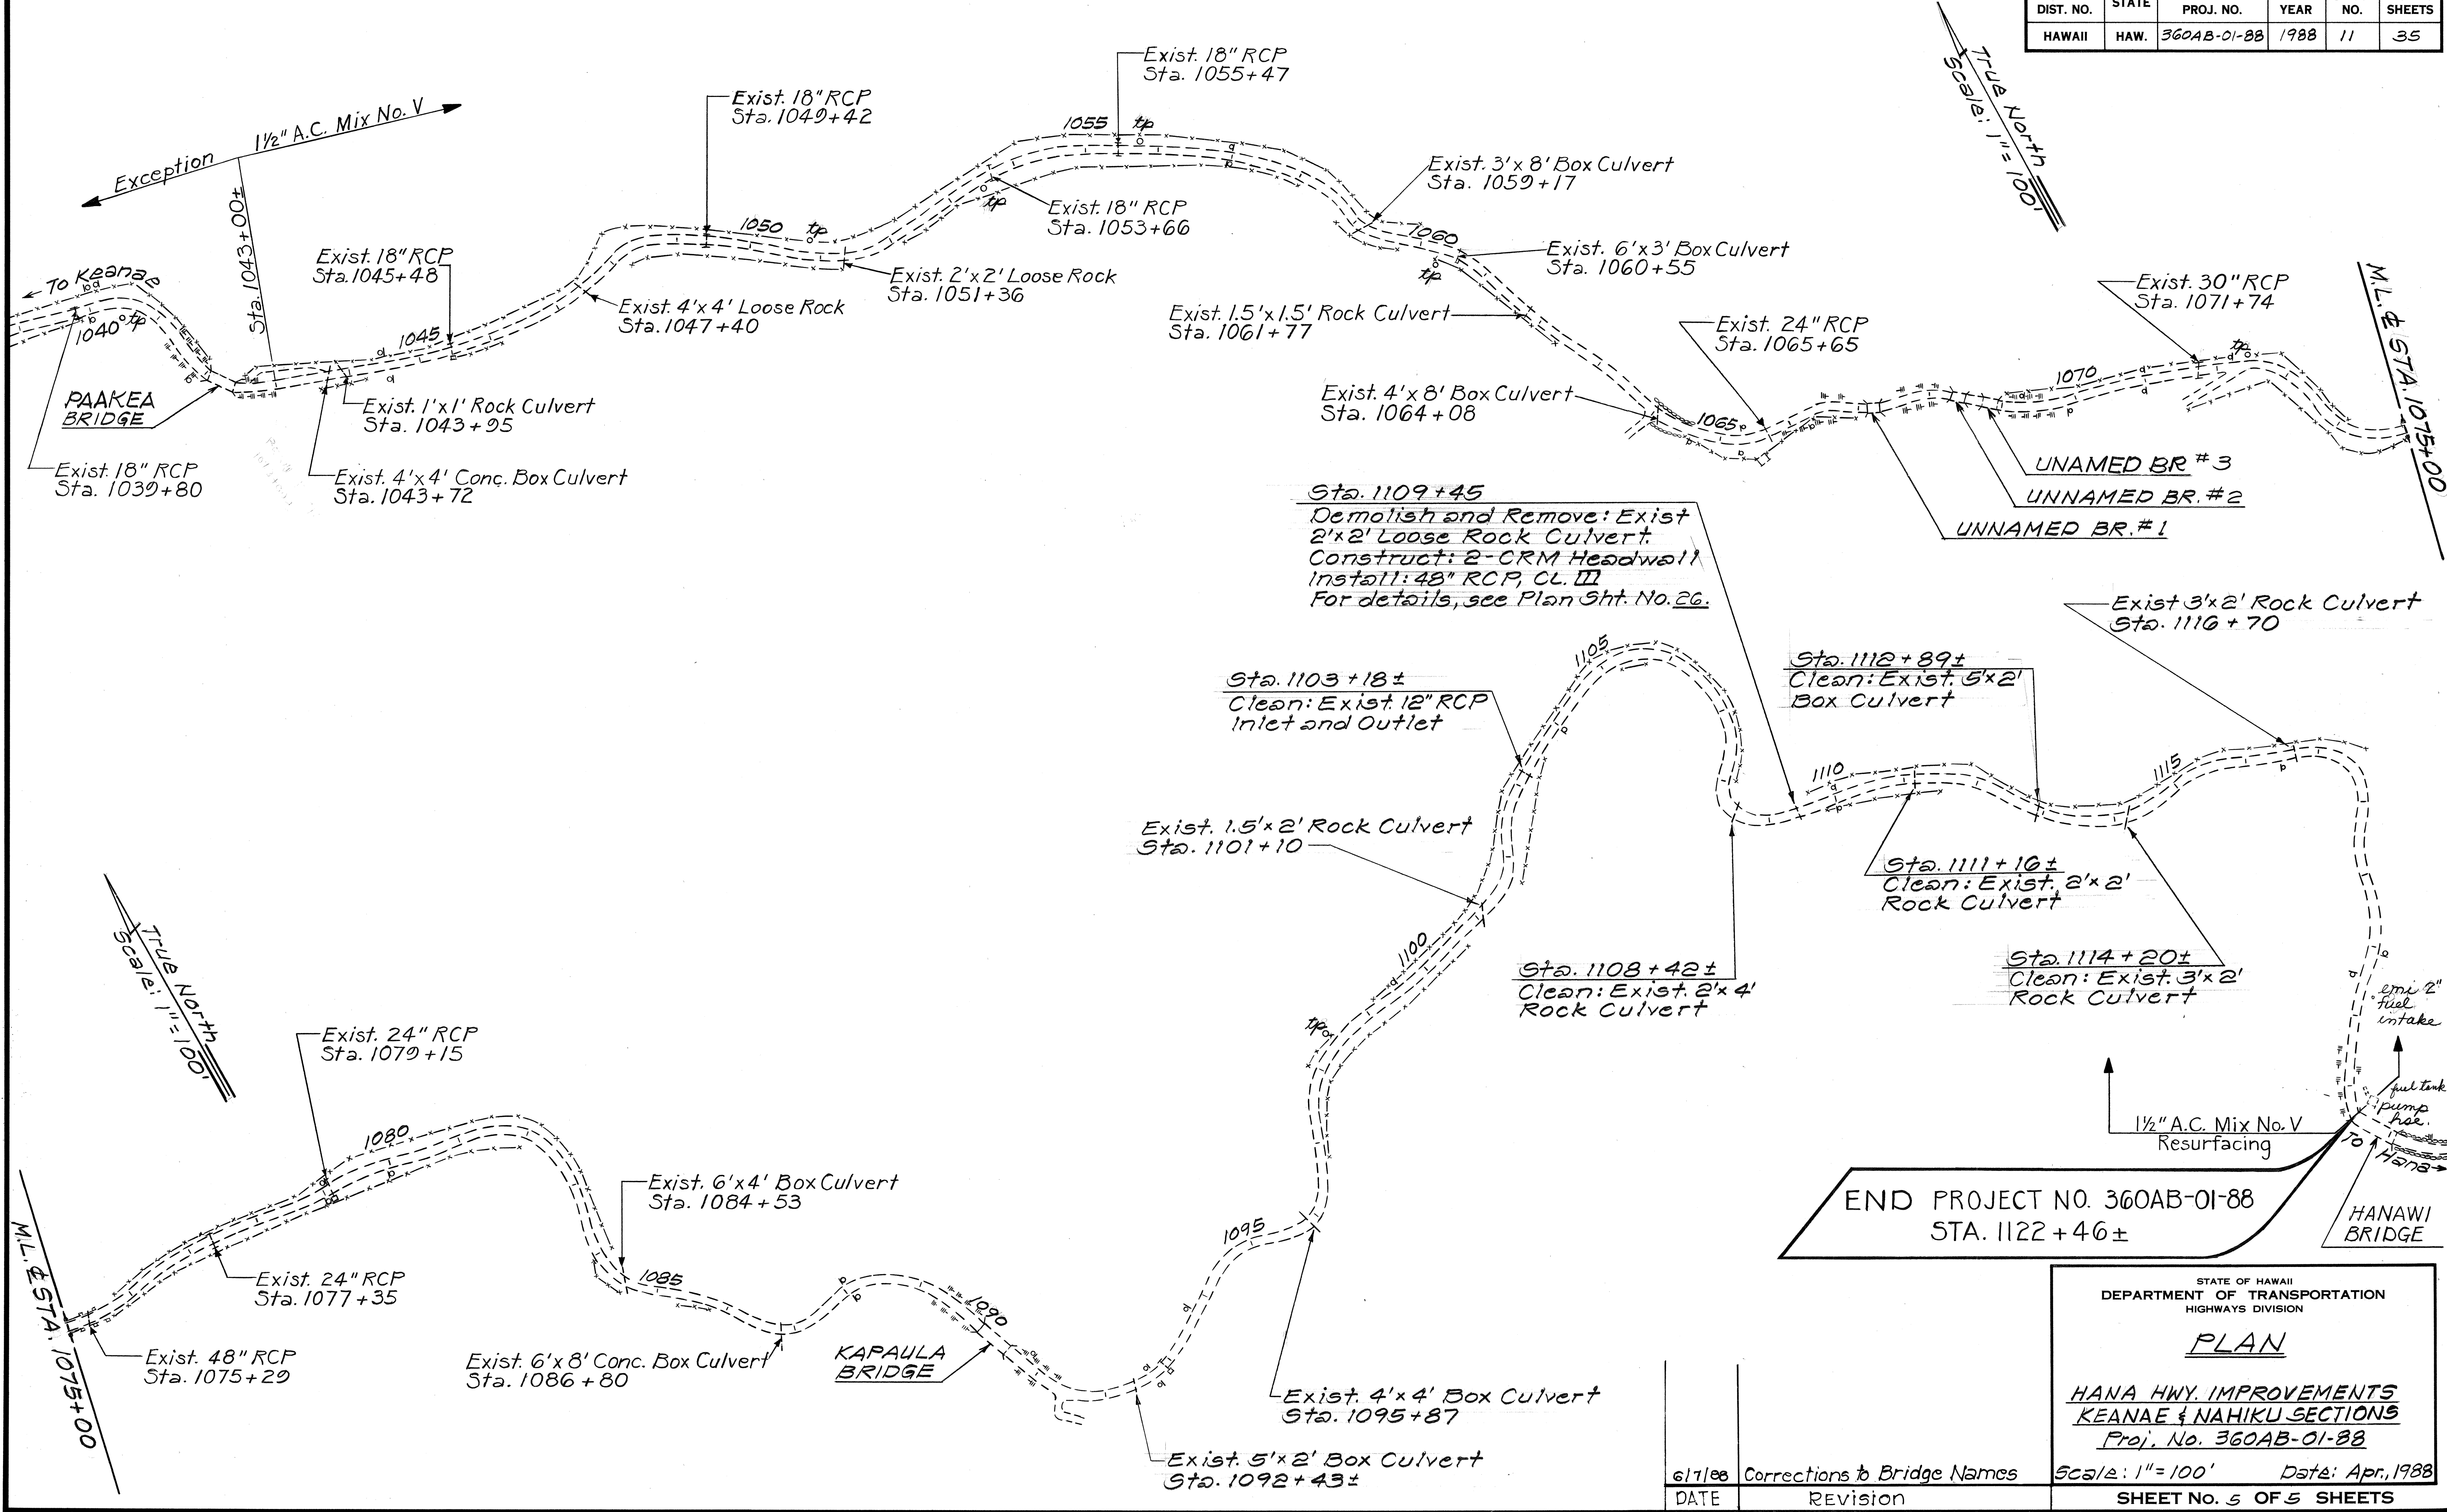

SURVEY PLOTTED BY	DATE
DRAWN BY	
DESIGNED BY	
NOTED BY	
CHECKED BY	

6/1/88	Corrections to Bridge Names
DATE	Revision

STATE OF HAWAII
DEPARTMENT OF TRANSPORTATION
HIGHWAYS DIVISION

PLAN

HANA HWY. IMPROVEMENTS
KEANAE & NAHIKU SECTIONS
Proj. No. 360AB-01-88

Scale: 1"=100' Date: Apr., 1988

SHEET NO. 5 OF 5 SHEETS