	INDEX TO DRAWINGS
SHEET NO.	DESCRIPTION
1	TITLE SHEET
2	STANDARD PLANS SUMMARY SHEET
3	TYPICAL SECTIONS & GEN. NOTES
4	DETAILS AND SCHEDULES
<u> </u>	GUARDRAIL SCHEDULE & DETAILS
7 - 11	PLAN
12 - 27	DRAINAGE PLAN, PROFILE & DETAILS
28 - 35	SIGNING AND PAVEMENT MARKING PLAN AND DETAILS
2	
	· · · · · · · · · · · · · · · · · · ·
	,
:	
	•


Plan Sht. Nos. (1) ADD. 5 S-1, (2) C.O. 35 S-1, C.O. 35 S-2, C.O. 35 S-3 are supplementary sheets to this project. TOTAL SHEET COUNT after "AS BUILT" postings: 39 Sheets.

STATE OF HAWAII

DEPARTMENT OF TRANSPORTATION HIGHWAYS DIVISION HONOLULU, HAWAII "AS-BUILT" PLANS FOR

HANA HIGHWAY IMPROVEMENTS KEANAE AND NAHIKU SECTIONS PROJECT NO. 360AB - 01 - 88

> DISTRICT OF HANA ISLAND OF MAUI

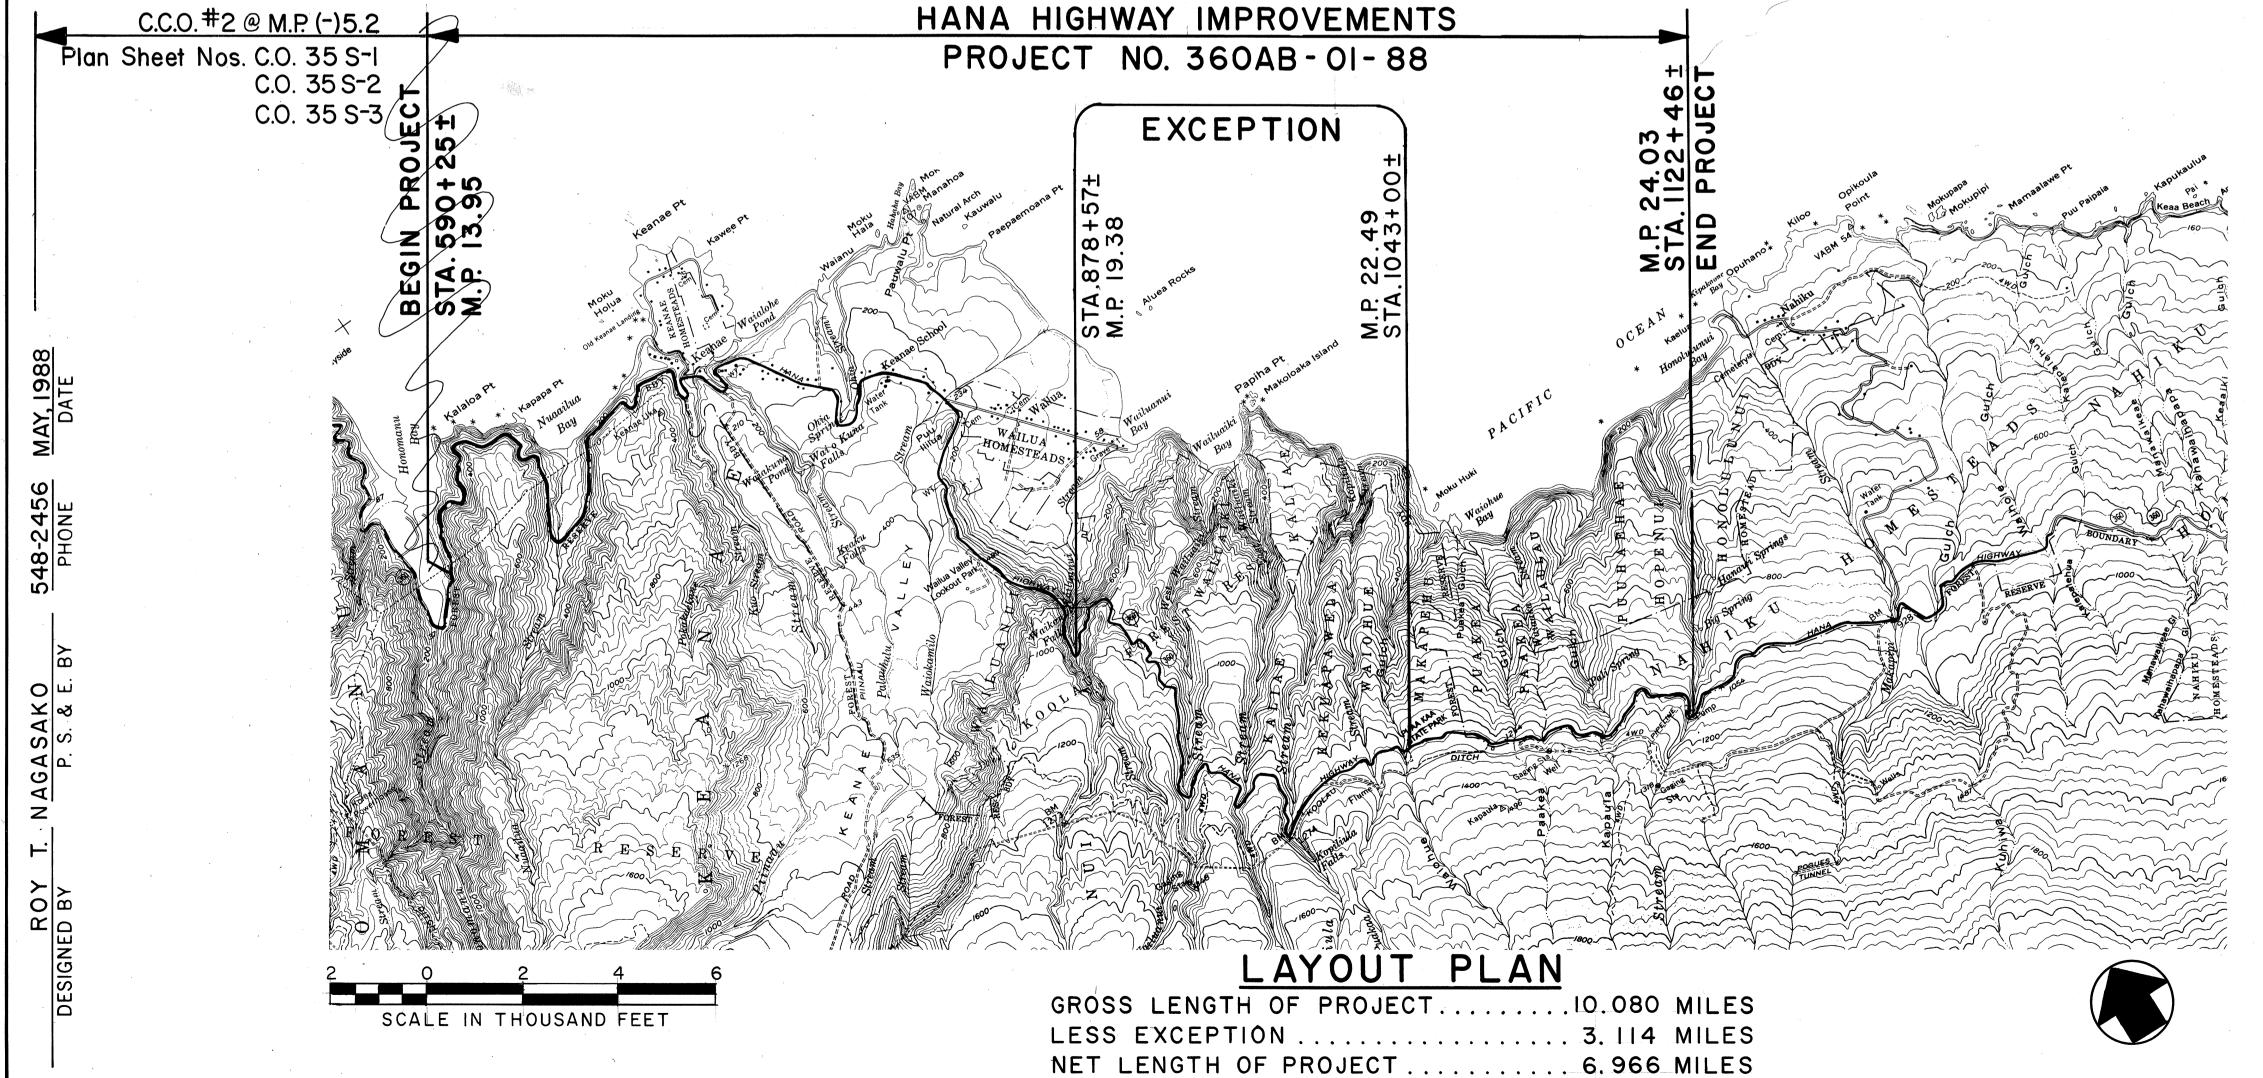

HAW. 360AB-01-88 360 STATE OF HAWAII LOCATION OF PROJECT LAHAINA HALEAKALA NATIONAL PARK KALAMA PARK

FED. ROAD DIST. NO.

FISCAL SHEET TOTAL YEAR NO. SHEETS

PROJ. NO.

OR UNDER CONSTRUCTION

SCALE IN MILES

CHANGES MADE DURING CONSTRUCTION HAVE BEEN INCORPORATED ON THESE PLANS EXCEPT CHANGES IN THE ORIGINAL THEORETICAL QUANTITIES. FOR ACTUAL QUANTITIES, REFER TO PROJECT LEDGER AND/OR COMPUTATION BOOK.

RESIDENT ENGINEER

DATE

DEPARTMENT OF TRANSPORTATION STATE OF HAWAII APPROVED: