




FED. ROAD DIST. NO.	STATE	FED. AID PROJ. NO.	FISCAL YEAR	SHEET NO.	TOTAL SHEETS
HAWAII	HAW.	360A-01-90M	1990	4	5

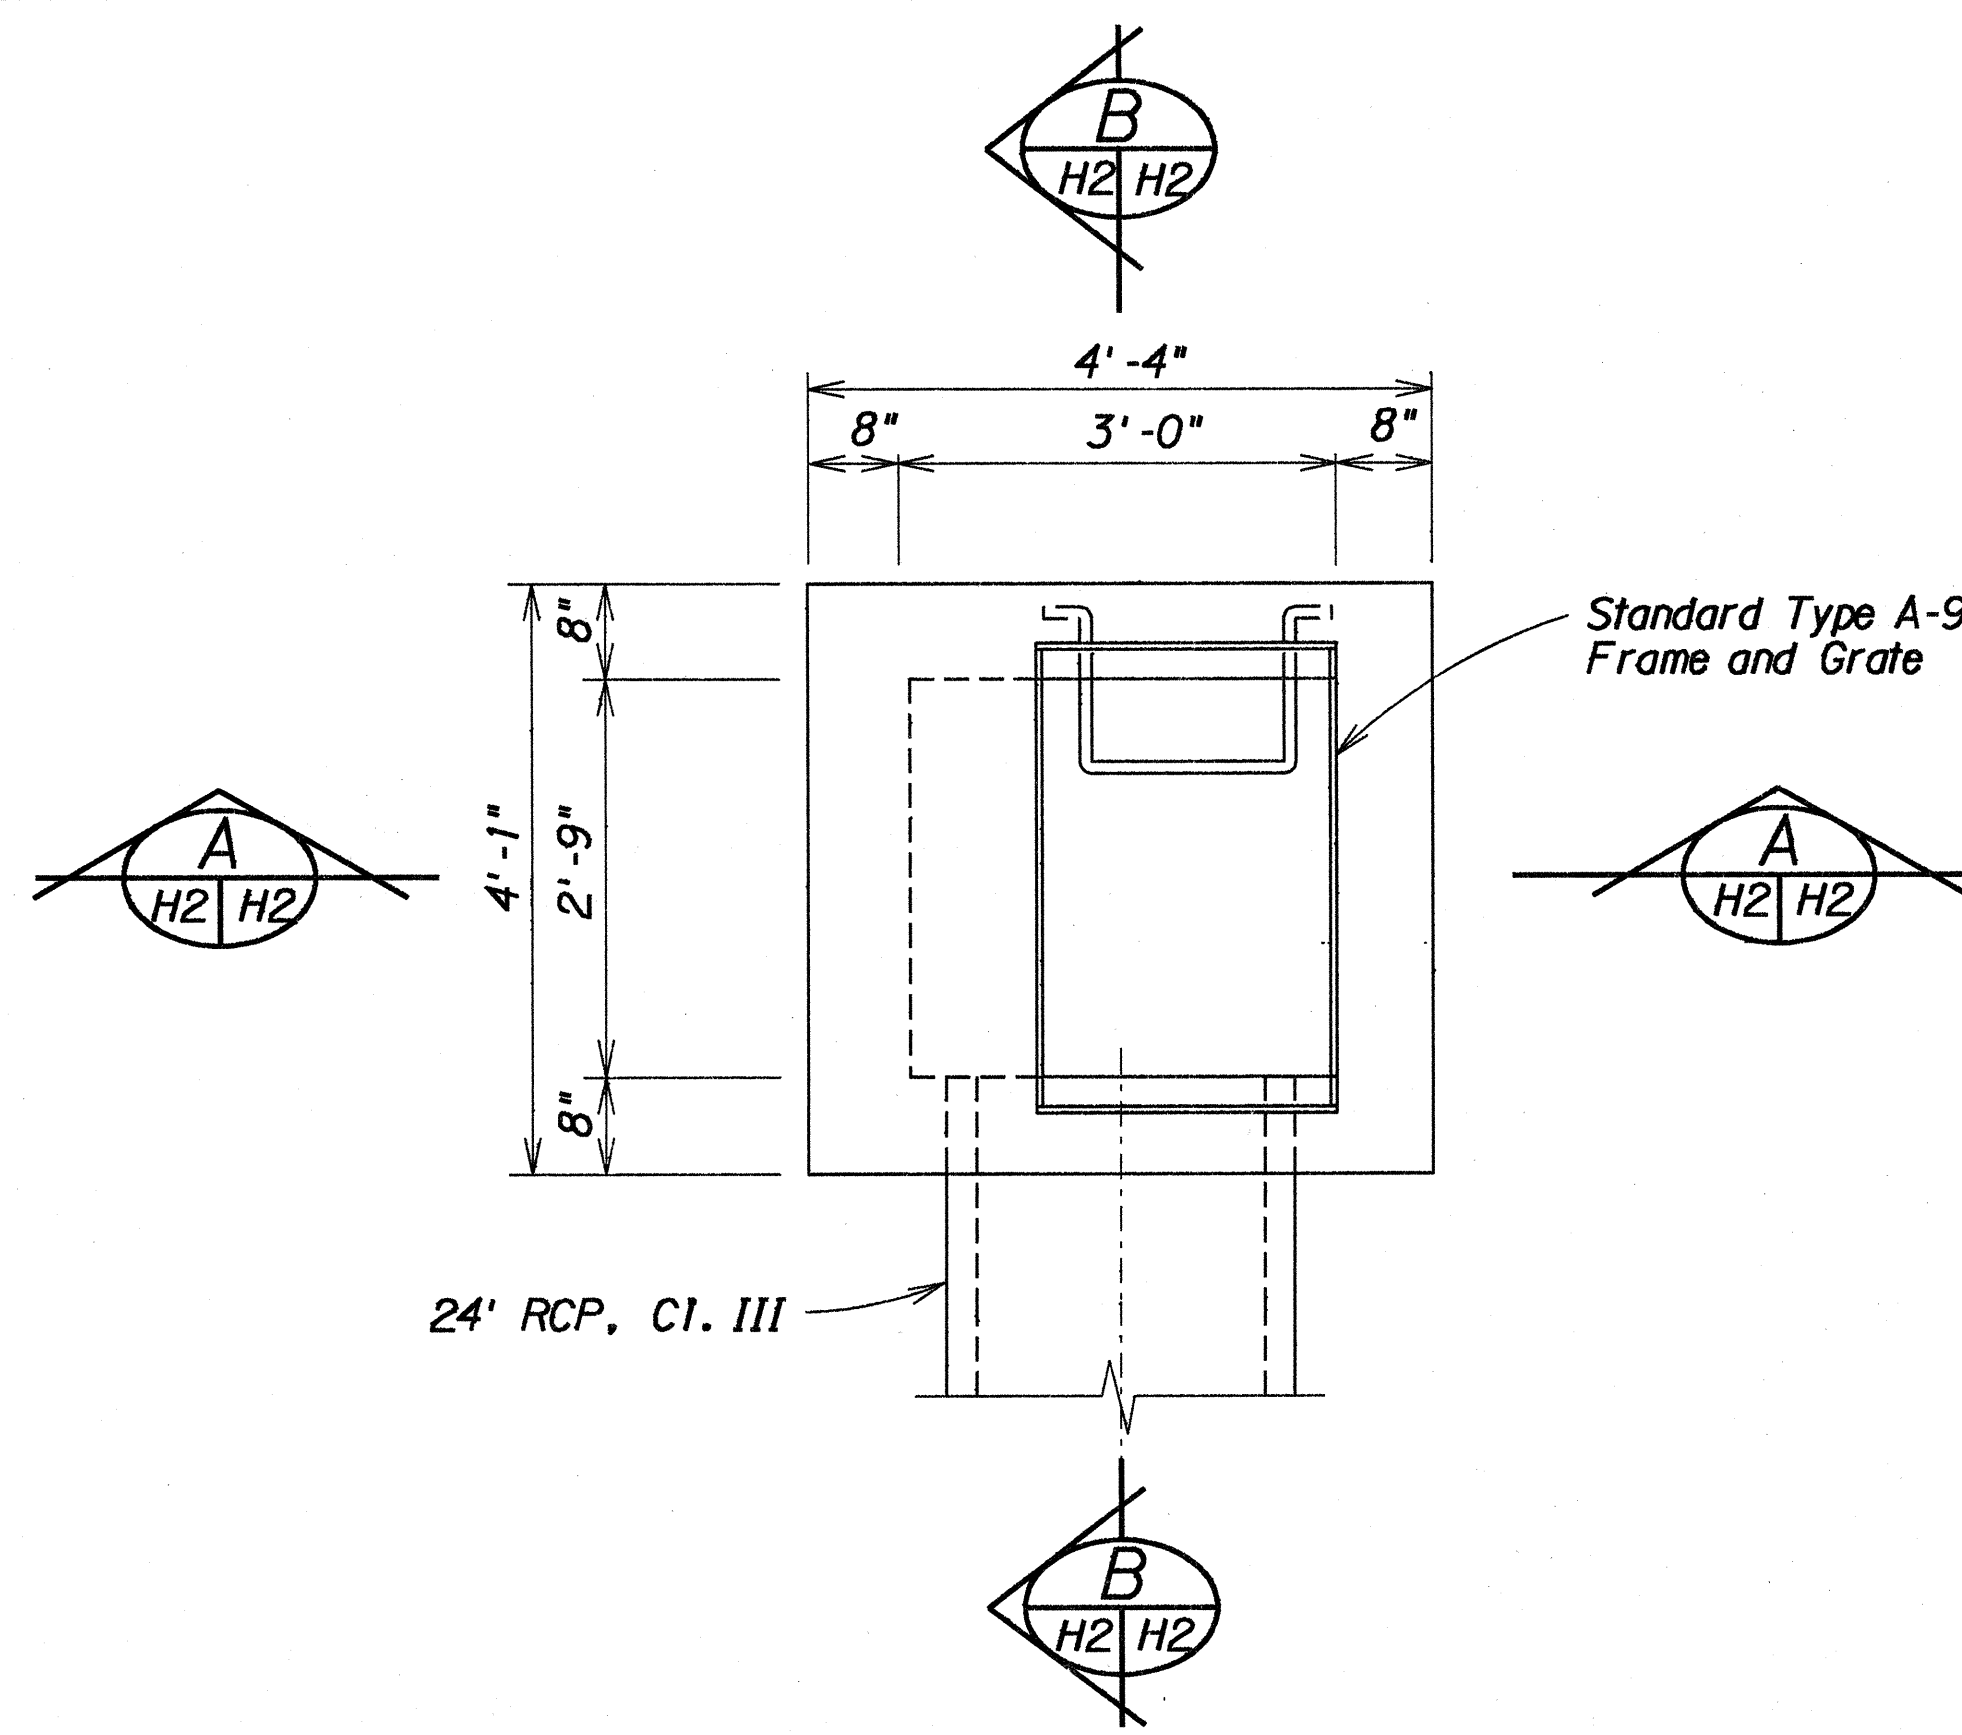


PLAN

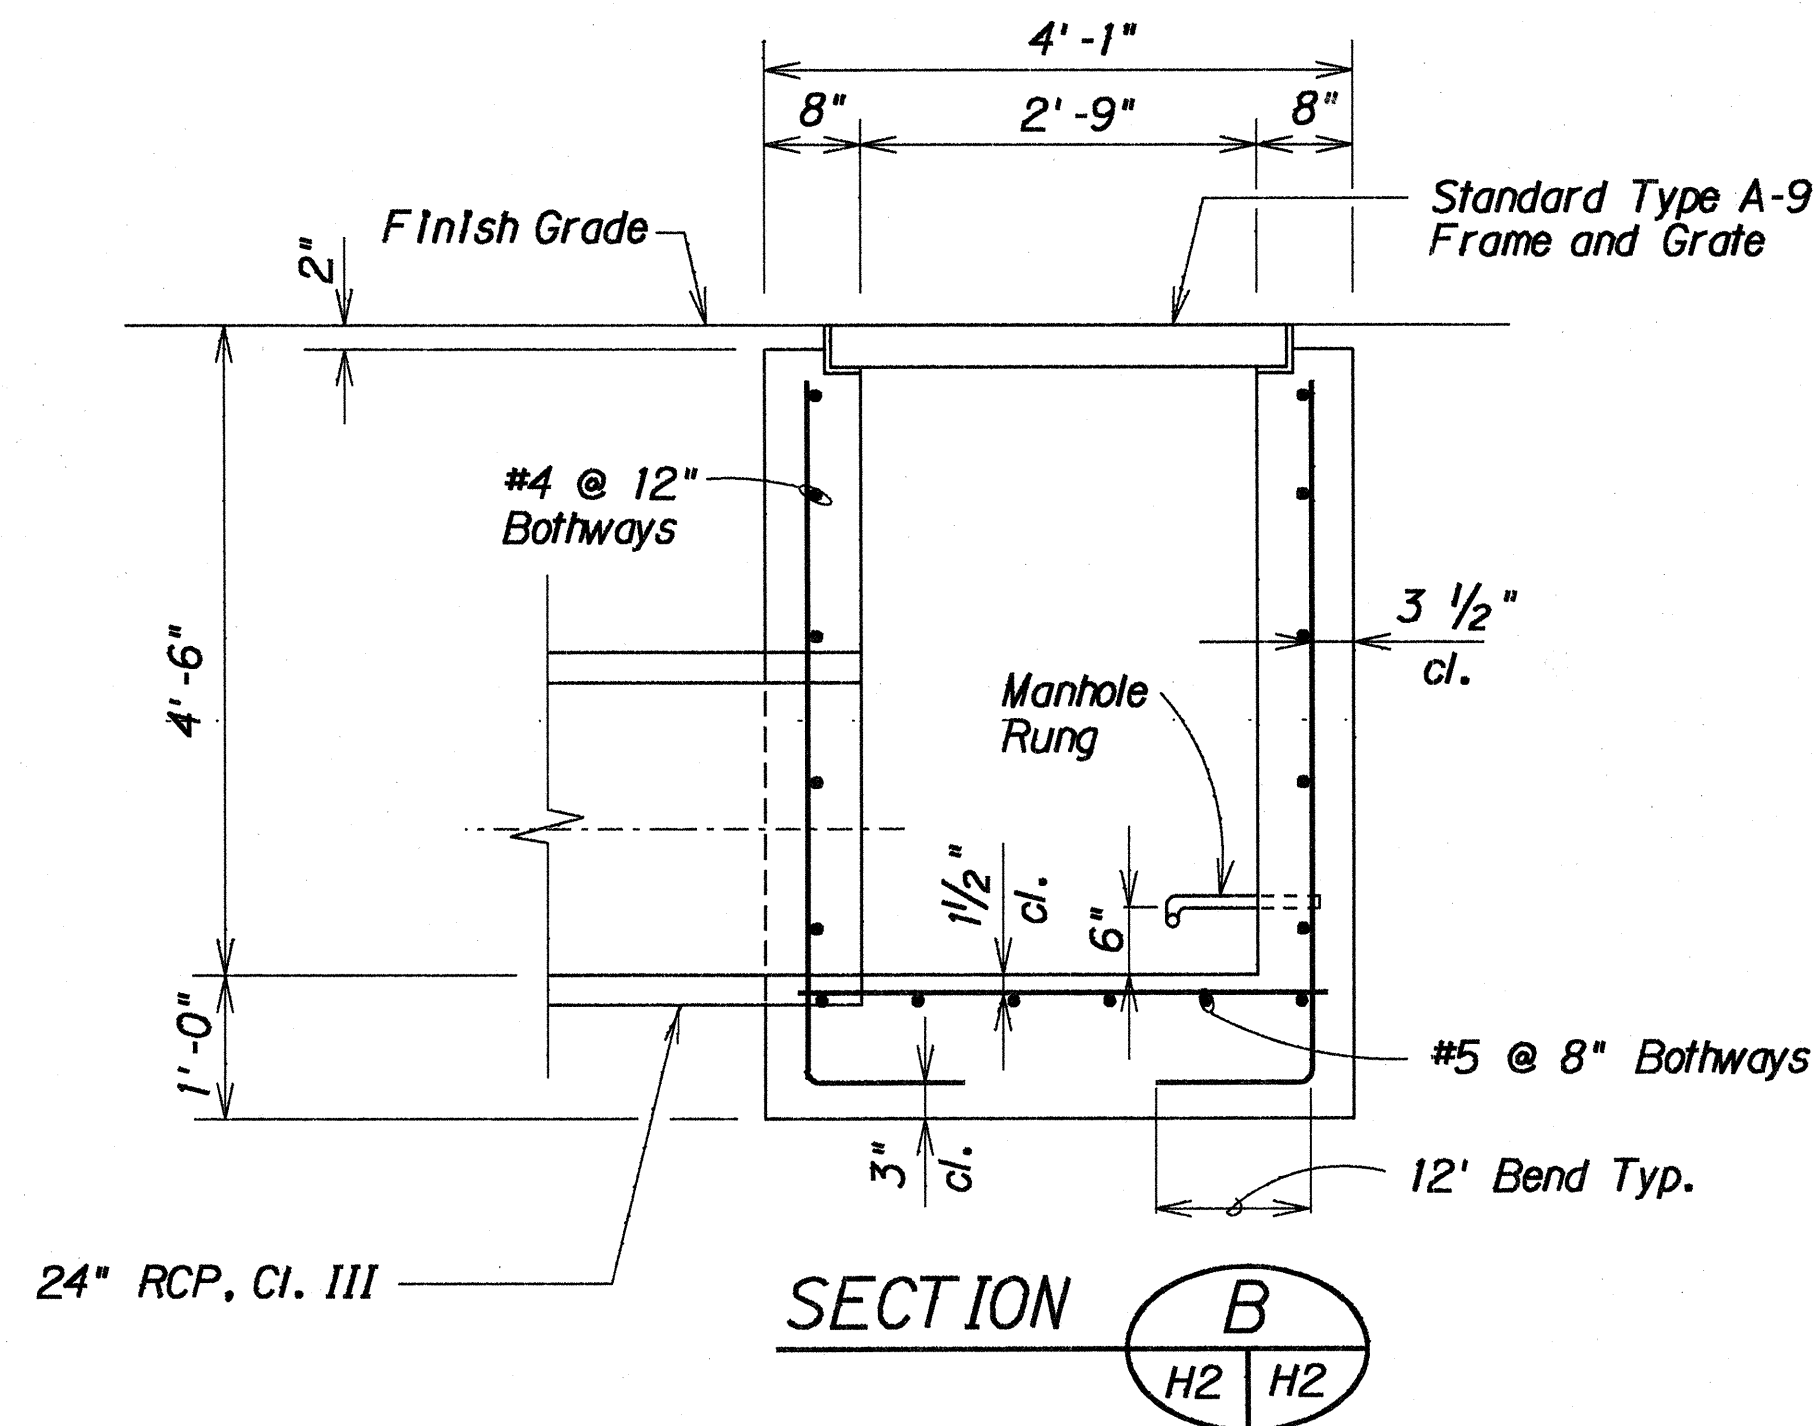


SECTION B
H2 H2

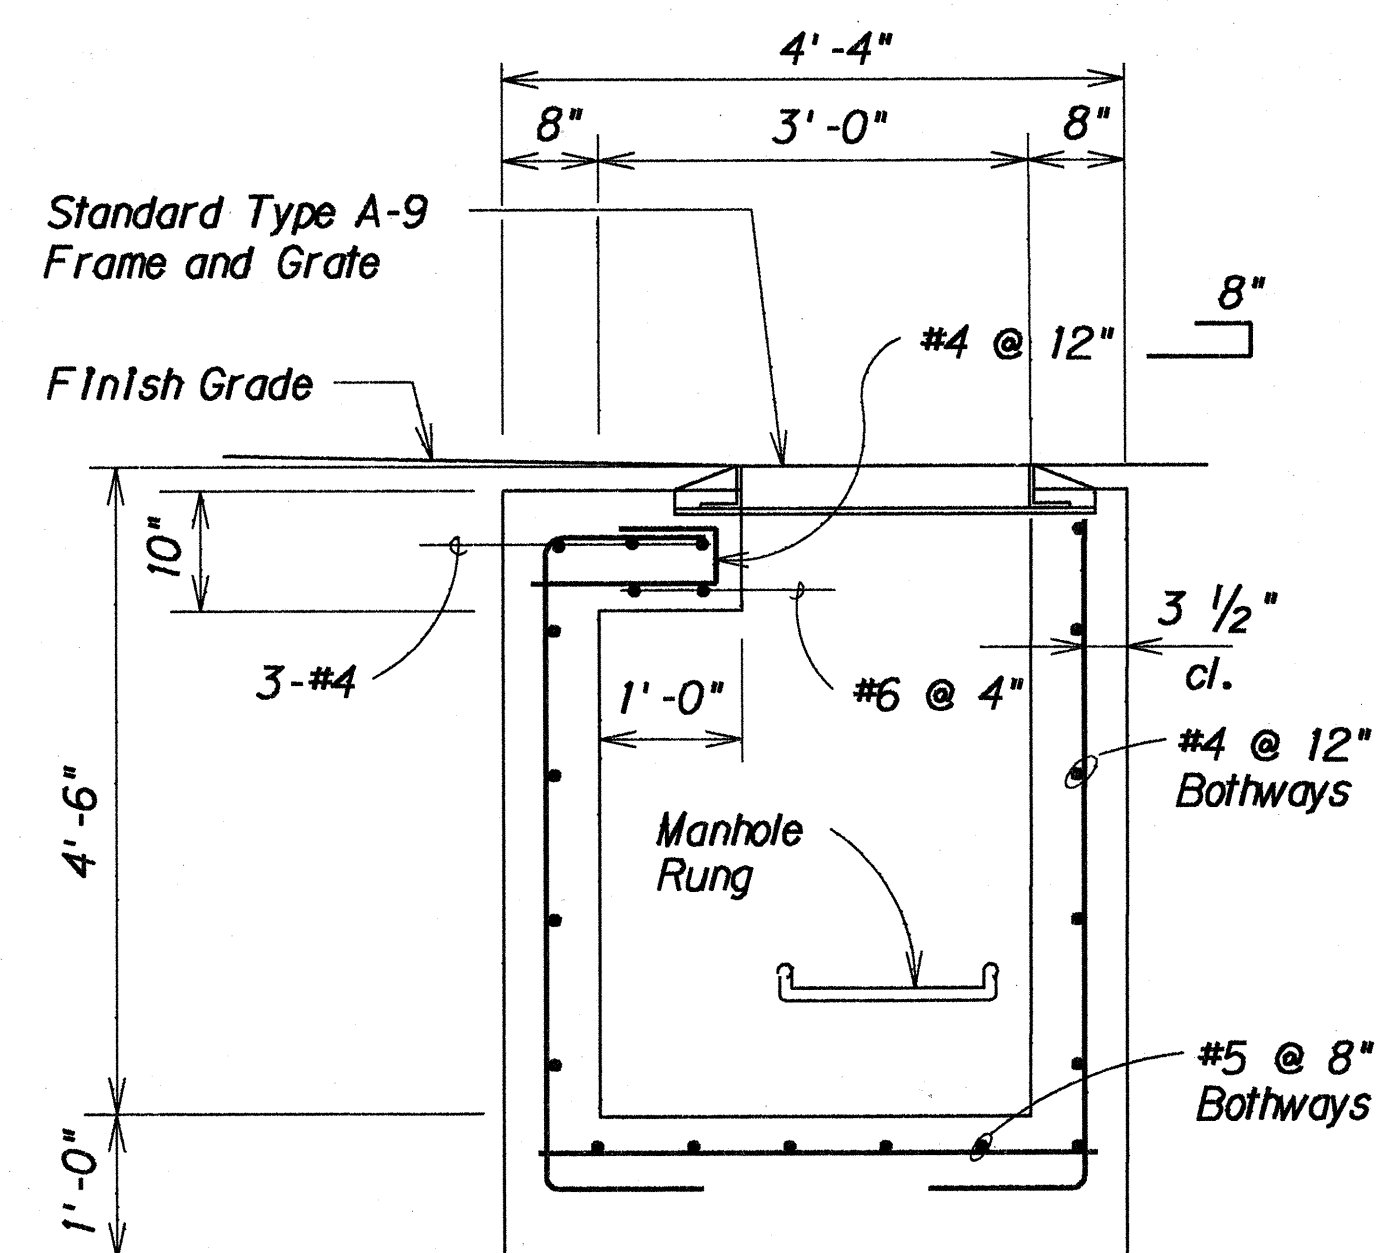

SECTION A
H2 H2

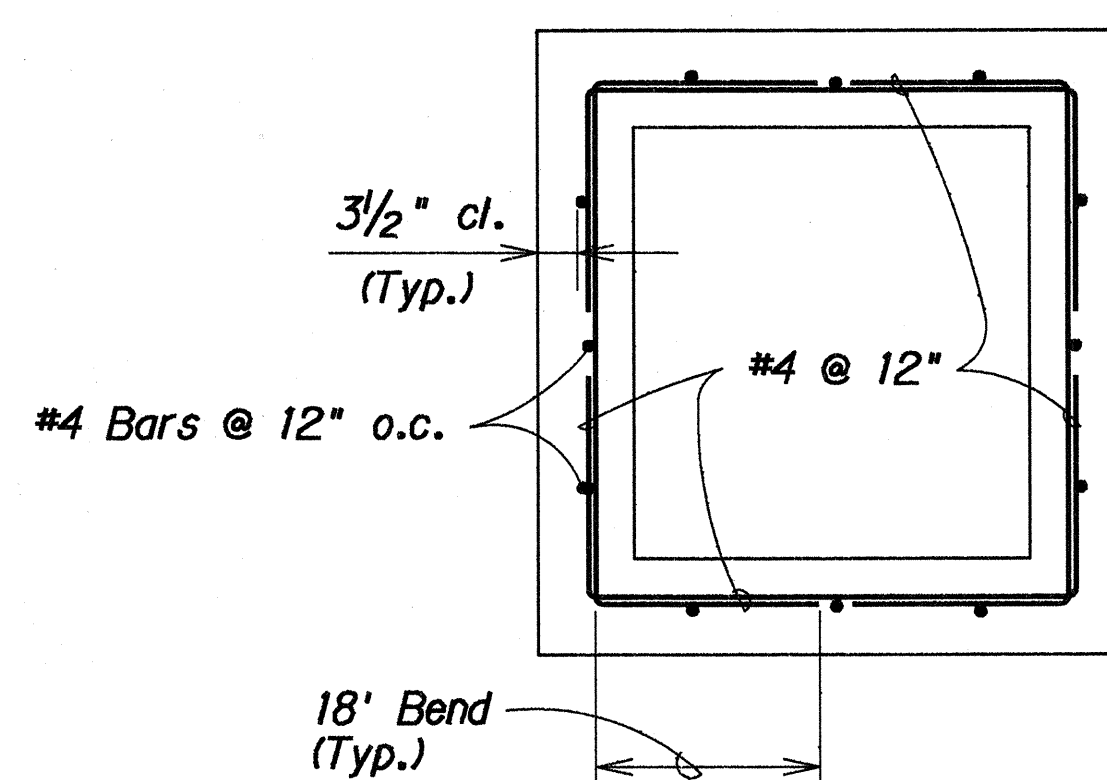


PLAN VIEW OF WALL REINFORCING

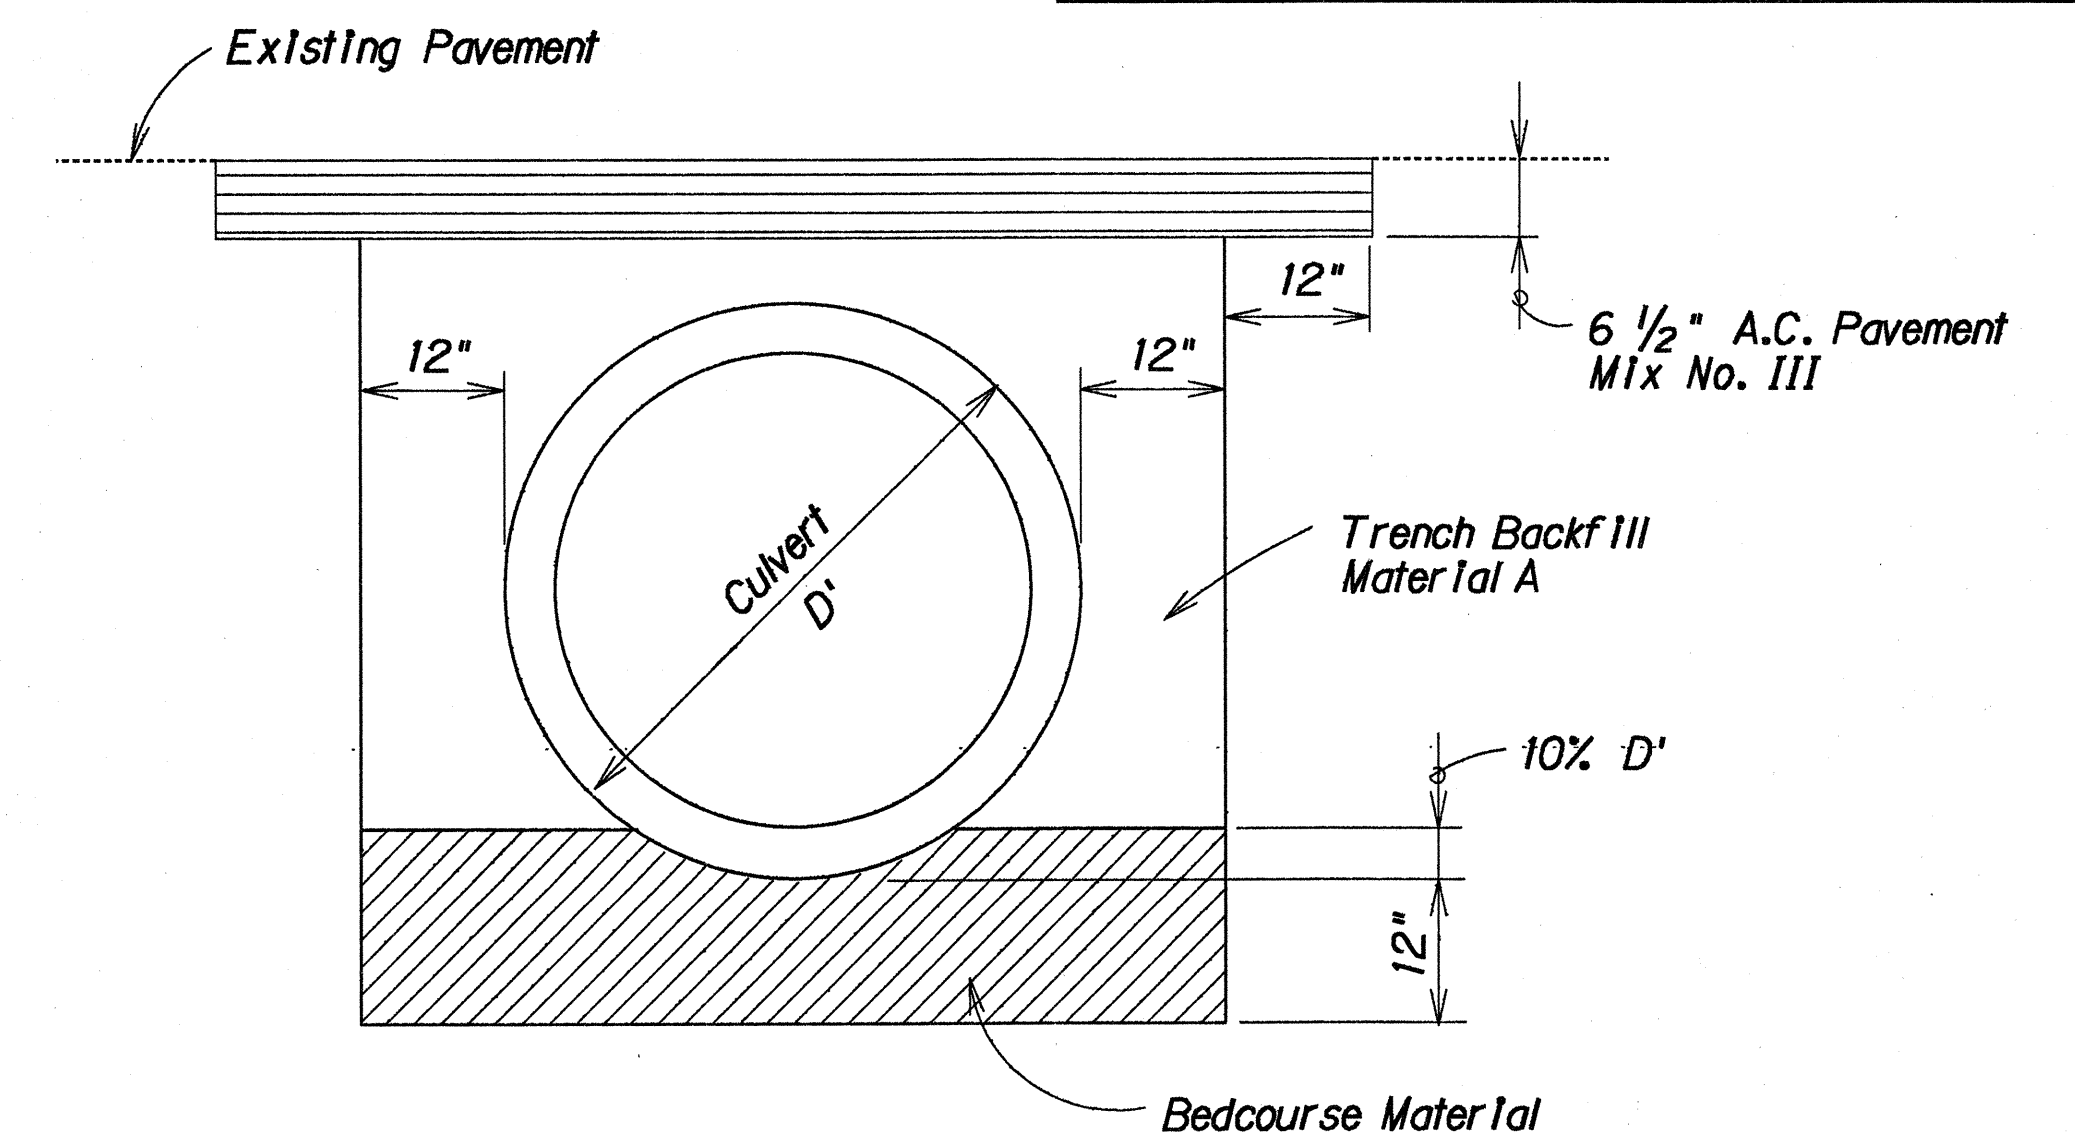

Note:
Pavement for above work, except Bedcourse Material, shall be considered incidental to the various contract items.

TRENCH DETAIL FOR CULVERTS

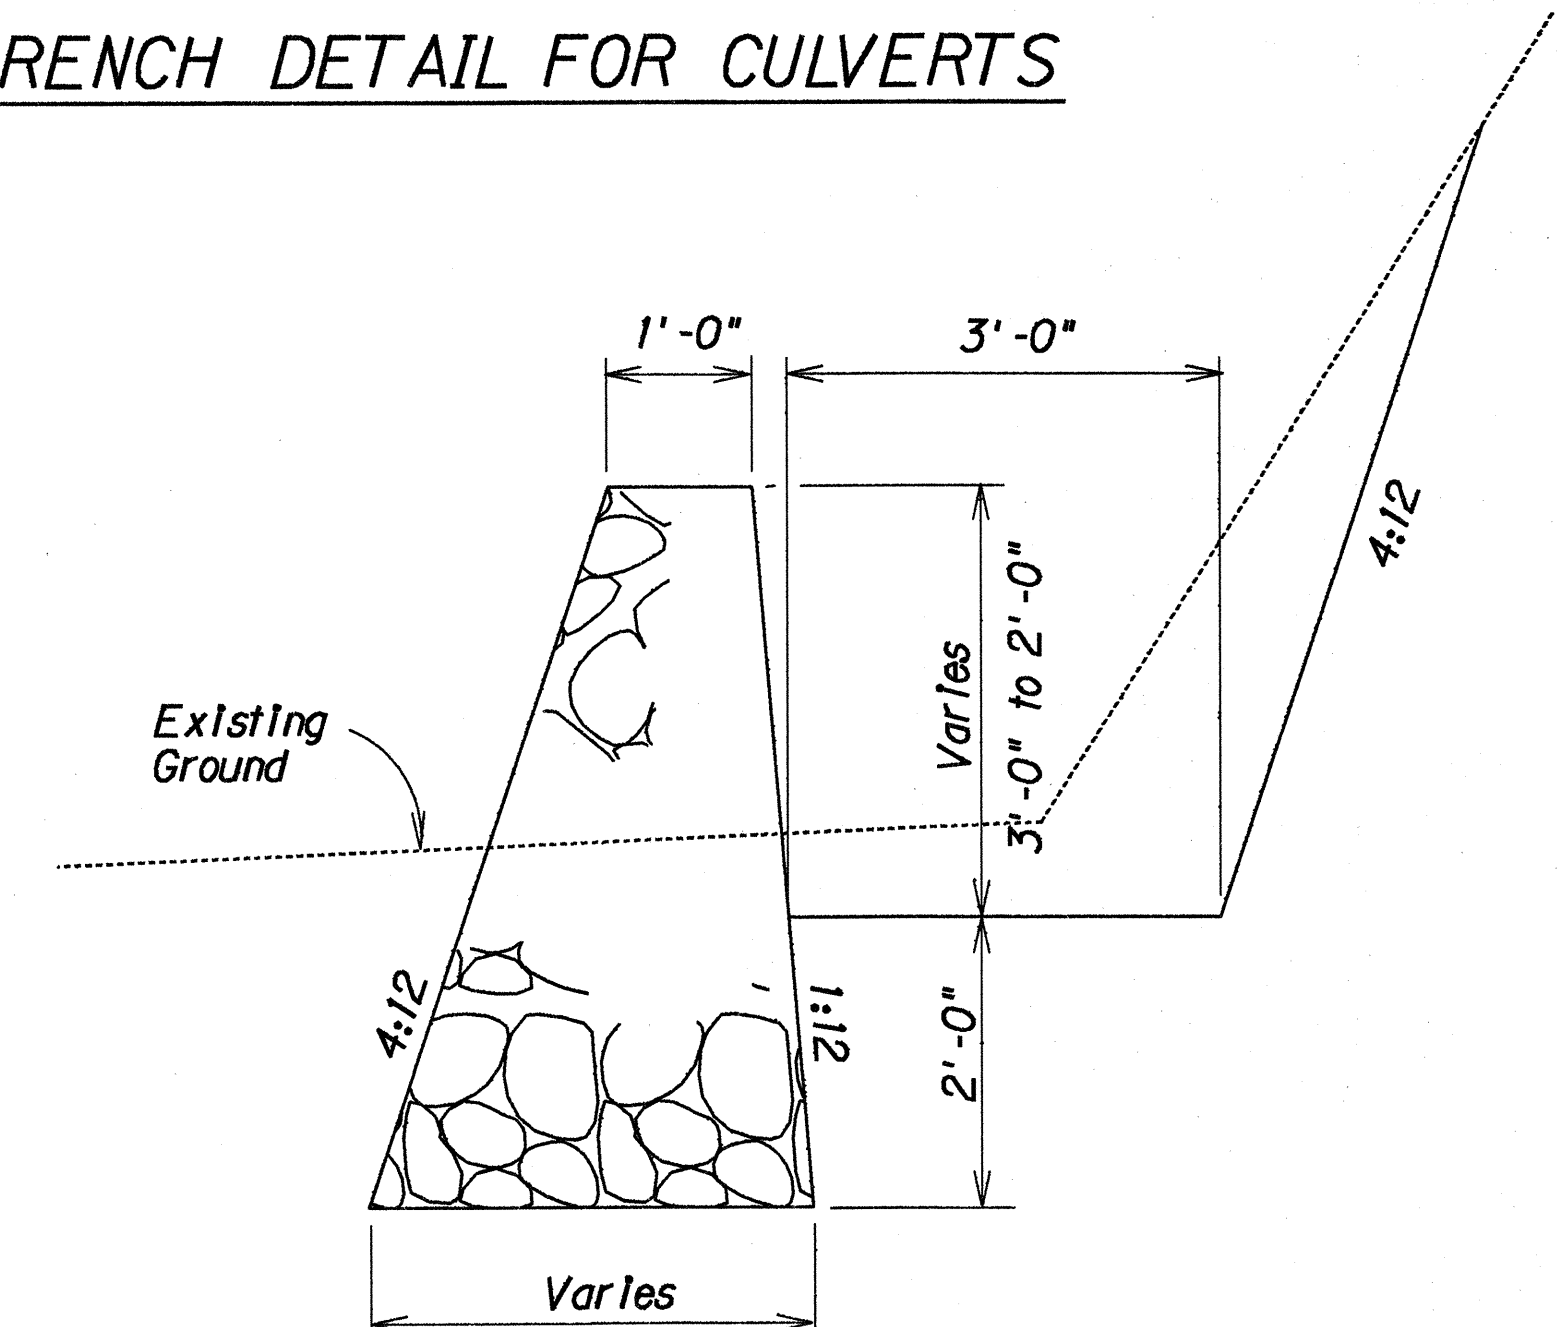

DETAIL OF CRM WALL & EARTH DITCH

TYPICAL DETAILS OF TYPE A9 GRATED DROP INLET

STATE OF HAWAII
DEPARTMENT OF TRANSPORTATION
HIGHWAYS DIVISION

DRAINAGE DETAILS

HANA HIGHWAY
WAIKANI BRIDGE REPAIR
PROJ. No. 360A-01-90M

Scale: 3/4" = 1'-0" Date: May 1990

SHEET No. H2 OF 2 SHEETS