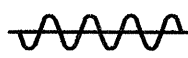
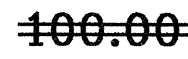


FED. ROAD DIST. NO.	STATE	PROJ. NO.	FISCAL YEAR	SHEET NO.	TOTAL SHEETS
HAWAII	HAW.	360B-01-91M	1991	7	18

HANA BOUND L= left side of lane
R= right side of lane

STA. ±	TO	STA. ±	LENGTH	WIDTH
1624+90		1625+40	50	9
1625+40 L		1626+30	90	4
1626+30		1626+55	25	9
1631+85		1632+85	100	9
1632+85 L		1634+95	210	4
1634+95		1635+05	10	9
1635+05 L		1637+80	275	4
1638+50 L		1642+30	380	4
1643+40 L		1646+50	310	4
1648+05		1648+75	70	9
1648+75 L		1650+00	125	4
1651+00 L		1653+00	200	4
1659+70 R		1660+20	50	4
1662+60 R		1663+30	70	4
1664+15		1666+40	225	9
1667+00 L		1667+80	80	4
1668+90 R		1670+60	170	4
1670+60		1671+00	40	9
1674+00 L		1674+35	35	4
1675+95 R		1678+95	300	4
1681+35 R		1681+60	25	4
1689+35 R		1689+50	15	4
1690+30 L		1690+70	40	4
1690+70 R		1691+10	40	4
1692+60 R		1694+00	140	4
1695+00 R		1698+40	340	4
1701+40 L		1701+60	20	4
1702+40		1702+60	20	9
1710+00 R		1710+60	60	4
1710+60		1711+10	50	9
1711+10 R		1712+00	90	4
1721+20		1721+60	40	9
1725+60 R		1726+00	40	4
1727+00 R		1727+60	30	4
1729+40		1730+60	120	9
1734+60 R		1735+40	80	4

STA. ±	TO	STA. ±	LENGTH	WIDTH
1746+50		1747+50	100	9
1753+05 L		1753+30	25	4
1753+80 R		1754+05	25	4
1754+30 L		1755+00	70	4
1755+45 L		1756+00	55	4
1756+50 R		1756+70	20	4
1757+80 R		1758+80	100	4
1759+60 R		1760+00	40	4
1762+60		1764+40	180	9
1766+40 L		1766+60	20	4
1781+40 L		1781+90	50	4
1781+90		1782+90	100	9
1783+90		1785+50	160	9
1789+30 R		1789+50	20	4
1790+00 R		1791+50	150	4
1798+00 R		1798+10	10	4
1826+00 R		1828+75	275	4

LEGEND FOR AS-BUILT POSTINGS	
	Squiggly line for as-built deletion
	Double line for as-built deletion
Roadway	Text for as-built posting

STATE OF HAWAII DEPARTMENT OF TRANSPORTATION HIGHWAYS DIVISION
RECONSTRUCTION SCHEDULE
HANA HIGHWAY RESURFACING Kalahu To Hana Proj. No. 360B-01-91M

Date: Feb., 1991

SHEET No. 1 OF 2 SHEETS

AS-BUILT


ORIGINAL PLAN	SURVEY PLOTTED BY	DATE
NOTE BOOK	DRAWN BY	
	DESIGNED BY	
	QUANTITIES BY	
	CHECKED BY	

FED. ROAD DIST. NO.	STATE	PROJ. NO.	FISCAL YEAR	SHEET NO.	TOTAL SHEETS
HAWAII	HAW.	360B-01-91M	1991	8	18

NAHIKU BOUND L= left side of lane
R= right side of lane

STA. ±	TO	STA. ±	LENGTH	WIDTH
1624+90		1625+40	50	9
1625+40 L		1629+00	360	4
1631+80 L		1632+30	50	4
1633+40 L		1634+40	100	4
1637+50 L		1637+80	30	4
1638+30		1639+00	70	9
1639+60 R		1640+00	40	4
1640+00 L		1642+00	200	4
1642+00		1643+75	175	9
1644+30		1644+95	65	9
ULAINO RD.		INTER.	30	11
1645+30		1646+30	100	9
1646+30		1647+00	70	4
1648+10		1648+40	30	4
1648+70 L		1649+00	30	4
1649+50		1650+00	40	9
1651+00		1651+40	40	9
1652+10		1652+40	30	9
1652+50		1653+25	75	9
1654+75		1655+55	40	9
1655+15 L		1657+00	185	4
1657+30 L		1659+00	120	9
1661+00 L		1663+30	230	4
1664+15 L		1667+00	285	4
ALALELE PL.		INTER.	75	11
1670+60		1671+00	40	9
1680+70 L		1681+00	30	4
1683+50 L		1684+10	60	4
1684+70 R		1685+00	30	4
1686+75 L		1687+25	50	4
1690+70 R		1691+10	40	4
1692+60 L		1693+00	40	4
1693+90 L		1694+90	100	4
WAIANAPANAPA RD.		INTER.	40	11
1695+00 R		1696+00	100	4
1697+70 L		1698+50	80	4

STA. ±	TO	STA. ±	LENGTH	WIDTH
1699+80 L		1700+00	20	4
1702+40		1702+60	20	9
1707+30 R		1707+60	30	4
1711+20		1711+60	40	9
1712+50 L		1712+90	40	4
1715+50 L		1715+90	40	4
1722+90 L		1726+90	400	4
1730+25 R		1731+00	75	4
1750+00 R		1750+50	50	4
1752+20 L		1752+55	75	4
1756+25 L		1757+00	75	4
1758+30 L		1761+30	300	4
1763+30 L		1763+95	65	4
1766+15 L		1766+65	50	4
1768+10 R		1768+50	40	4
1771+40 L		1774+40	300	4
1778+90 R		1779+00	10	4
1780+40 R		1780+50	10	4
1783+00 R		1783+60	60	4
1783+90 R		1784+30	40	4
1784+50		1784+54	4	9
1789+90 L		1792+55	265	4
1811+00		1811+40	40	9
1823+25 L		1824+00	75	4
1825+00 L		1826+20	120	4
1827+75 L		1828+40	65	4

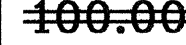LEGEND FOR AS-BUILT POSTINGS	
	Squiggly line for as-built deletion
	Double line for as-built deletion
Roadway	Text for as-built posting

STATE OF HAWAII
DEPARTMENT OF TRANSPORTATION
HIGHWAYS DIVISION

RECONSTRUCTION SCHEDULE

HANA HIGHWAY RESURFACING
Kalahu To Hana
Proj. No. 360B-01-91M

Date: Feb., 1991

SHEET No. 2 OF 2 SHEETS

ORIGINAL PLAN	SURVEY PLOTTED BY	DATE
NOTE BOOK	DRAWN BY	
No.	TRACED BY	
	CHECKED BY	
	QUANTITIES BY	