


|                  |                         |            |
|------------------|-------------------------|------------|
| ORIGINAL<br>PLAN | SURVEY PLOTTED BY _____ | DATE _____ |
| NOTEBOOK         | DRAWN BY _____          | _____      |
|                  | TRACED BY _____         | _____      |
|                  | DESIGNED BY _____       | _____      |
|                  | QUANTITIES BY _____     | _____      |
| No. _____        | CHECKED BY _____        | _____      |

FILE: HTM0454  
SCALE: 1"=1'-0"  
BEG: 9/11/91

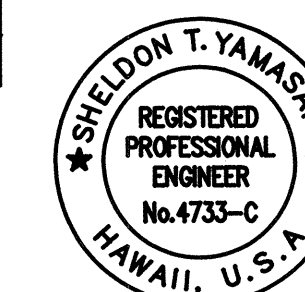

Shubh T. Up

SCALE: NONE DATE: SEPT. 17, 1990  
SHEET NO. OF SHEETS