


FED. ROAD DIST. NO.	STATE	FED. AID PROJ. NO.	FISCAL YEAR	SHEET NO.	TOTAL SHEETS
HAWAII	HAW.	BR-RS-0360(6)	1992	4	75

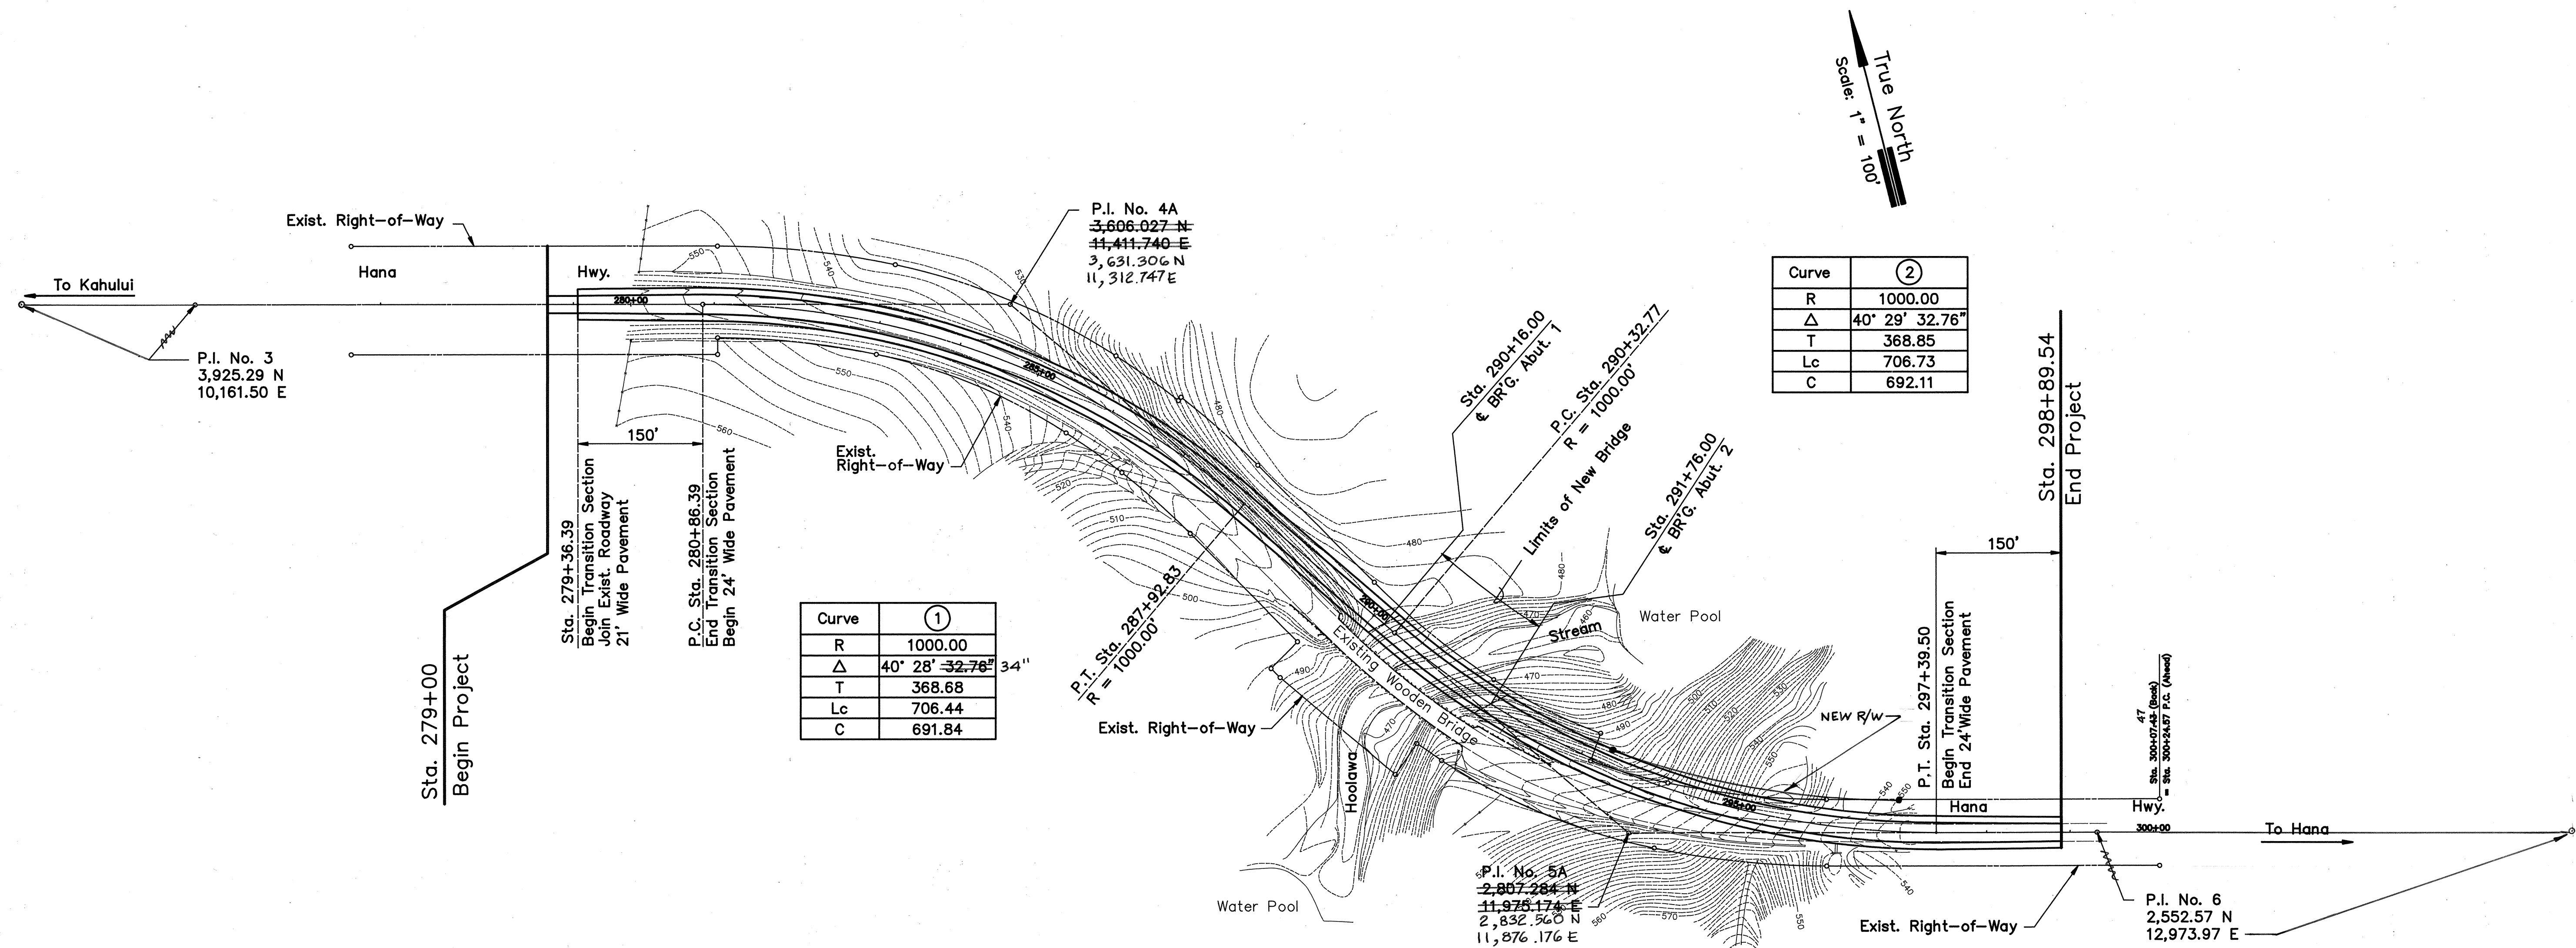


ORIGINAL PLAN	SURVEY PLOTTED BY	DATE
NOTED	DRAWN BY	
	DESIGNED BY	
	QUANTITIES BY	
	CHECKED BY	

FILE: HTM0417
SCALE: 1"=100'
BEG: 90

PM: STY
OPR: *DHY,TML
REVISED: 9/19/91

WORKSHEET:
REVIEWED BY:

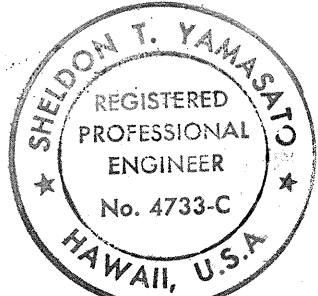

THIS WORK WAS PREPARED BY
ME OR UNDER MY SUPERVISION.

Sheldon T. Yamashita

STATE OF HAWAII
DEPARTMENT OF TRANSPORTATION
HIGHWAYS DIVISION

GENERAL PLAN

HOOLAWA BRIDGE REPLACEMENT
HANA HWY., HOOLAWA, MAUI
PROJECT NO. BR-RS-0360(6)

SCALE: 1" = 100' DATE: SEPT. 17, 1991
SHEET NO. 4 OF 75 SHEETS