


FED. ROAD DIST. NO.	STATE	FED. AID PROJ. NO.	FISCAL YEAR	SHEET NO.	TOTAL SHEETS
HAWAII	HAW.	BR-RS-0360(6)	1992	7	75

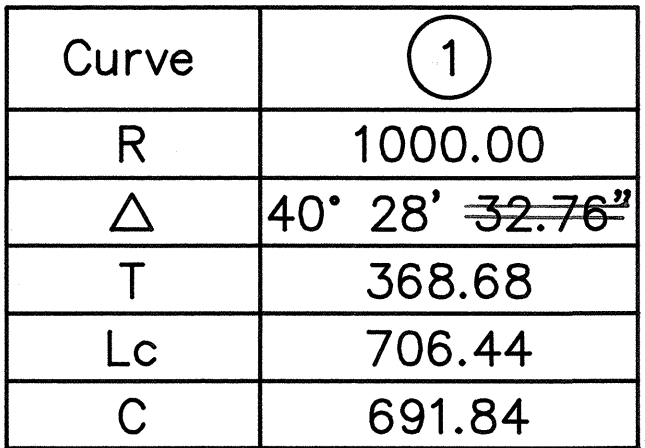

ORIGINAL PLAN	SURVEY PLOTTED BY _____	DATE _____
NOTEBOOK	DRAWN BY _____	" _____
	TRACED BY _____	" _____
	DESIGNED BY _____	" _____
	QUANTITIES BY _____	" _____
No. _____	CHECKED BY _____	" _____

PM: STY
OPR: JSK,DHY,TML,*STY
REVISED: 9/29/91

FILE: HTM0413
SCALE: 1=40
BEG: 2/24/90

WORKSHEET:
REVIEWED BY
REVIEWED BY



THIS WORK WAS PREPARED BY
ME OR, UNDER MY SUPERVISION


STATE OF HAWAII
DEPARTMENT OF TRANSPORTATION
HIGHWAYS DIVISION

PLAN - STA. 279+36.39
TO STA. 289+00

HOOLAWA BRIDGE REPLACEMENT
HANA HWY., HOOLAWA, MAUI
PROJECT NO. BR-RS-0360(6)

SCALE: 1" = 40' DATE: SEPT. 17, 1991
SHEET NO. OF SHEETS



FED. ROAD DIST. NO.	STATE	FED. AID PROJ. NO.	FISCAL YEAR	SHEET NO.	TOTAL SHEETS
HAWAII	HAW.	BR-RS-0360(6)	1992	8	75

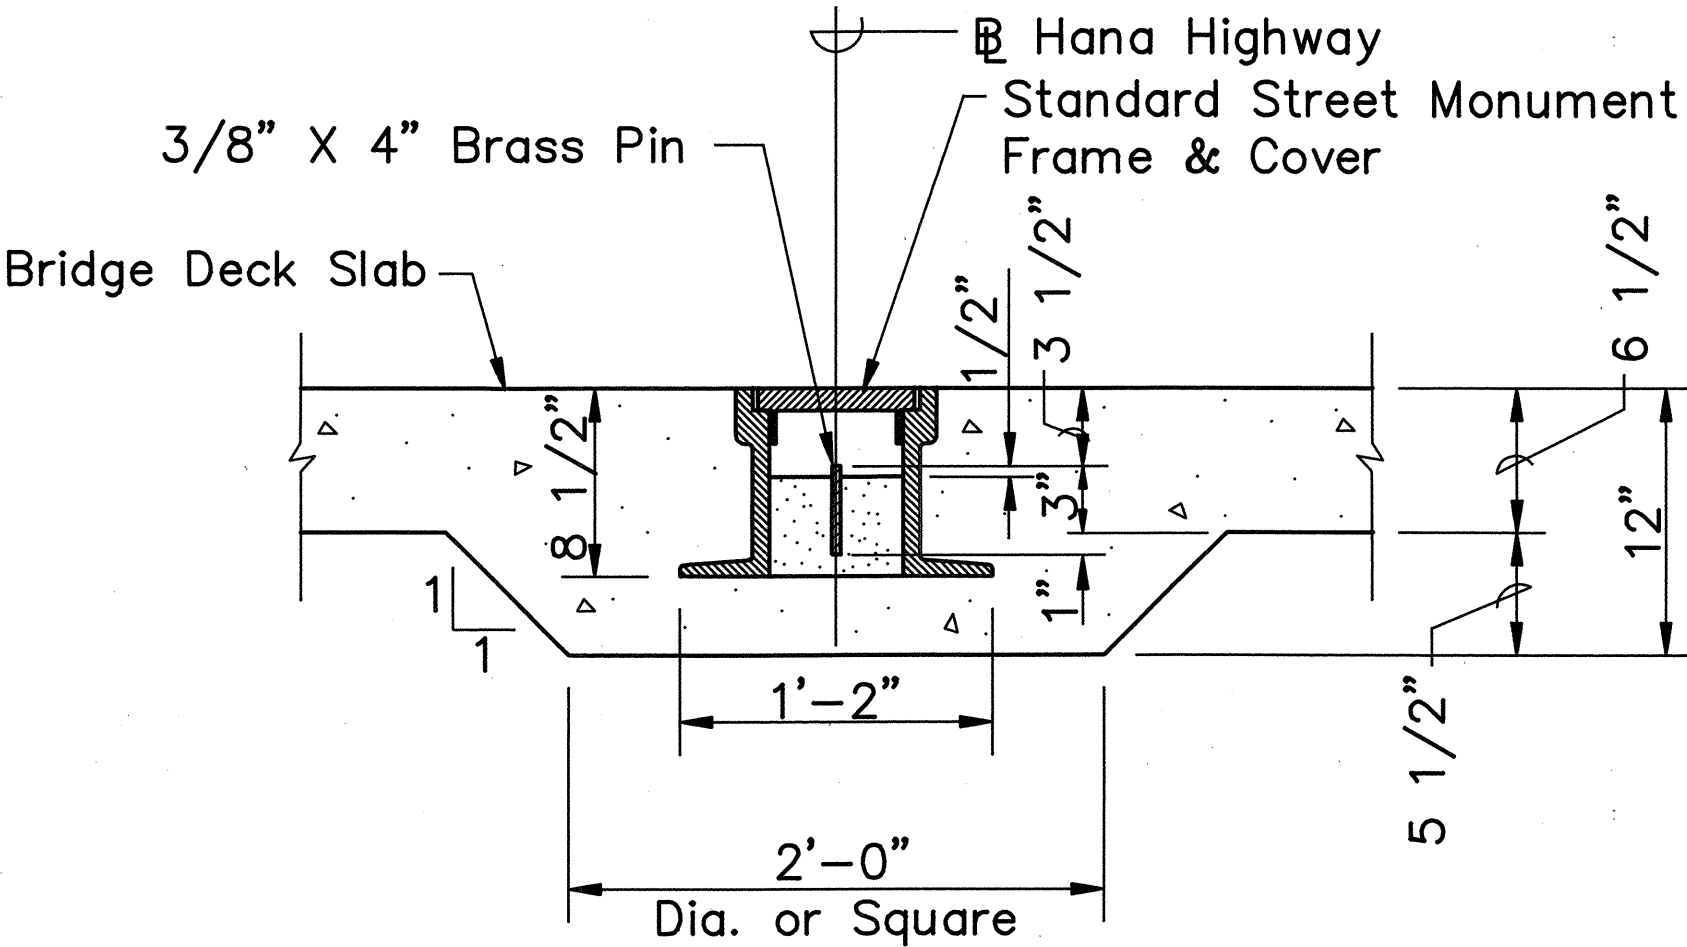

MODIFIED ST. SURVEY MONUMENT DETAIL
Scale: 1" = 1'-0"


Curve	(2)
R	1000.00
Δ	40° 29' 32.76"
T	368.85
Lc	706.73
C	692.11

Install Modified Street Monument
See Detail

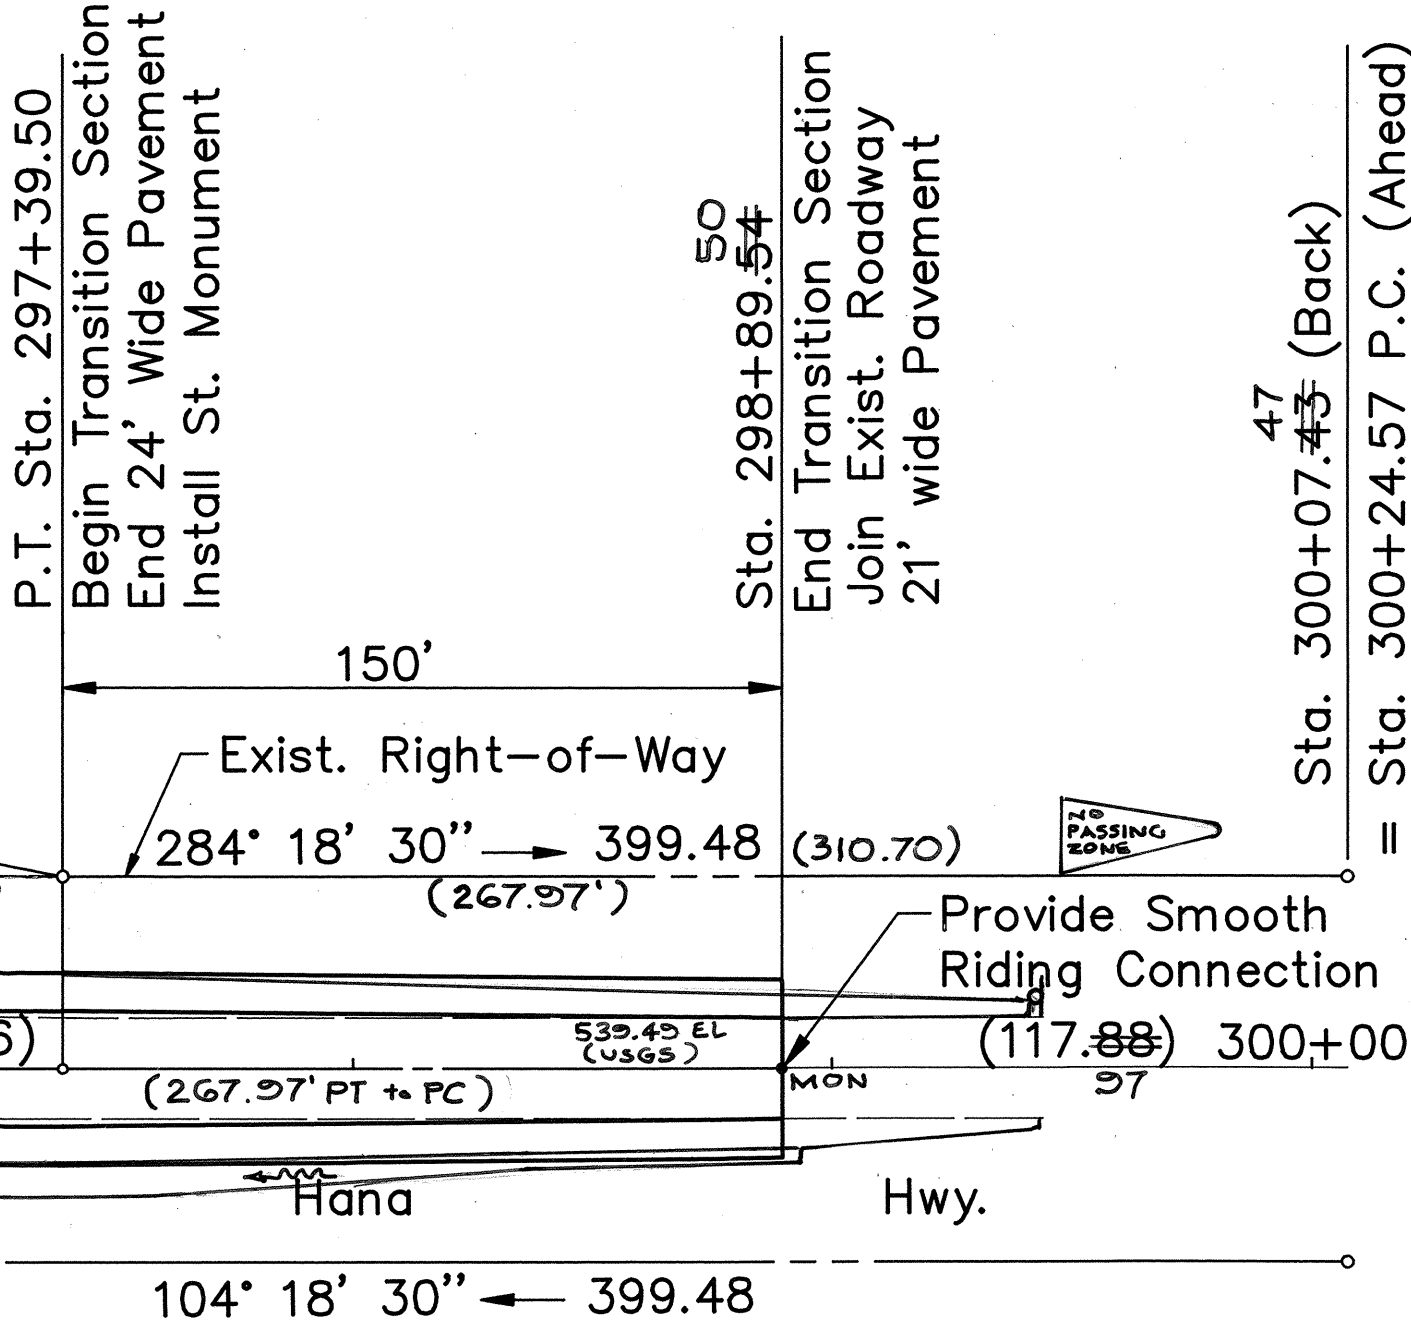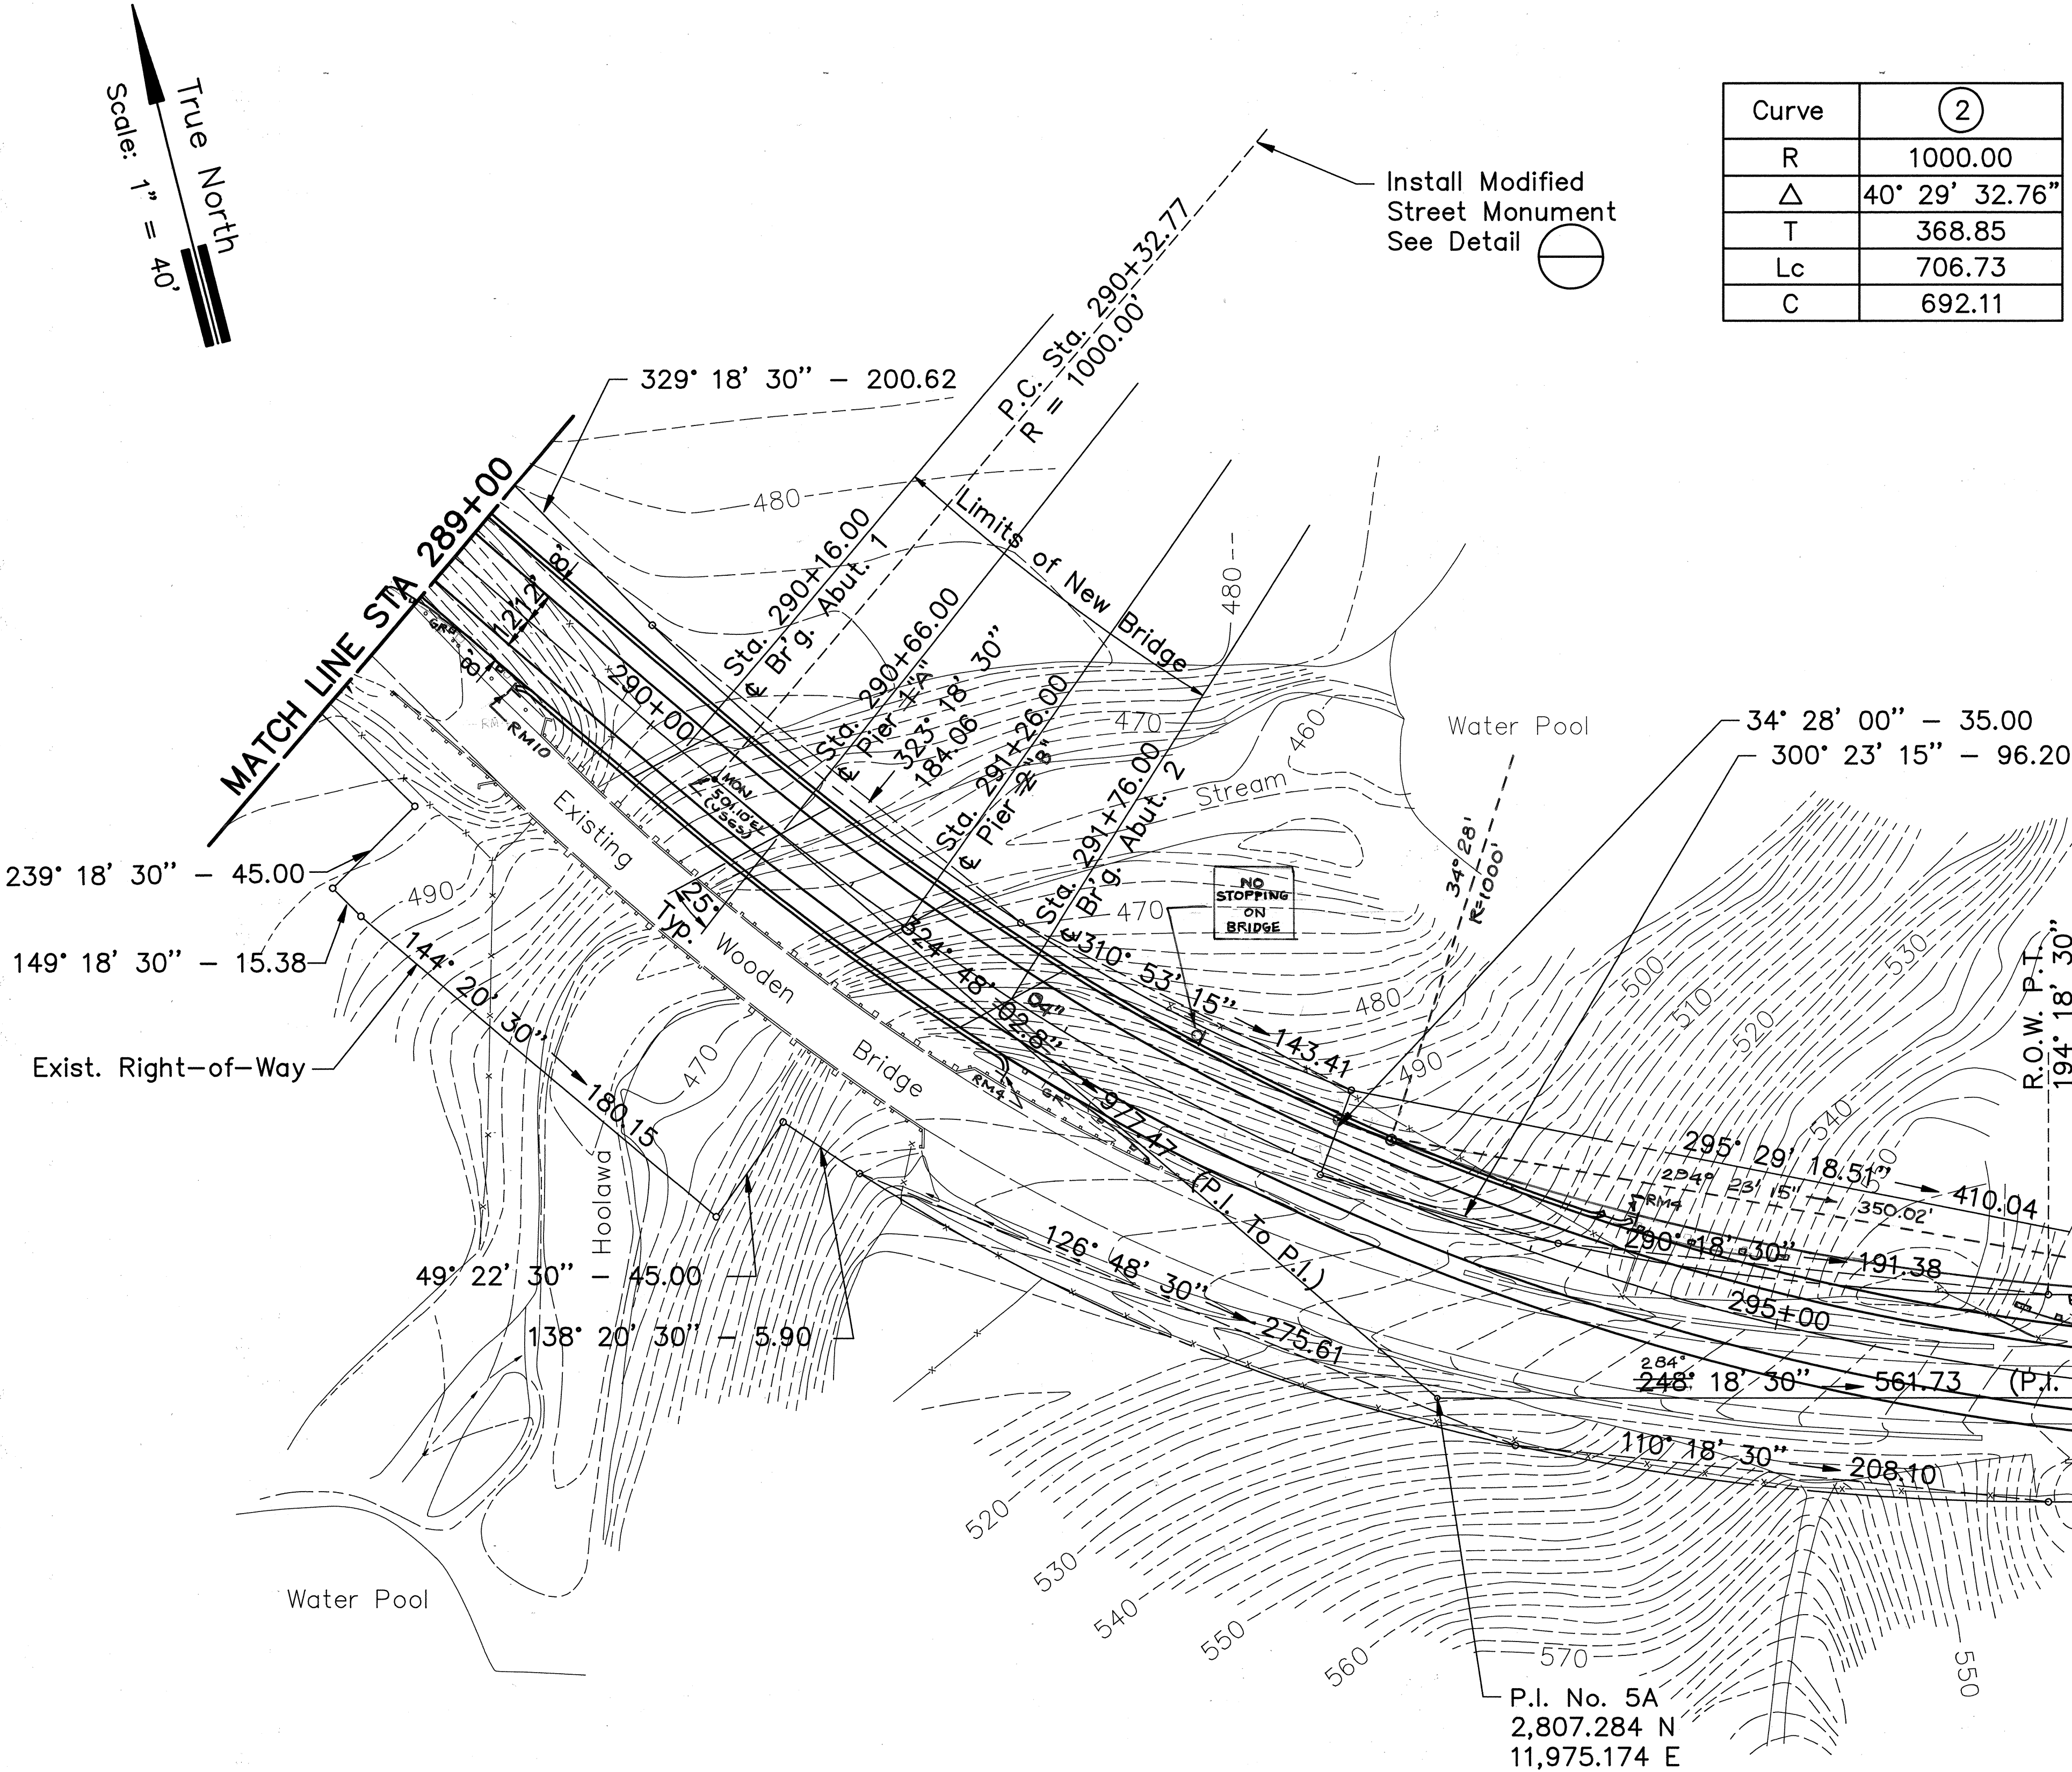

ORIGINAL PLAN	DATE
NO.	

WORKSHEET: _____
REVIEWED BY: _____
FILE: HTM0414
SCALE: 1"=40'
BEG: TODAY
PM: STY
OPR: JSK,DHY,TML,*STY
REVISED: 9/29/91

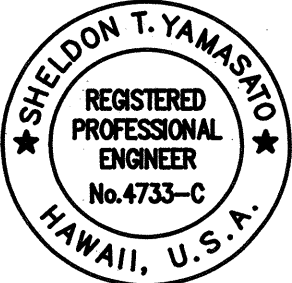

THIS WORK WAS PREPARED BY
ME OR UNDER MY SUPERVISION

Sheldon T. Yamashiro

STATE OF HAWAII
DEPARTMENT OF TRANSPORTATION
HIGHWAYS DIVISION

**PLAN - STA. 289+00
TO STA. 298+89.54**

**HOOLOWA BRIDGE REPLACEMENT
HANA HWY., HOOLOWA, MAUI
PROJECT NO. BR-RS-0360(6)**

SCALE: 1" = 40' DATE: SEPT. 17, 1991
SHEET NO. OF SHEETS



ORIGINAL PLAN	SURVEY PLOTTED BY _____	DATE _____
NOTED BY _____	DRAWN BY _____	DESIGNED BY _____
No. _____	QUANTITIES BY _____	CHECKED BY _____

FILE: HTM0415
SCALE: 1"=40'
BEG: 2/28/90

PW: STY
OPR: *STY,DHY,TML
REVISED: 10/3/91

WORKSHEET:
REVIEWED BY:
REVIEWED BY:

FED. ROAD DIST. NO.	STATE	FED. AID PROJ. NO.	FISCAL YEAR	SHEET NO.	TOTAL SHEETS
HAWAII	HAW.	BR-RS-0360(6)	1992	9	75

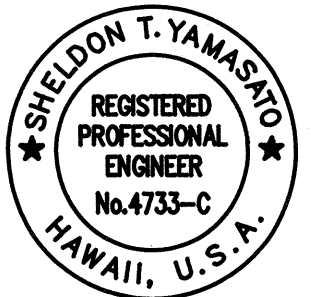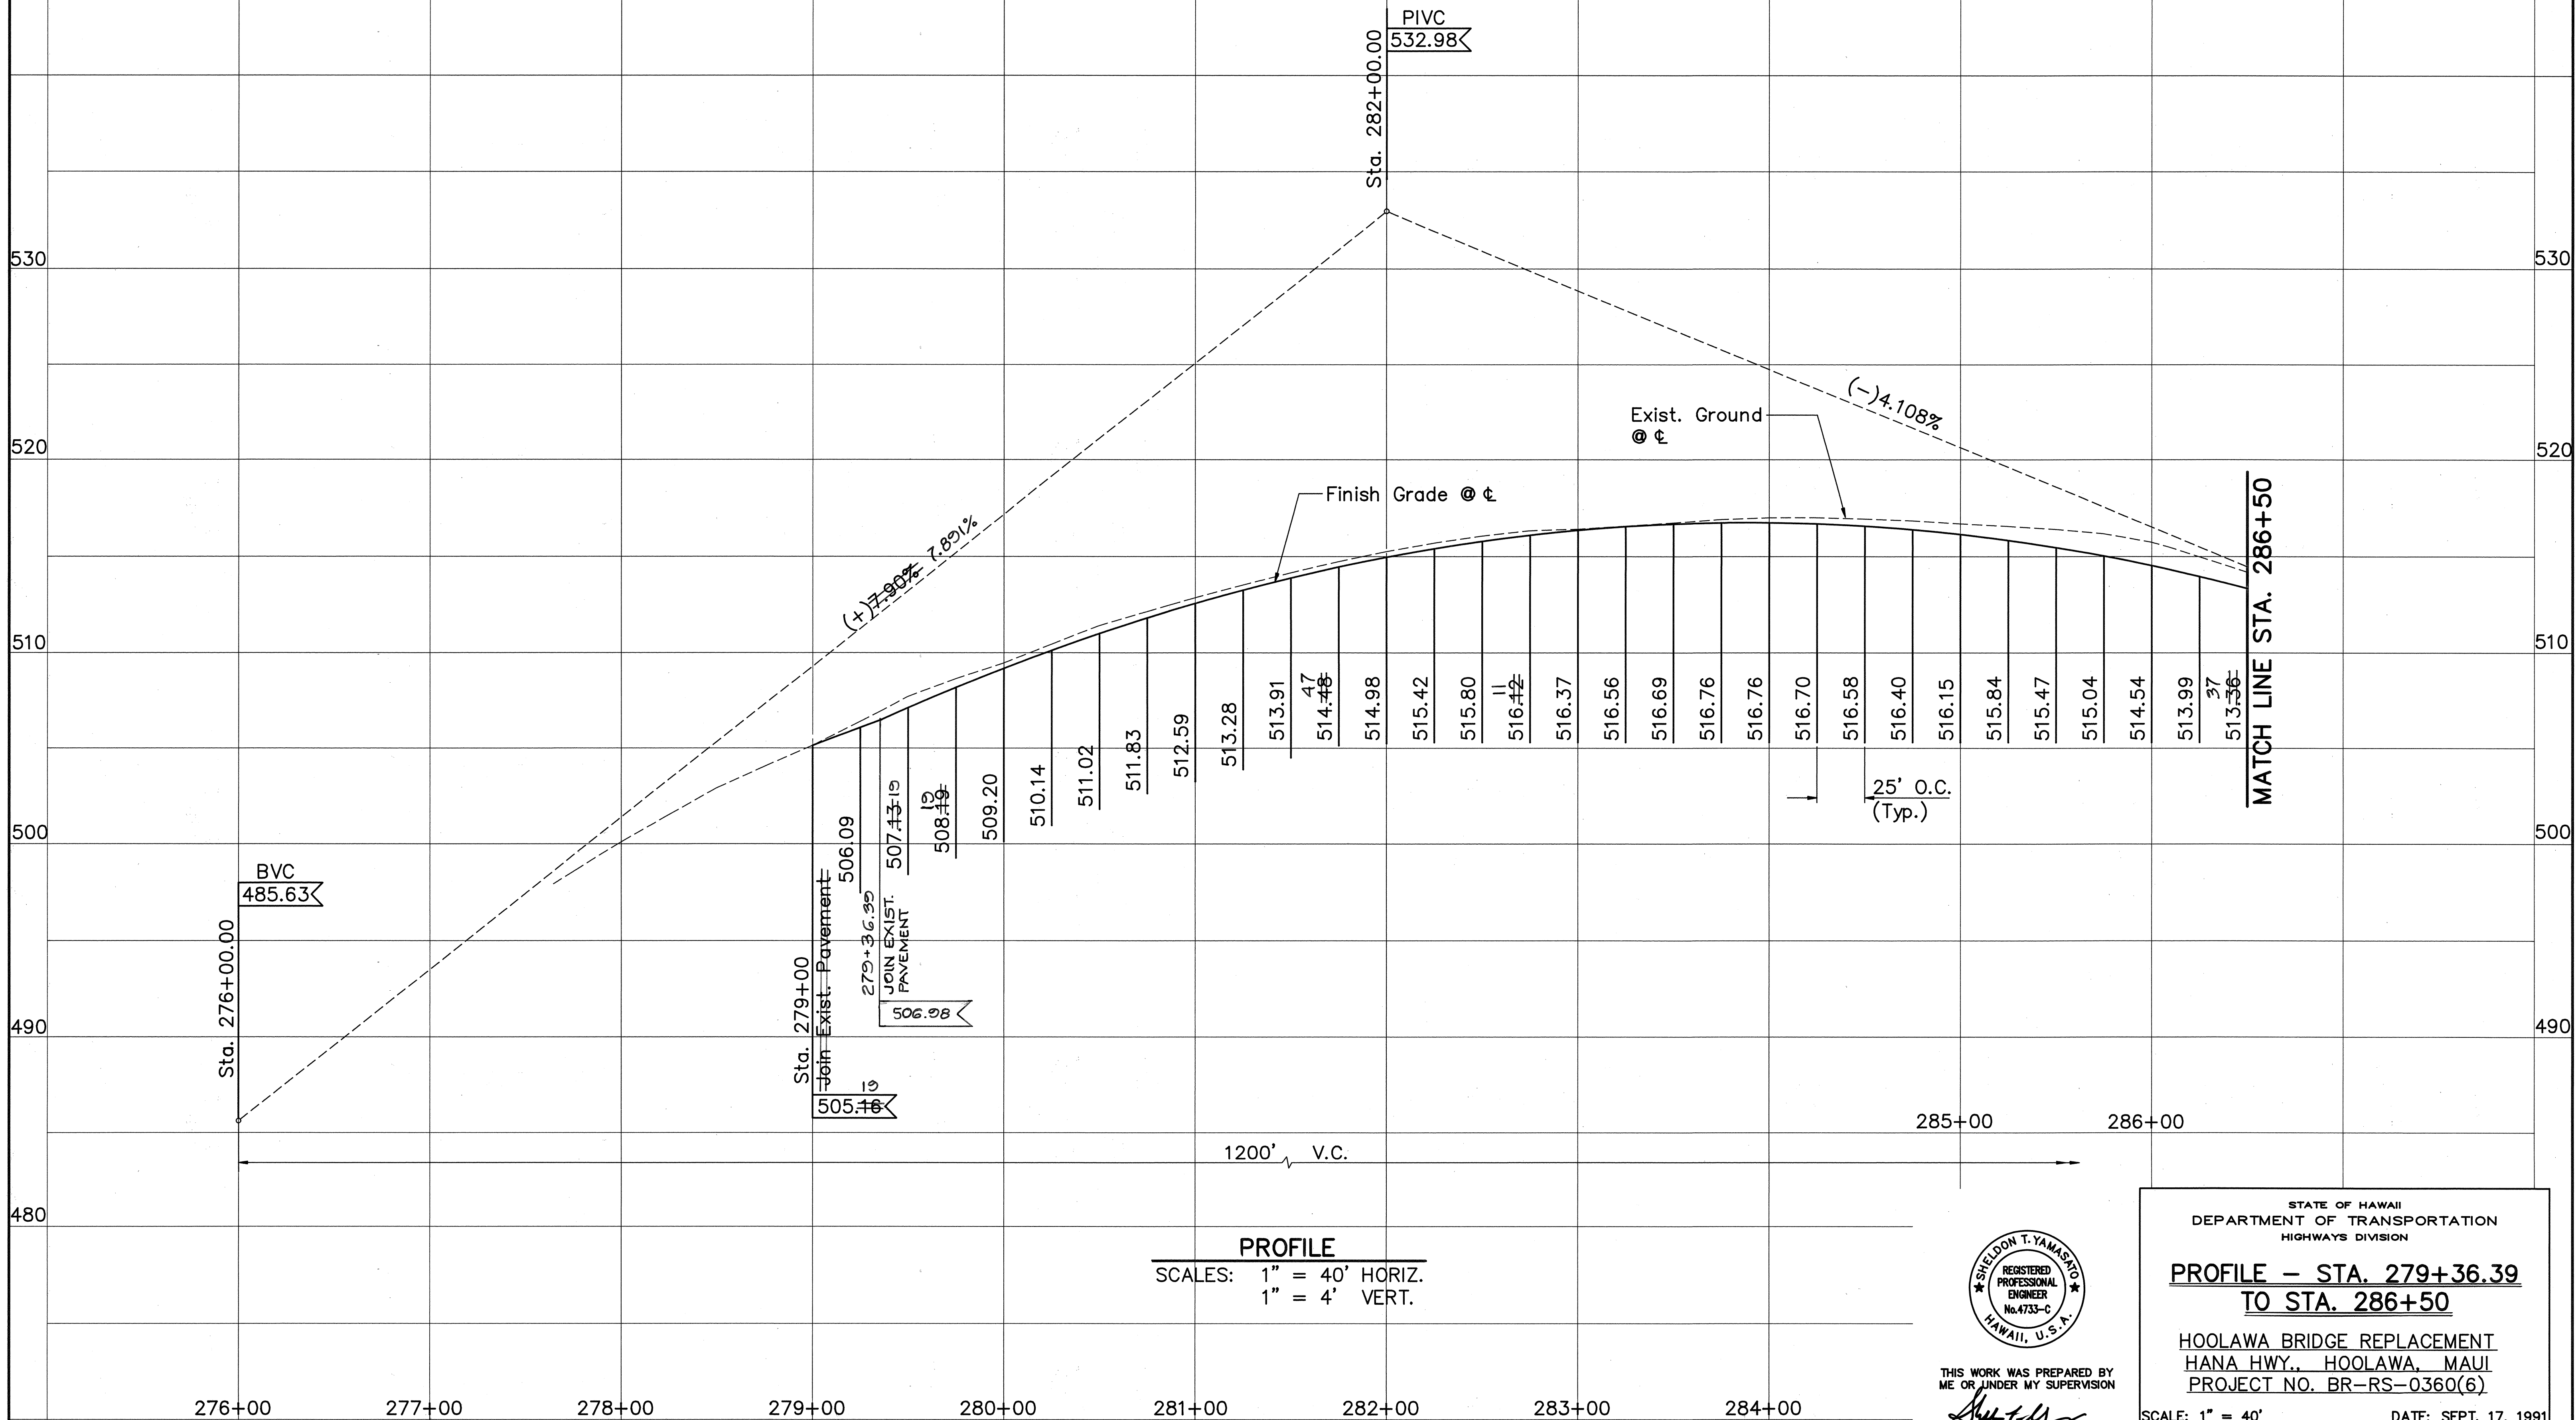

THIS WORK WAS PREPARED BY
ME OR UNDER MY SUPERVISION

Sheldon T. Yamashiro

STATE OF HAWAII
DEPARTMENT OF TRANSPORTATION
HIGHWAYS DIVISION

**PROFILE - STA. 279+36.39
TO STA. 286+50**

HOOLAWA BRIDGE REPLACEMENT
HANA HWY., HOOLAWA, MAUI
PROJECT NO. BR-RS-0360(6)

SCALE: 1" = 40' DATE: SEPT. 17, 1991



SHEET NO. OF SHEETS

ORIGINAL PLAN	SURVEY PLOTTED BY	DATE
NOTED BY	DRAWN BY	
DESIGNED BY	TRACED BY	
QUANTITIES BY	CHECKED BY	
No.		

FILE: HTM0416
SCALE: 1"=40'
BEG: 2/28/90

PM: STY
OPR: STY,ADHY,TML
REVISED: 9/17/91

WORKSHEET:
REVIEWED BY:

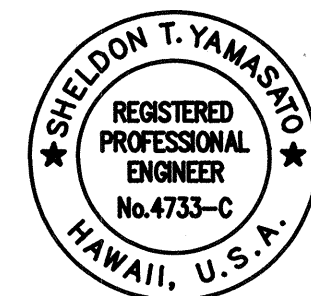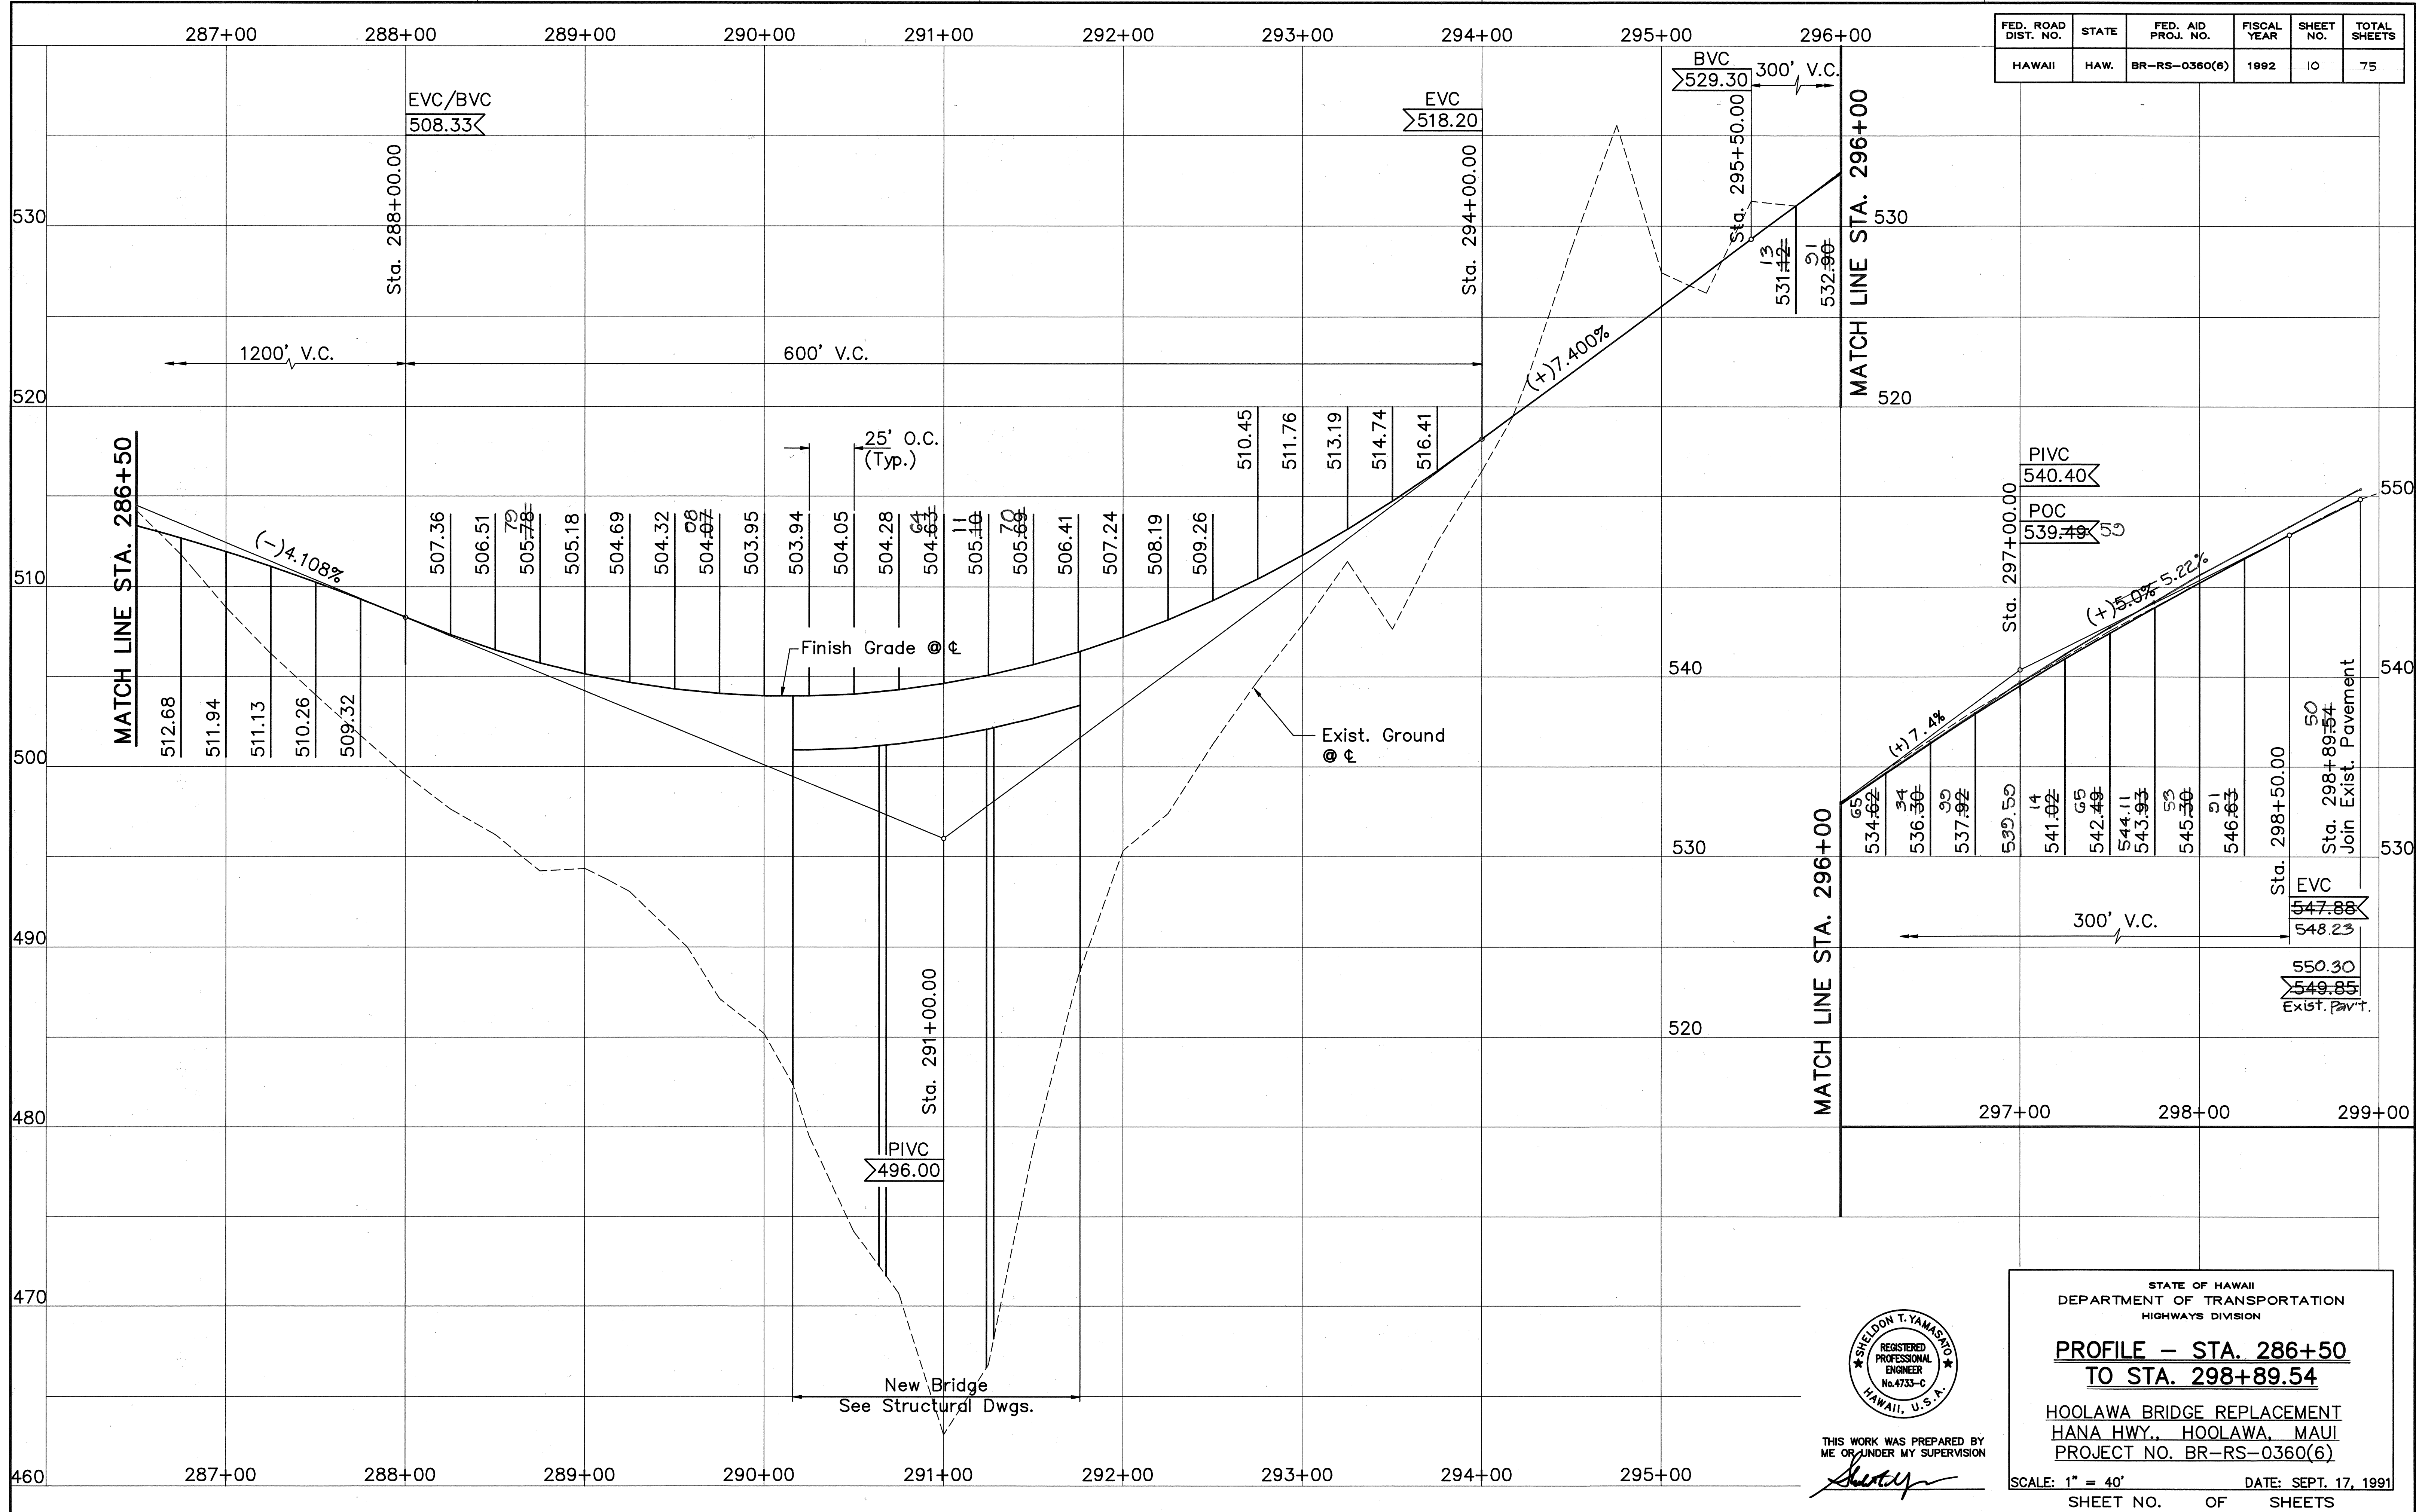

THIS WORK WAS PREPARED BY
ME OR UNDER MY SUPERVISION

STATE OF HAWAII
DEPARTMENT OF TRANSPORTATION
HIGHWAYS DIVISION

**PROFILE - STA. 286+50
TO STA. 298+89.54**

HOOLAWA BRIDGE REPLACEMENT
HANA HWY., HOOLAWA, MAUI
PROJECT NO. BR-RS-0360(6)

SCALE: 1" = 40' DATE: SEPT. 17, 1991
SHEET NO. OF SHEETS



ORIGINAL PLAN	SURVEY PLOTTED BY	DATE
NOTED	DRAWN BY	
NO.	DESIGNED BY	
	QUANTITIES BY	
	CHECKED BY	

FILE: HTM0410
SCALE: 1"=40'
BEG: 2/13/90

PM: STY
OPR: *DHY,TML
REVIS: 9/17/91

WORKSHEET:
REVIEWED BY:

FED. ROAD DIST. NO.	STATE	FED. AID PROJ. NO.	FISCAL YEAR	SHEET NO.	TOTAL SHEETS
HAWAII	HAW.	BR-RS-0360(6)	1992	11	75

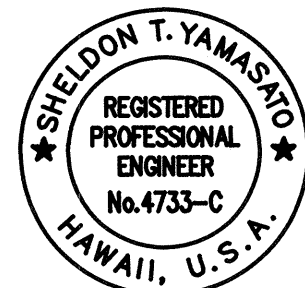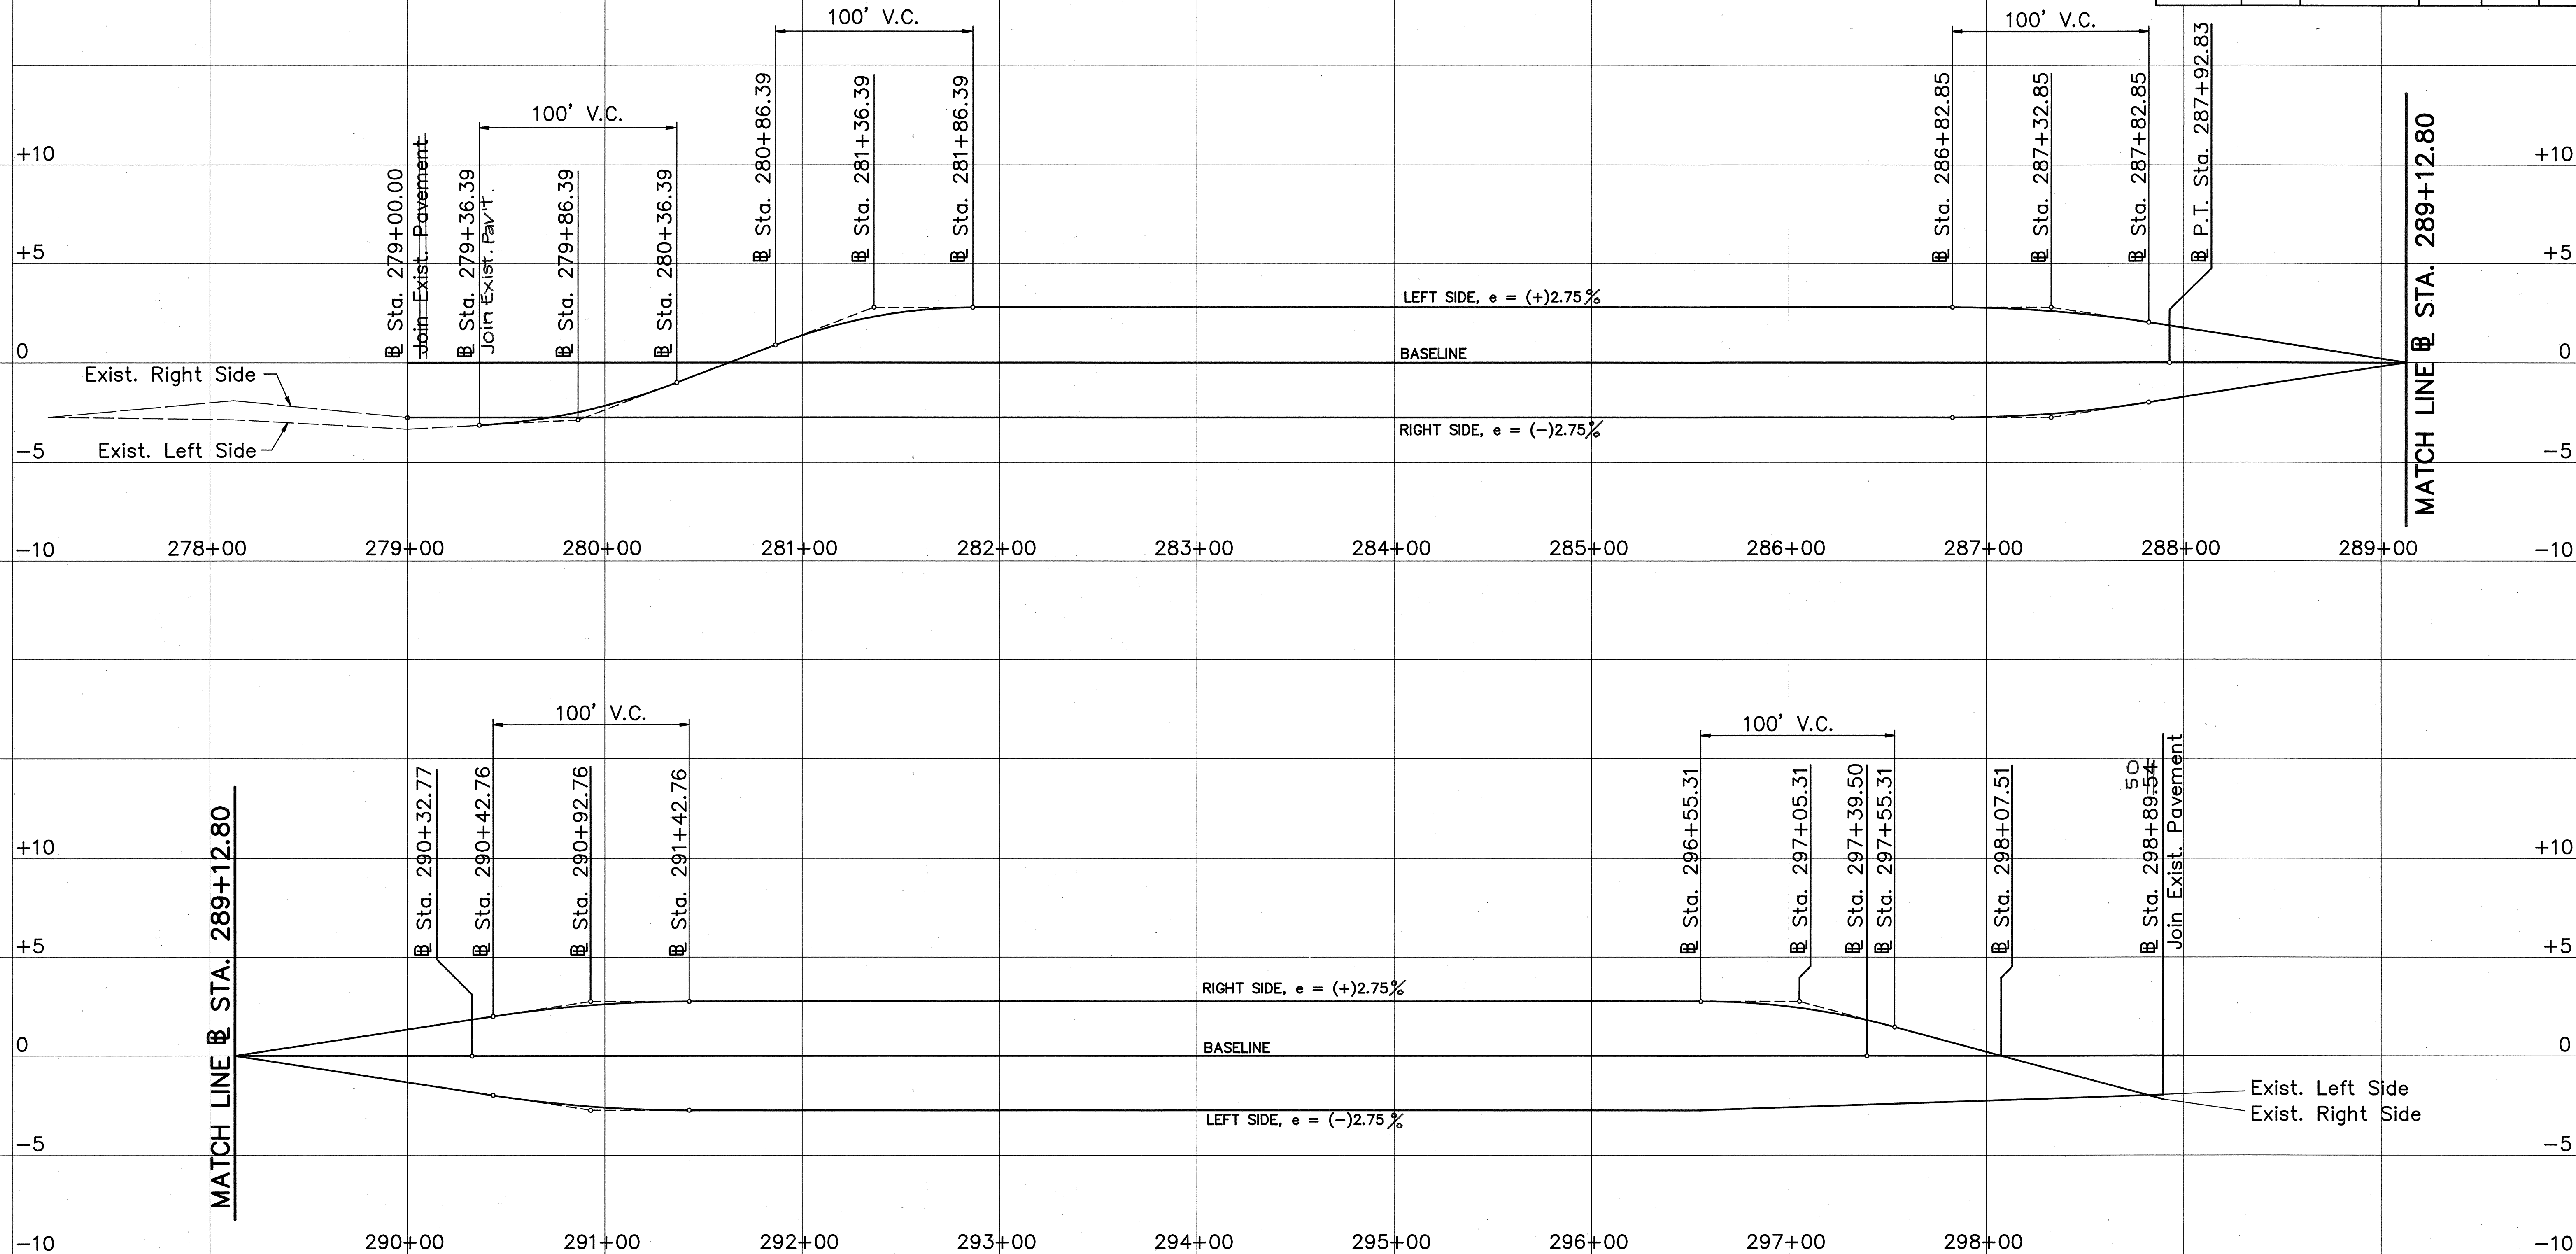

THIS WORK WAS PREPARED BY
ME OR UNDER MY SUPERVISION

Sheldon T. Yamamoto

STATE OF HAWAII DEPARTMENT OF TRANSPORTATION HIGHWAYS DIVISION	
SUPERELEVATION DIAGRAM	
HOOLAWA BRIDGE REPLACEMENT HANA HWY., HOOLAWA, MAUI PROJECT NO. BR-RS-0360(6)	
SCALE: HORIZ. 1" = 40' VERT. 1" = 4'	DATE: SEPT. 17, 1991
SHEET NO. OF SHEETS	