

INDEX TO DRAWINGS	
SHEET NO.	DESCRIPTION
1	TITLE SHEET
2	STANDARD PLAN SUMMARY
3	CONSTRUCTION NOTES
4	GENERAL PLAN
5-6	TYPICAL ROADWAY SECTIONS
7-11	PLAN AND PROFILE
12-13	HIGHWAY IMPROV. PLAN
14	DRAIN DETAILS
15	GRP SLOPE PROTECTION
16-21	TRAFFIC CONTROL
22-30	CROSS SECTIONS
31-32	BORING LOGS
33-57	BRIDGE STRUCTURE
58-69	REINF. EARTH WALLS
70-75	EXISTING BRIDGE STRUCTURE

STATE OF HAWAII

DEPARTMENT OF TRANSPORTATION

HIGHWAYS DIVISION

HONOLULU, HAWAII

"AS-BUILT"

PLANS FOR

HANA HIGHWAY






HOOLAWA BRIDGE REPLACEMENT

FEDERAL AID PROJECT NO. BR-RS-0360(6)

DISTRICT OF MAKAWAO

ISLAND OF MAUI

FED. ROAD DIST. NO.	STATE	FED. AID PROJ. NO.	FISCAL YEAR	SHEET NO.	TOTAL SHEETS
HAWAII	HAW.	BR-RS-0360(6)	1992	1	75

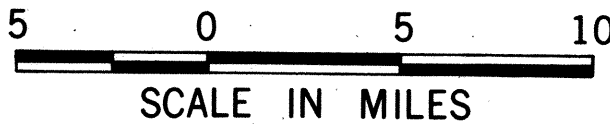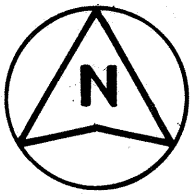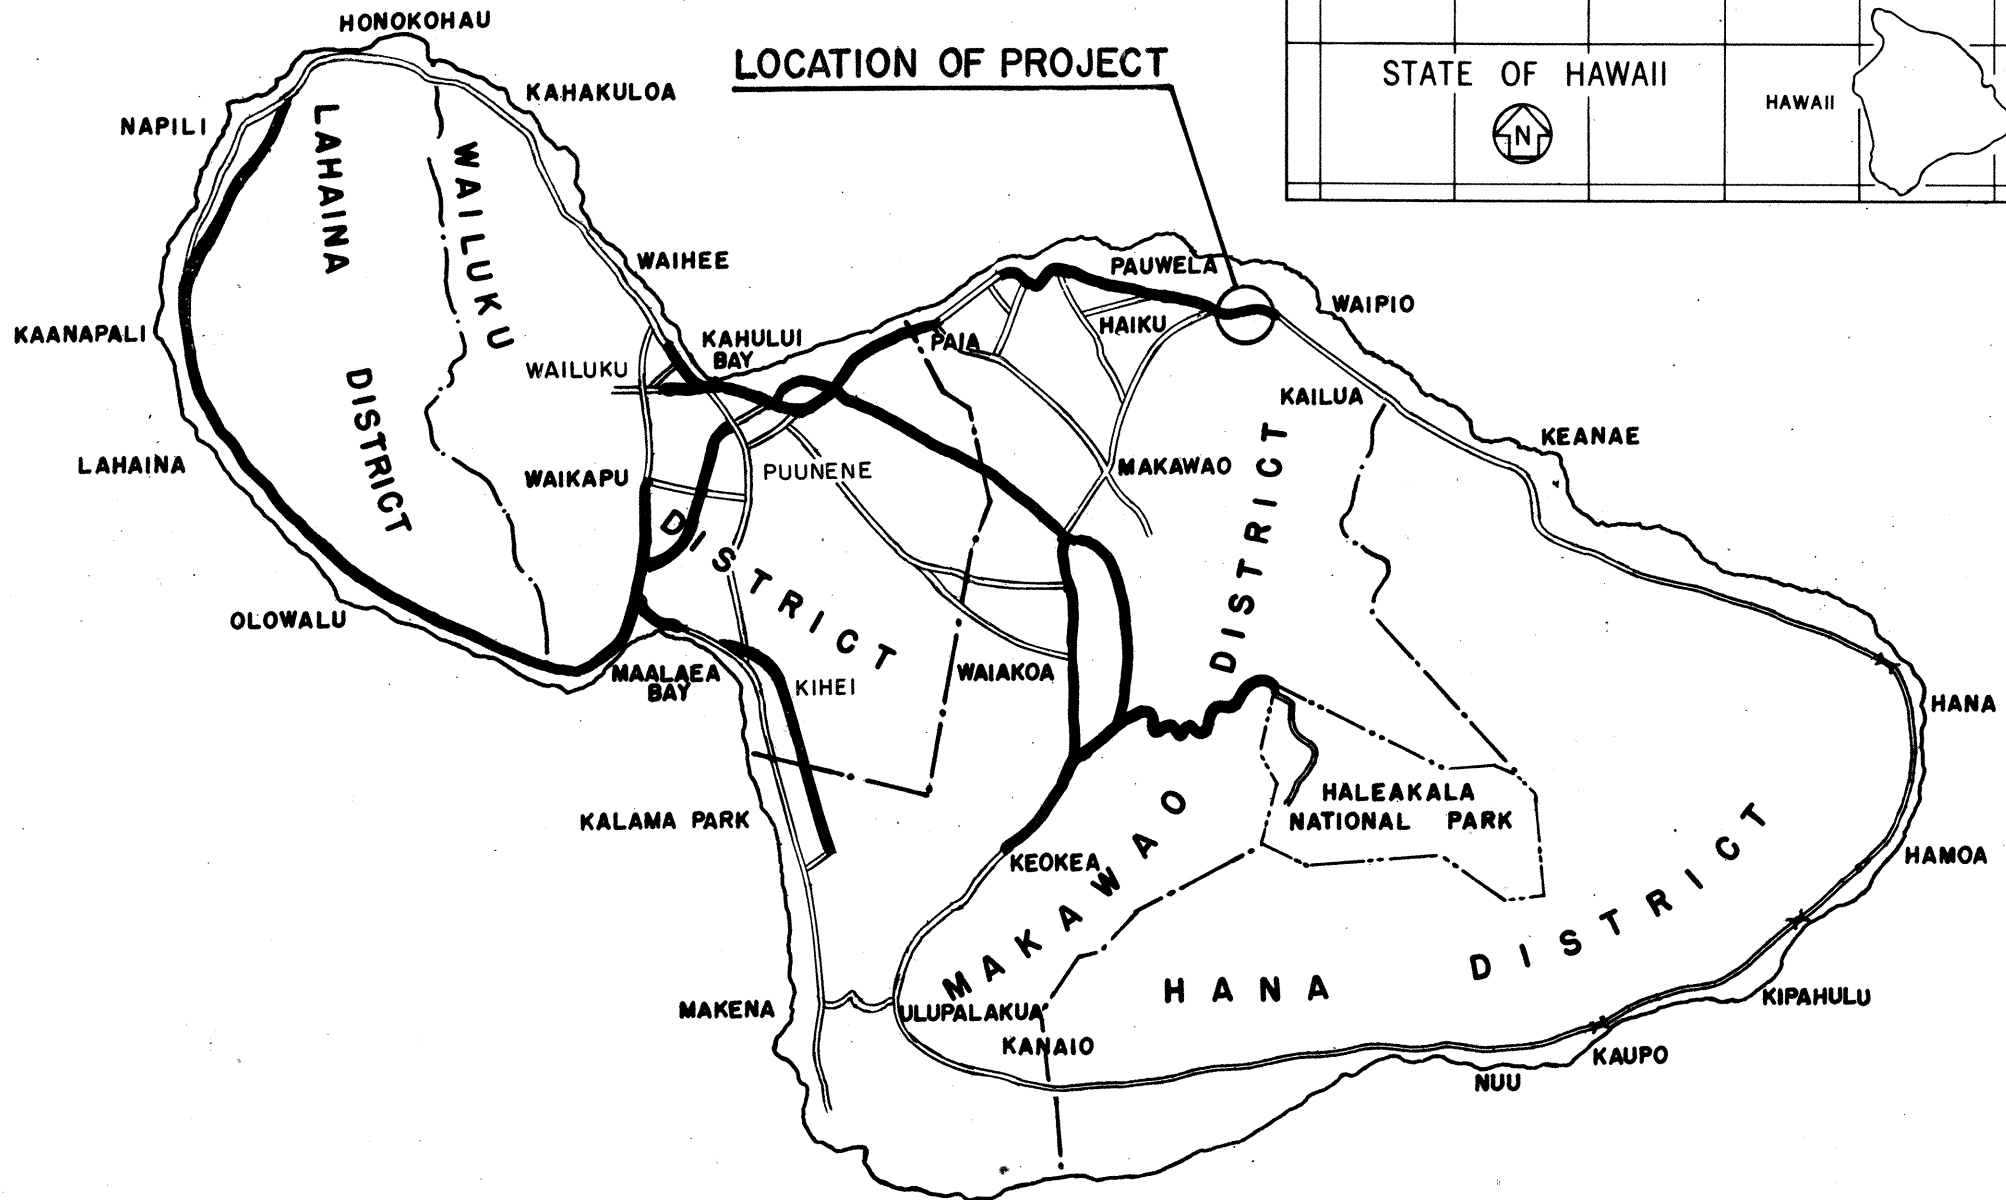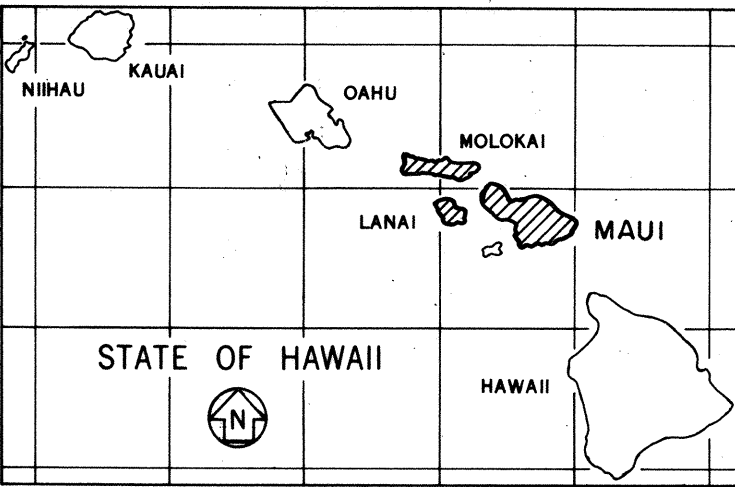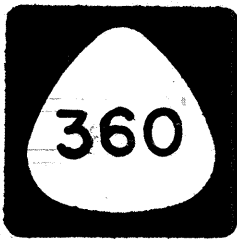

FEDERAL AID PROJECTS PREVIOUSLY CONSTRUCTED OR UNDER CONSTRUCTION

MILE POST 1.98 TO MILE POST 2.36

CHANGES MADE DURING CONSTRUCTION HAVE BEEN INCORPORATED ON THESE PLANS EXCEPT CHANGES IN THE ORIGINAL THEORETICAL QUANTITIES. FOR ACTUAL QUANTITIES, REFER TO PROJECT LEDGER AND/OR COMPUTATION BOOK.


[Signature] 6/4/99
RESIDENT ENGINEER DATE

HAROLD T. MIYAMOTO & ASSOCIATES, INC. DESIGNED BY

FRED ABESHIMA P. S. & E. BY

567-2123 PHONE

9-23-91 DATE

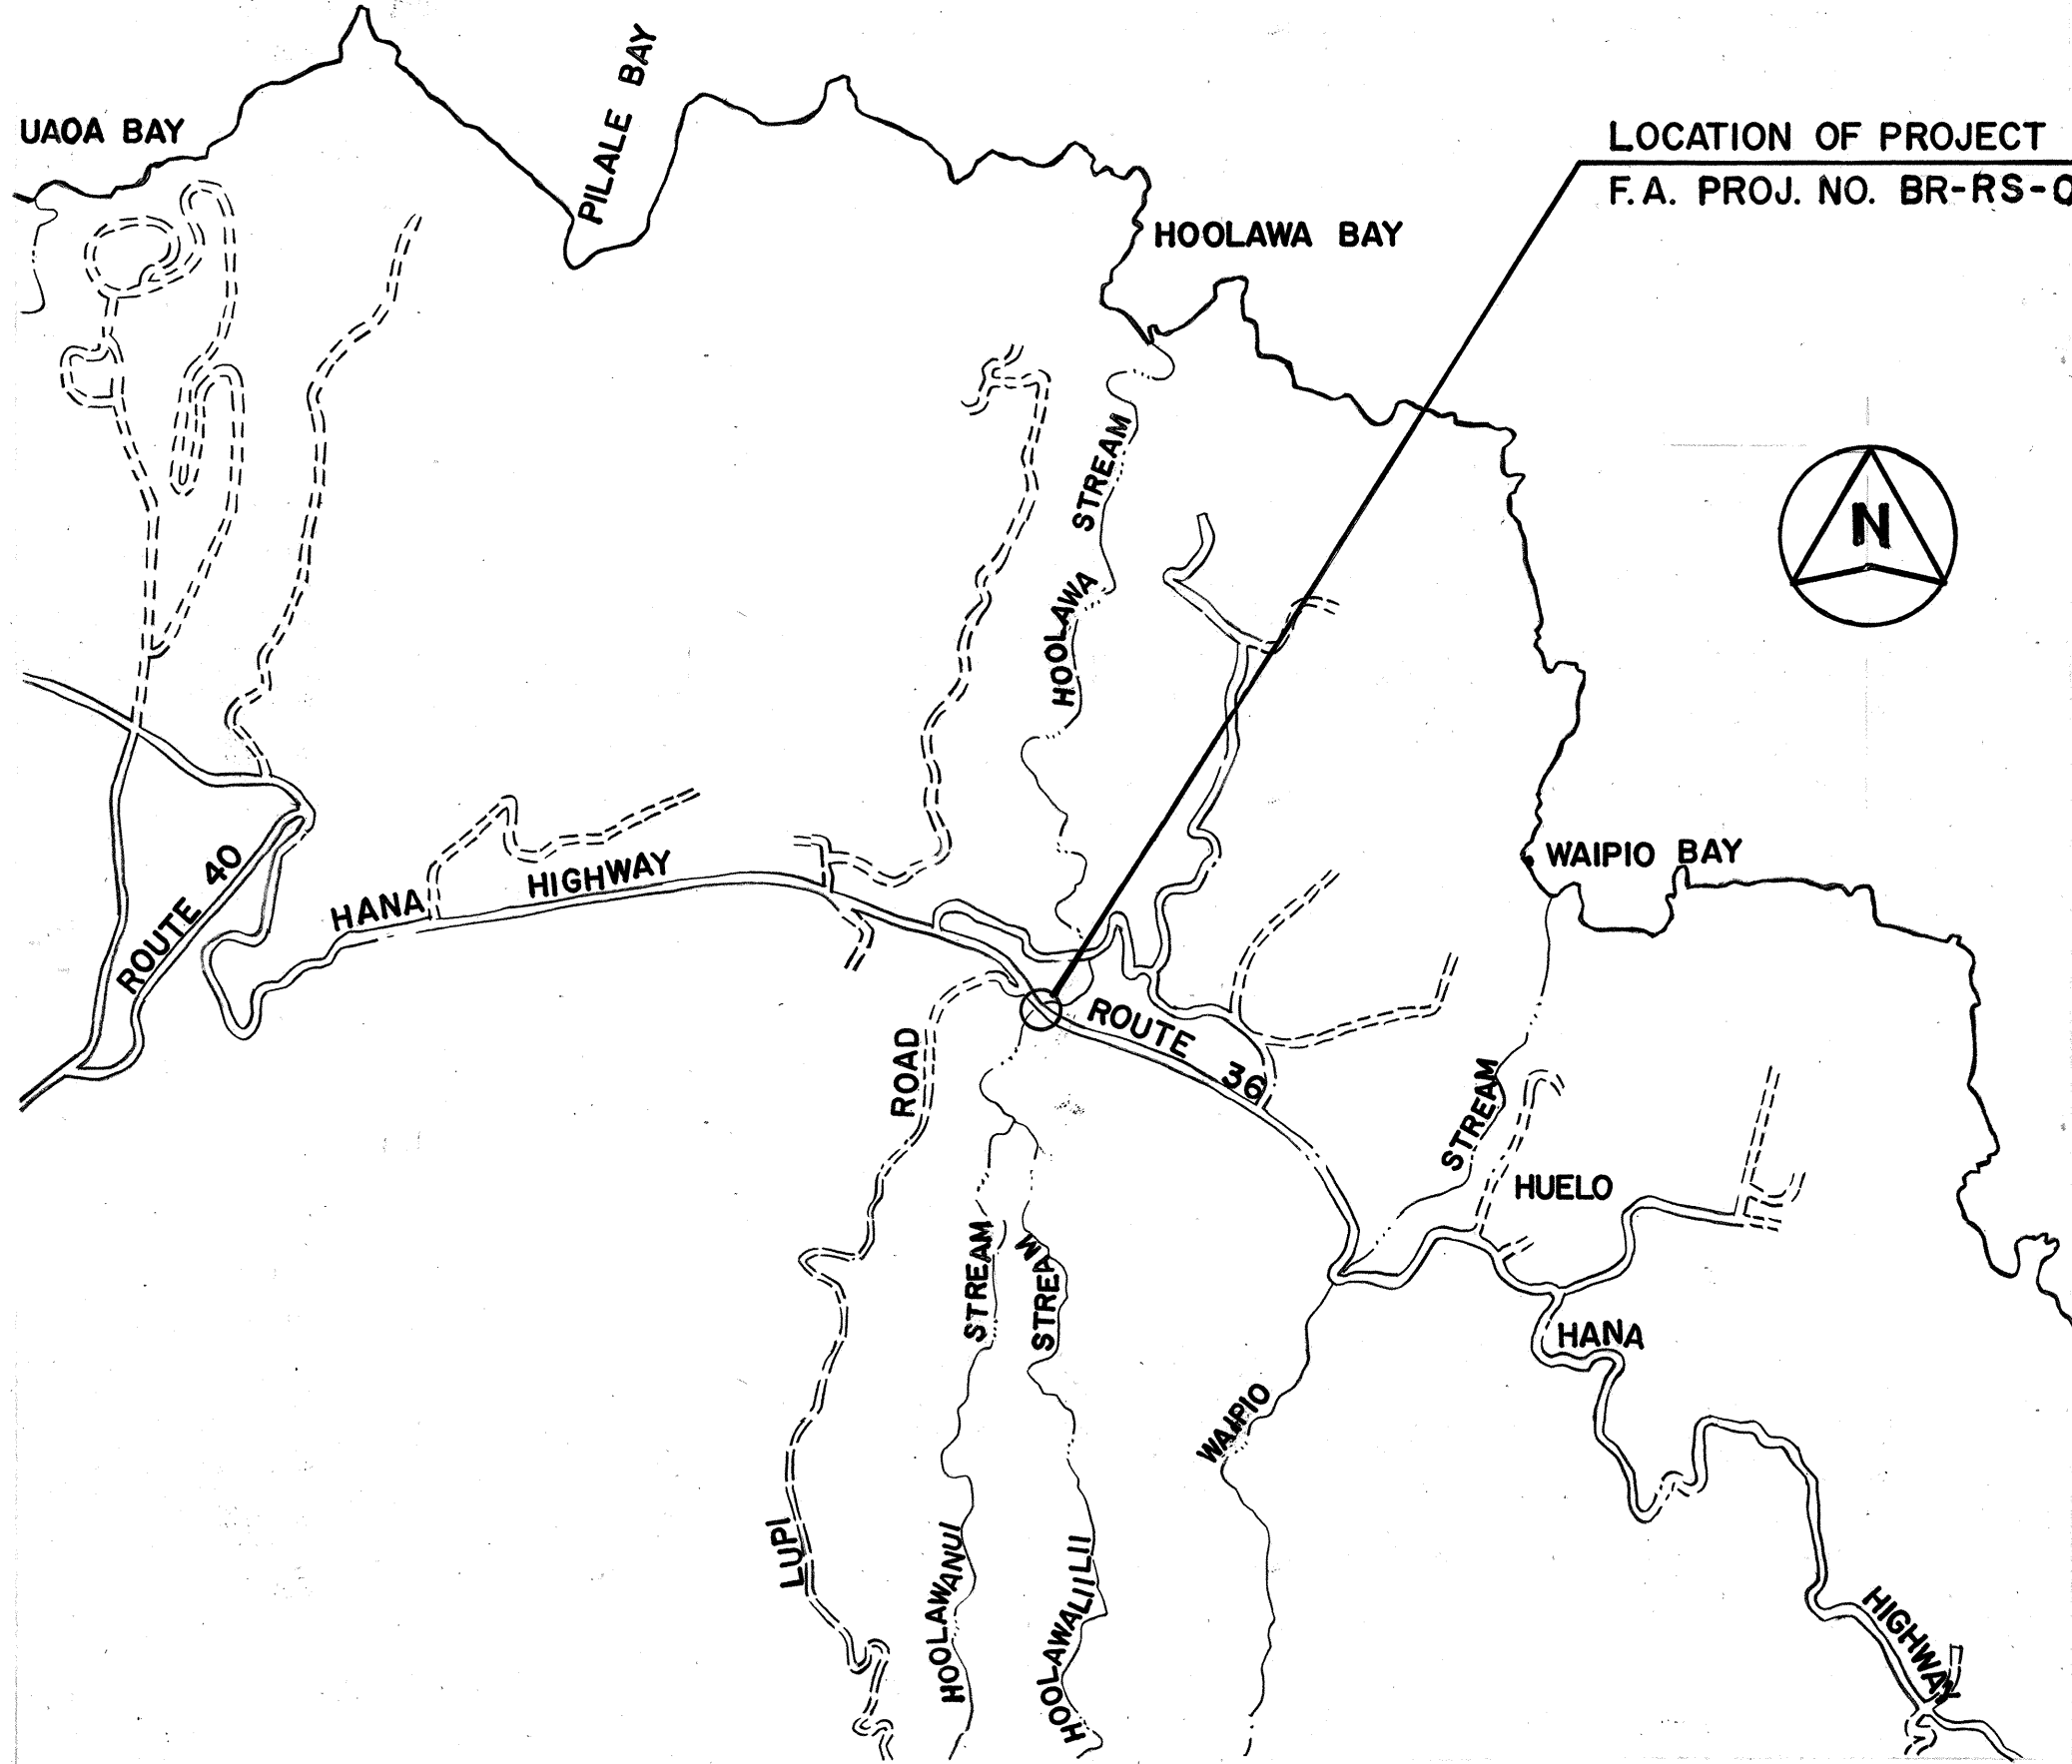

LAYOUT PLAN

0 1/4 1/2 3/4

SCALE IN MILES

DESIGN DESIGNATION

CURRENT ADT (1989) . . . 3,500

DESIGN ADT (2009) . . . 7,700

DHV. 800

D 75/25

T₂₄ 4.5%

V 40 M.P.H.

GROSS LENGTH OF PROJECT = 0.38 MILE

BRIDGE LENGTH = 0.03 MILE

NET LENGTH OF ROADWAY = 0.35 MILE

DEPARTMENT OF TRANSPORTATION
FEDERAL HIGHWAY ADMINISTRATION

APPROVED:

[Signature] 11/26/91
DIVISION ADMINISTRATOR DATE

DEPARTMENT OF TRANSPORTATION
STATE OF HAWAII

APPROVED:

[Signature] 9/23/91
DIR. OF TRANSPORTATION DATE