

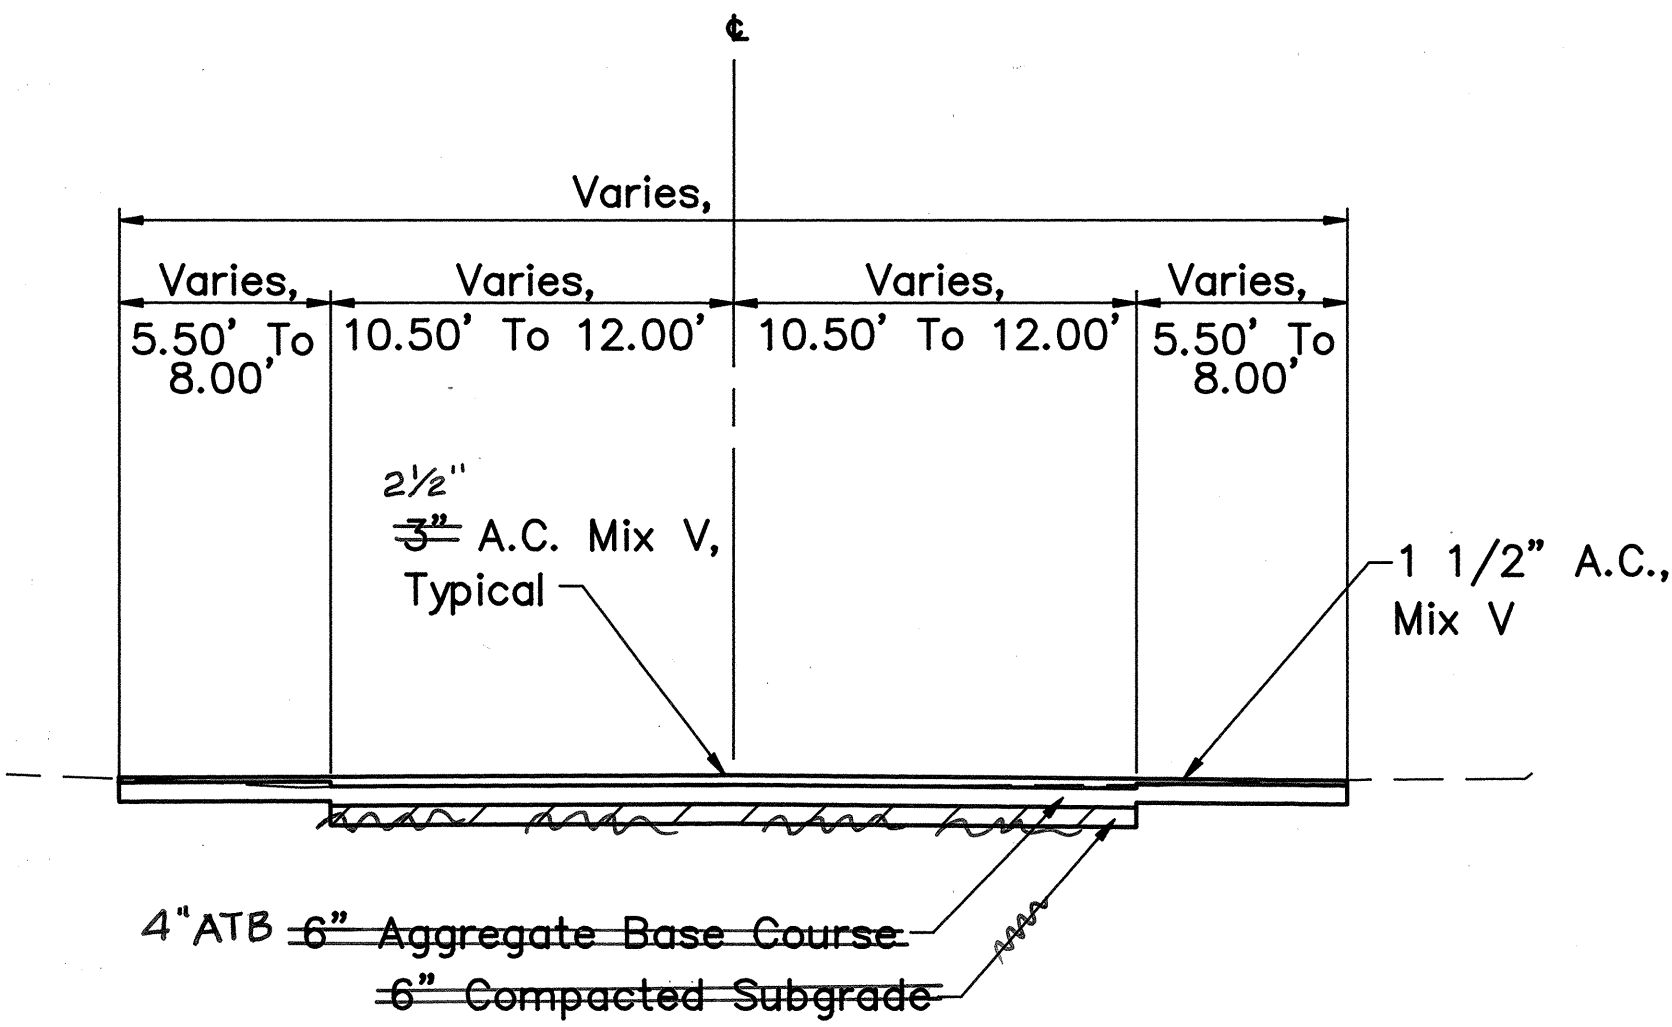



| FED. ROAD DIST. NO. | STATE | FED. AID PROJ. NO. | FISCAL YEAR | SHEET NO. | TOTAL SHEETS |
|---------------------|-------|--------------------|-------------|-----------|--------------|
| HAWAII              | HAW.  | BR-RS-0360(6)      | 1992        | 5         | 75           |

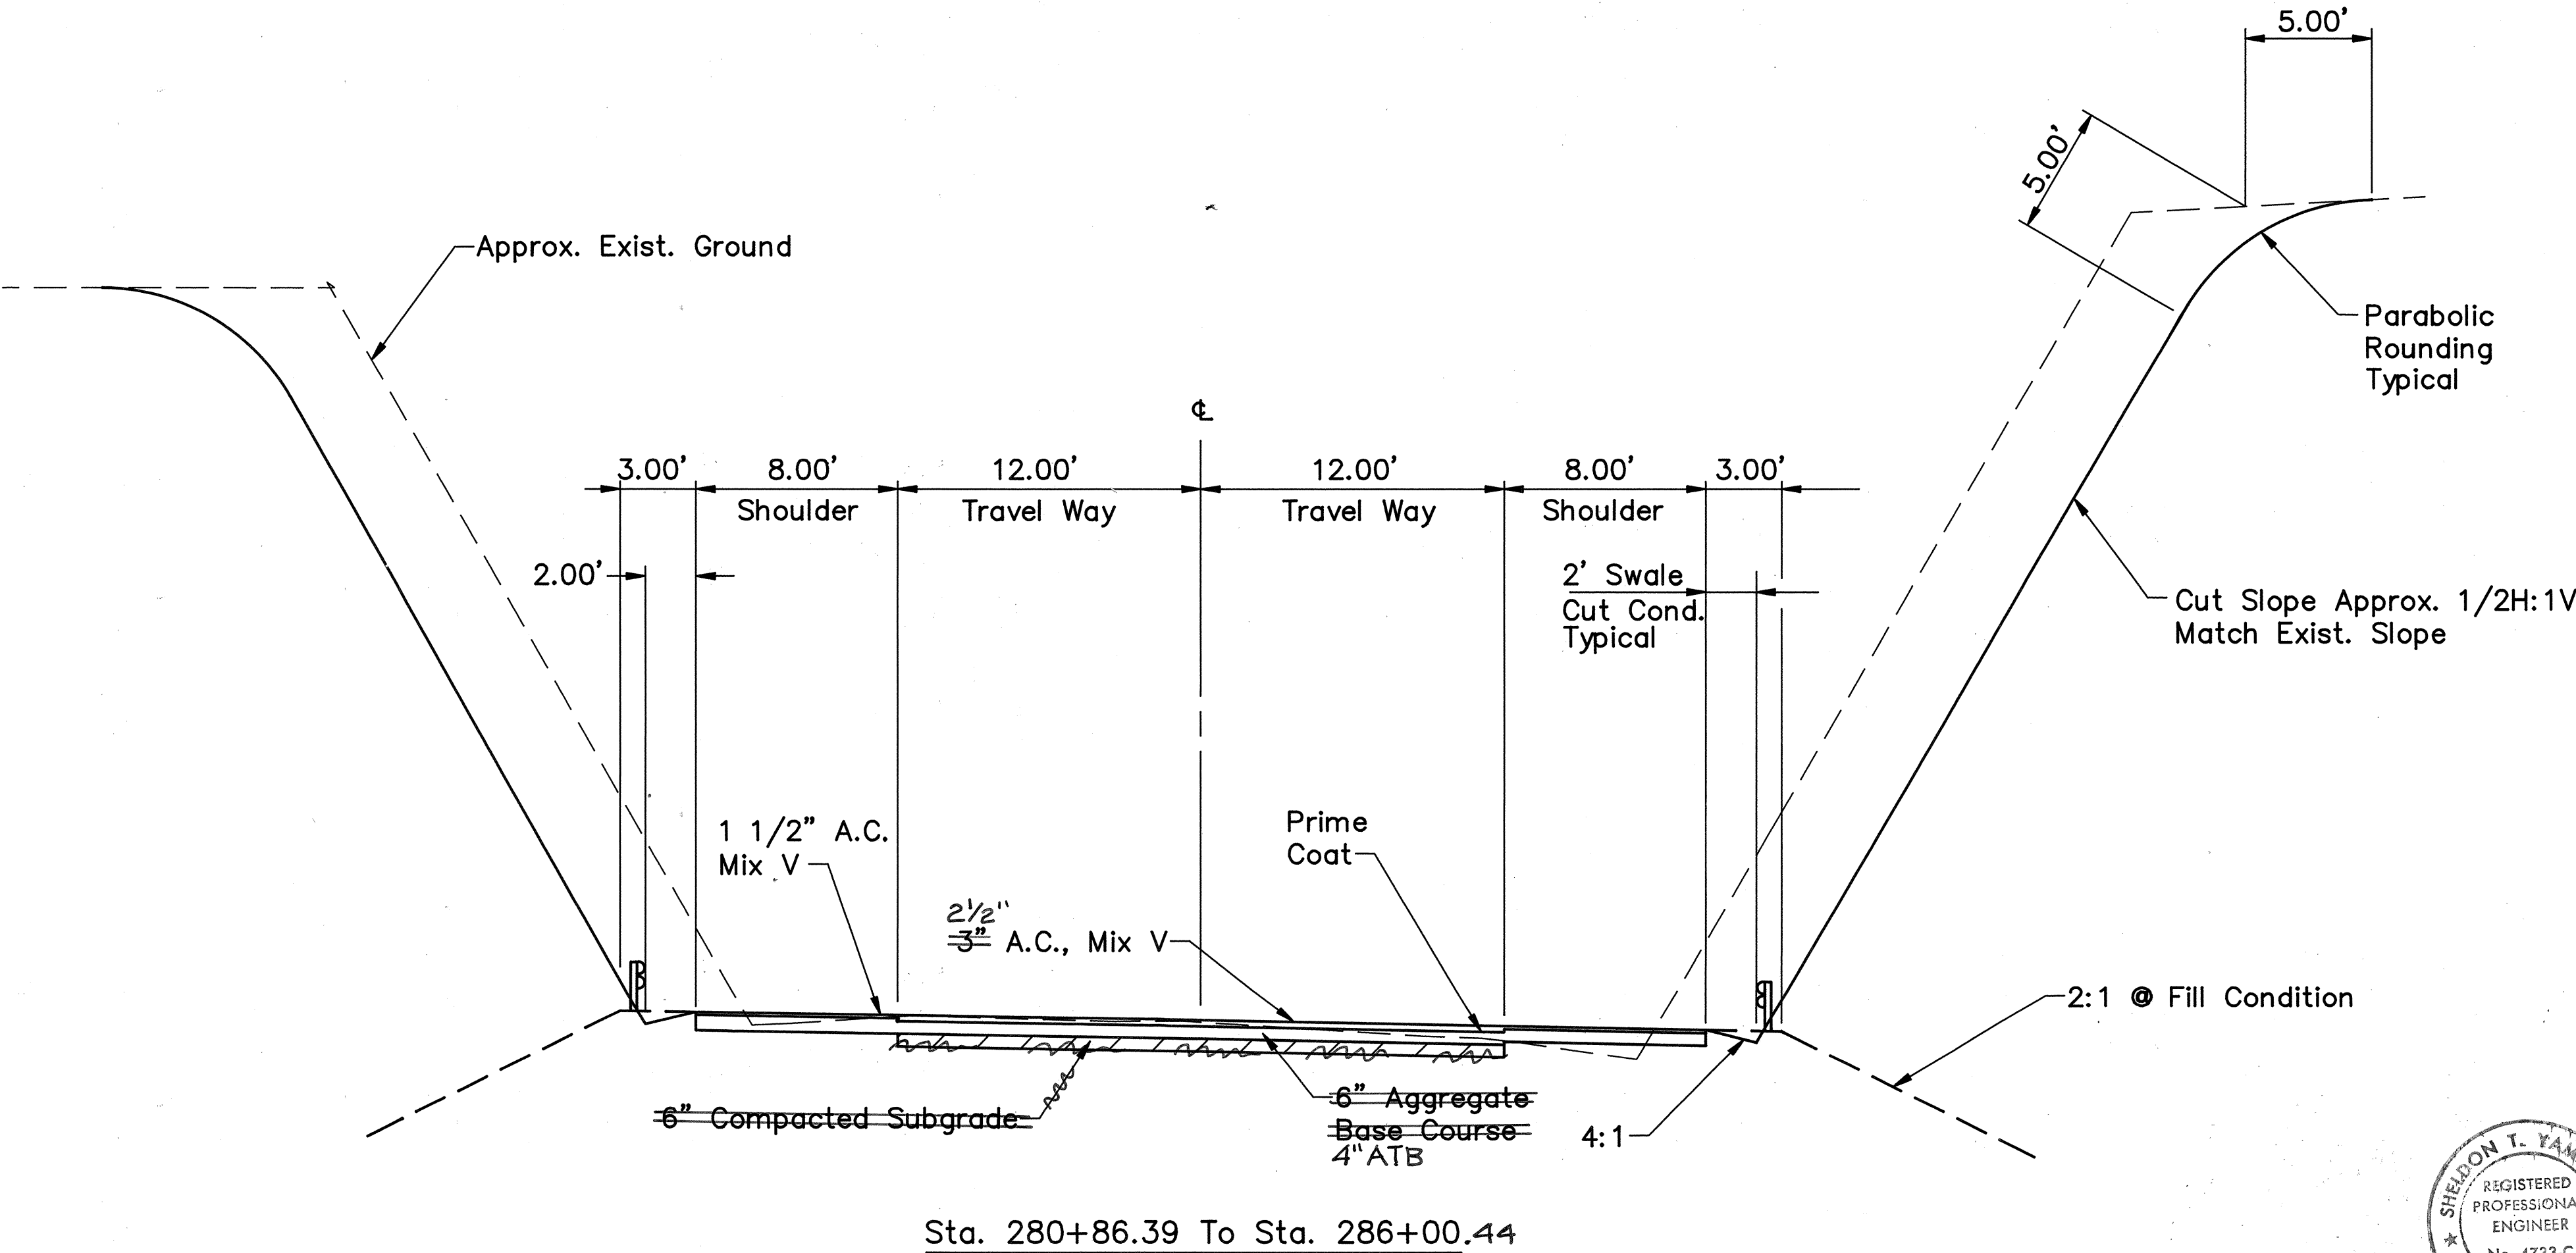

Sta. 297+39.50 to Sta. 298+89.54  
Sta. 279+36.39 to Sta. 280+86.39

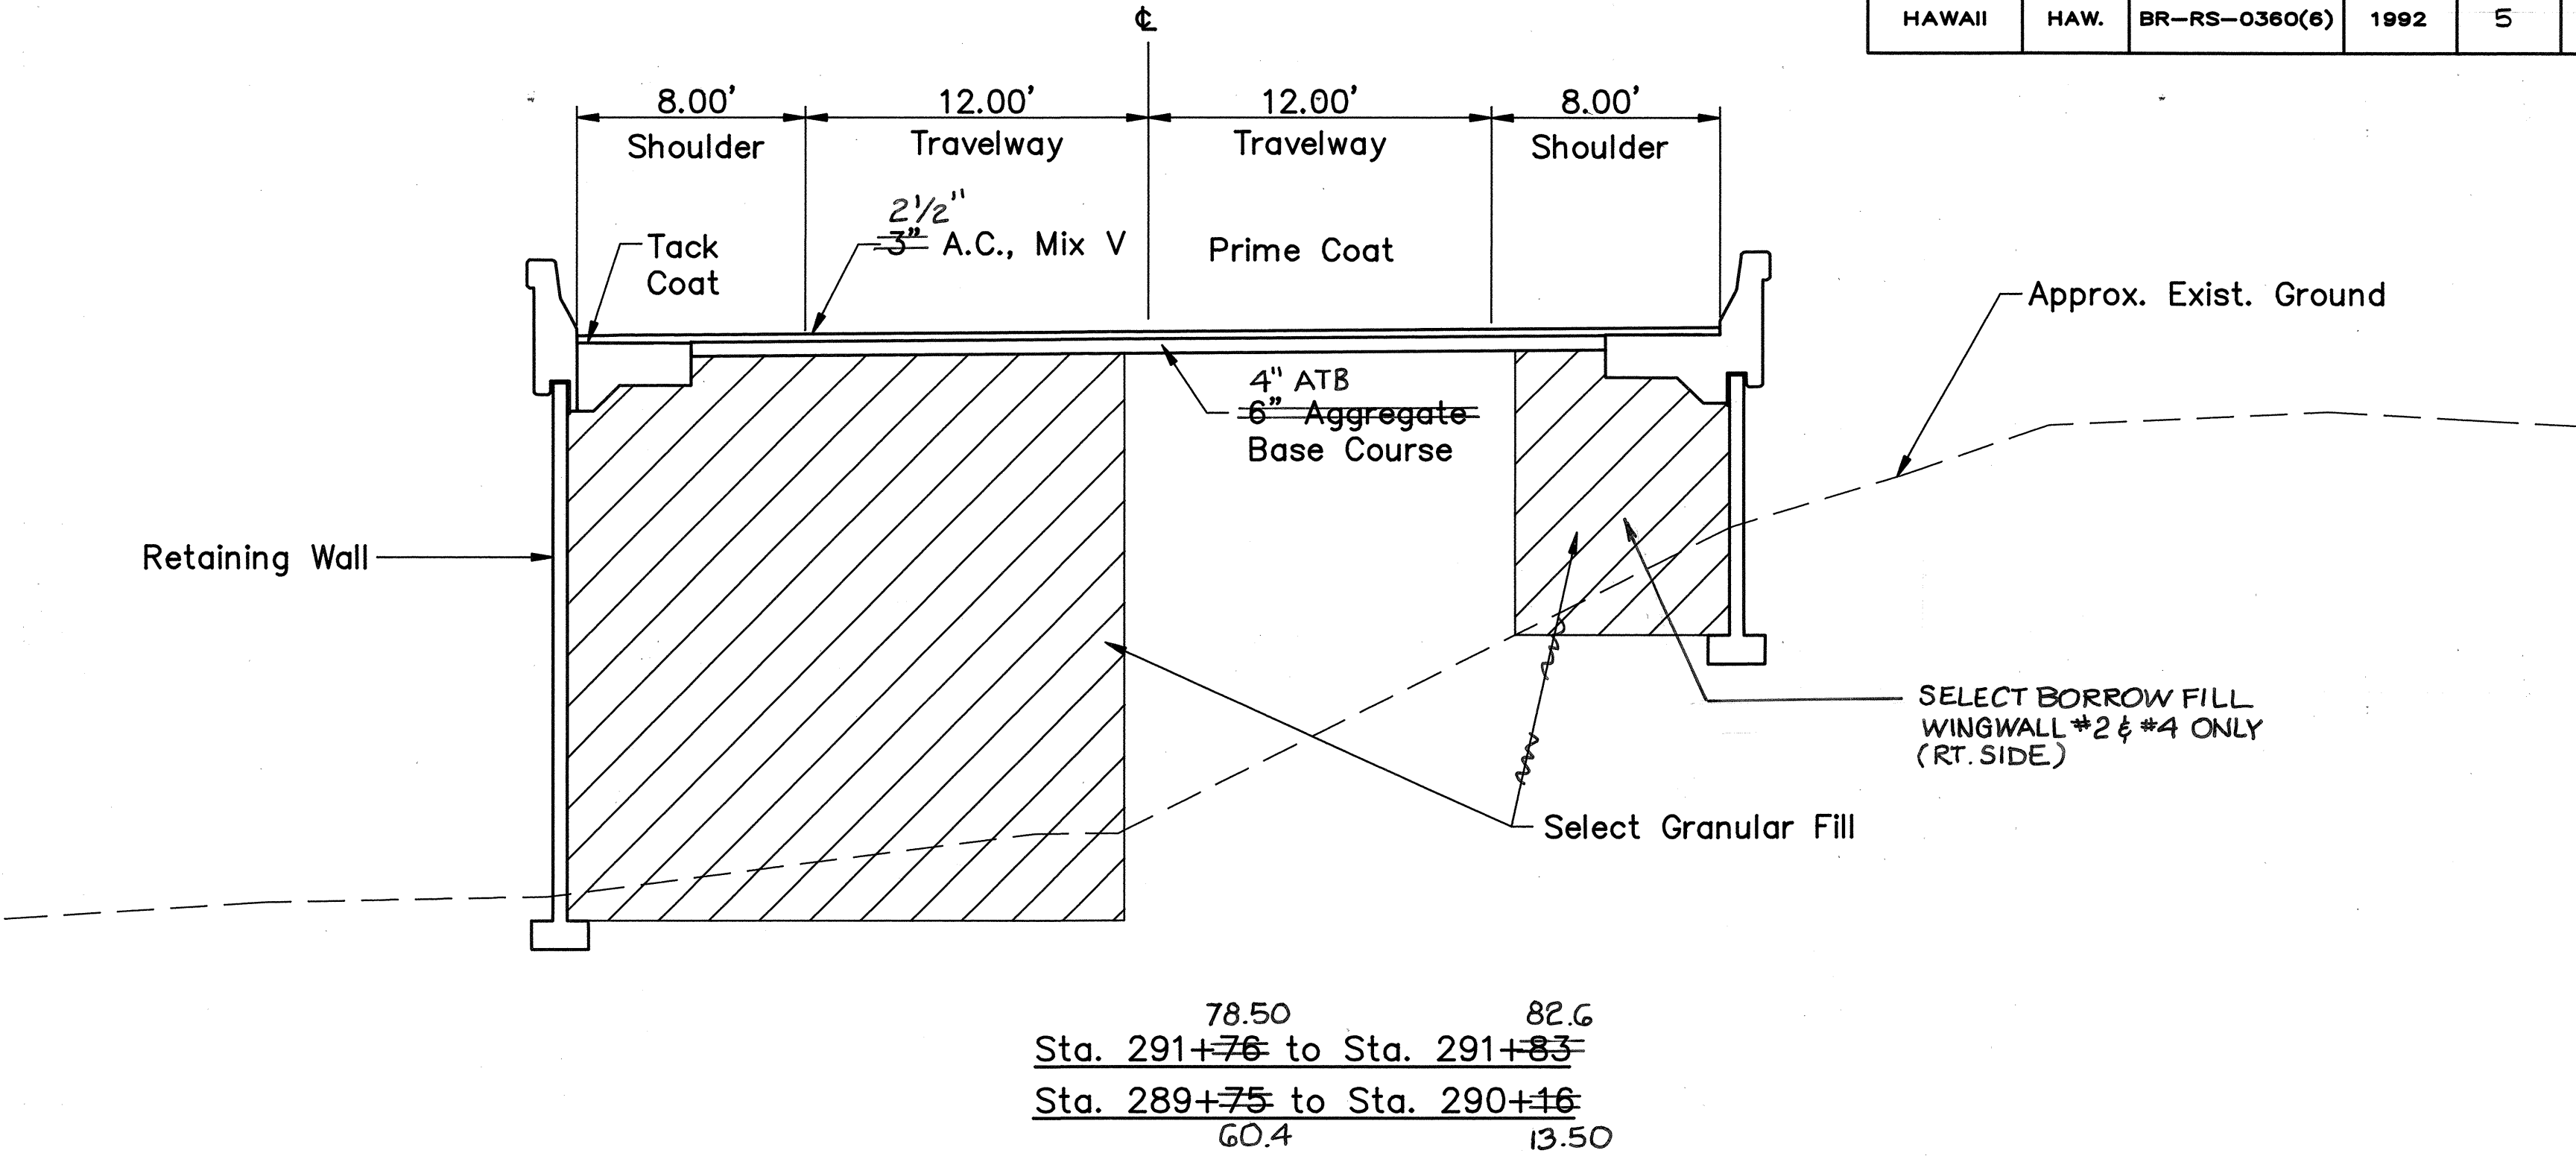

Typical Road Sections  
Scale: 1" = 5'

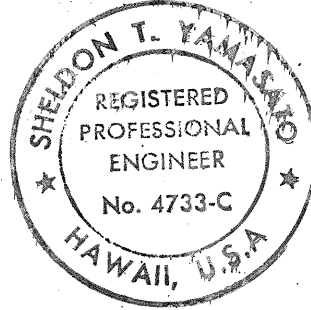


THIS WORK WAS PREPARED BY  
ME OR UNDER MY SUPERVISION.



*Shannon T. Yamaguchi*

STATE OF HAWAII  
DEPARTMENT OF TRANSPORTATION  
HIGHWAYS DIVISION  
**TYPICAL ROAD SECTIONS**  
HOOLAWA BRIDGE REPLACEMENT  
HANA HWY., HOOLAWA, MAUI  
PROJECT NO. BR-RS-0360(6)  
SCALE: 1" = 5' DATE: SEPT. 17, 1991  
SHEET NO. OF SHEETS



| FED. ROAD DIST. NO. | STATE | FED. AID PROJ. NO. | FISCAL YEAR | SHEET NO. | TOTAL SHEETS |
|---------------------|-------|--------------------|-------------|-----------|--------------|
| HAWAII              | HAW.  | BR-RS-0360(6)      | 1992        | 6         | 75           |

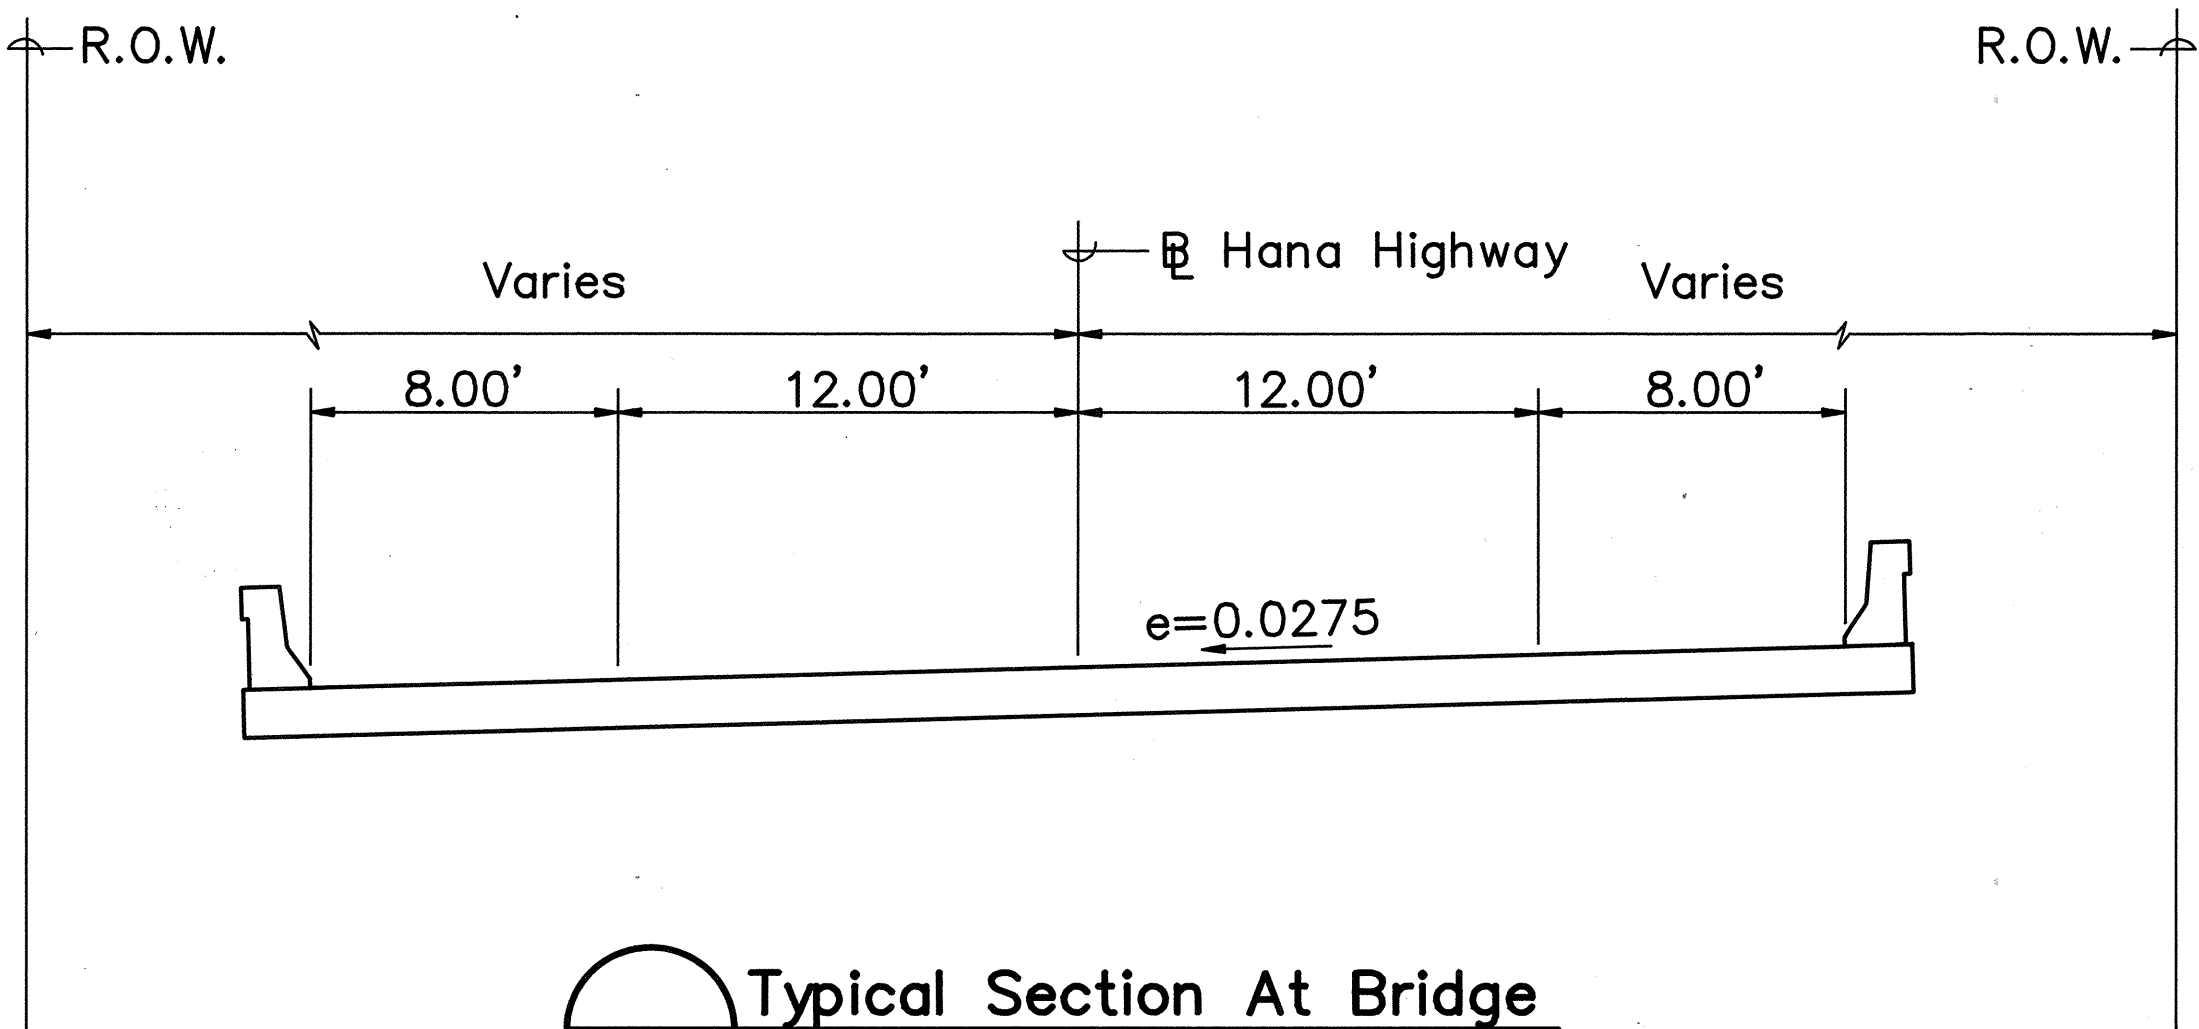

**Typical Section At Bridge**  
 Scale: 1" = 5'  
 Station 210+13.5 to 210+78.5

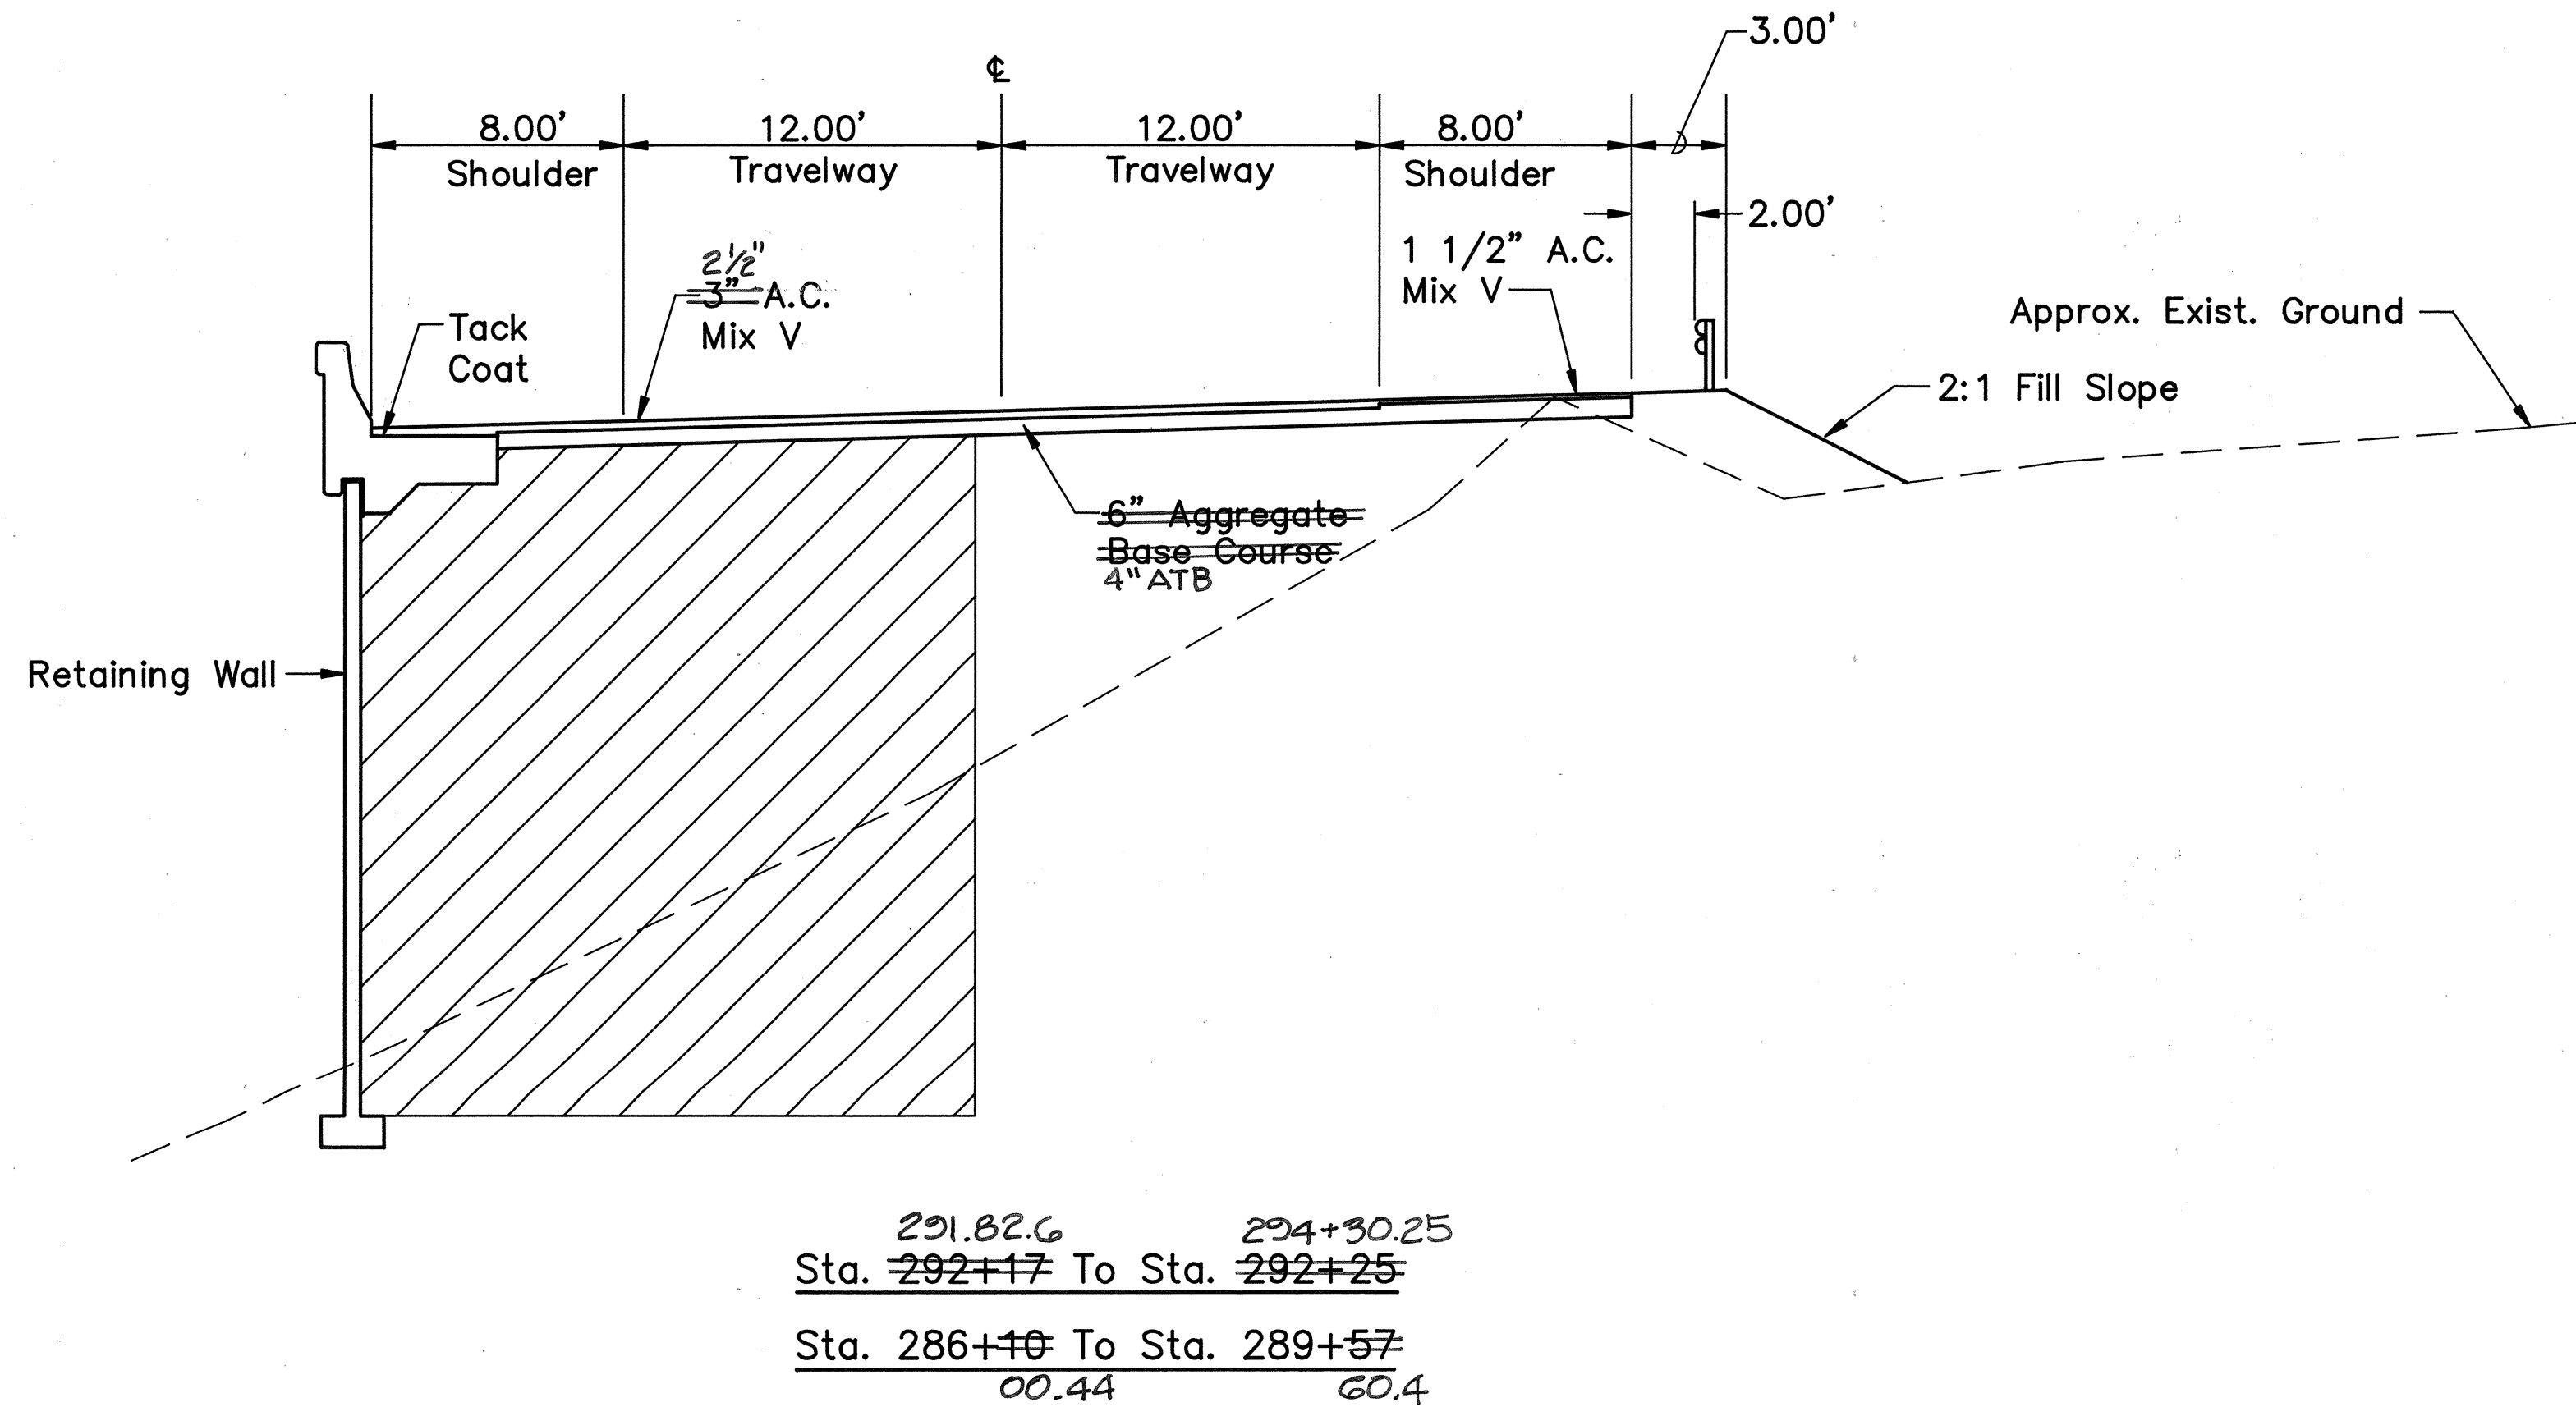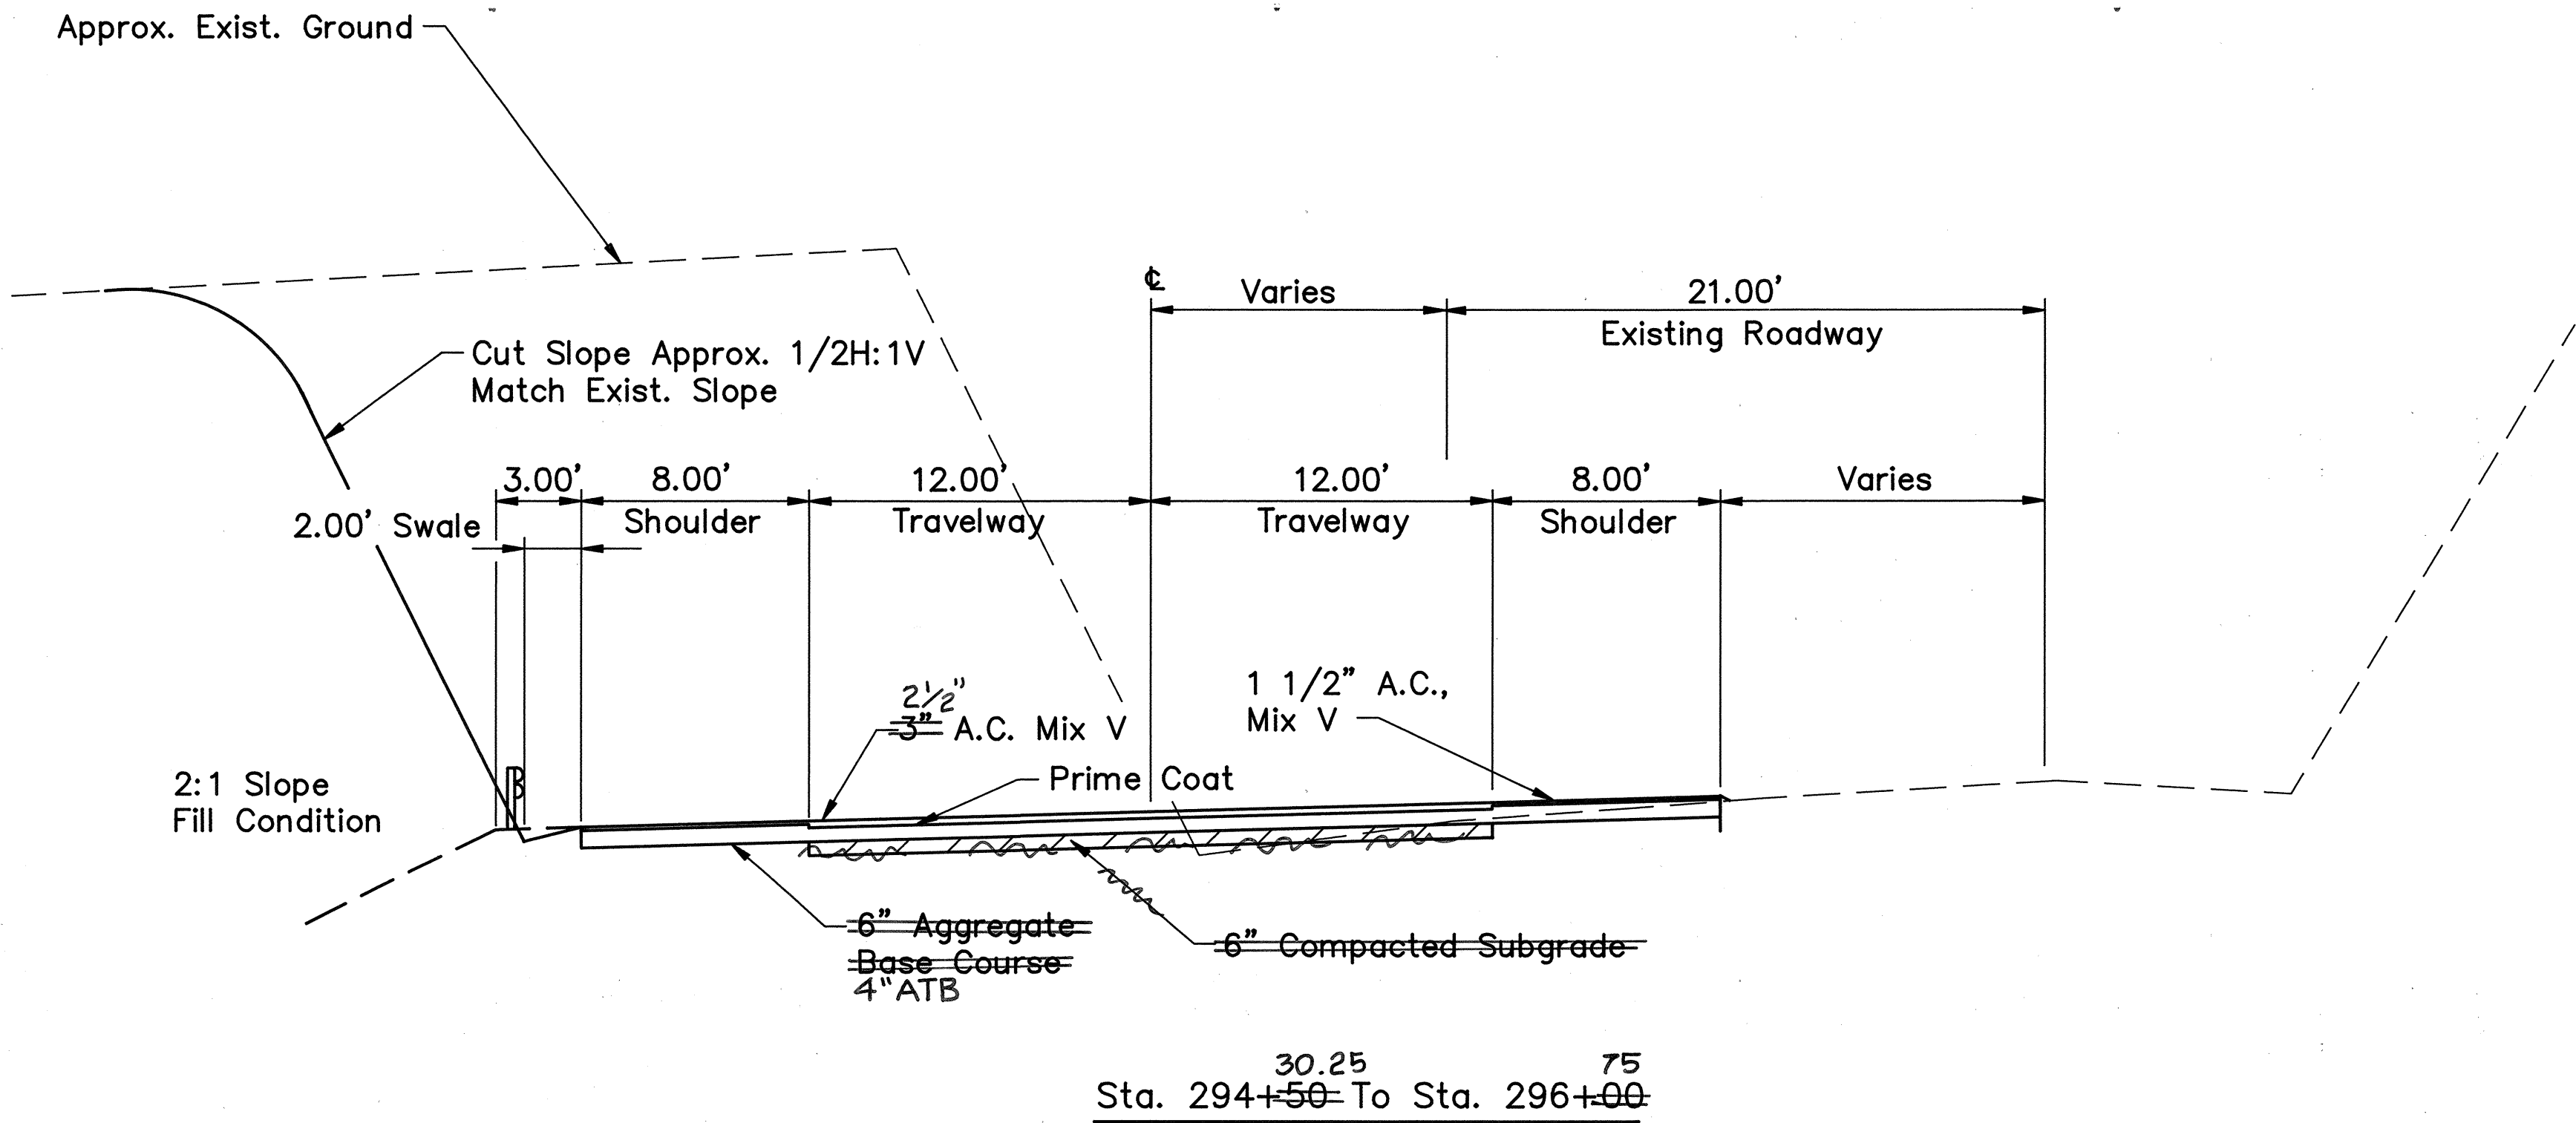

**Typical Road Sections**  
 Scale: 1" = 5'

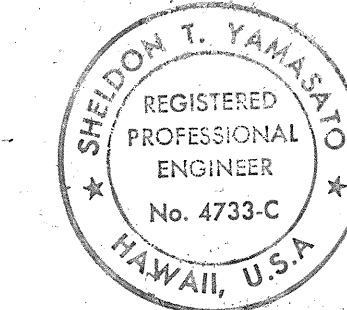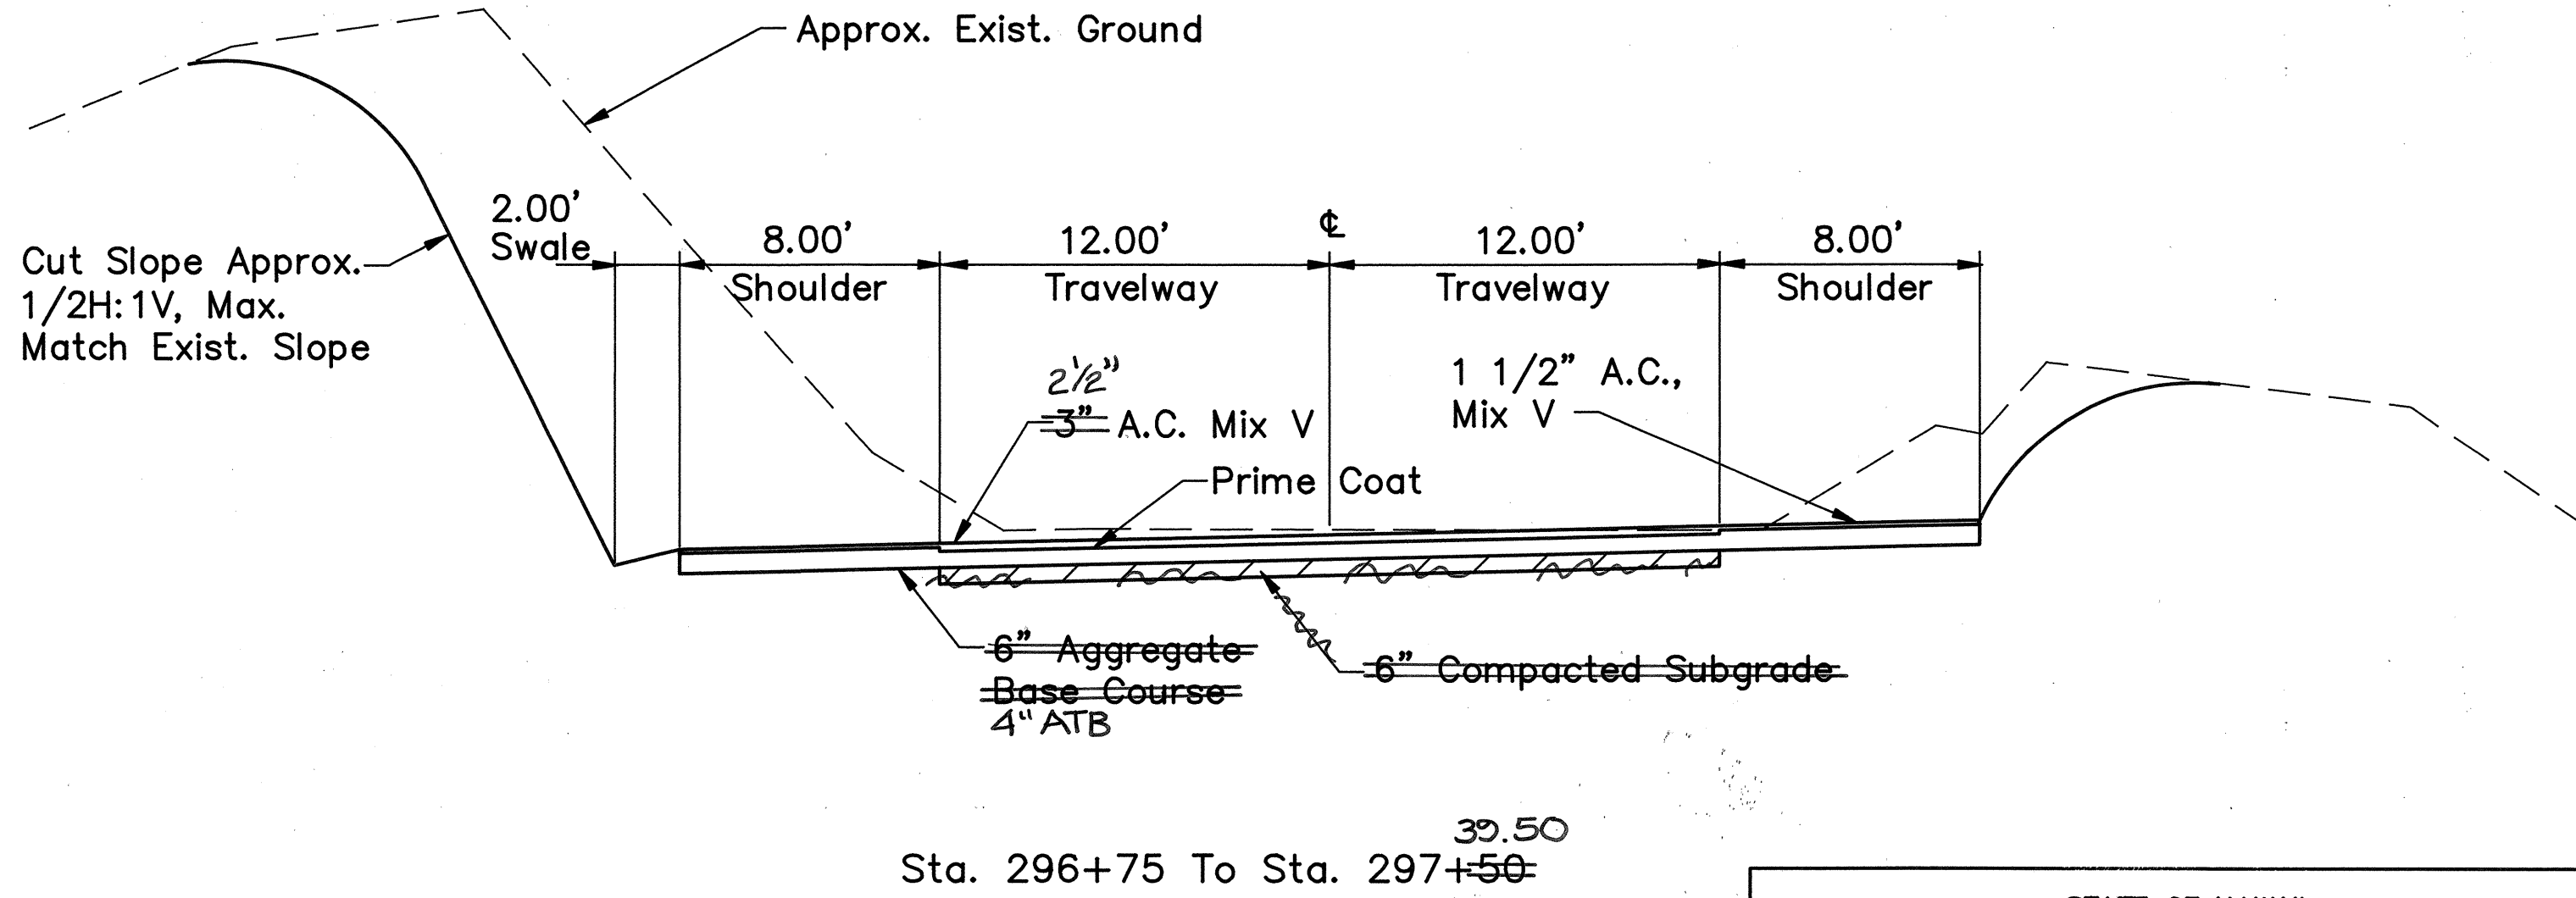

THIS WORK WAS PREPARED BY  
 ME OR UNDER MY SUPERVISION.

*Sheldon T. Yamashita*

STATE OF HAWAII  
DEPARTMENT OF TRANSPORTATION  
HIGHWAYS DIVISION

**TYPICAL ROAD SECTIONS**  
  
HOOLAWA BRIDGE REPLACEMENT  
HANA HWY., HOOLAWA, MAUI  
PROJECT NO. BR-RS-0360(6)

SCALE: 1" = 5'  
SHEET NO. OF SHEETS

DATE: SEPT. 17, 1991

WORKSHEET:  
 REVIEWED BY:  
 REVIEWED BY:

PM: STY  
 OPR: JSK\*DHV,TWL  
 REVISED: 10/8/91

FILE: HTM0430  
 SCALE: 1"=5'  
 BEG: 6/26/90

| DATE              | BY |
|-------------------|----|
| SURVEY PLOTTED BY |    |
| DRAWN BY          |    |
| DESIGNED BY       |    |
| QUANTITIES BY     |    |
| CHECKED BY        |    |
| ORIGINAL PLAN     |    |
| NOTES             |    |
| No.               |    |