	INDEX TO DRAWINGS
SHEET NO.	DESCRIPTION
1	TITLE SHEET
2	STANDARD PLANS SUMMARY
3	GENERAL NOTES AND LEGEND
4–5	TYPICAL SECTIONS AND DETAILS
6–12	PLANS
13–24	PAVEMENT MARKING & SIGNING PLANS, LEGEND, DETAILS AND NOTES
MENNELS MANAGEMENT AND A STATE OF THE STATE	
<u> </u>	

STATE OF HAWAII

DEPARTMENT OF TRANSPORTATION

HIGHWAYS DIVISION
HONOLULU, HAWAII


"AS-BUILT"

PLANS FOR

HANA HIGHWAY RESURFACING


VARIOUS LOCATIONS
PROJECT NO. 360B-01-93M

DISTRICT OF HANA
ISLAND OF MAUI

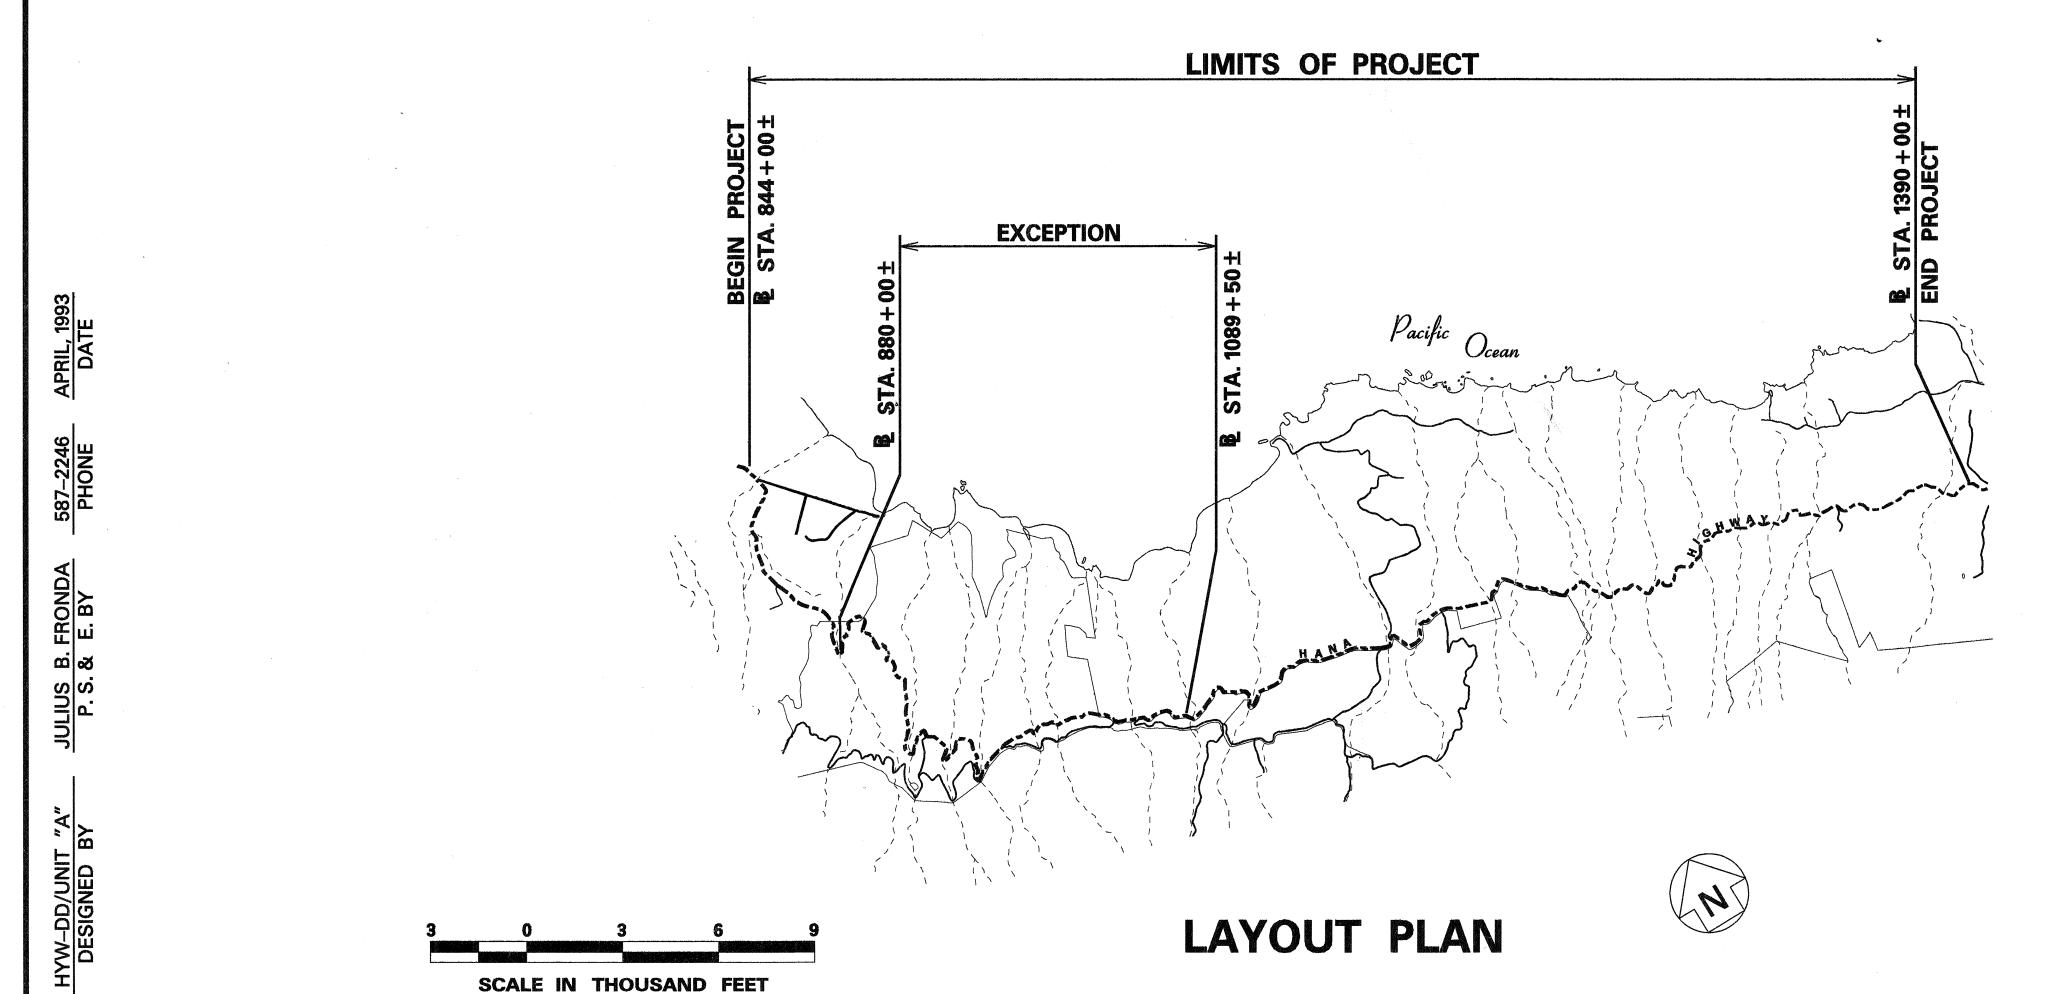

FED. ROAD DIST. NO. STATE PROJ. NO. FISCAL YEAR NO. SHEETS

HAWAII HAW. 360B-01-93M 1993 1 24

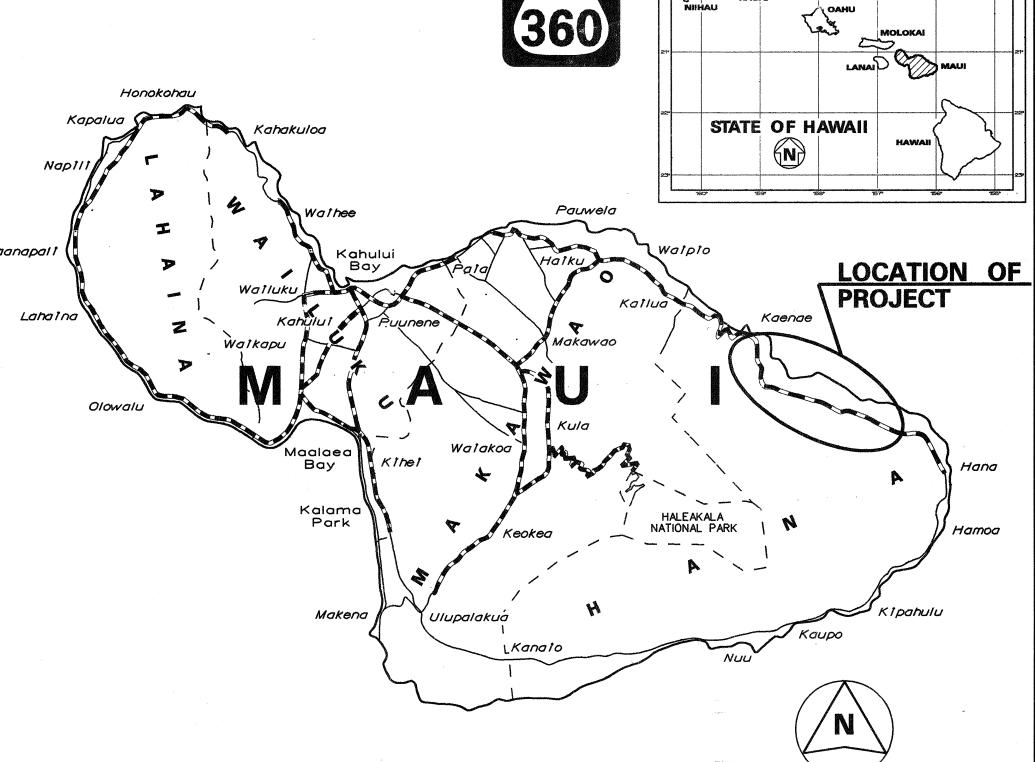

FEDERAL AID PROJECTS PREVIOUSLY CONSTRUCTED OR UNDER CONSTRUCTION

MILE POST 18.74 TO MILE POST 19.39

MILE POST 23.38 TO MILE POST 29.04

NO SIGNIFICANT CHANGES WERE MADE DURING CONSTRUCTION ON THESE PLANS EXCEPT CHANGES IN THE ORIGINAL THEORETICAL QUANTITIES. FOR ACTUAL QUANTITIES, REFER TO PROJECT LEDGER AND OR COMPUTATION BOOKS.

PROJECT ENGINEER

9-5-96 DATE

PR DIR. OF TRANSPORTATION