
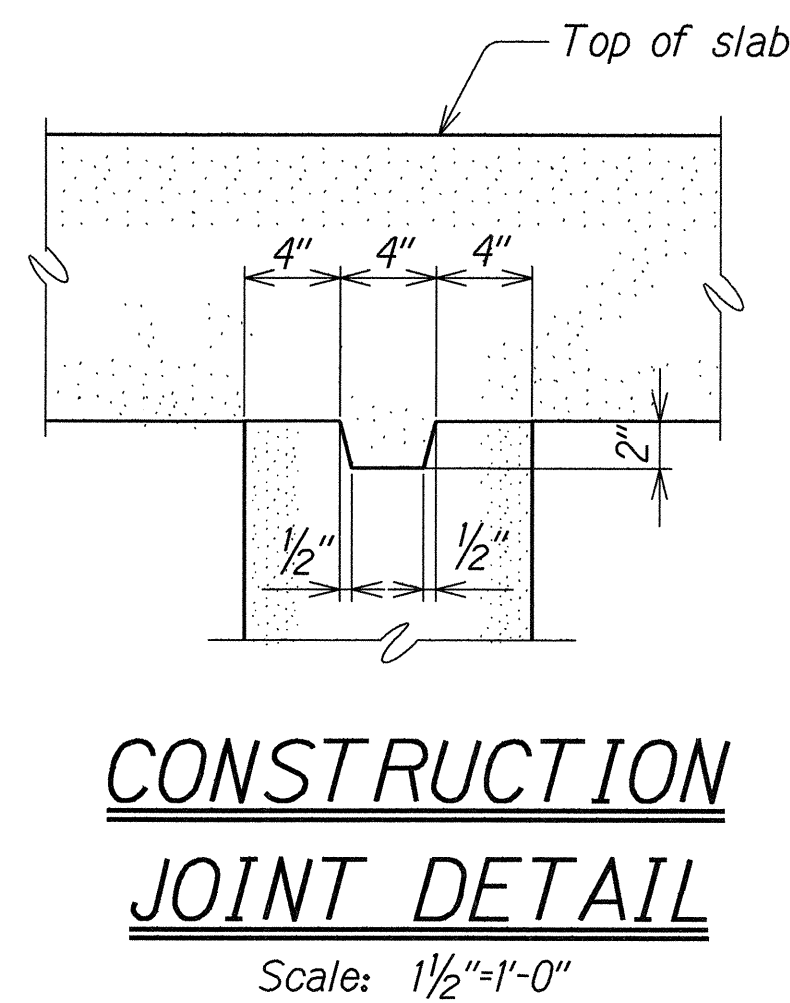
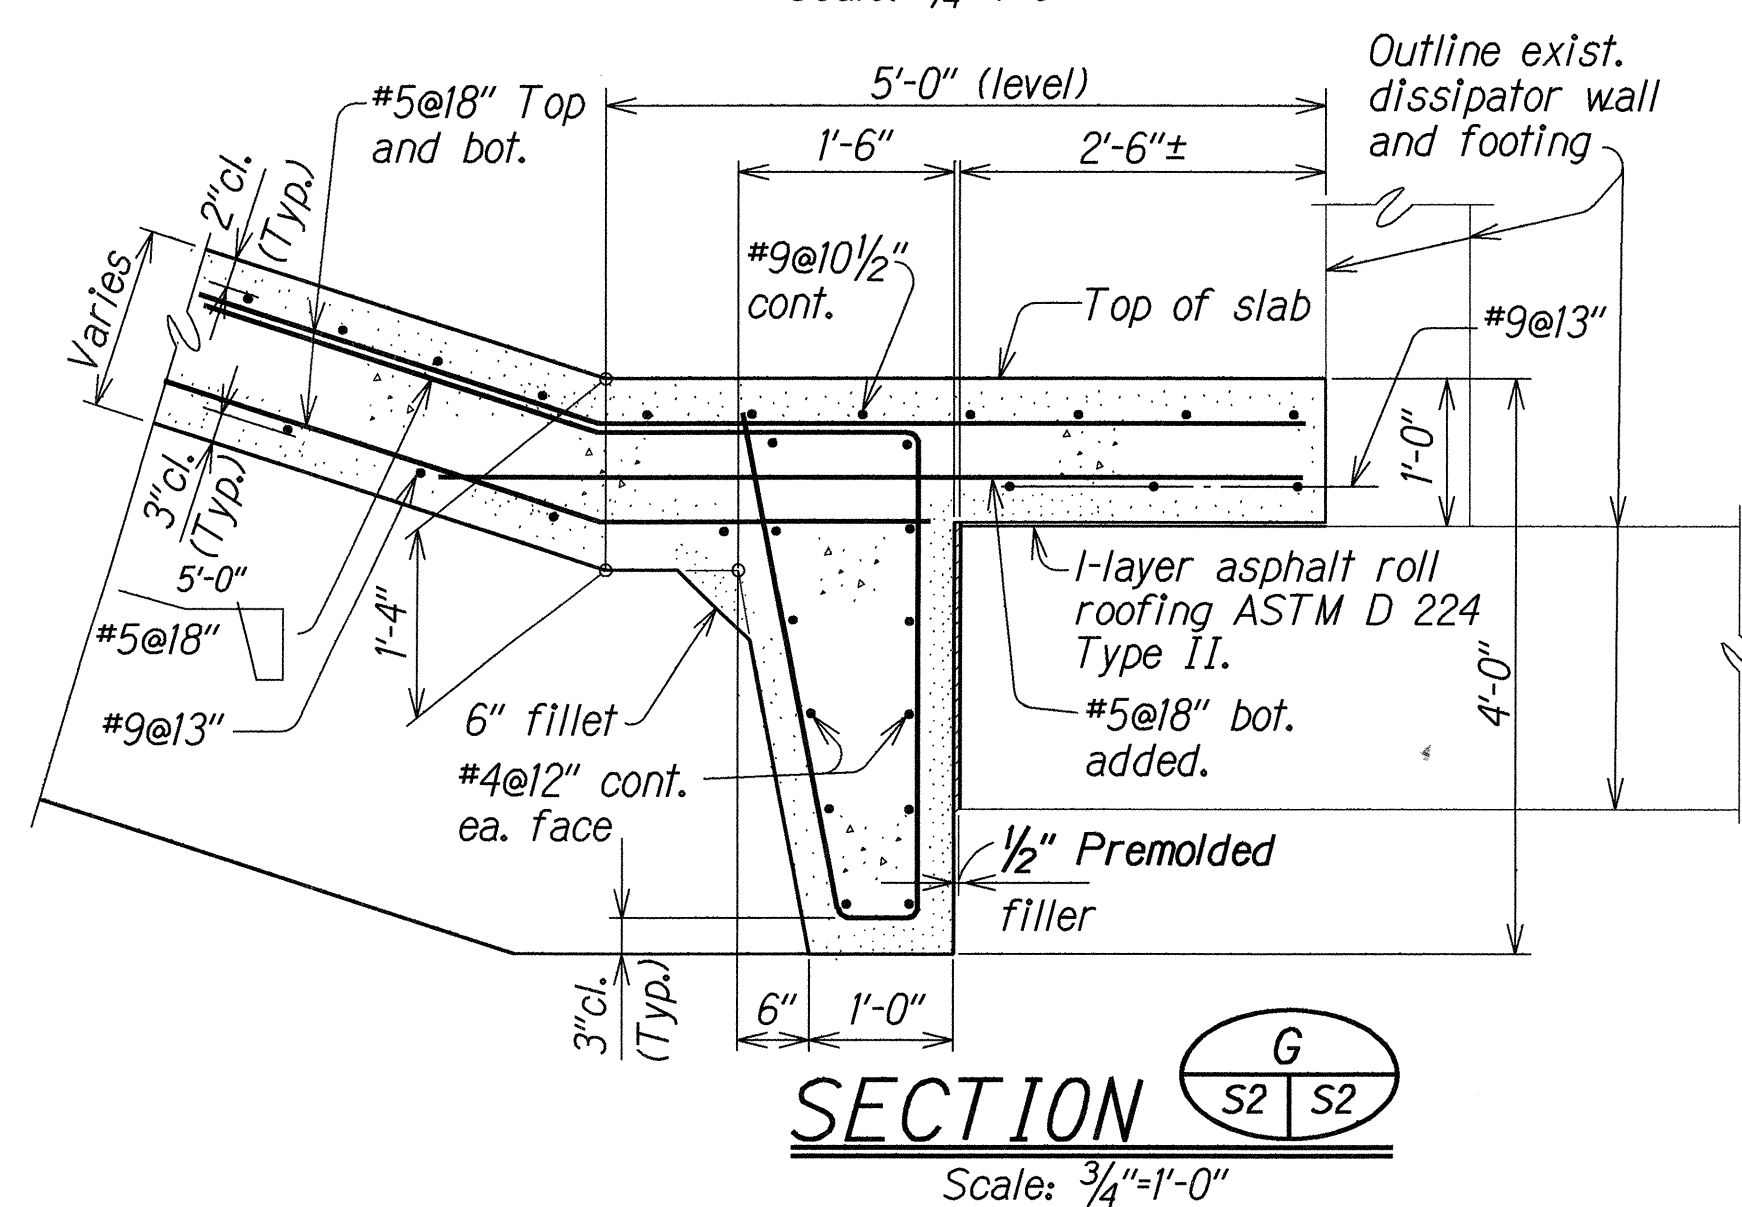
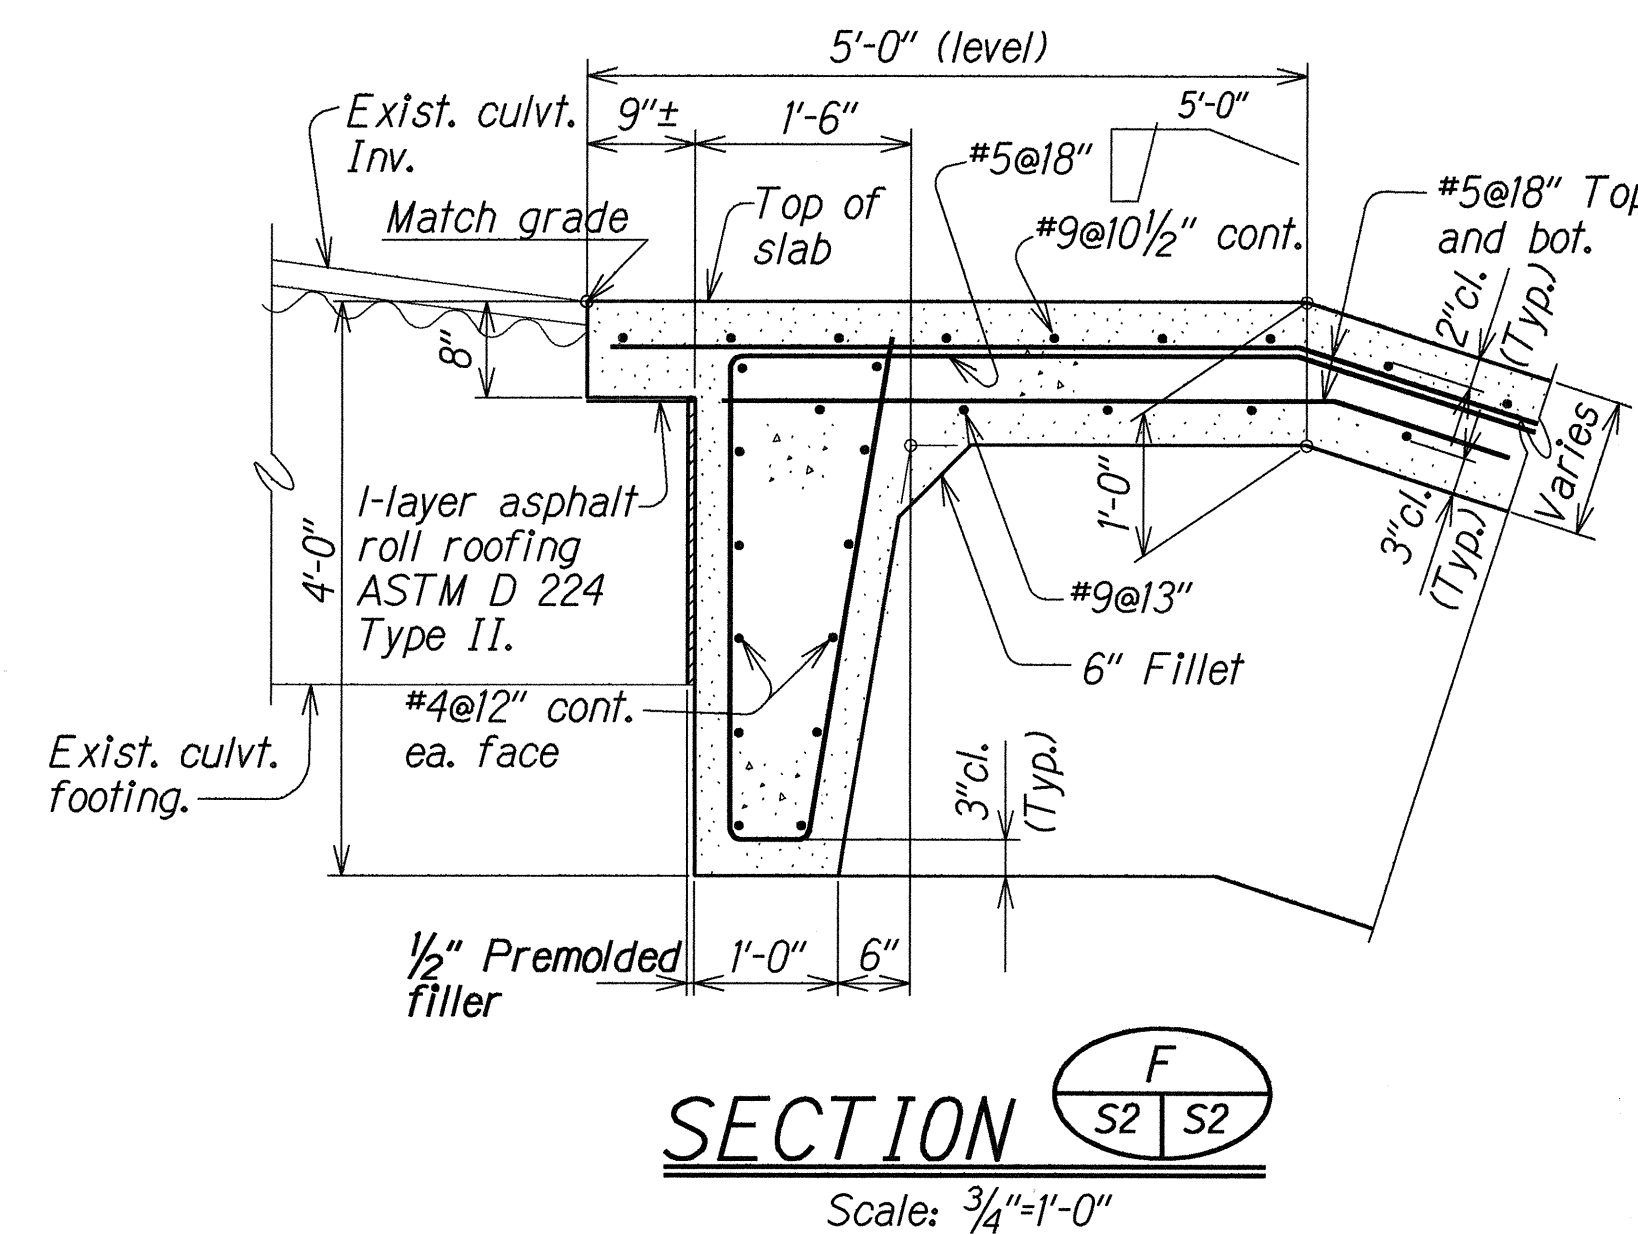
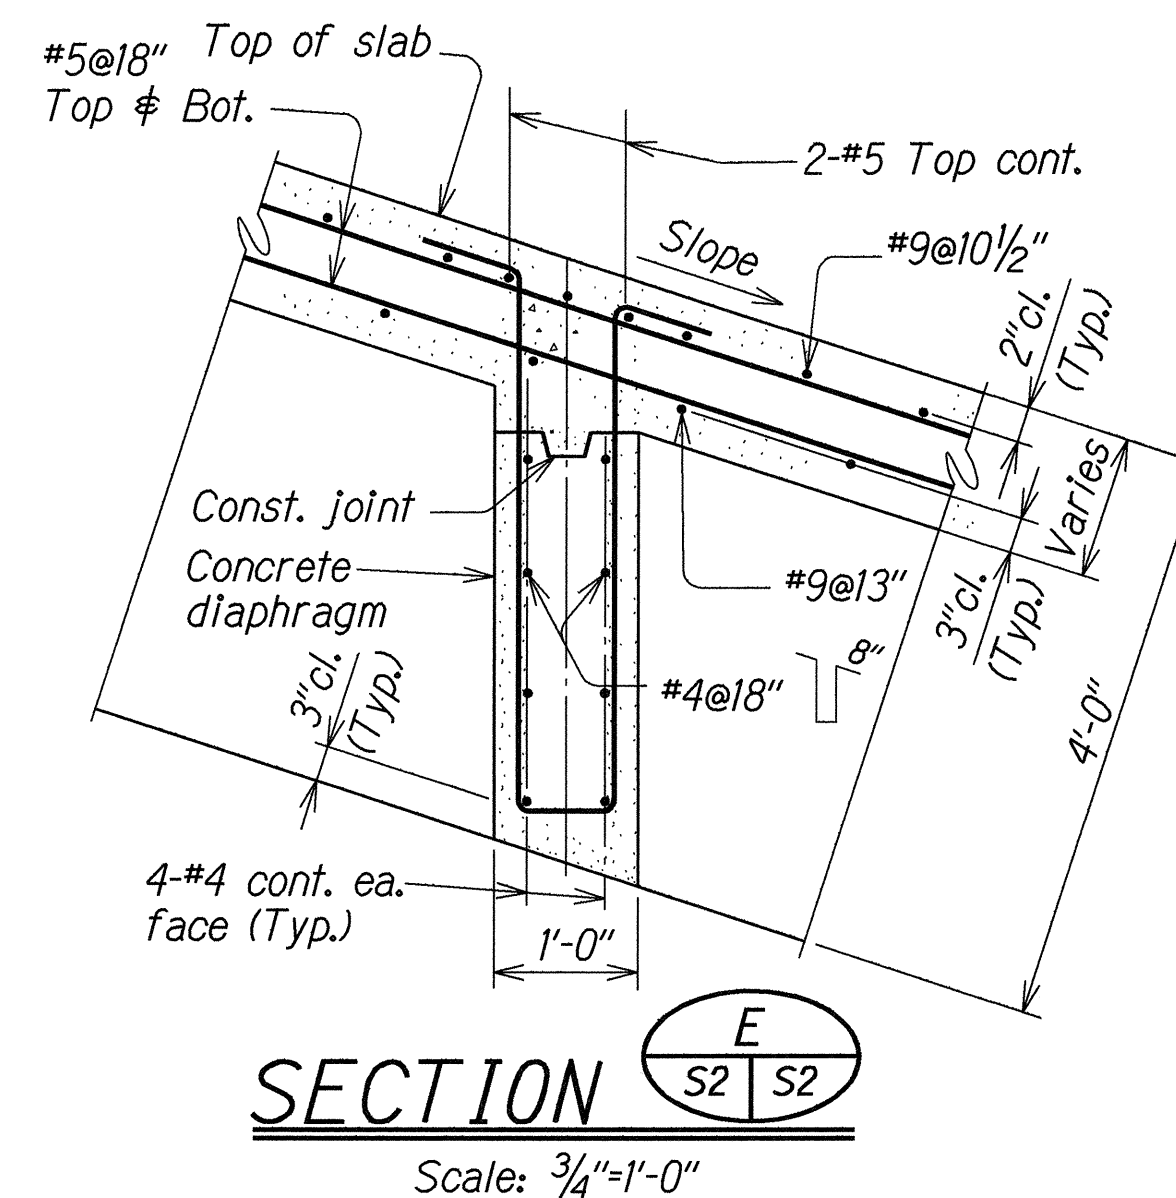
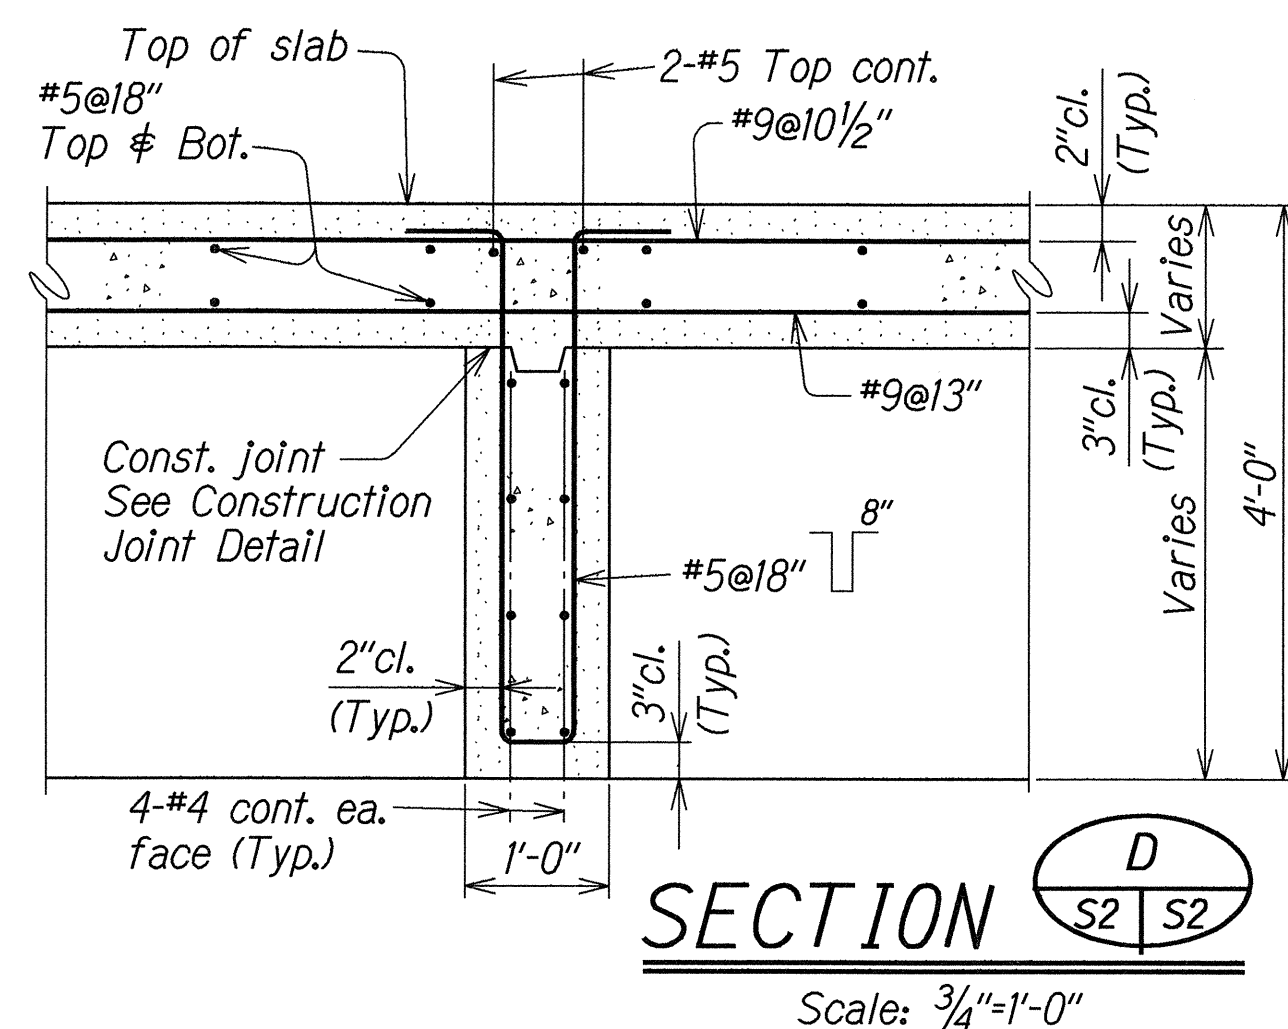
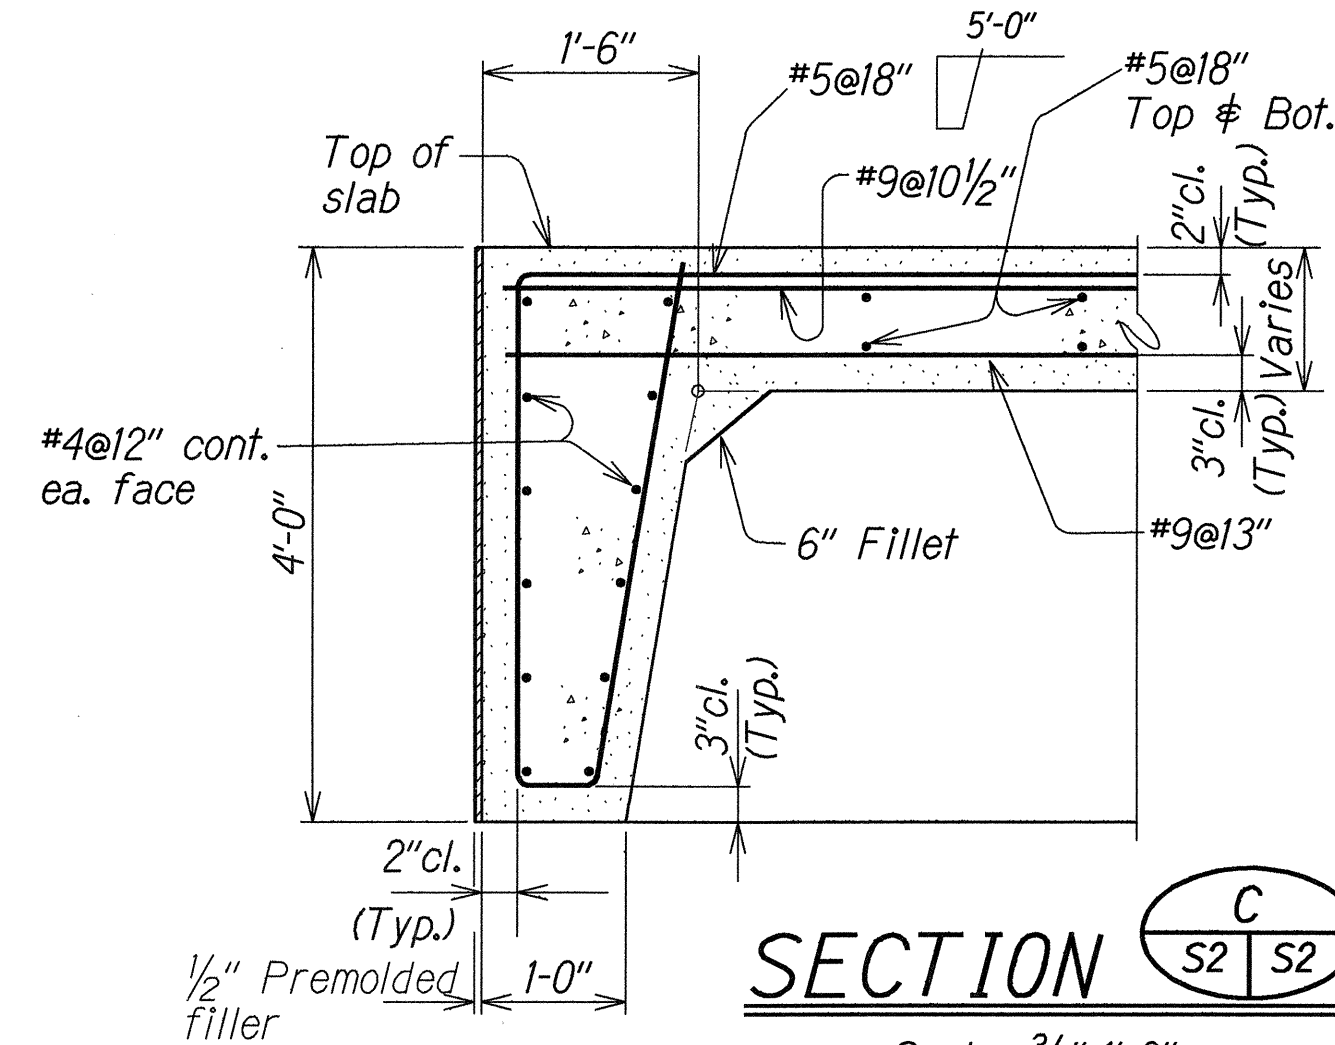
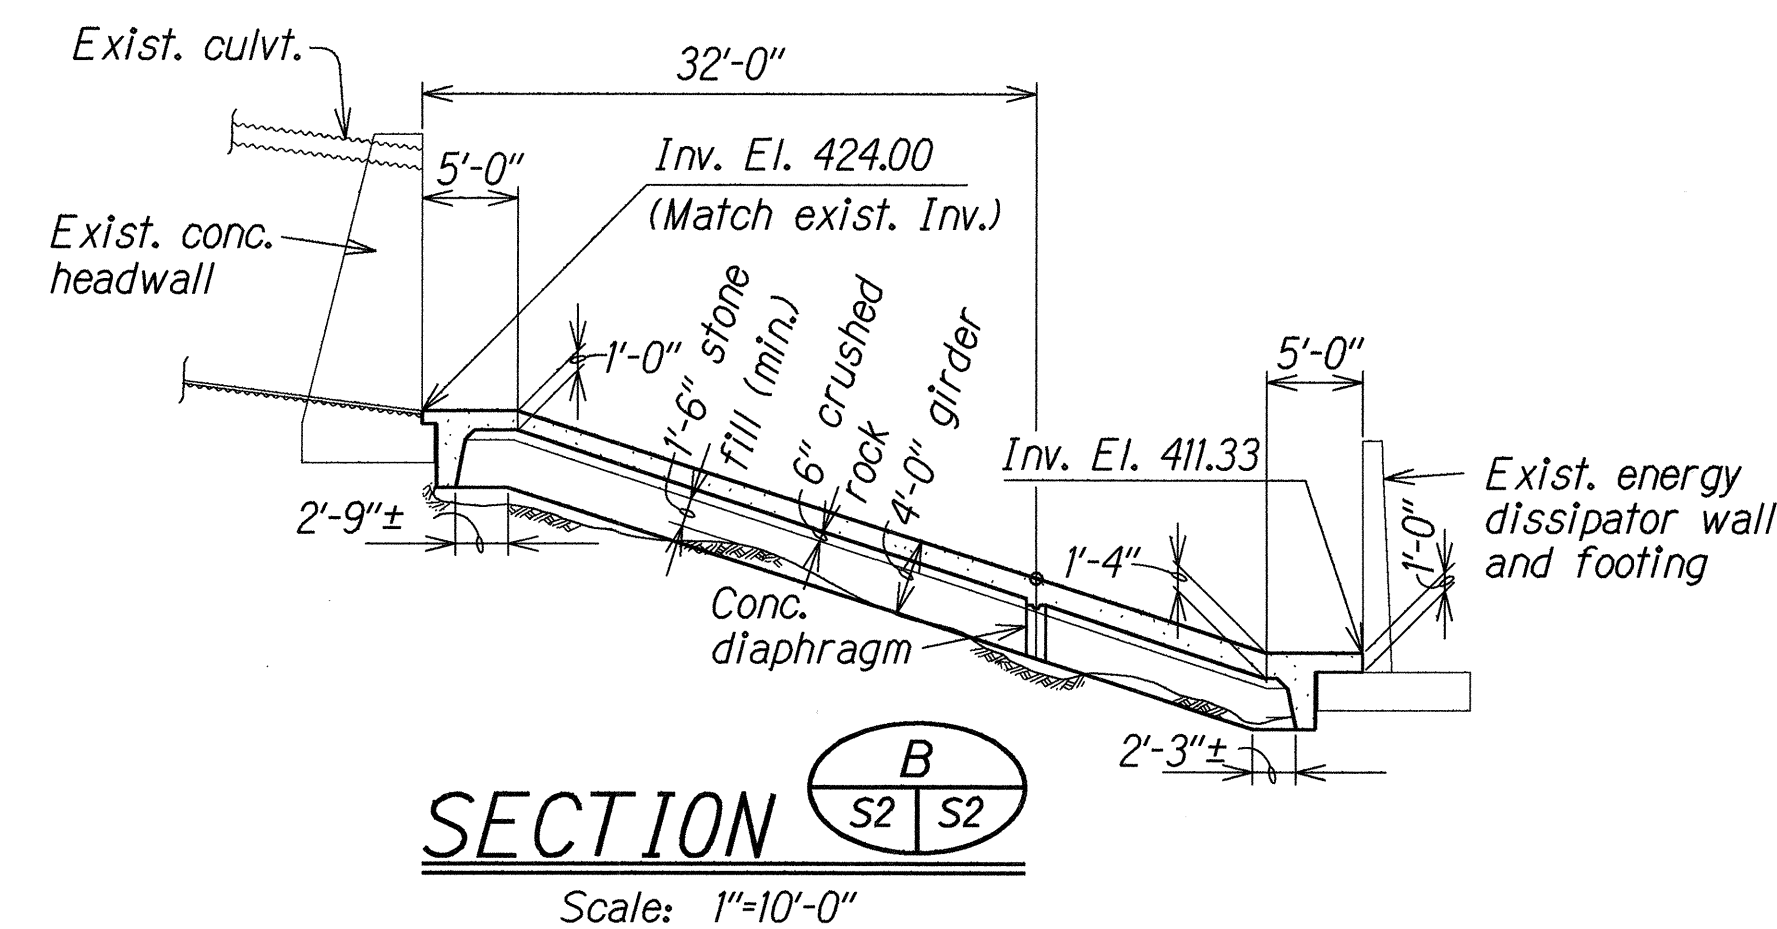
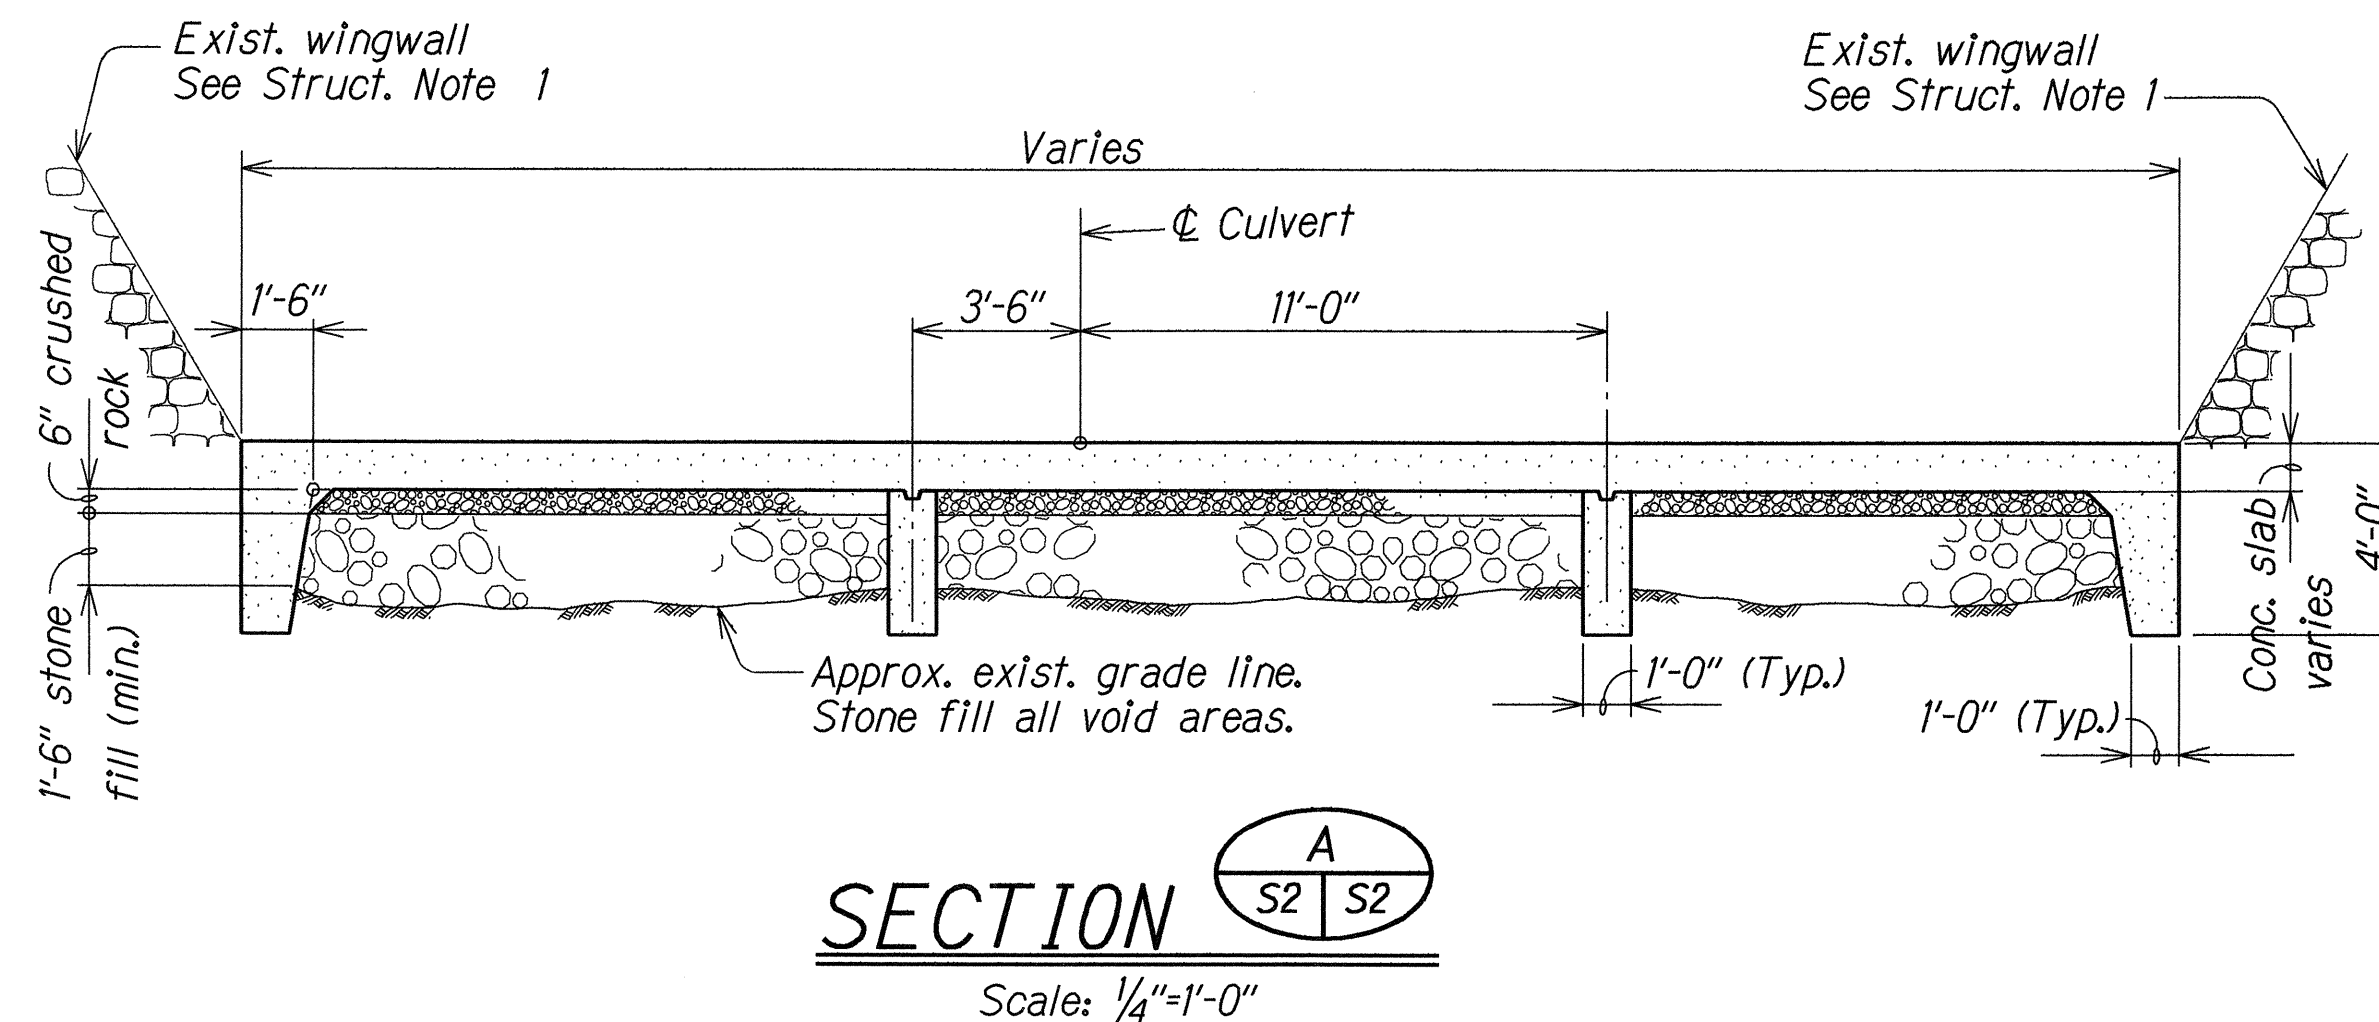


FED. ROAD DIST. NO.	STATE	PROJ. NO.	FISCAL YEAR	SHEET NO.	TOTAL SHEETS
HAWAII	HAW.	360A-02-94M	1994	4	4

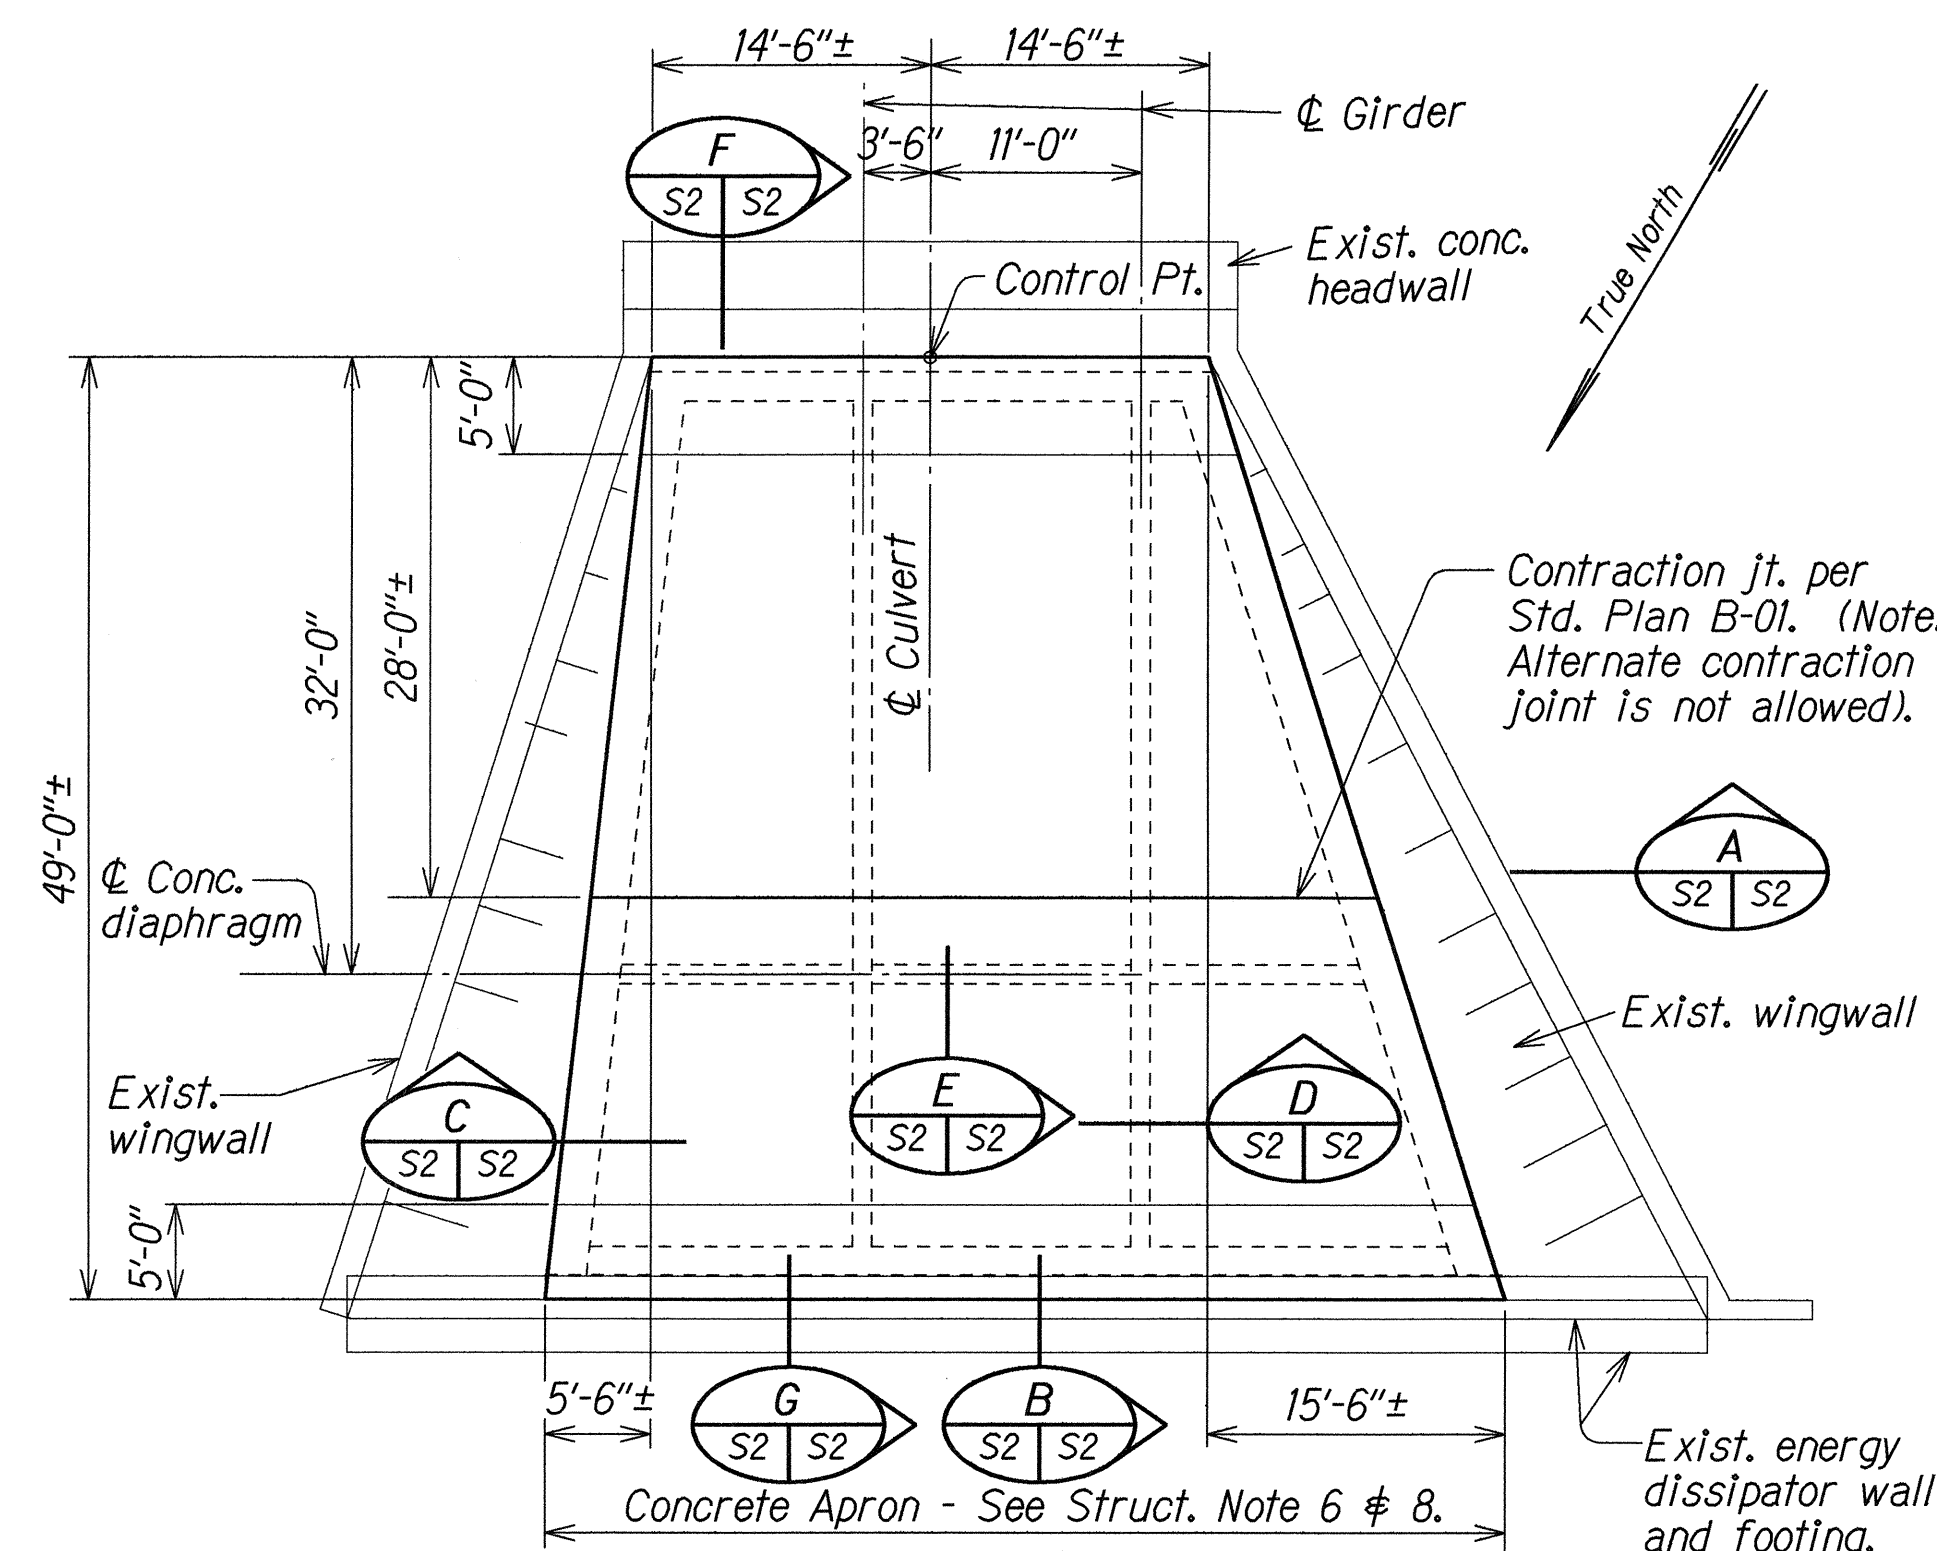

STATE OF HAWAII
DEPARTMENT OF TRANSPORTATION
HIGHWAYS DIVISION

**REPLACEMENT OF WASHED OUT EXISTING
CONCRETE APRON (OUTLET) AT KAKIPI BRIDGE**

CONCRETE APRON DETAILS

HANA HIGHWAY - KAKIPI TWIN CULVERT REPAIR
Project No. 360A-02-94M

Scale: As Noted Date: Nov. 1993

SHEET No. S2 OF 2 SHEETS