

## STATE OF HAWAII


## DEPARTMENT OF TRANSPORTATION


HIGHWAYS DIVISION HONOLULU, HAWAII "AS-BUILT" PLANS FOR


## HANA HIGHWAY RESURFACING


HUELO TO VICINITY OF HONOMANU BRIDGE PROJECT NO. 360A-01-94M

> DISTRICTS OF MAKAWAO AND HANA ISLAND OF MAUI

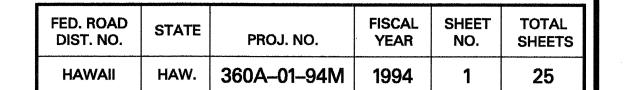

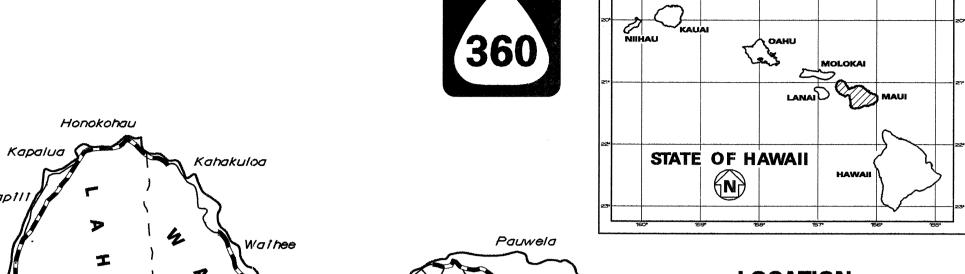

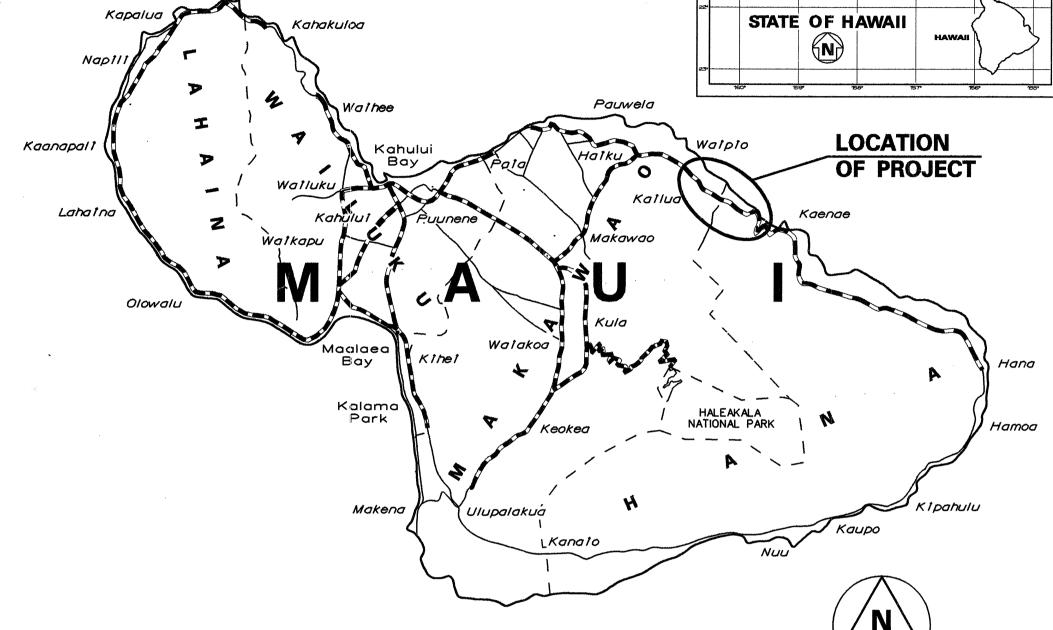

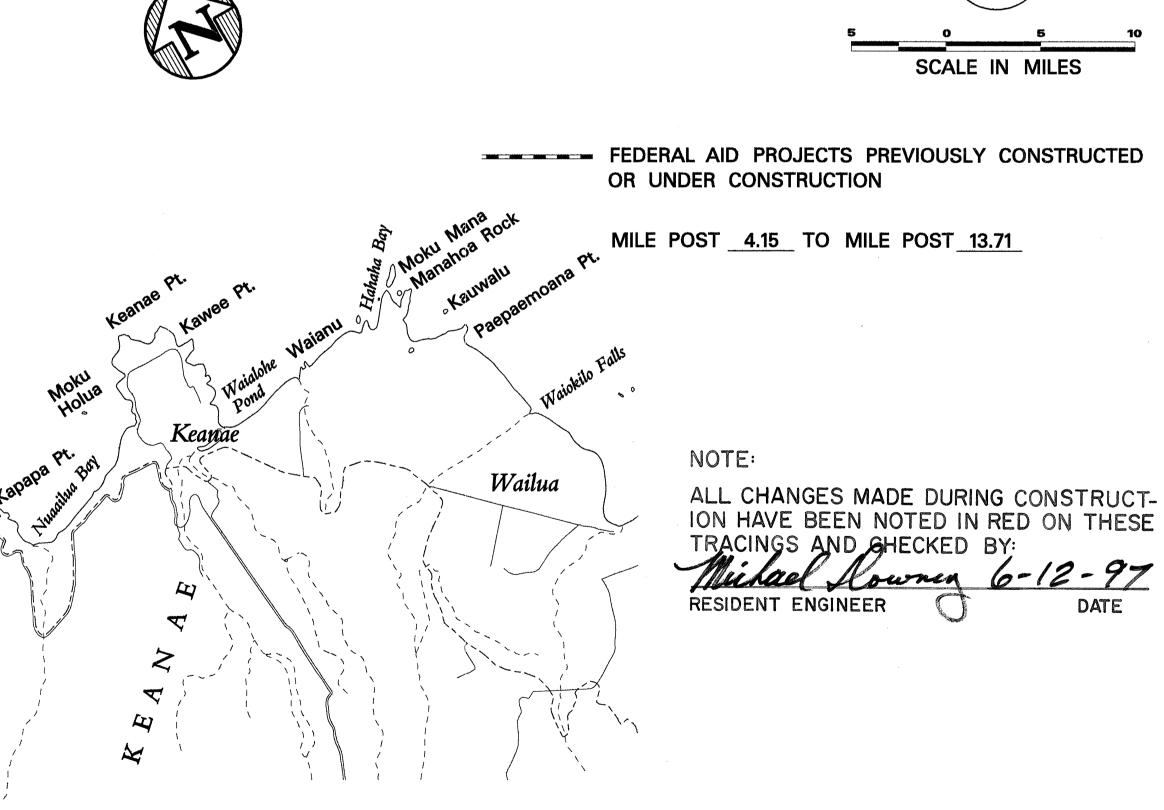

DEPARTMENT OF TRANSPORTATION STATE OF HAWAII

thereno 5/20/94 OP\_DIR. OF TRANSPORTATION

A-1-6

