



FED. ROAD DIST. NO.	STATE	PROJ. NO.	FISCAL YEAR	SHEET NO.	TOTAL SHEETS
HAWAII	HAW.	360A-01-94M	1994	5	25

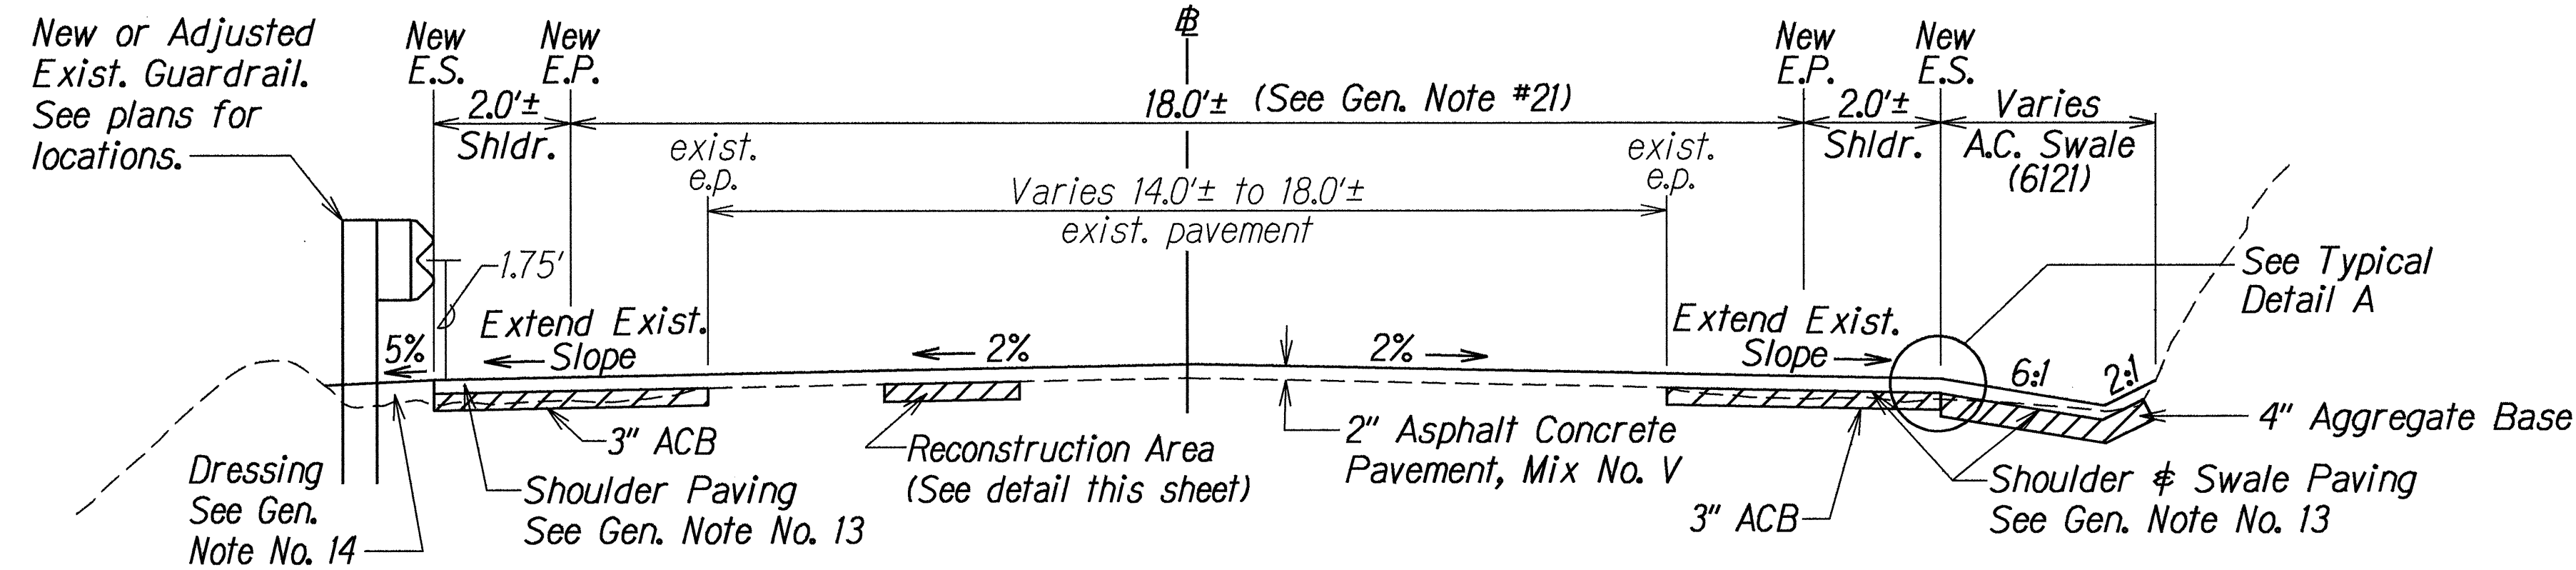


TYPICAL TANGENT SECTION

Scale: 1/2" = 1.0'

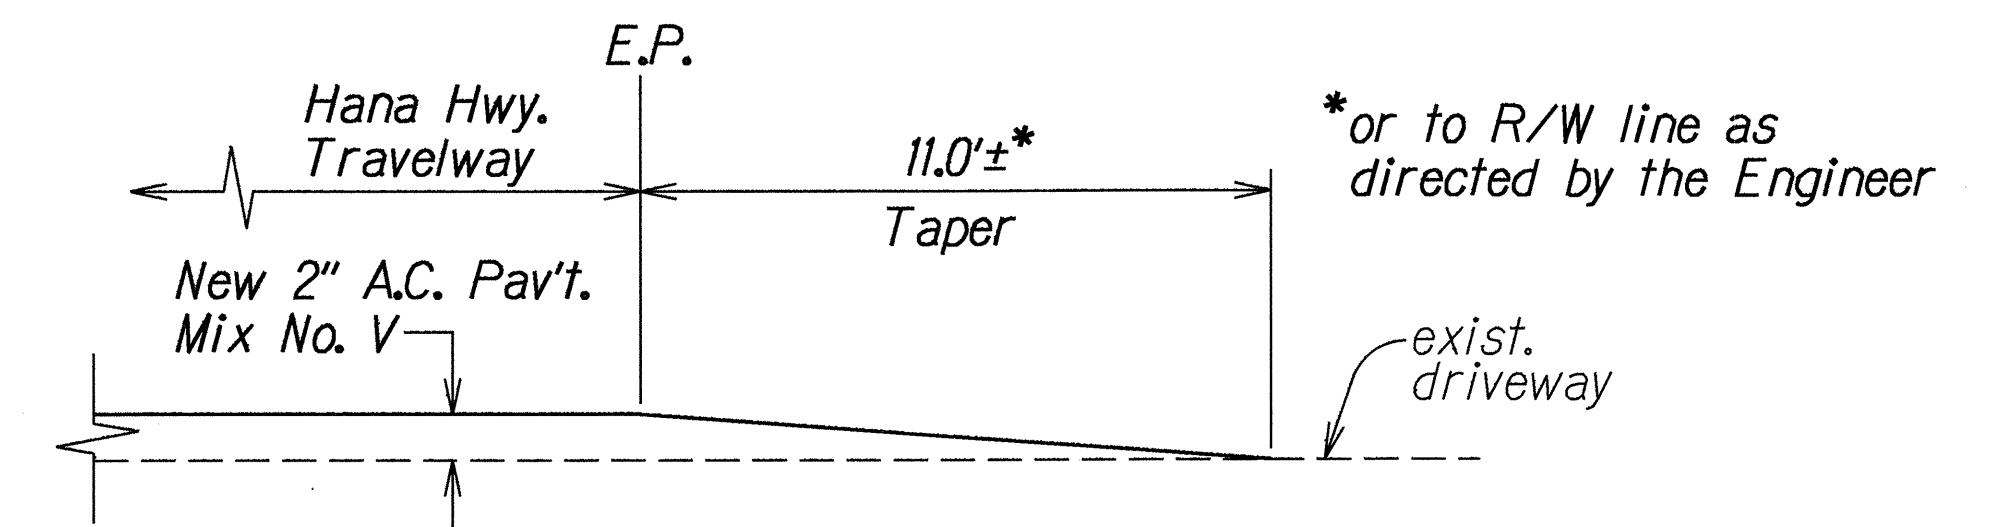


SIDE ROAD PAVING TRANSITION DETAIL

Not To Scale

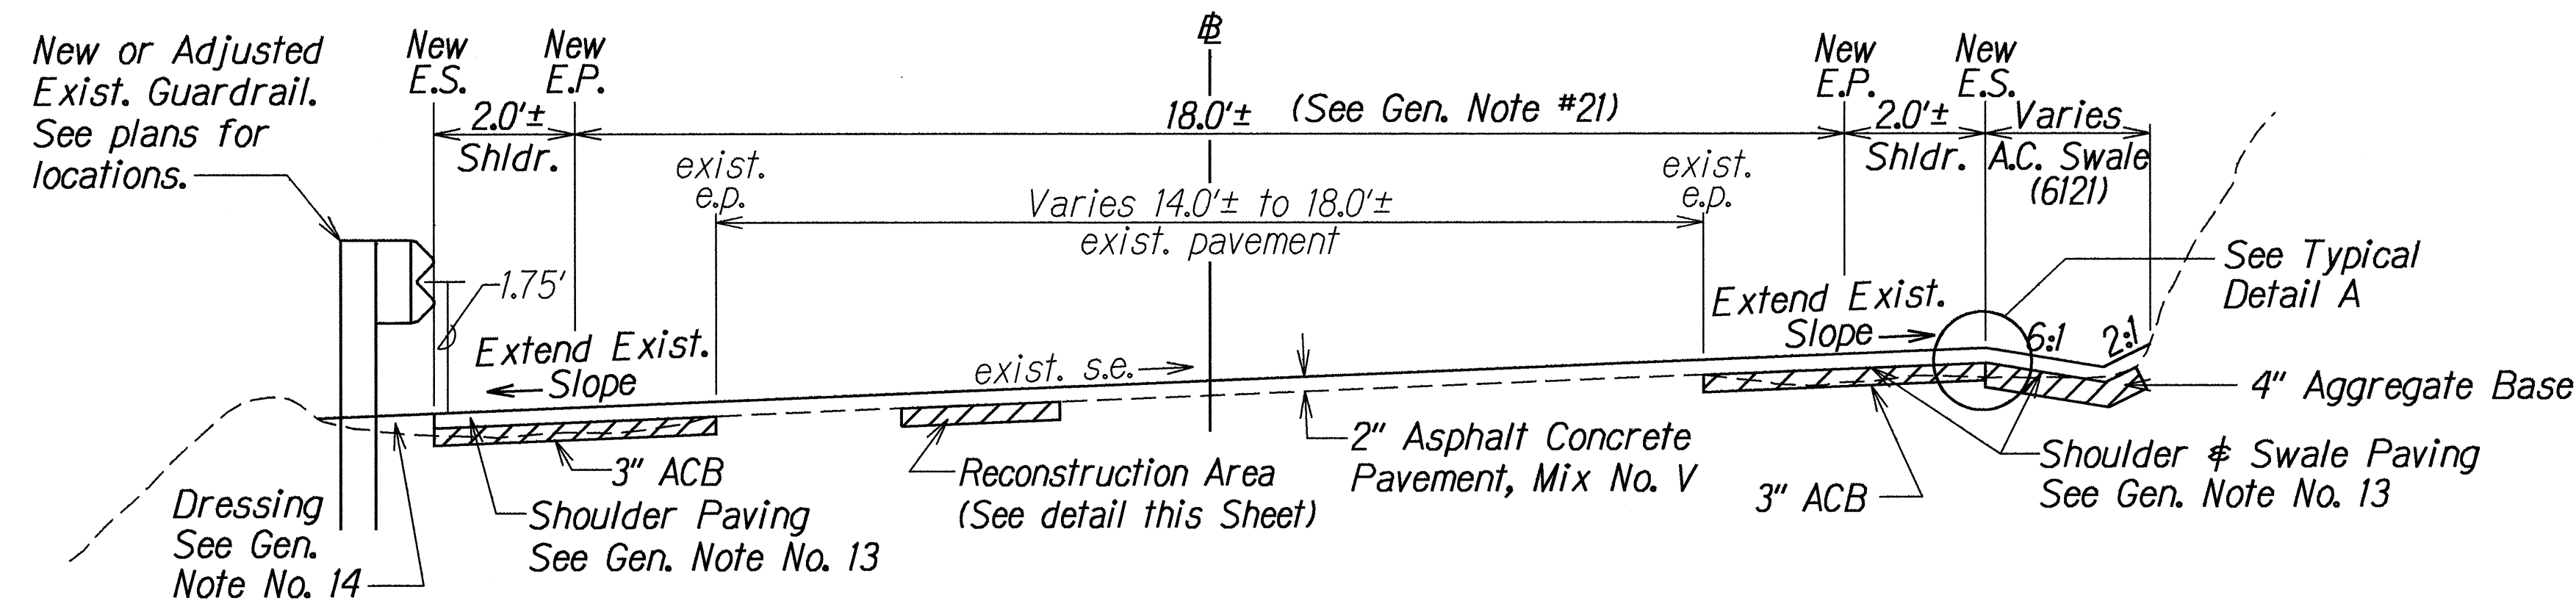


TYPICAL SUPERELEVATED SECTION

Scale: 1/2" = 1.0'

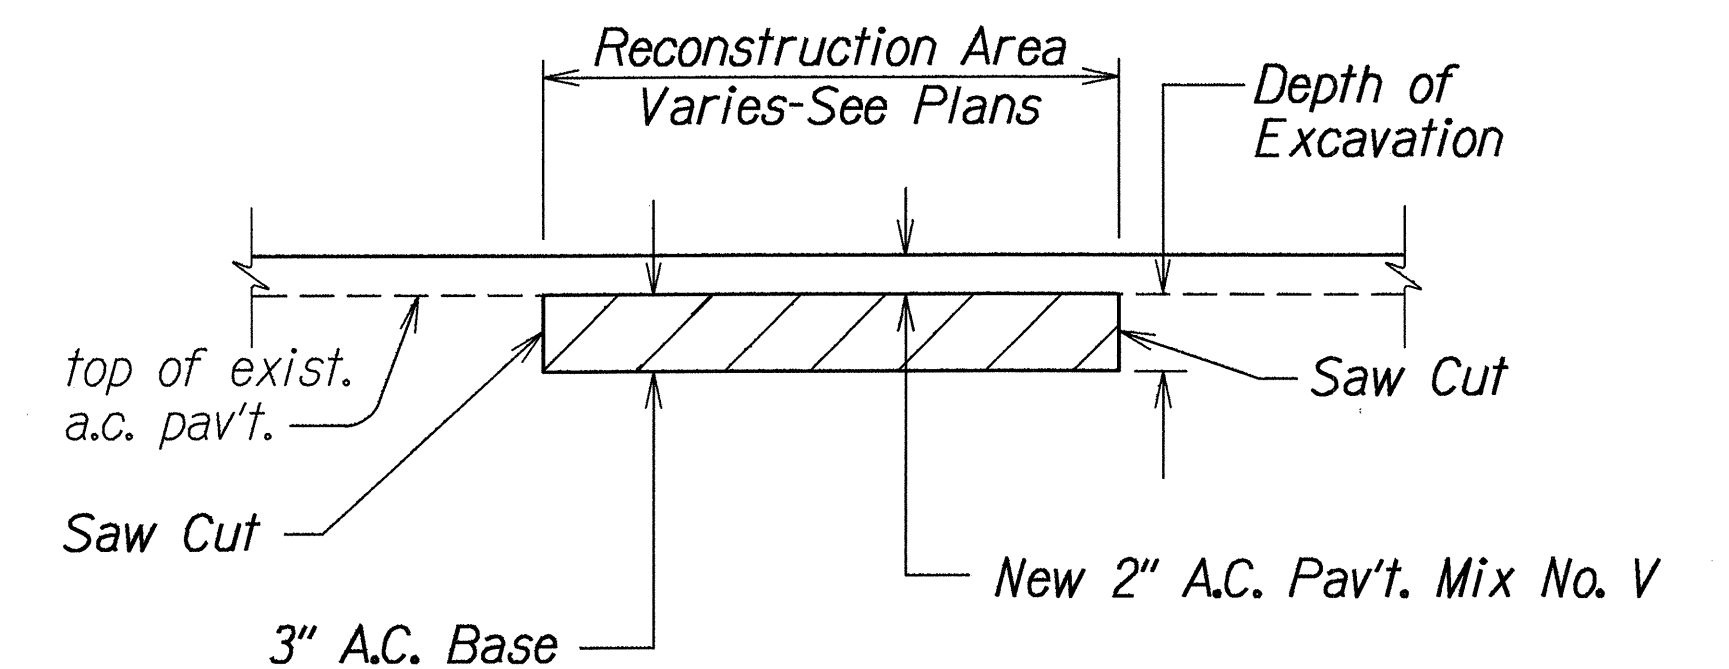

A.C. PAVEMENT RECONSTRUCTION DETAIL


Not To Scale

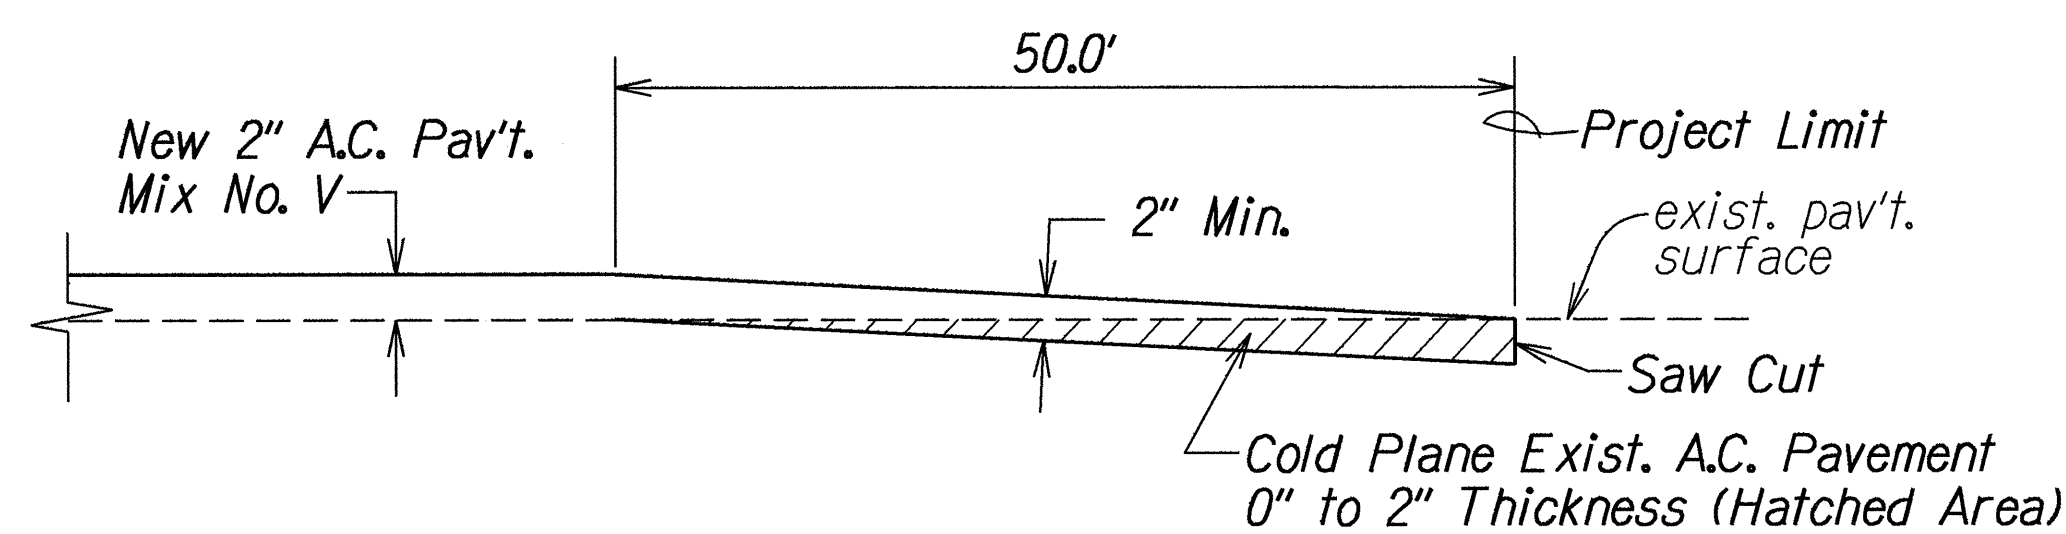

PAVEMENT TRANSITION DETAIL


BEGIN & END PROJECT

Not to Scale

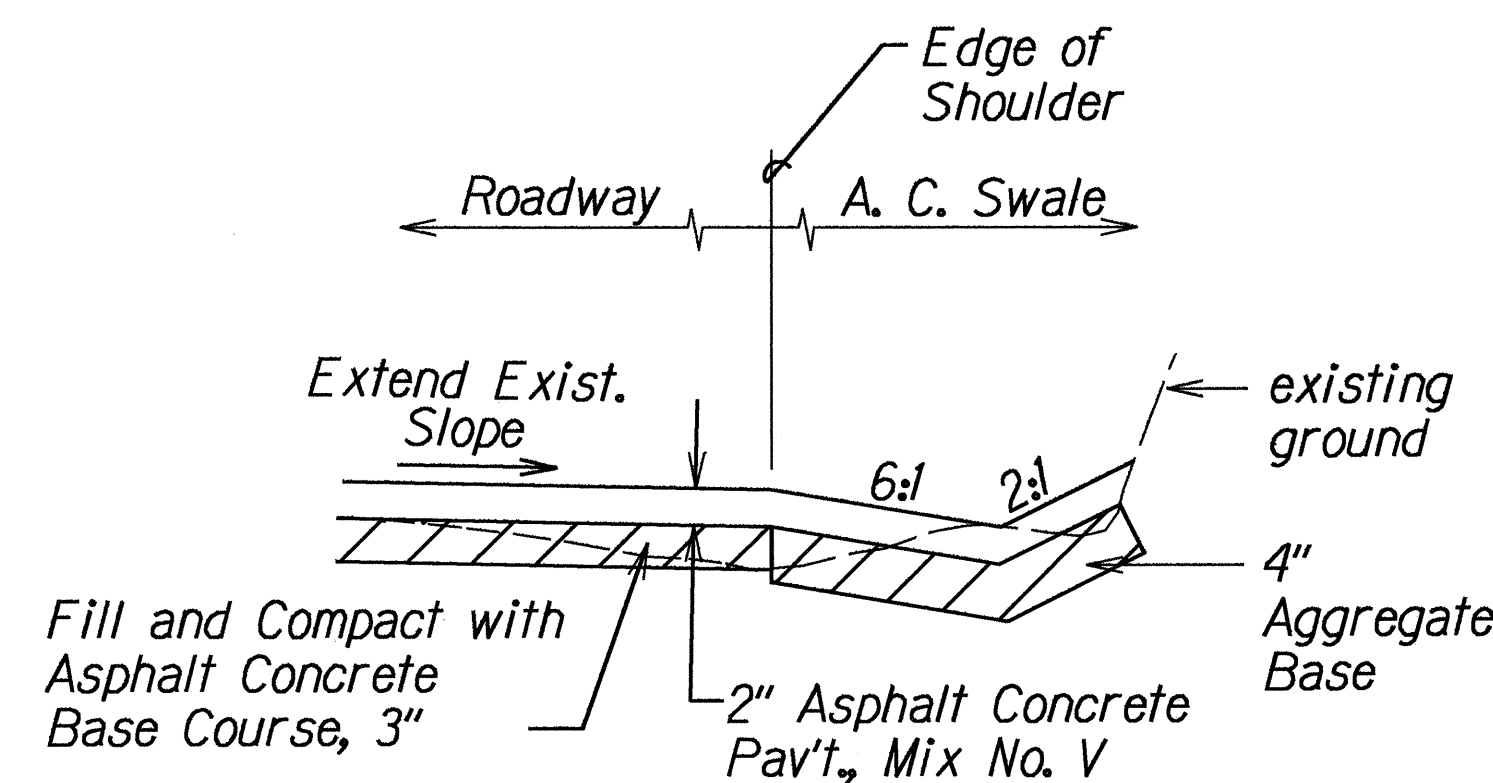


TYPICAL DETAIL A

Not To Scale

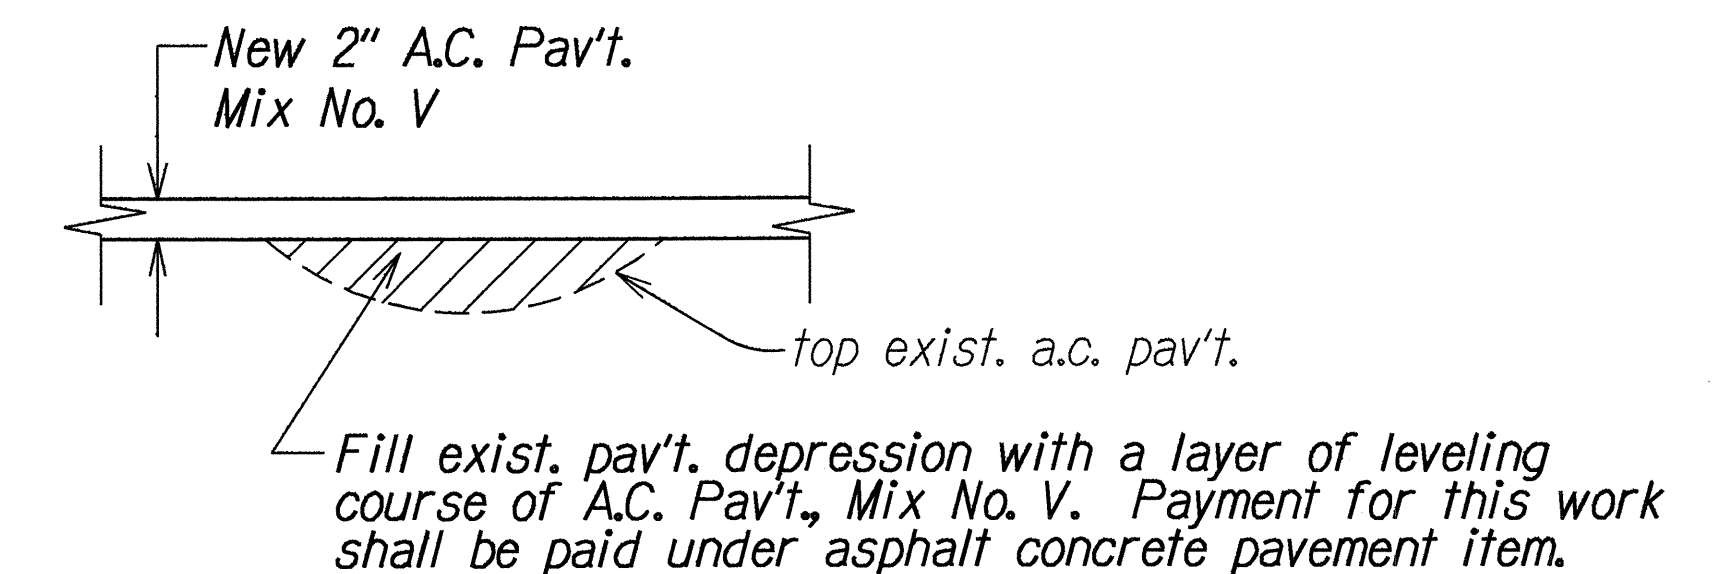

LEVELING COURSE DETAIL

Not To Scale

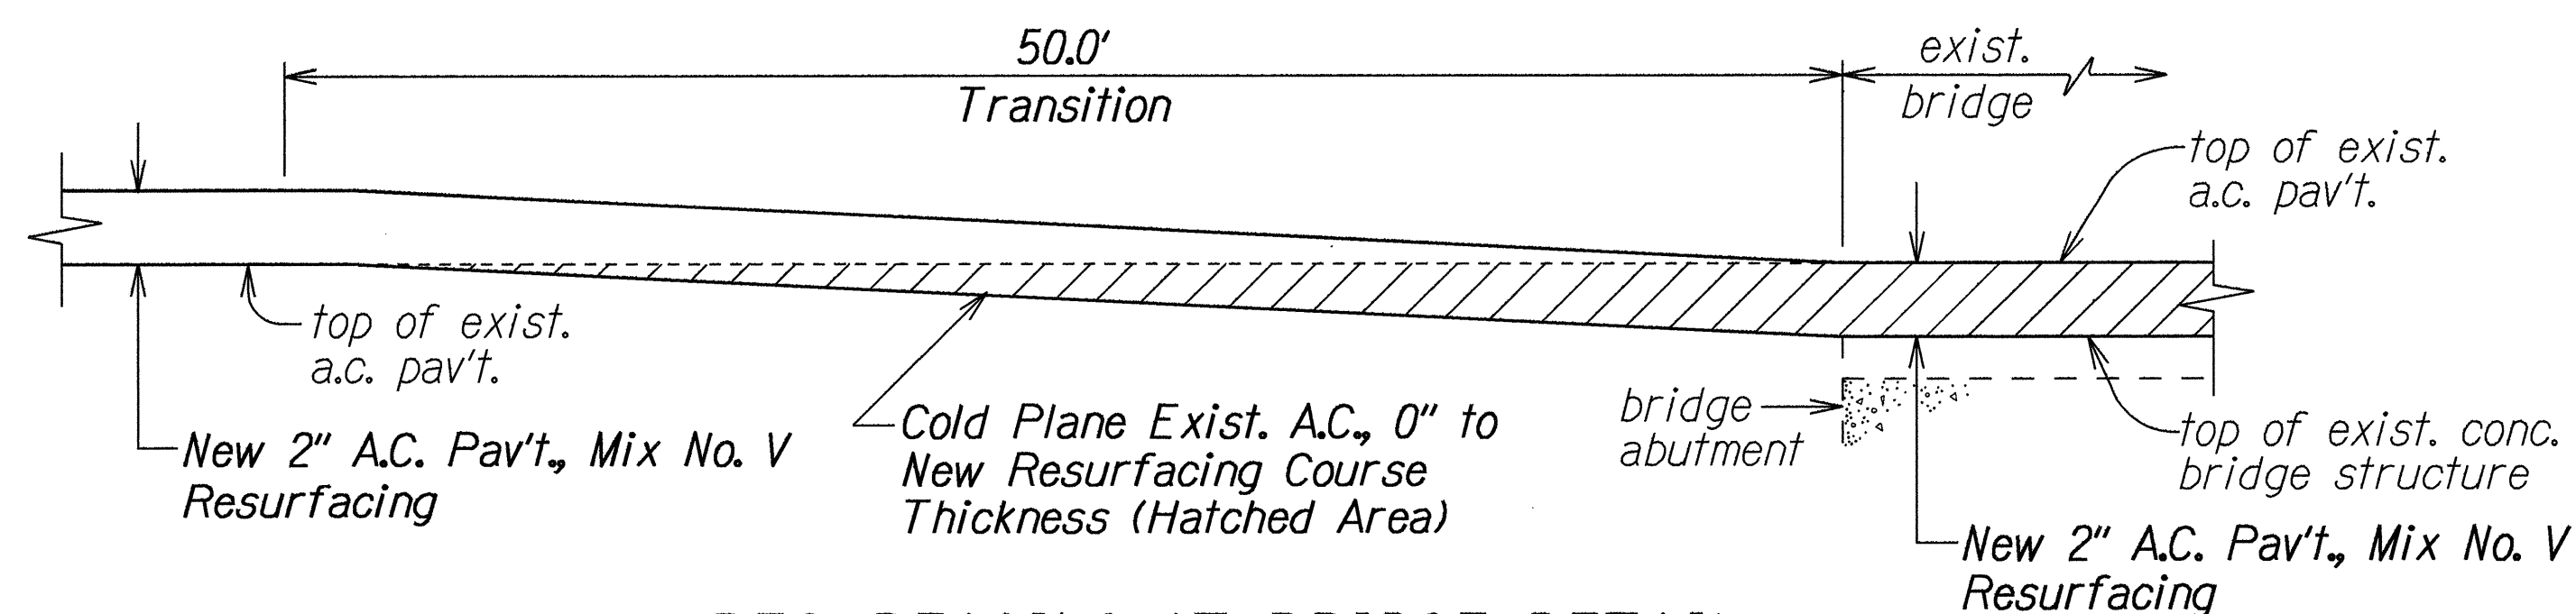

RESURFACING AT BRIDGE DETAIL

Not to Scale

6-14-94 Revised 3" A.C.B. on Typical Sections and 'Side Road Paving Transition Detail'

DATE REVISION

STATE OF HAWAII
DEPARTMENT OF TRANSPORTATION
HIGHWAYS DIVISION

**TYPICAL SECTIONS
AND DETAILS**
HANA HIGHWAY RESURFACING
Huelo to Vicinity of Honomanu Bridge
Project No. 360A-01-94M
Scale: As Shown Date: May, 1994
SHEET No. 1 OF 2 SHEETS