| | INDEX TO DRAWINGS |
|-----------|------------------------|
| SHEET NO. | DESCRIPTION |
| 1 | TITLE SHEET |
| 2 | STANDARD PLANS SUMMARY |
| 3 | GENERAL NOTES & LEGEND |
| 4 | ROADWAY PLAN |
| 5 | DRAINAGE PLAN |
| 6 – 9 | DRAINAGE DETAILS |
| | |
| | |
STATE OF HAWAII


DEPARTMENT OF TRANSPORTATION


HIGHWAYS DIVISION
HONOLULU, HAWAII
'AS-BUILT'
PLANS FOR

HANA HIGHWAY

HANAWANA STREAM CULVERT REPLACEMENT PROJECT NO. 360A-02-95M

DISTRICT OF MAKAWAO
ISLAND OF MAUI

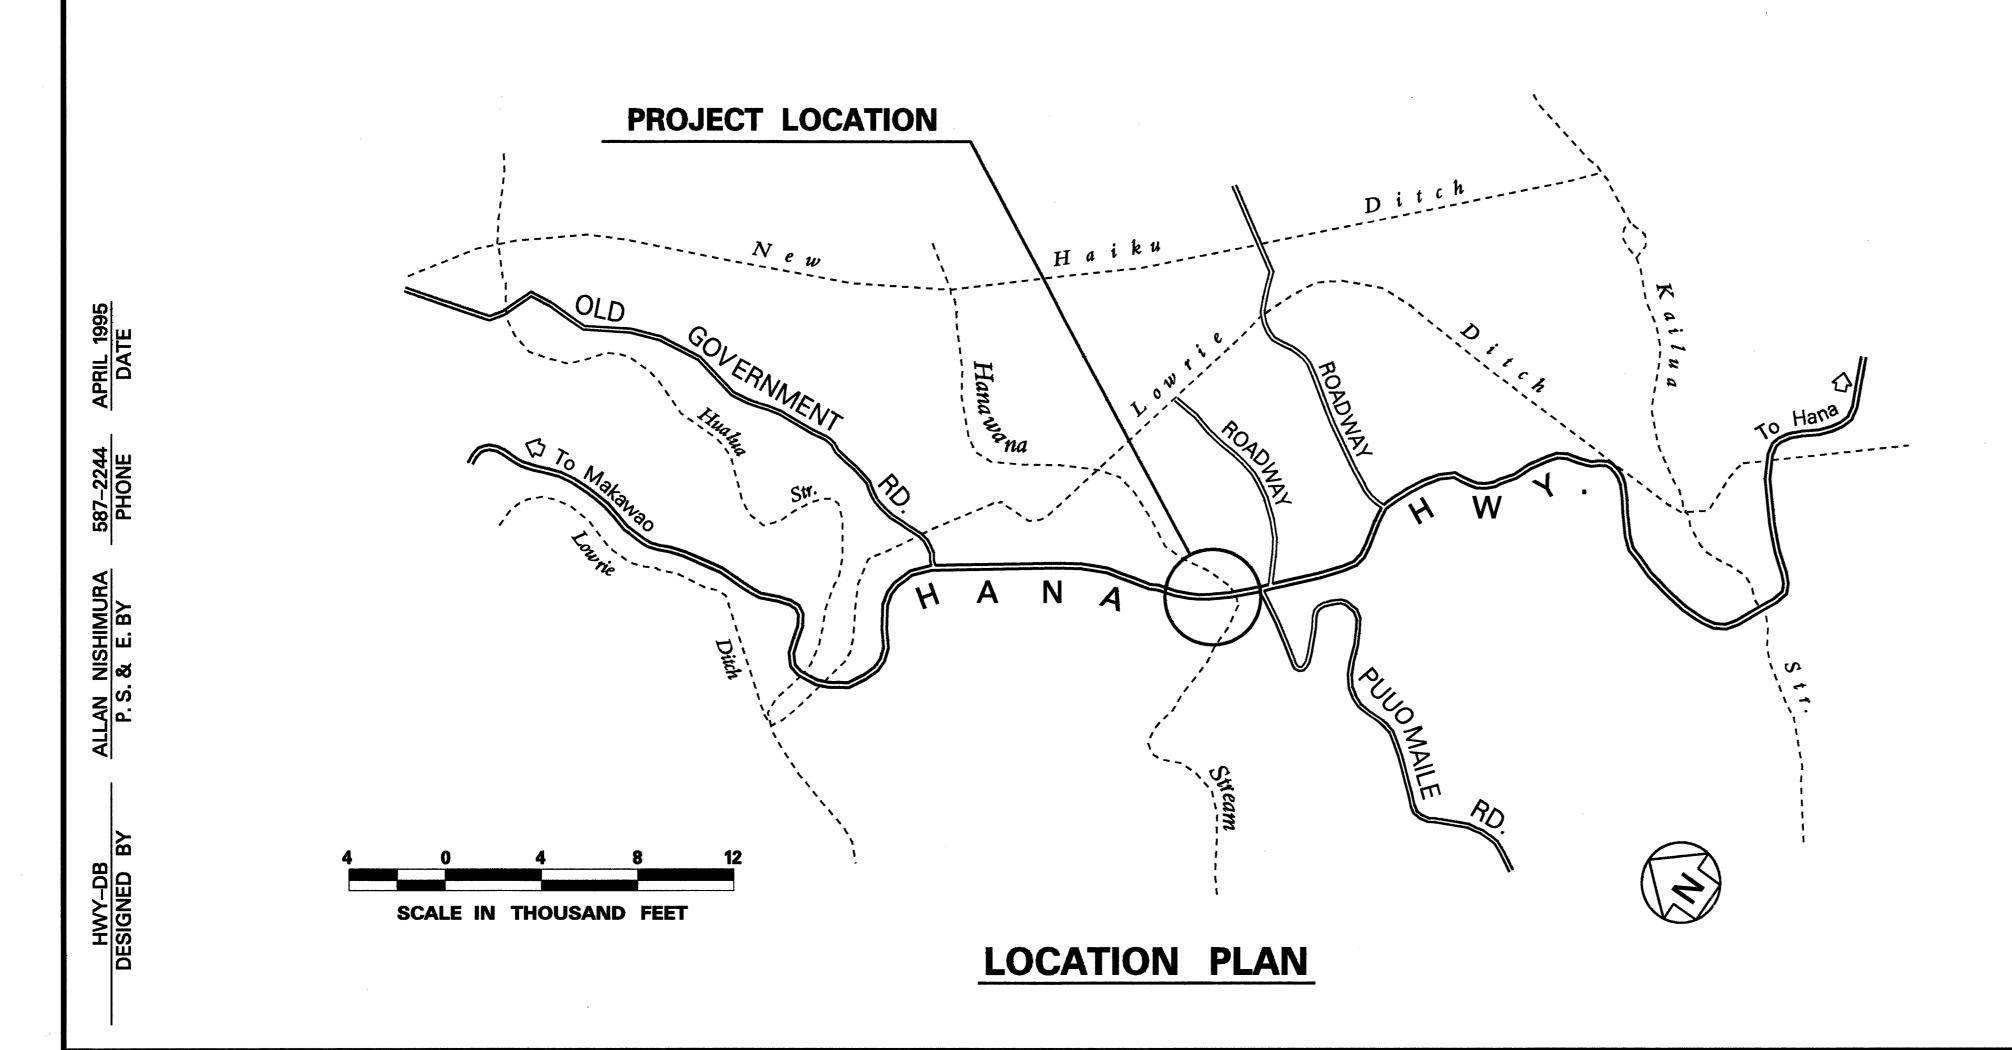

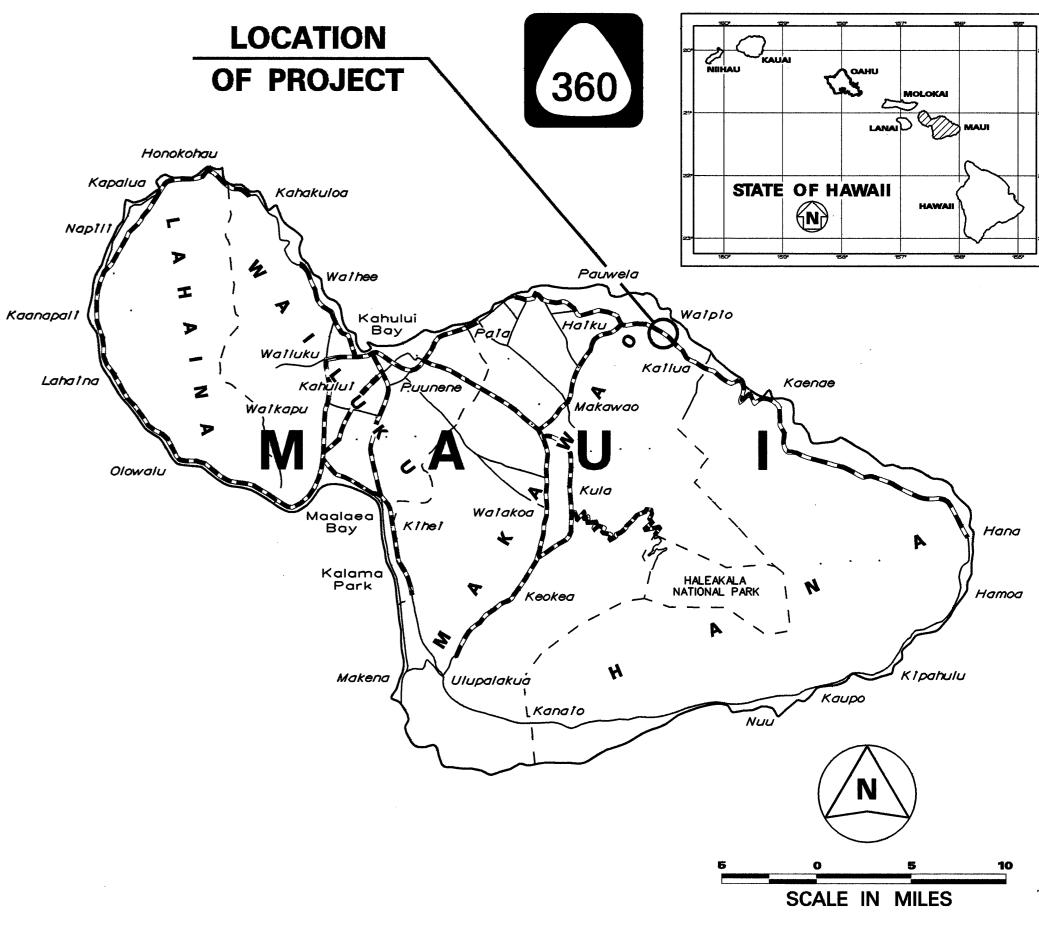

FED. ROAD DIST. NO.

HAW. 360A-02-95M

FISCAL SHEET YEAR NO.

1995

FEDERAL AID PROJECTS PREVIOUSLY CONSTRUCTED OR UNDER CONSTRUCTION

MILE POST 5.499 TO MILE POST 5.506

NOTE:

ALL CHANGES MADE DURING CONSTRUCTION HAVE BEEN NOTED IN RED ON THESE TRACINGS AND CHECKED BY:

RESIDENT ENGINEER

11-5-98 DATE

DEPARTMENT OF TRANSPORTATION
STATE OF HAWAII

APPROVED:

My Gapanila 5/23/45

DIR. OF TRANSPORTATION DATE