


FED. ROAD DIST. NO.	STATE	PROJ. NO.	FISCAL YEAR	SHEET NO.	TOTAL SHEETS
HAWAII	HAW.	360B-01-95M	1995	6	43

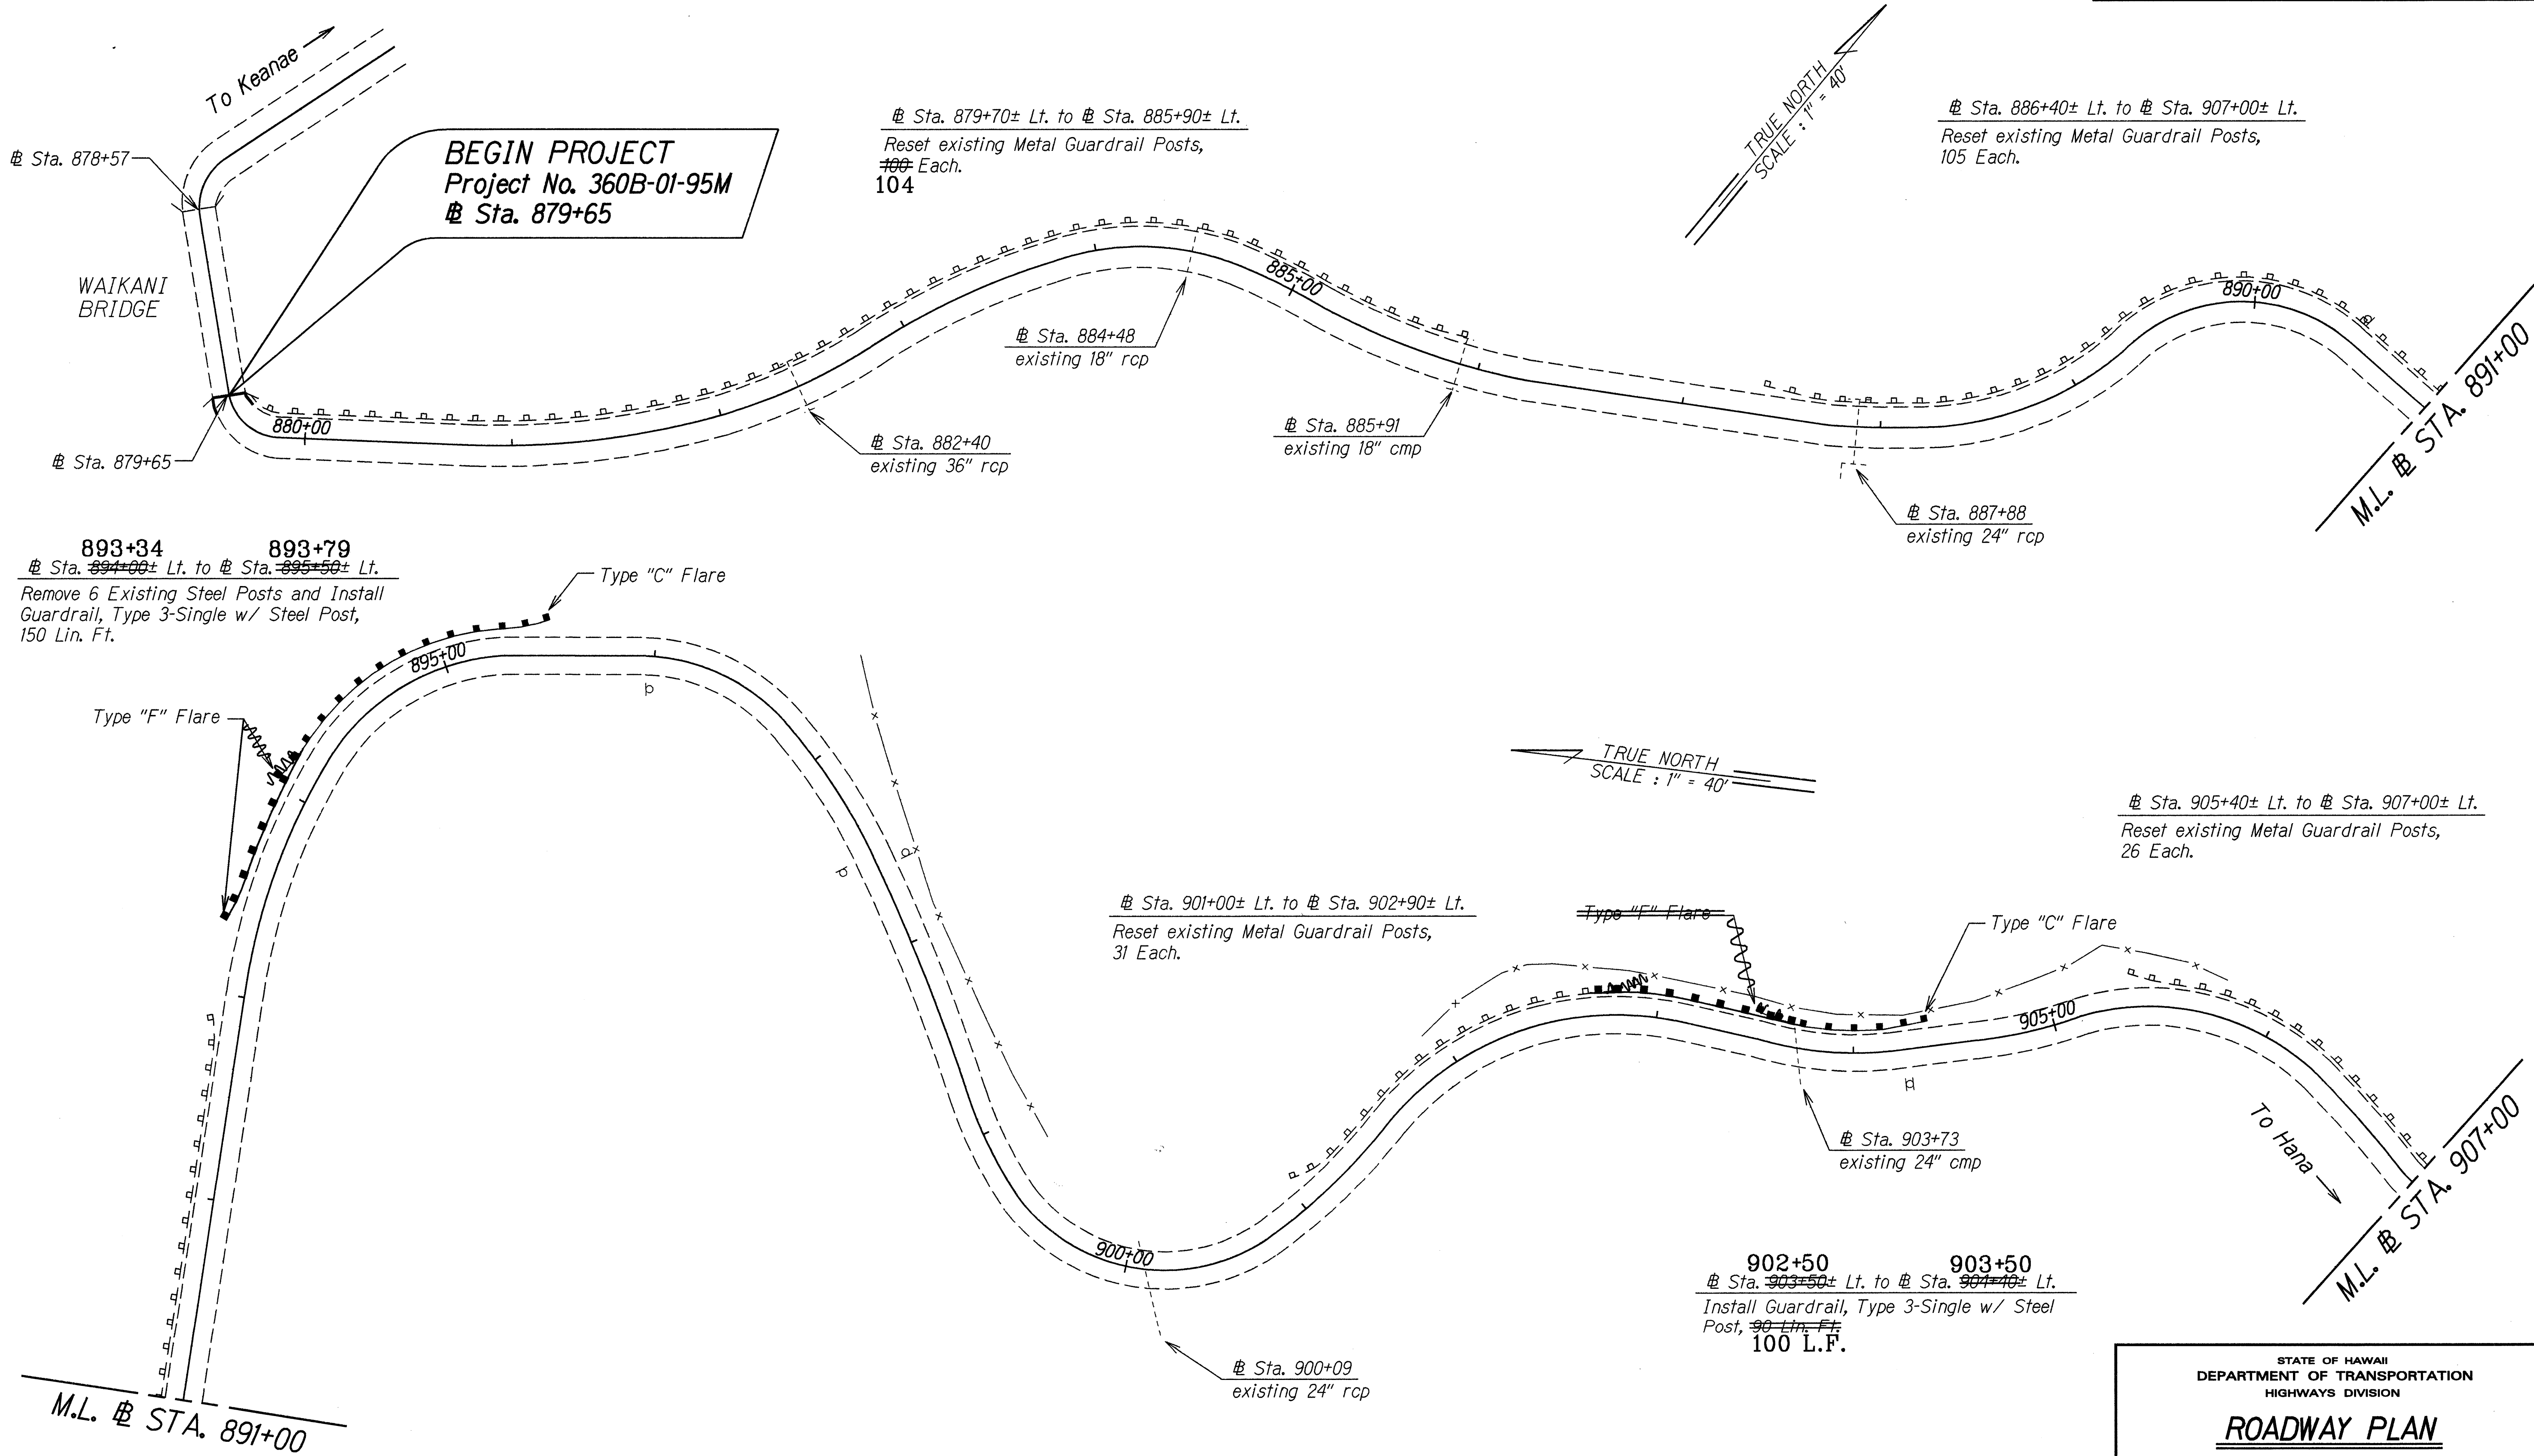

SURVEY PLOTTED BY	DATE
DRAWN BY	14-25-95
TRACED BY	
NOTED BY	
QUANTITIES BY	
CHECKED BY	

ORIGINAL PLAN	
NOTE BOOK	
DATE	
BY	

LEGEND FOR AS-BUILT POSTINGS	
	Squiggly line for as-built deletion
	Double line for as-built deletion
Roadway	Text for as-built posting

STATE OF HAWAII
DEPARTMENT OF TRANSPORTATION
HIGHWAYS DIVISION


ROADWAY PLAN

HANA HIGHWAY RESURFACING
Waikani Bridge to Kapaula Bridge
Project No. 360B-01-95M

Scale: 1"=40' Date: Sept., 1994

SHEET No. 1 OF 8 SHEETS

FED. ROAD DIST. NO.	STATE	PROJ. NO.	FISCAL YEAR	SHEET NO.	TOTAL SHEETS
HAWAII	HAW.	360B-01-95M	1995	7	43

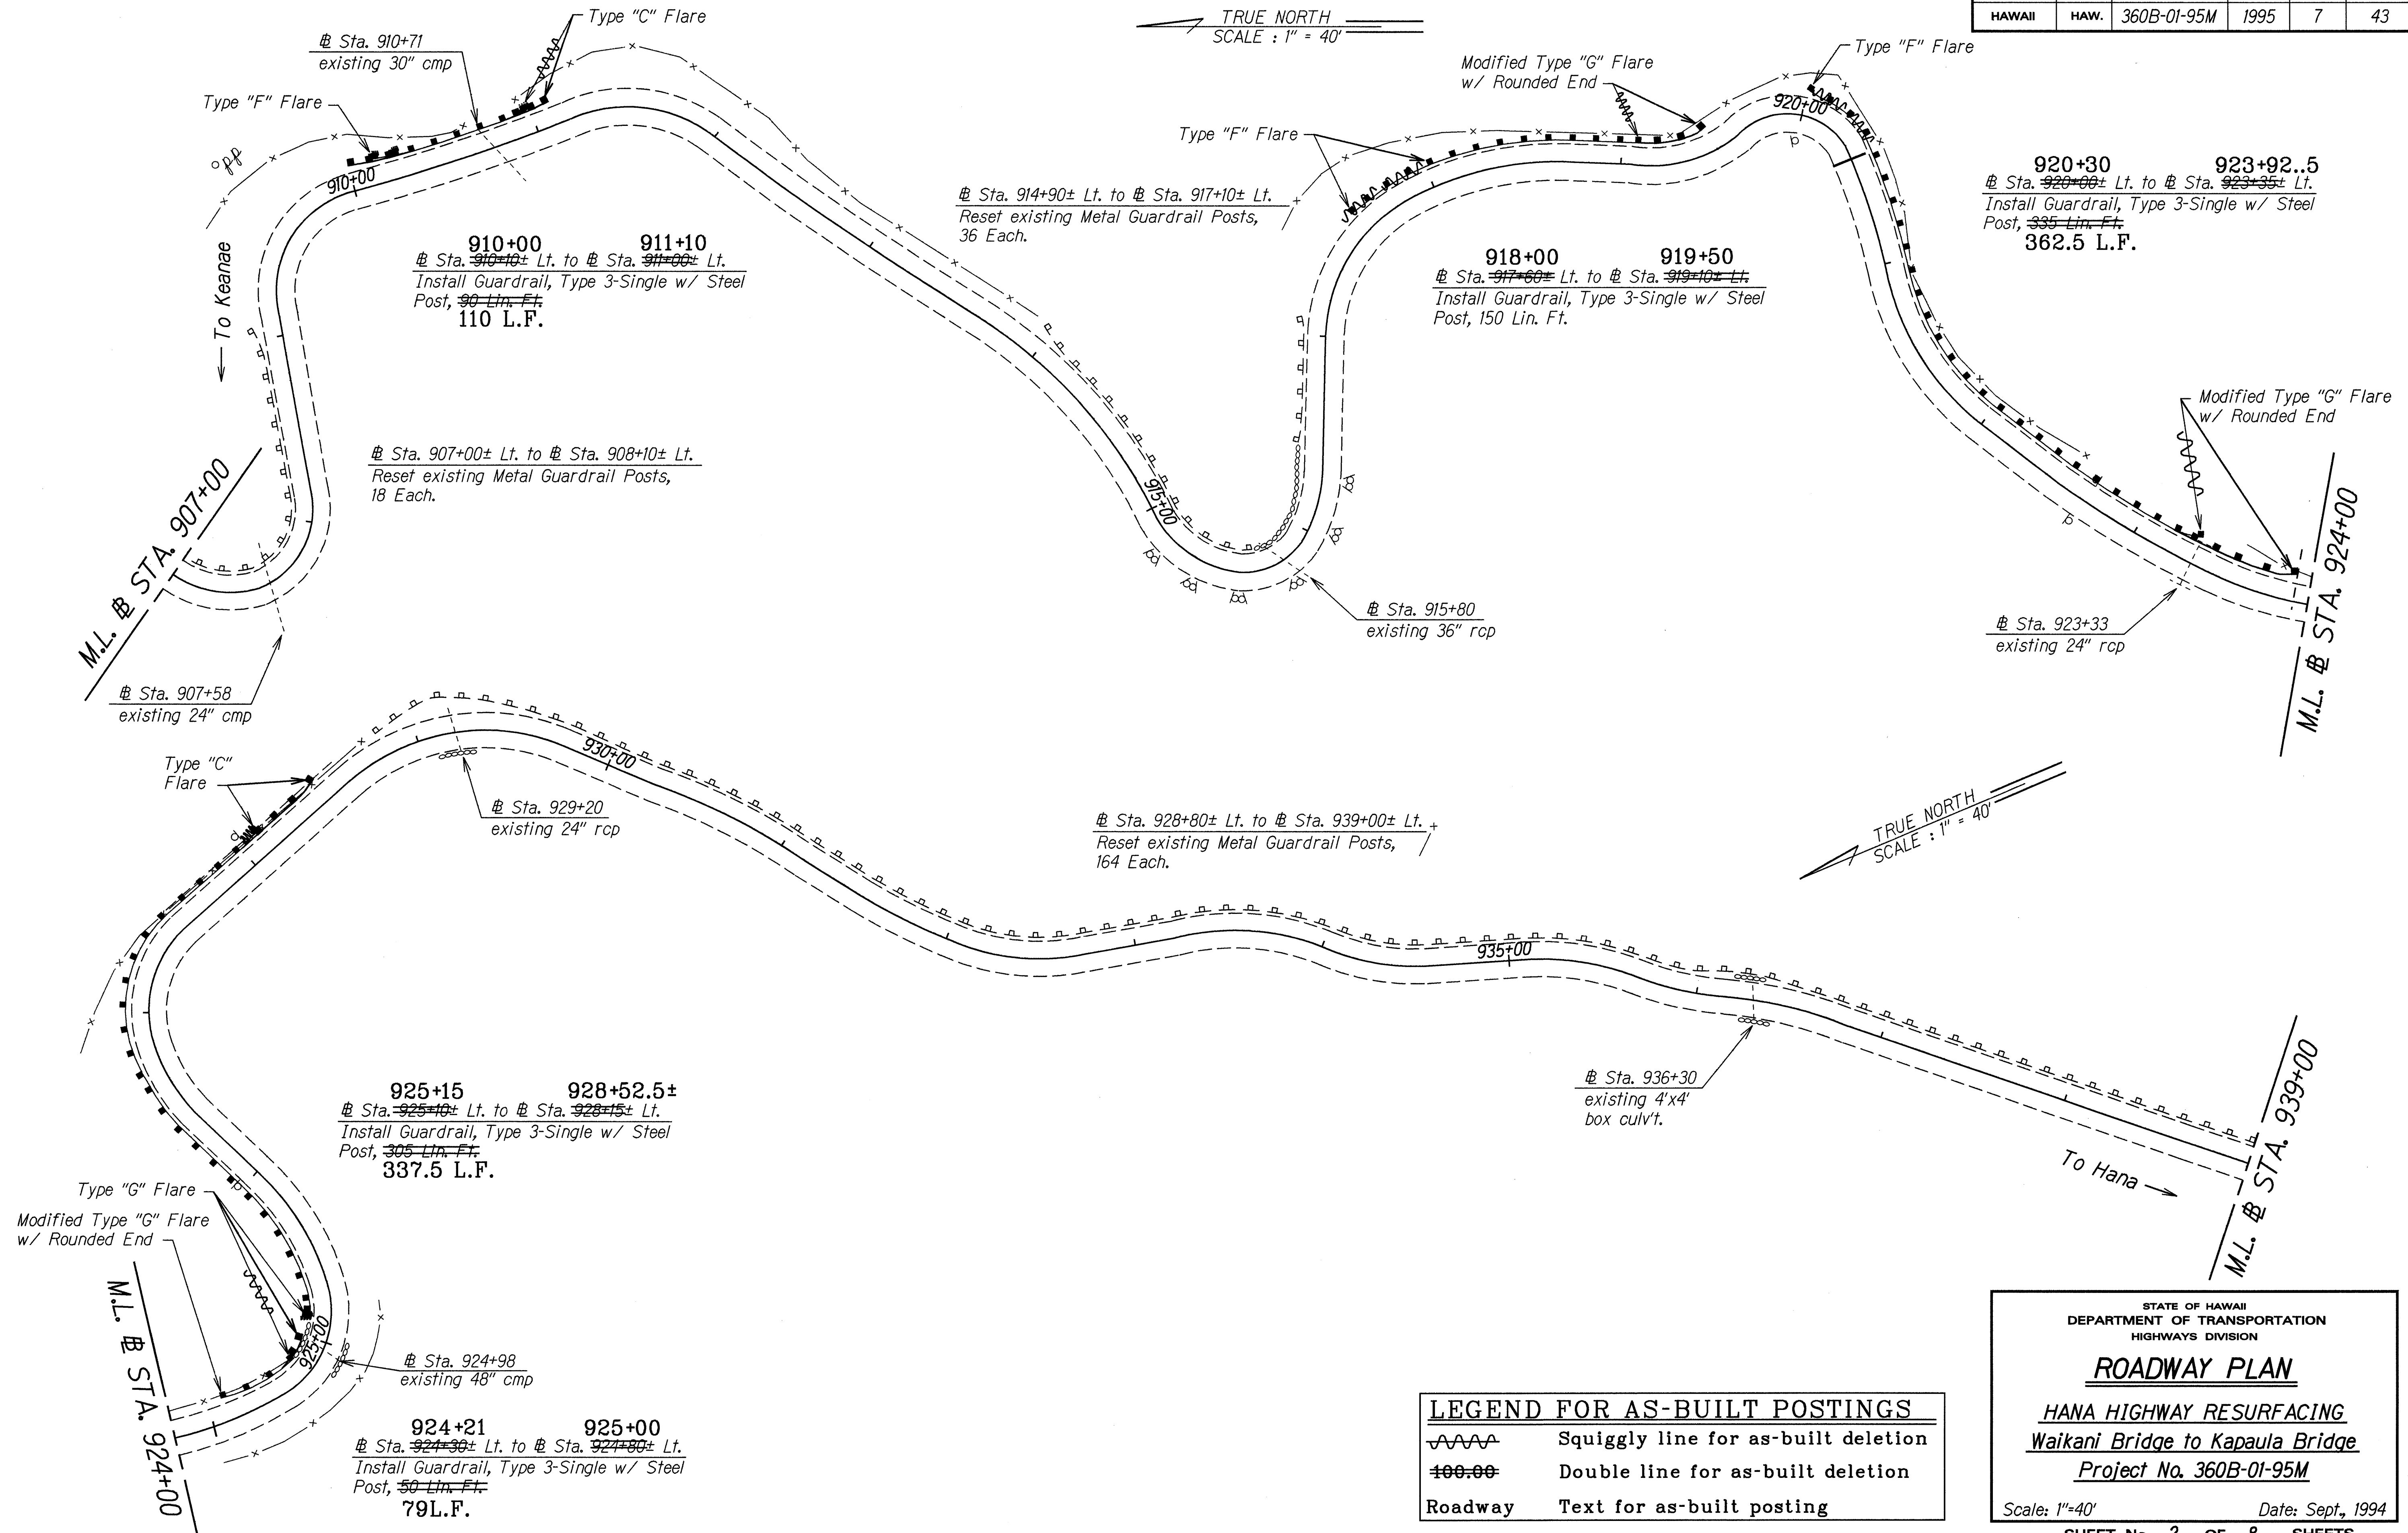

ORIGINAL PLAN	DATE
DRAWN BY J. Malsiani	12-25-94
CHECKED BY M. A. A. A.	
NOTED BY M. A. A. A.	
QUANTITIES BY M. A. A. A.	
CHECKED BY M. A. A. A.	

STATE OF HAWAII
DEPARTMENT OF TRANSPORTATION
HIGHWAYS DIVISION


ROADWAY PLAN

HANA HIGHWAY RESURFACING
Waikani Bridge to Kapaula Bridge
Project No. 360B-01-95M

Scale: 1"=40' Date: Sept., 1994

SHEET No. 2 OF 8 SHEETS


FED. ROAD DIST. NO.	STATE	PROJ. NO.	FISCAL YEAR	SHEET NO.	TOTAL SHEETS
HAWAII	HAW.	360B-01-95M	1995	8	43

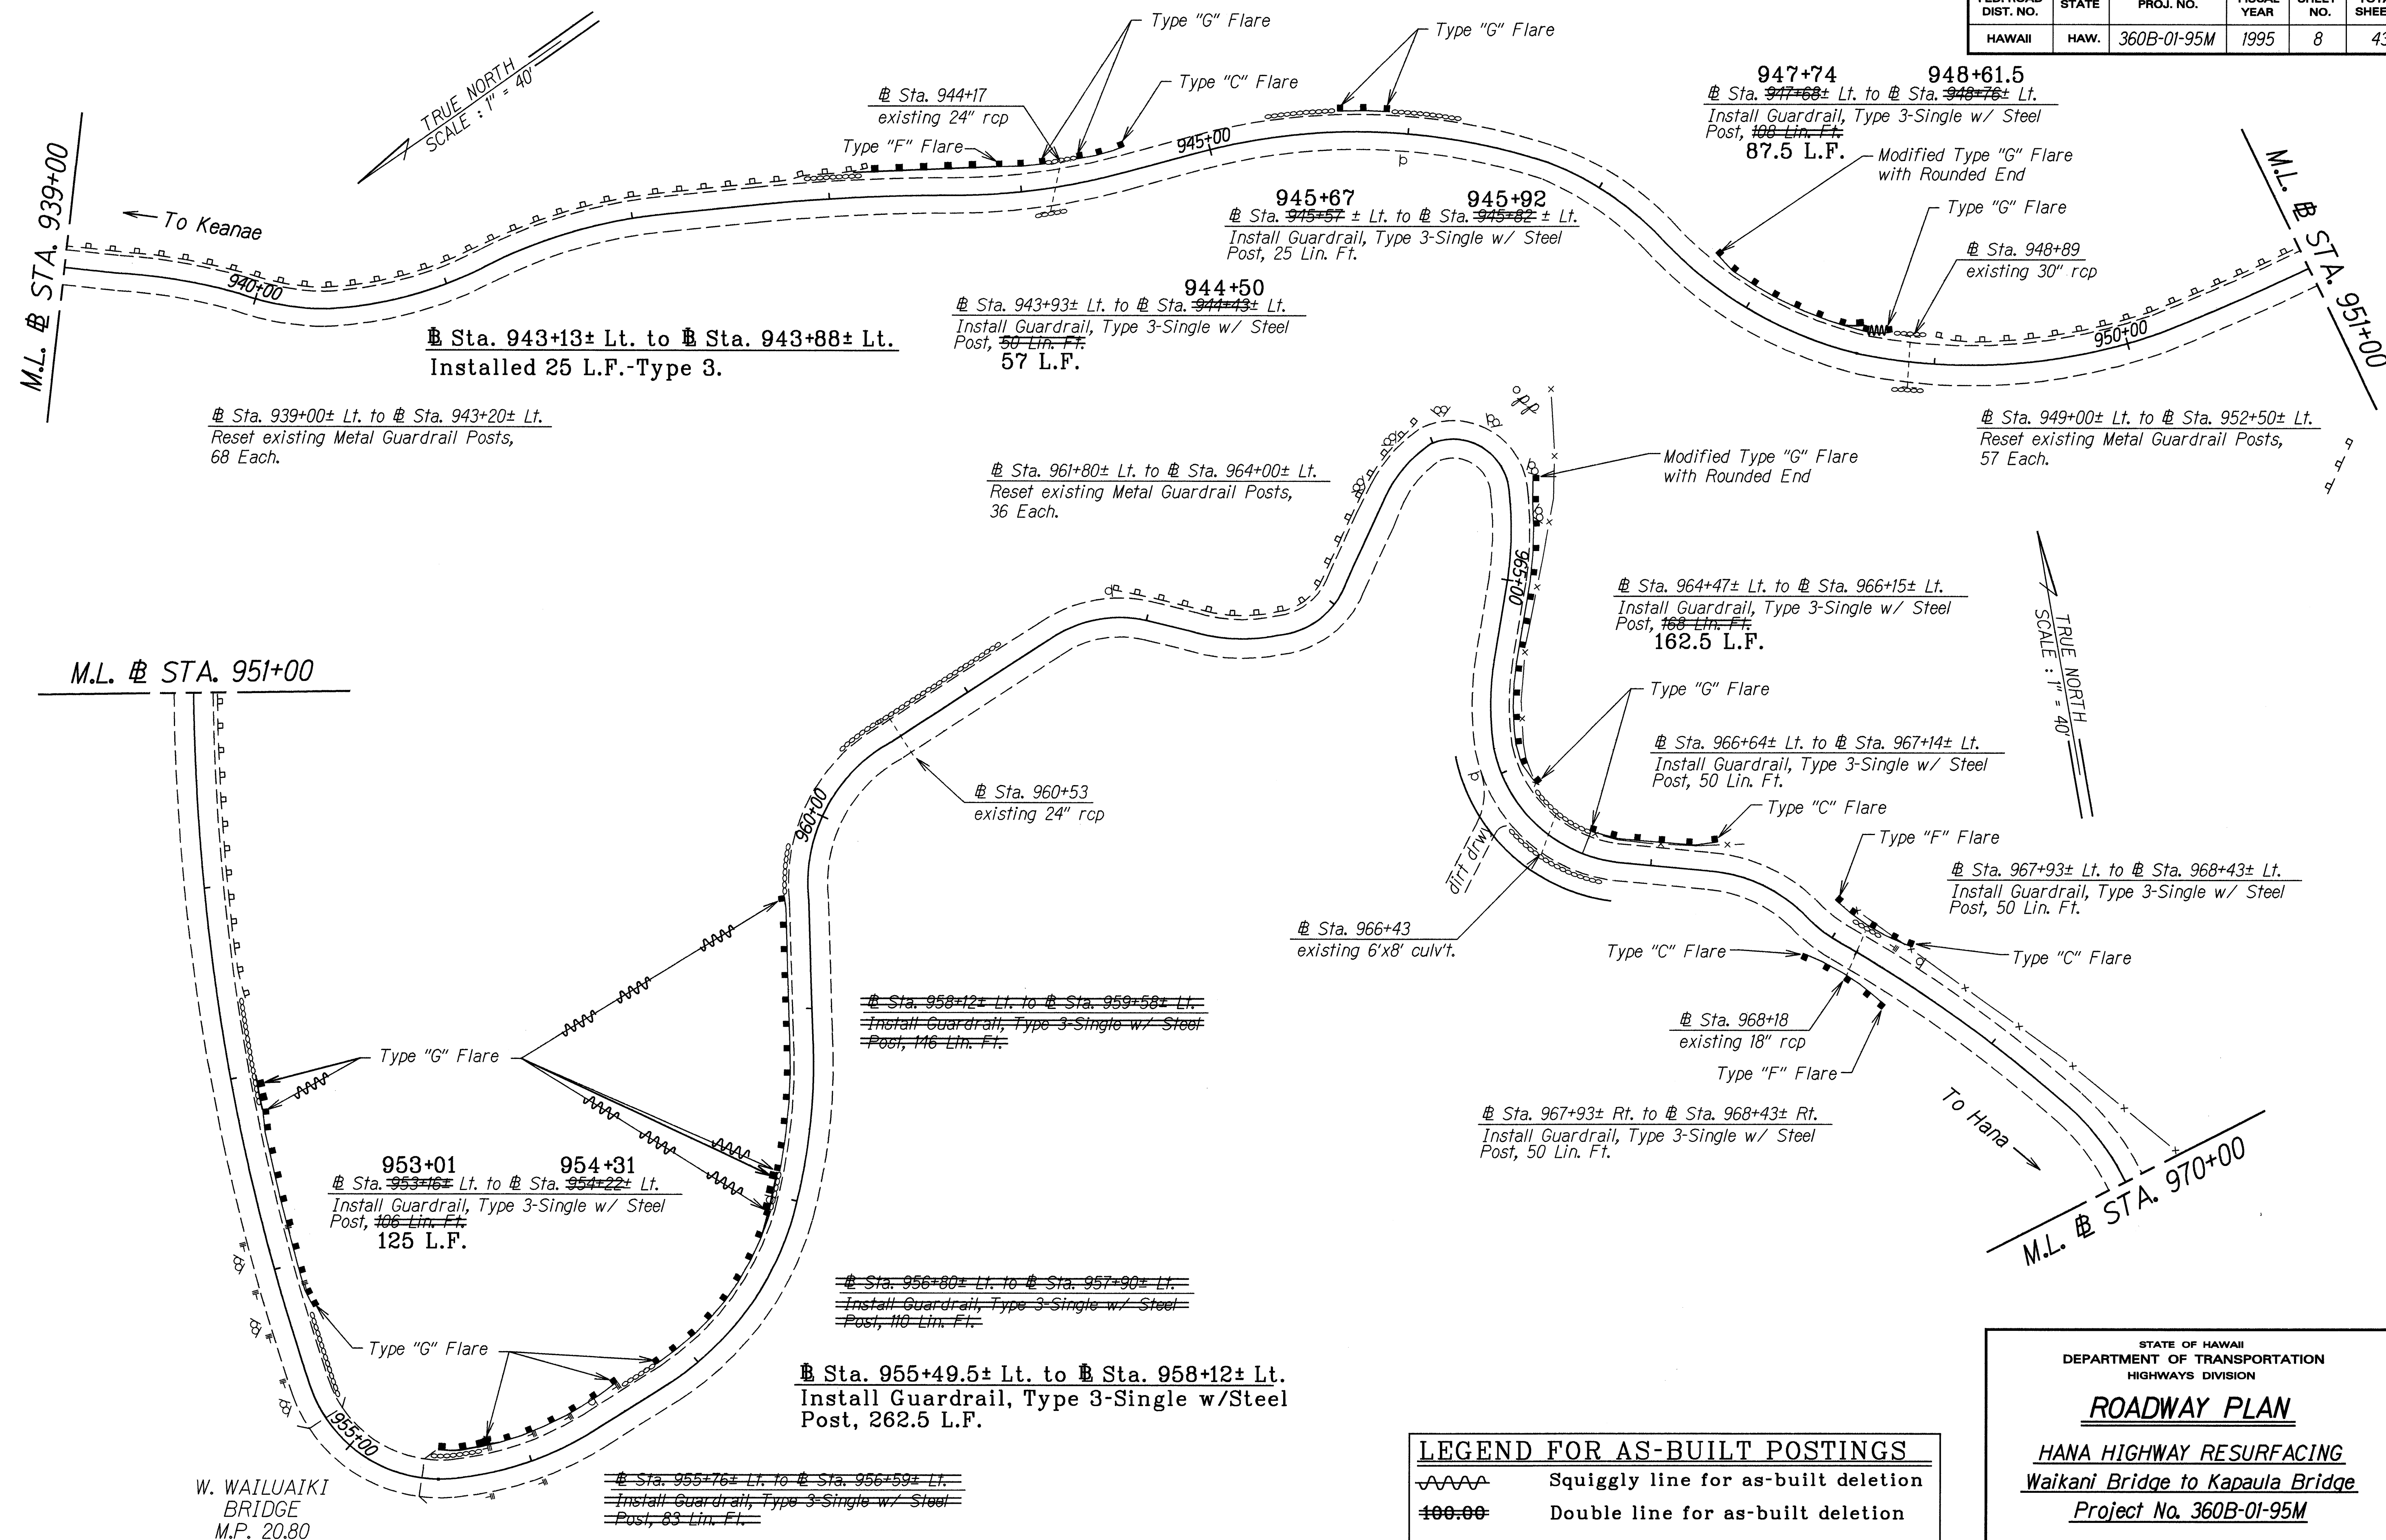

ORIGINAL PLAN	DATE
DRAWN BY: M. J. M. J.	12/25/95
DESIGNED BY: M. J. M. J.	
CHECKED BY: M. J. M. J.	
NOTED BY: M. J. M. J.	
DATE: 12/25/95	
CHECKED BY: M. J. M. J.	
DATE: 12/25/95	


STATE OF HAWAII DEPARTMENT OF TRANSPORTATION HIGHWAYS DIVISION
ROADWAY PLAN
HANA HIGHWAY RESURFACING Waikani Bridge to Kapaula Bridge Project No. 360B-01-95M
Scale: 1"=40' Date: Sept., 1994
SHEET No. 3 OF 8 SHEETS

FED. ROAD DIST. NO.	STATE	PROJ. NO.	FISCAL YEAR	SHEET NO.	TOTAL SHEETS
HAWAII	HAW.	360B-01-95M	1995	9	43

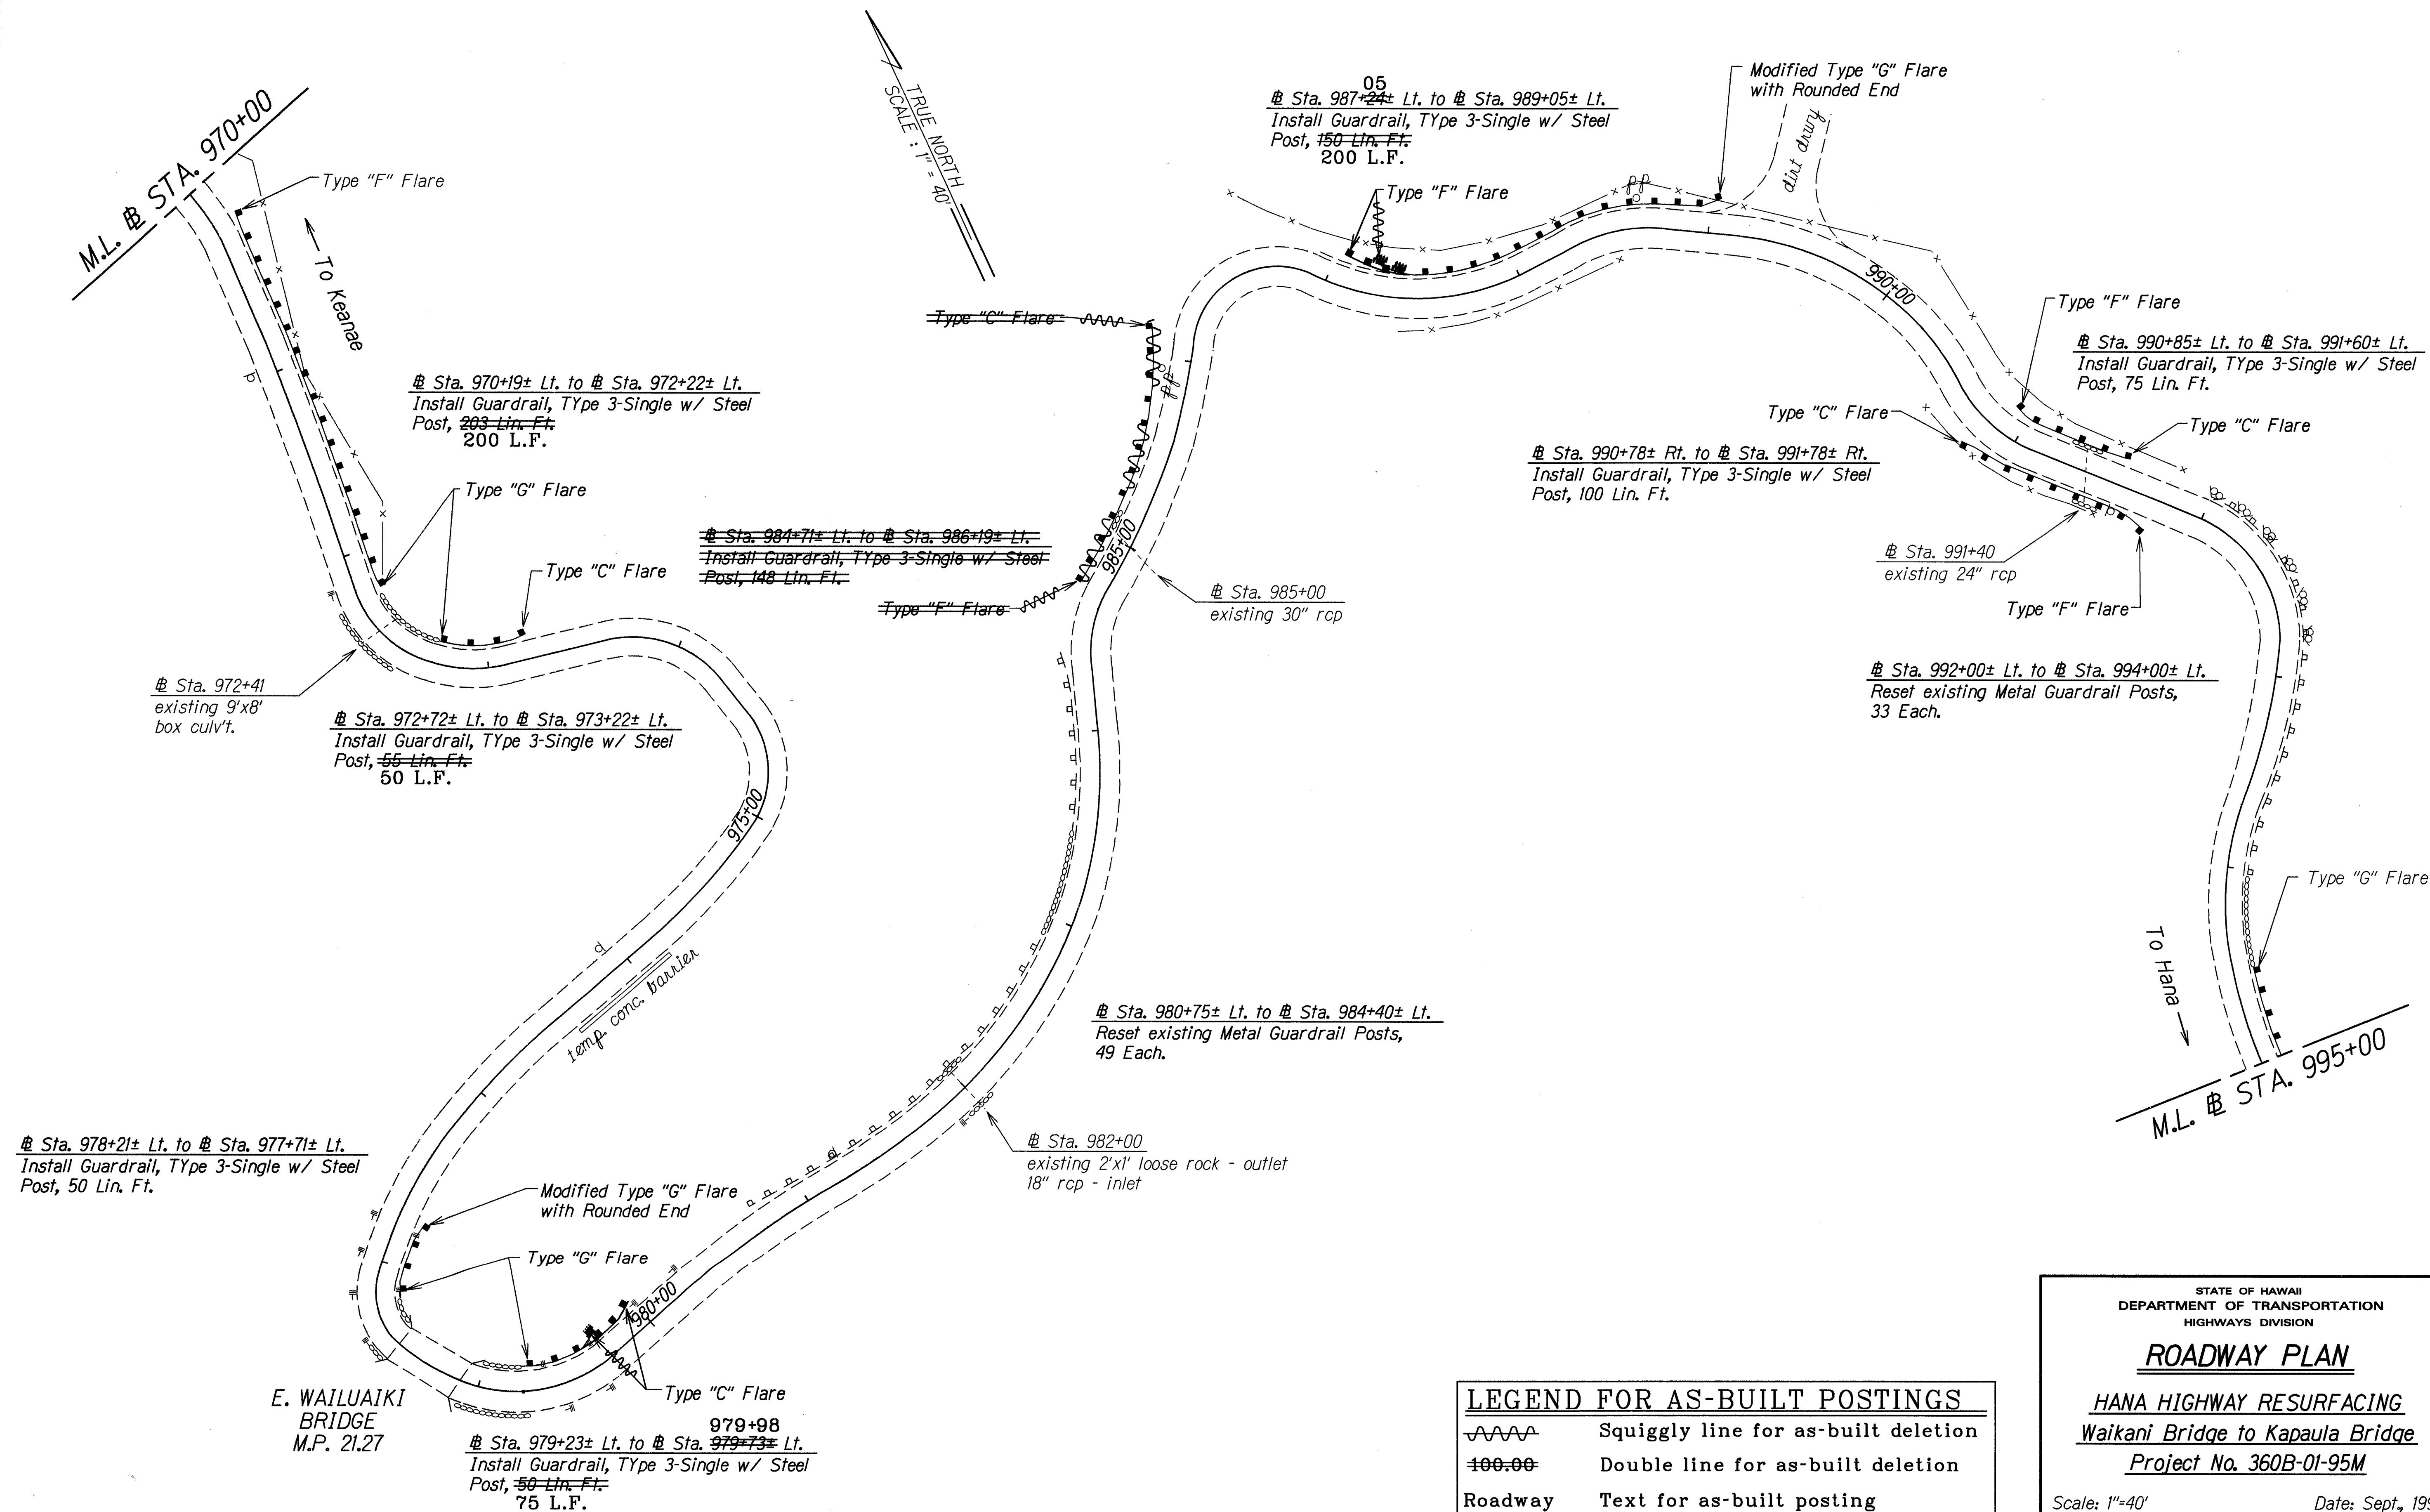


ORIGINAL PLAN	DATE
14-25-95	
SURVEY PLOTTED BY	
DRAWN BY J. Malsuriani	
TRACED BY M. Ate	
NOTED BY J. Ate	
QUANTITIES BY	
CHECKED BY	

FED. ROAD DIST. NO.	STATE	PROJ. NO.	FISCAL YEAR	SHEET NO.	TOTAL SHEETS
HAWAII	HAW.	360B-01-95M	1995	10	43

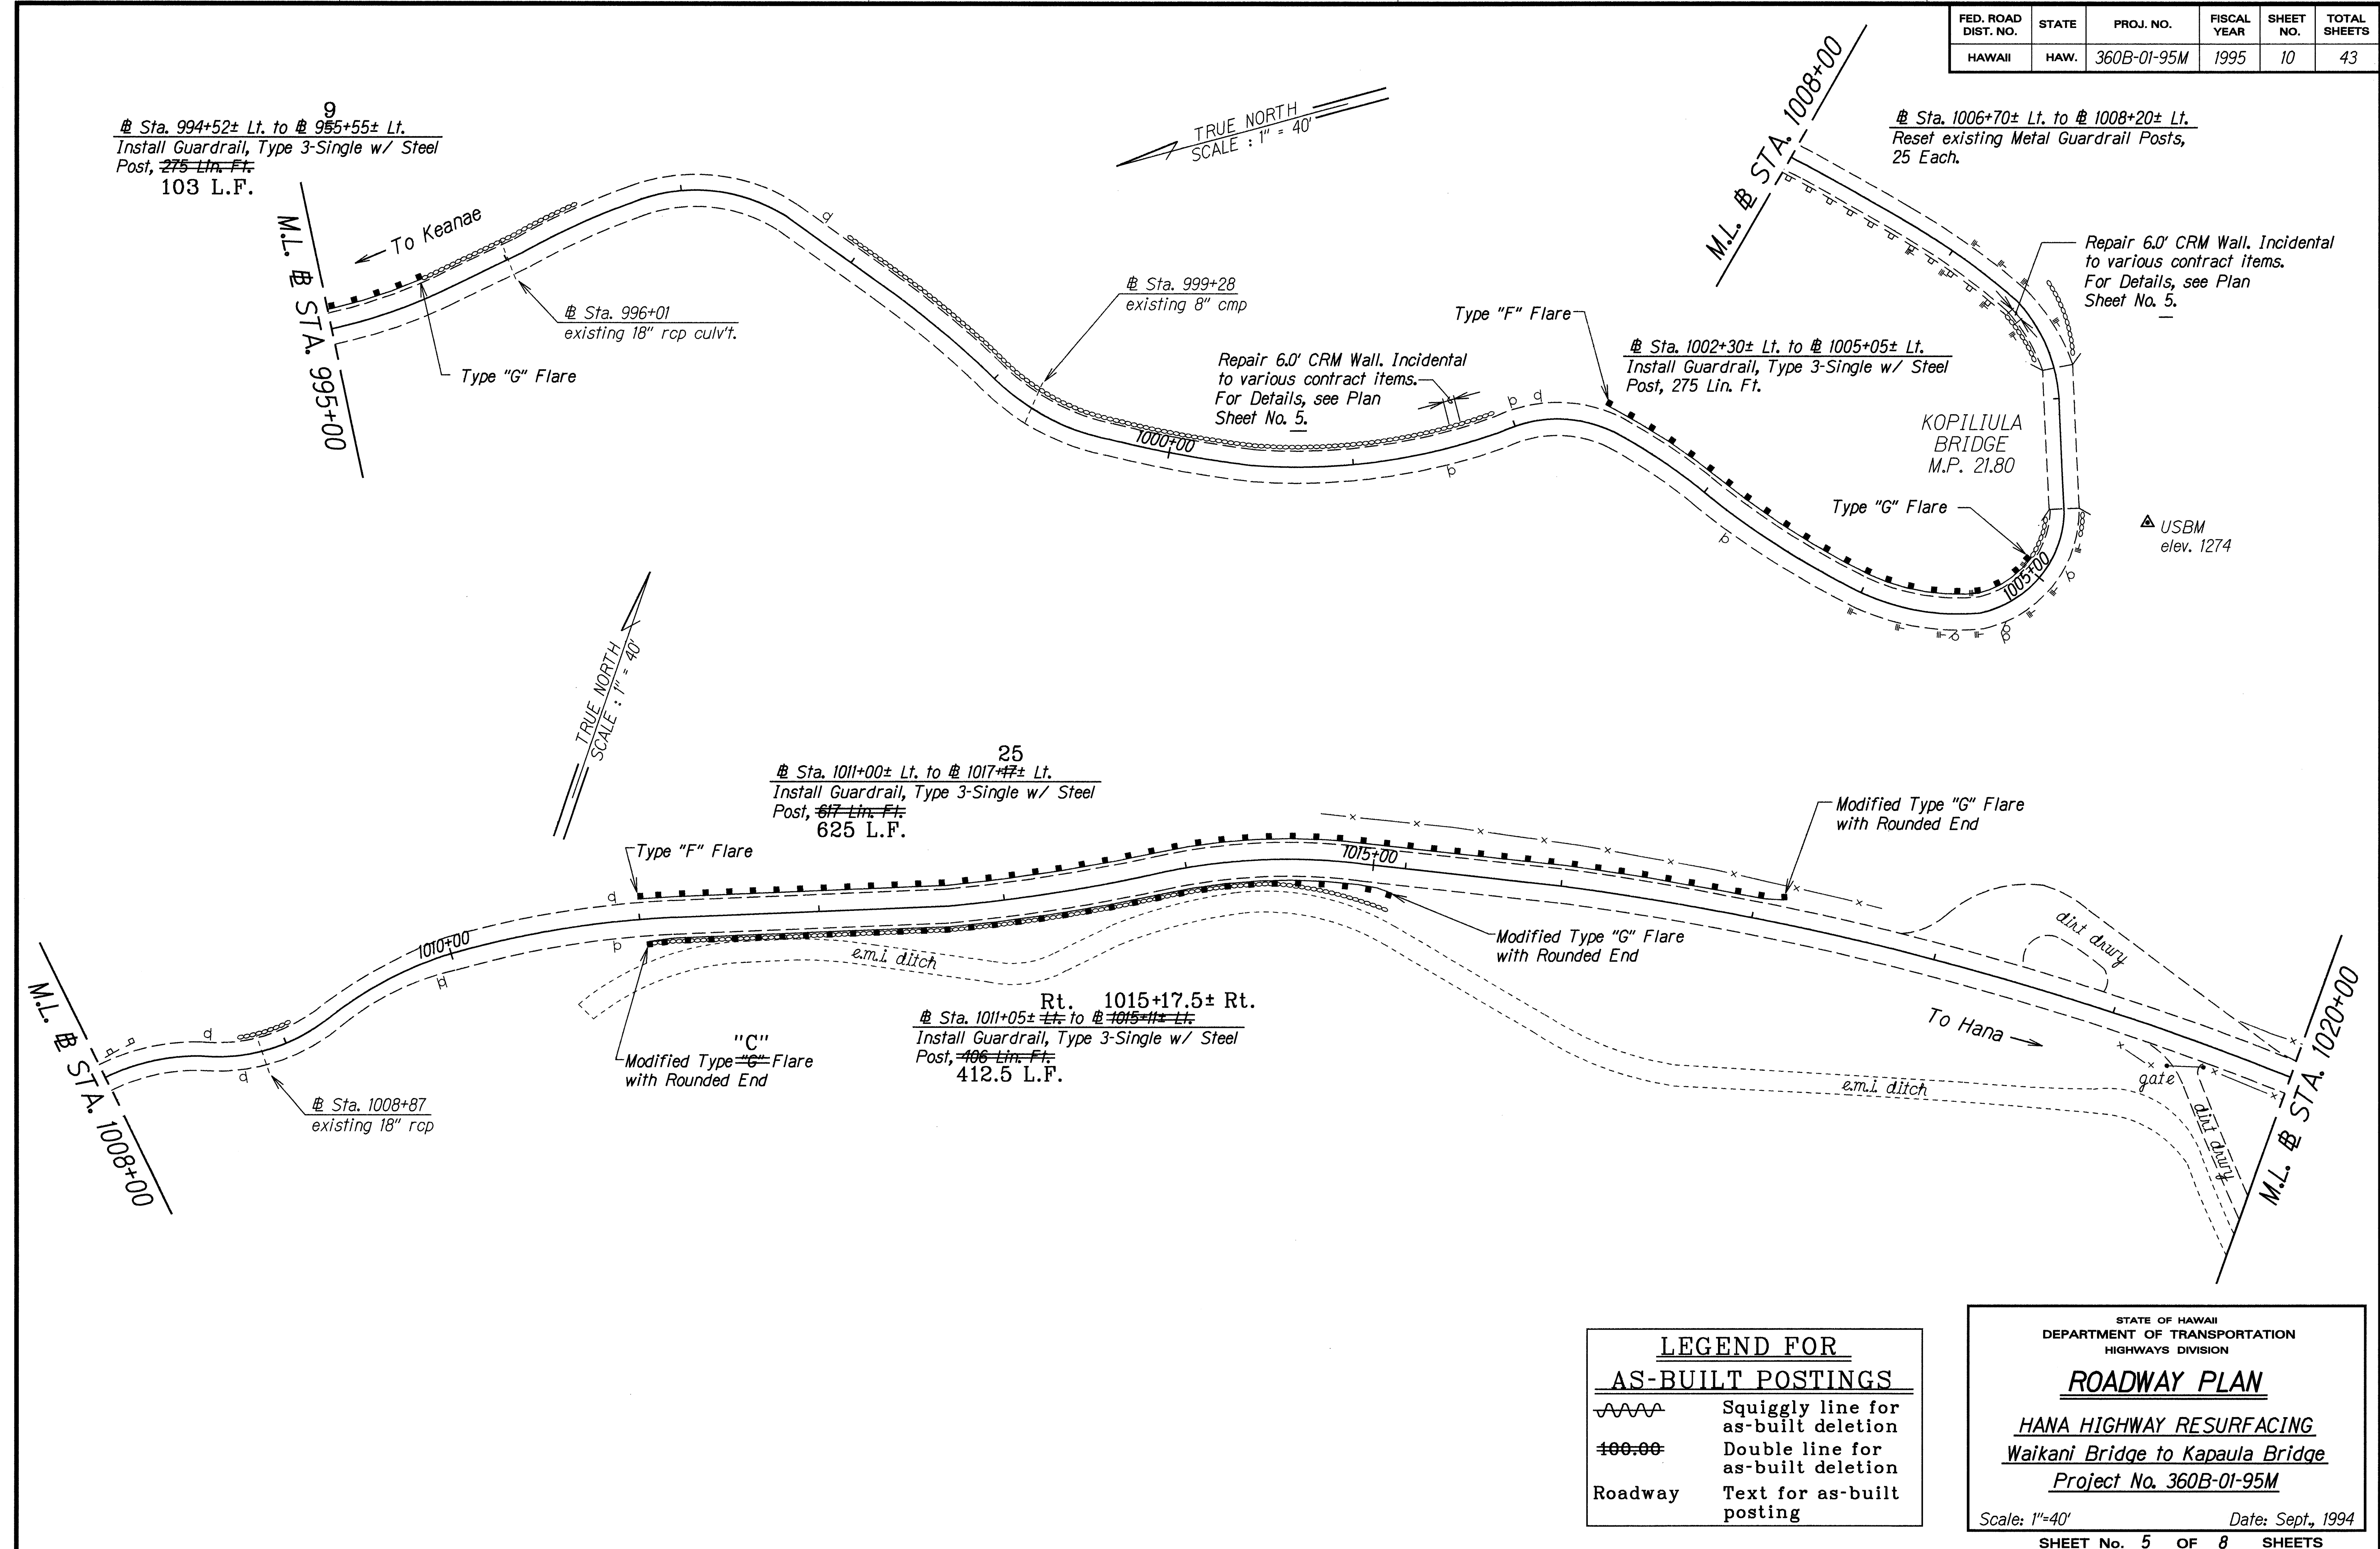

ORIGINAL PLAN	SURVEY PLOTTED BY	DATE
PLAN	DRAWN BY J. Malsbani	12-20-94
NOTE BOOK	TRACED BY M. Ate	
dd4/jason	QUANTITIES BY	
N. Jhandip	CHECKED BY	

FED. ROAD DIST. NO.	STATE	PROJ. NO.	FISCAL YEAR	SHEET NO.	TOTAL SHEETS
HAWAII	HAW.	360B-01-95M	1995	11	43

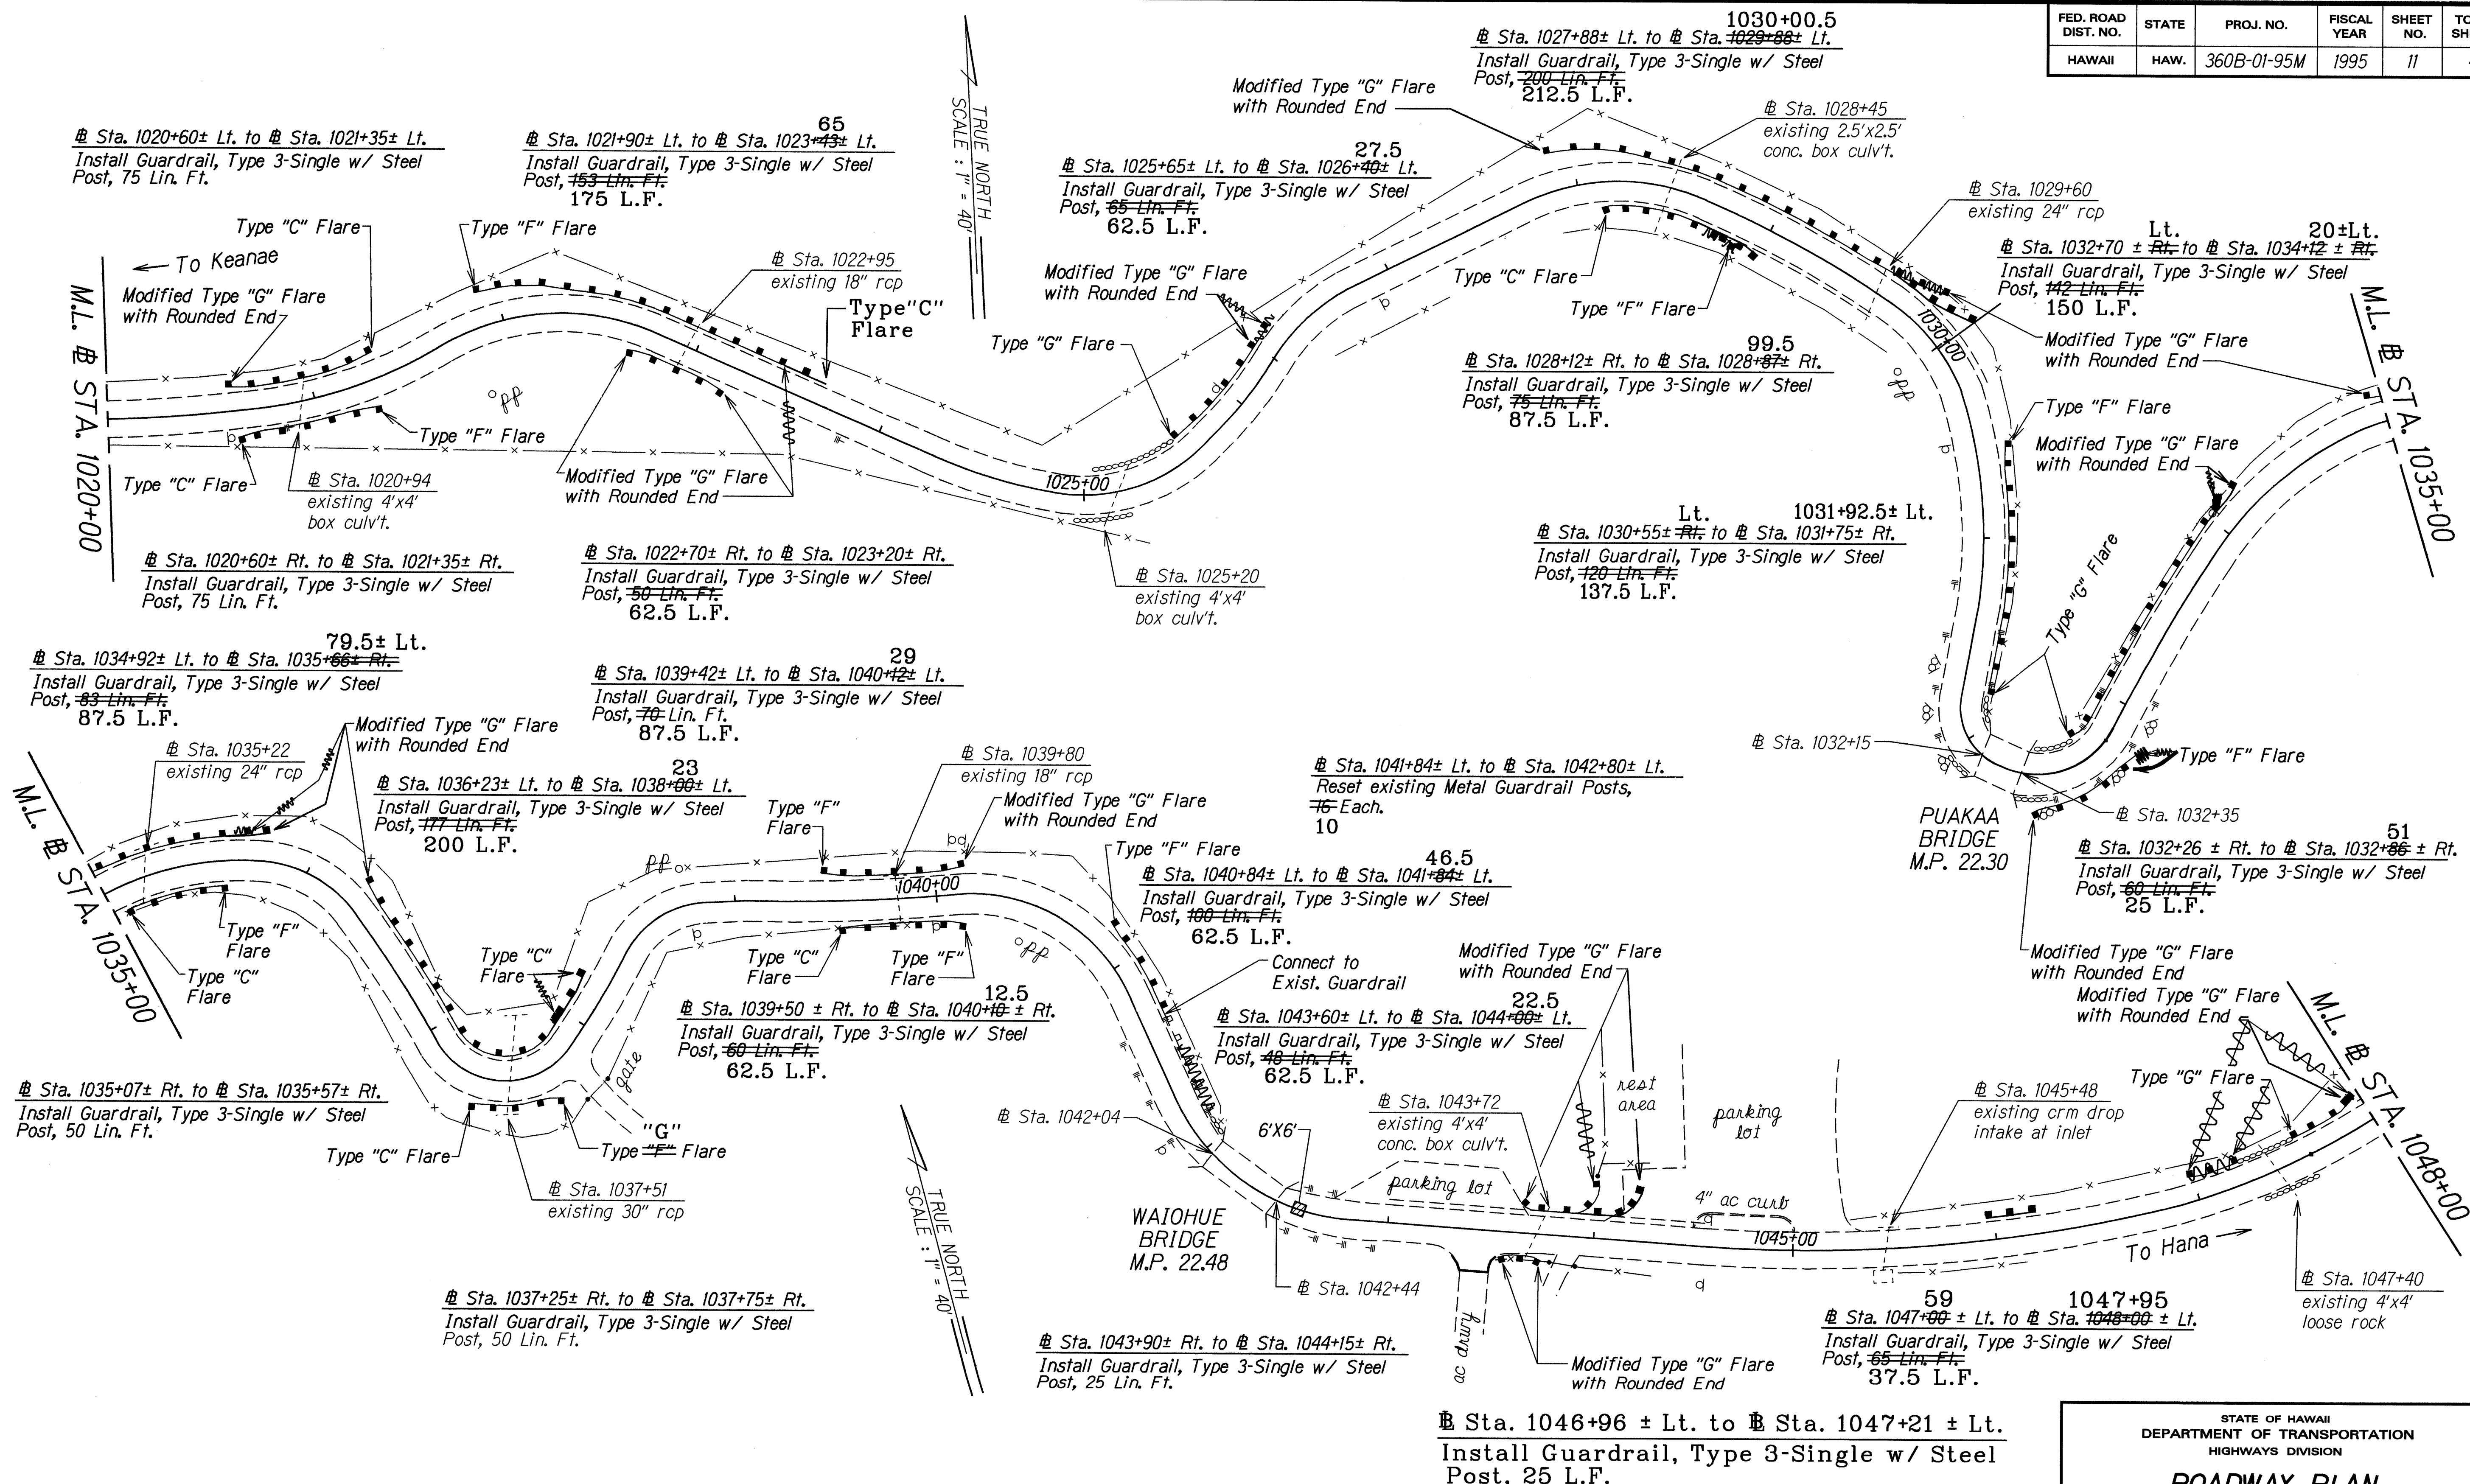

LEGEND FOR AS-BUILT POSTINGS	
	Squiggly line for as-built deletion
	Double line for as-built deletion
Roadway	Text for as-built posting



STATE OF HAWAII
DEPARTMENT OF TRANSPORTATION
HIGHWAYS DIVISION

ROADWAY PLAN

HANA HIGHWAY RESURFACING
Waikani Bridge to Kapaula Bridge
Project No. 360B-01-95M

Scale: 1"=40' Date: Sept., 1994
SHEET NO. 6 OF 8 SHEETS

FED. ROAD DIST. NO.	STATE	PROJ. NO.	FISCAL YEAR	SHEET NO.	TOTAL SHEETS
HAWAII	HAW.	360B-01-95M	1995	12	43

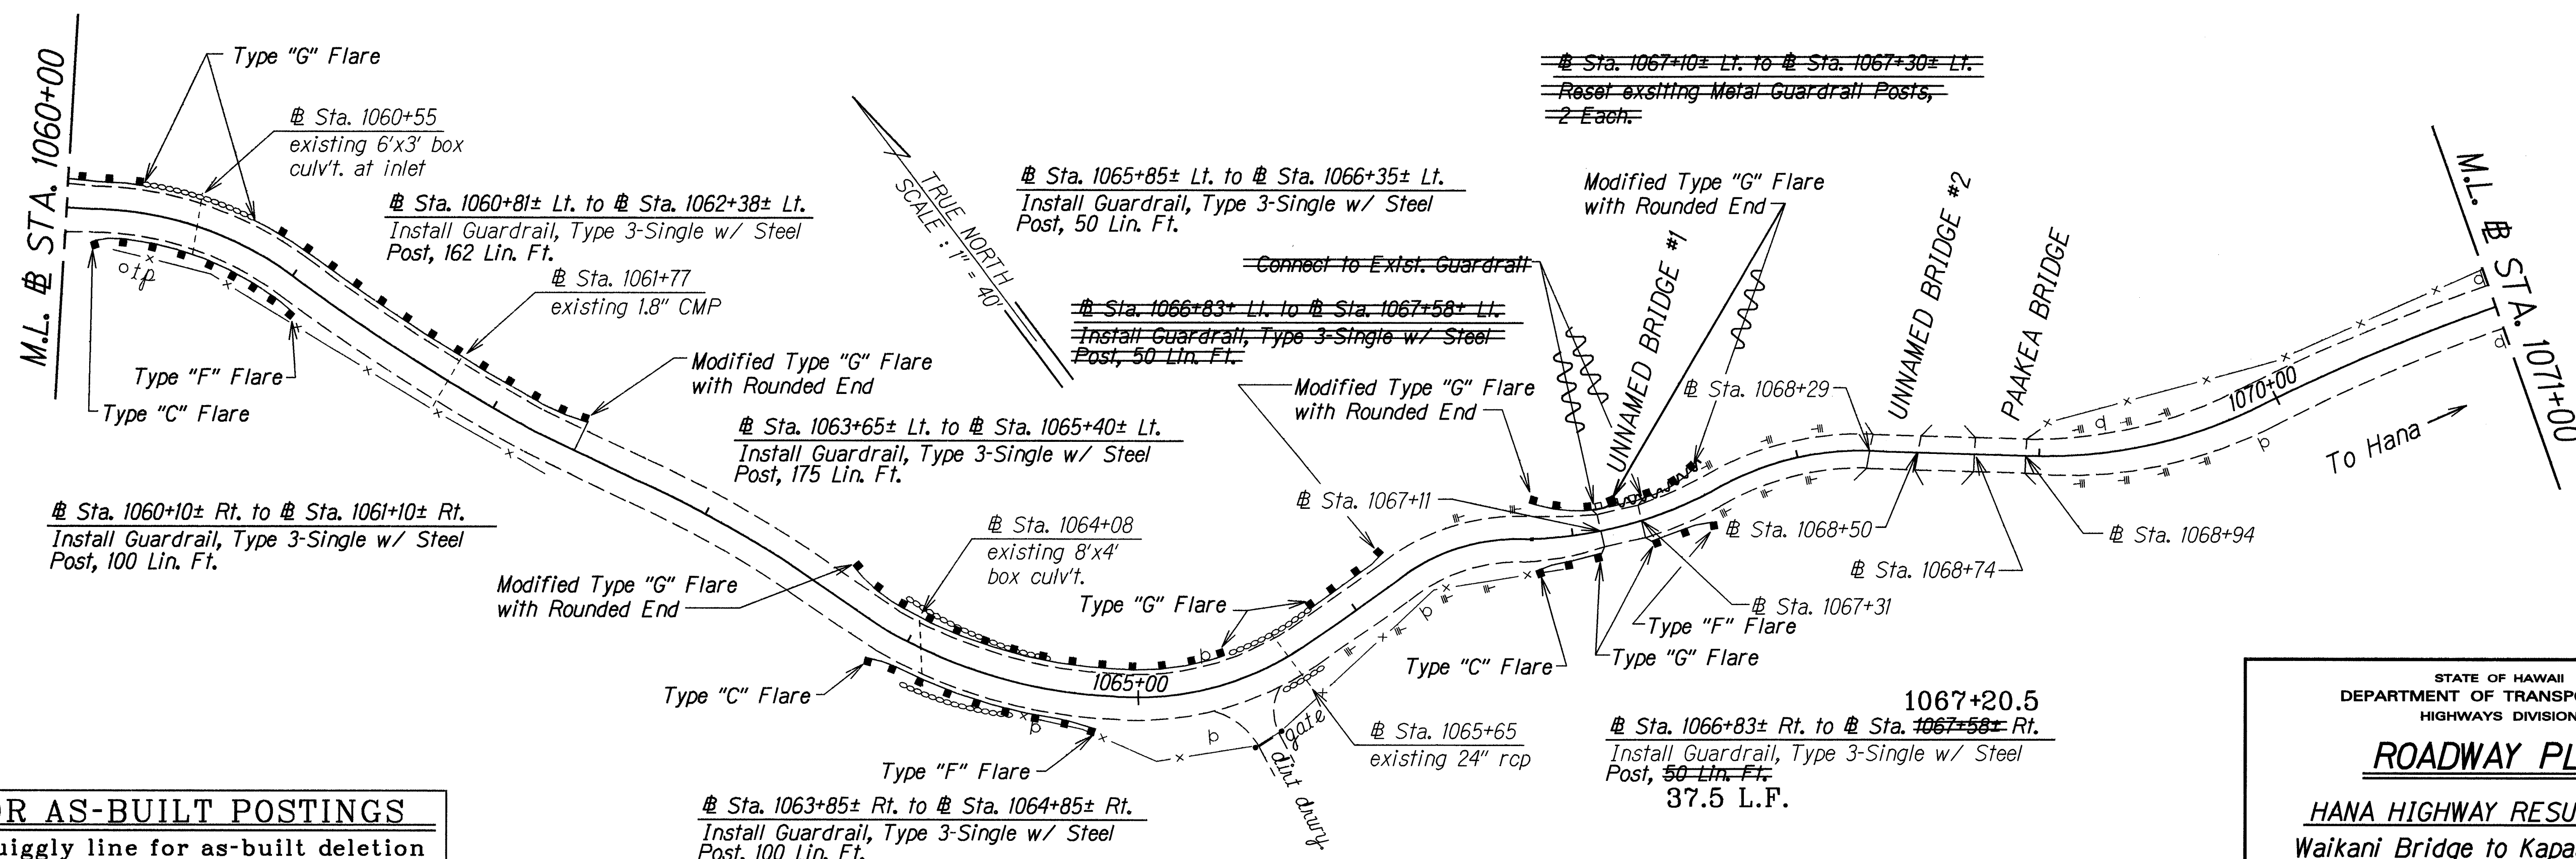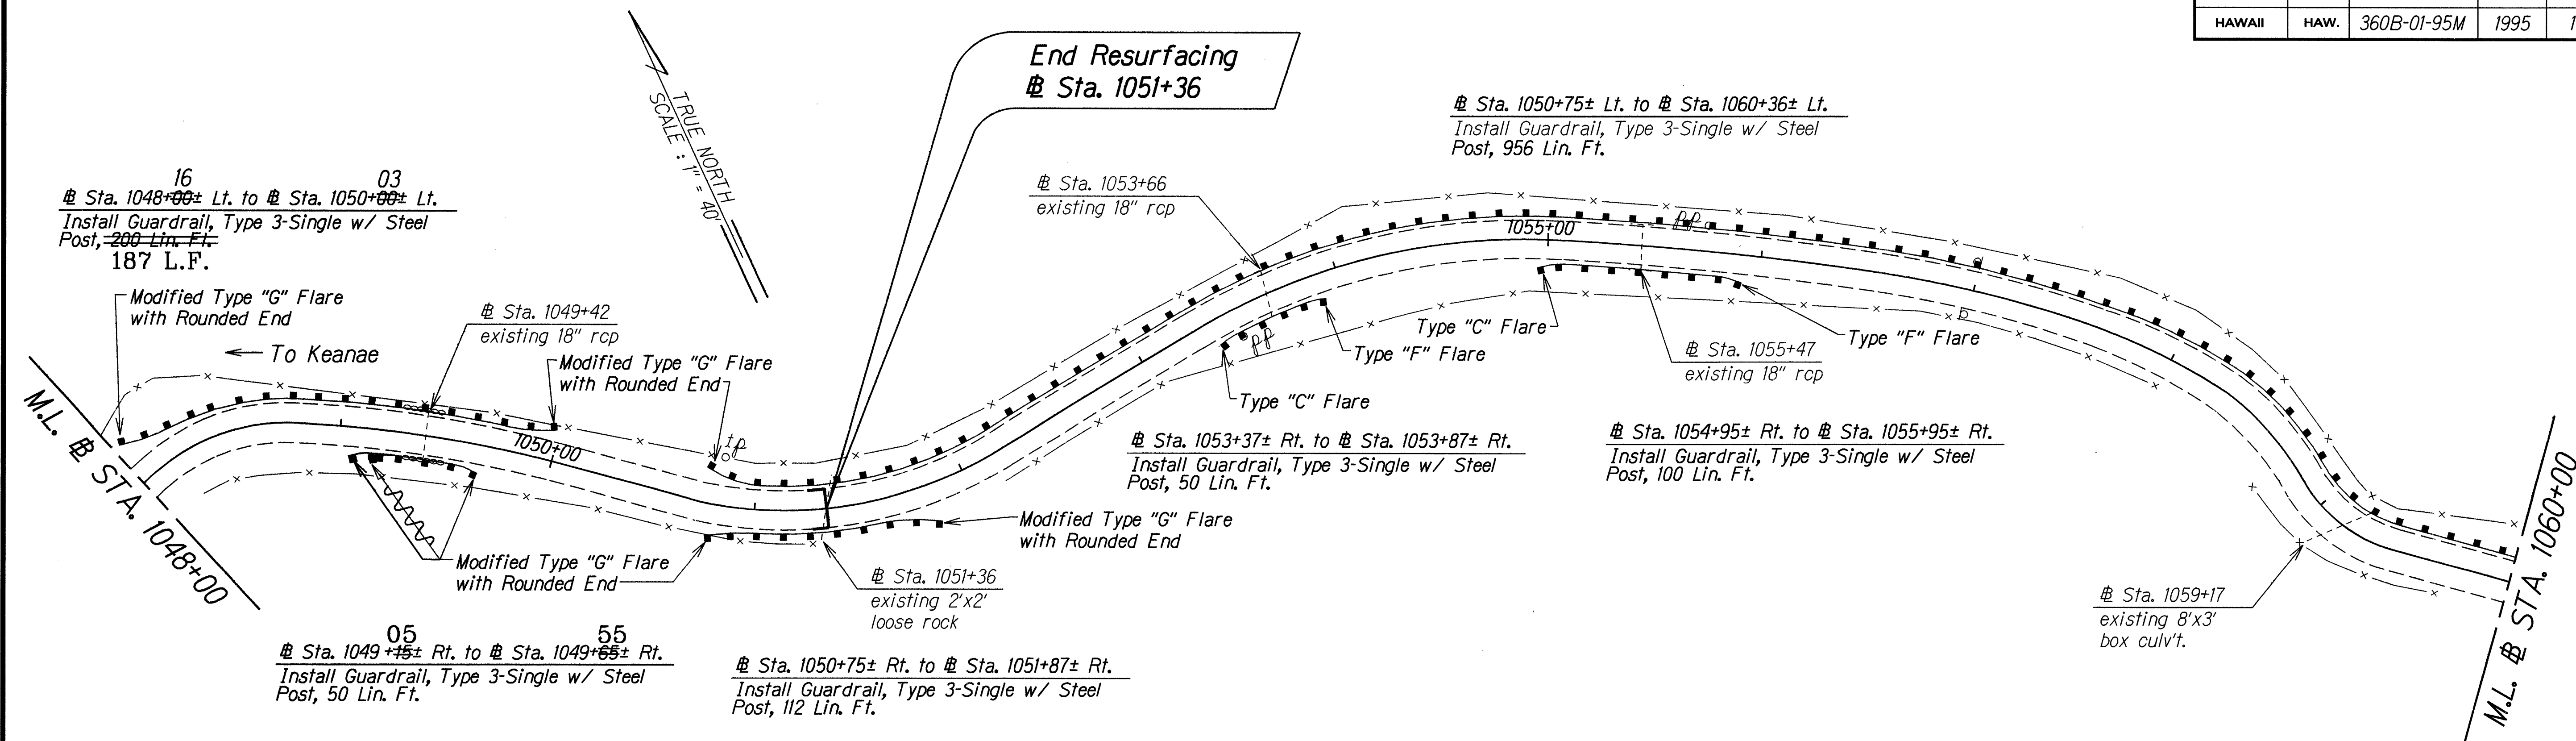

LEGEND FOR AS-BUILT POSTINGS	
	Squiggly line for as-built deletion
	Double line for as-built deletion
Roadway	Text for as-built posting

STATE OF HAWAII
DEPARTMENT OF TRANSPORTATION
HIGHWAYS DIVISION


ROADWAY PLAN

HANA HIGHWAY RESURFACING
Waikani Bridge to Kapaula Bridge
Project No. 360B-01-95M

Scale: 1"=40' Date: Sept., 1994

SHEET No. 7 OF 8 SHEETS

FED. ROAD DIST. NO.	STATE	PROJ. NO.	FISCAL YEAR	SHEET NO.	TOTAL SHEETS
HAWAII	HAW.	360B-01-95M	1995	13	43

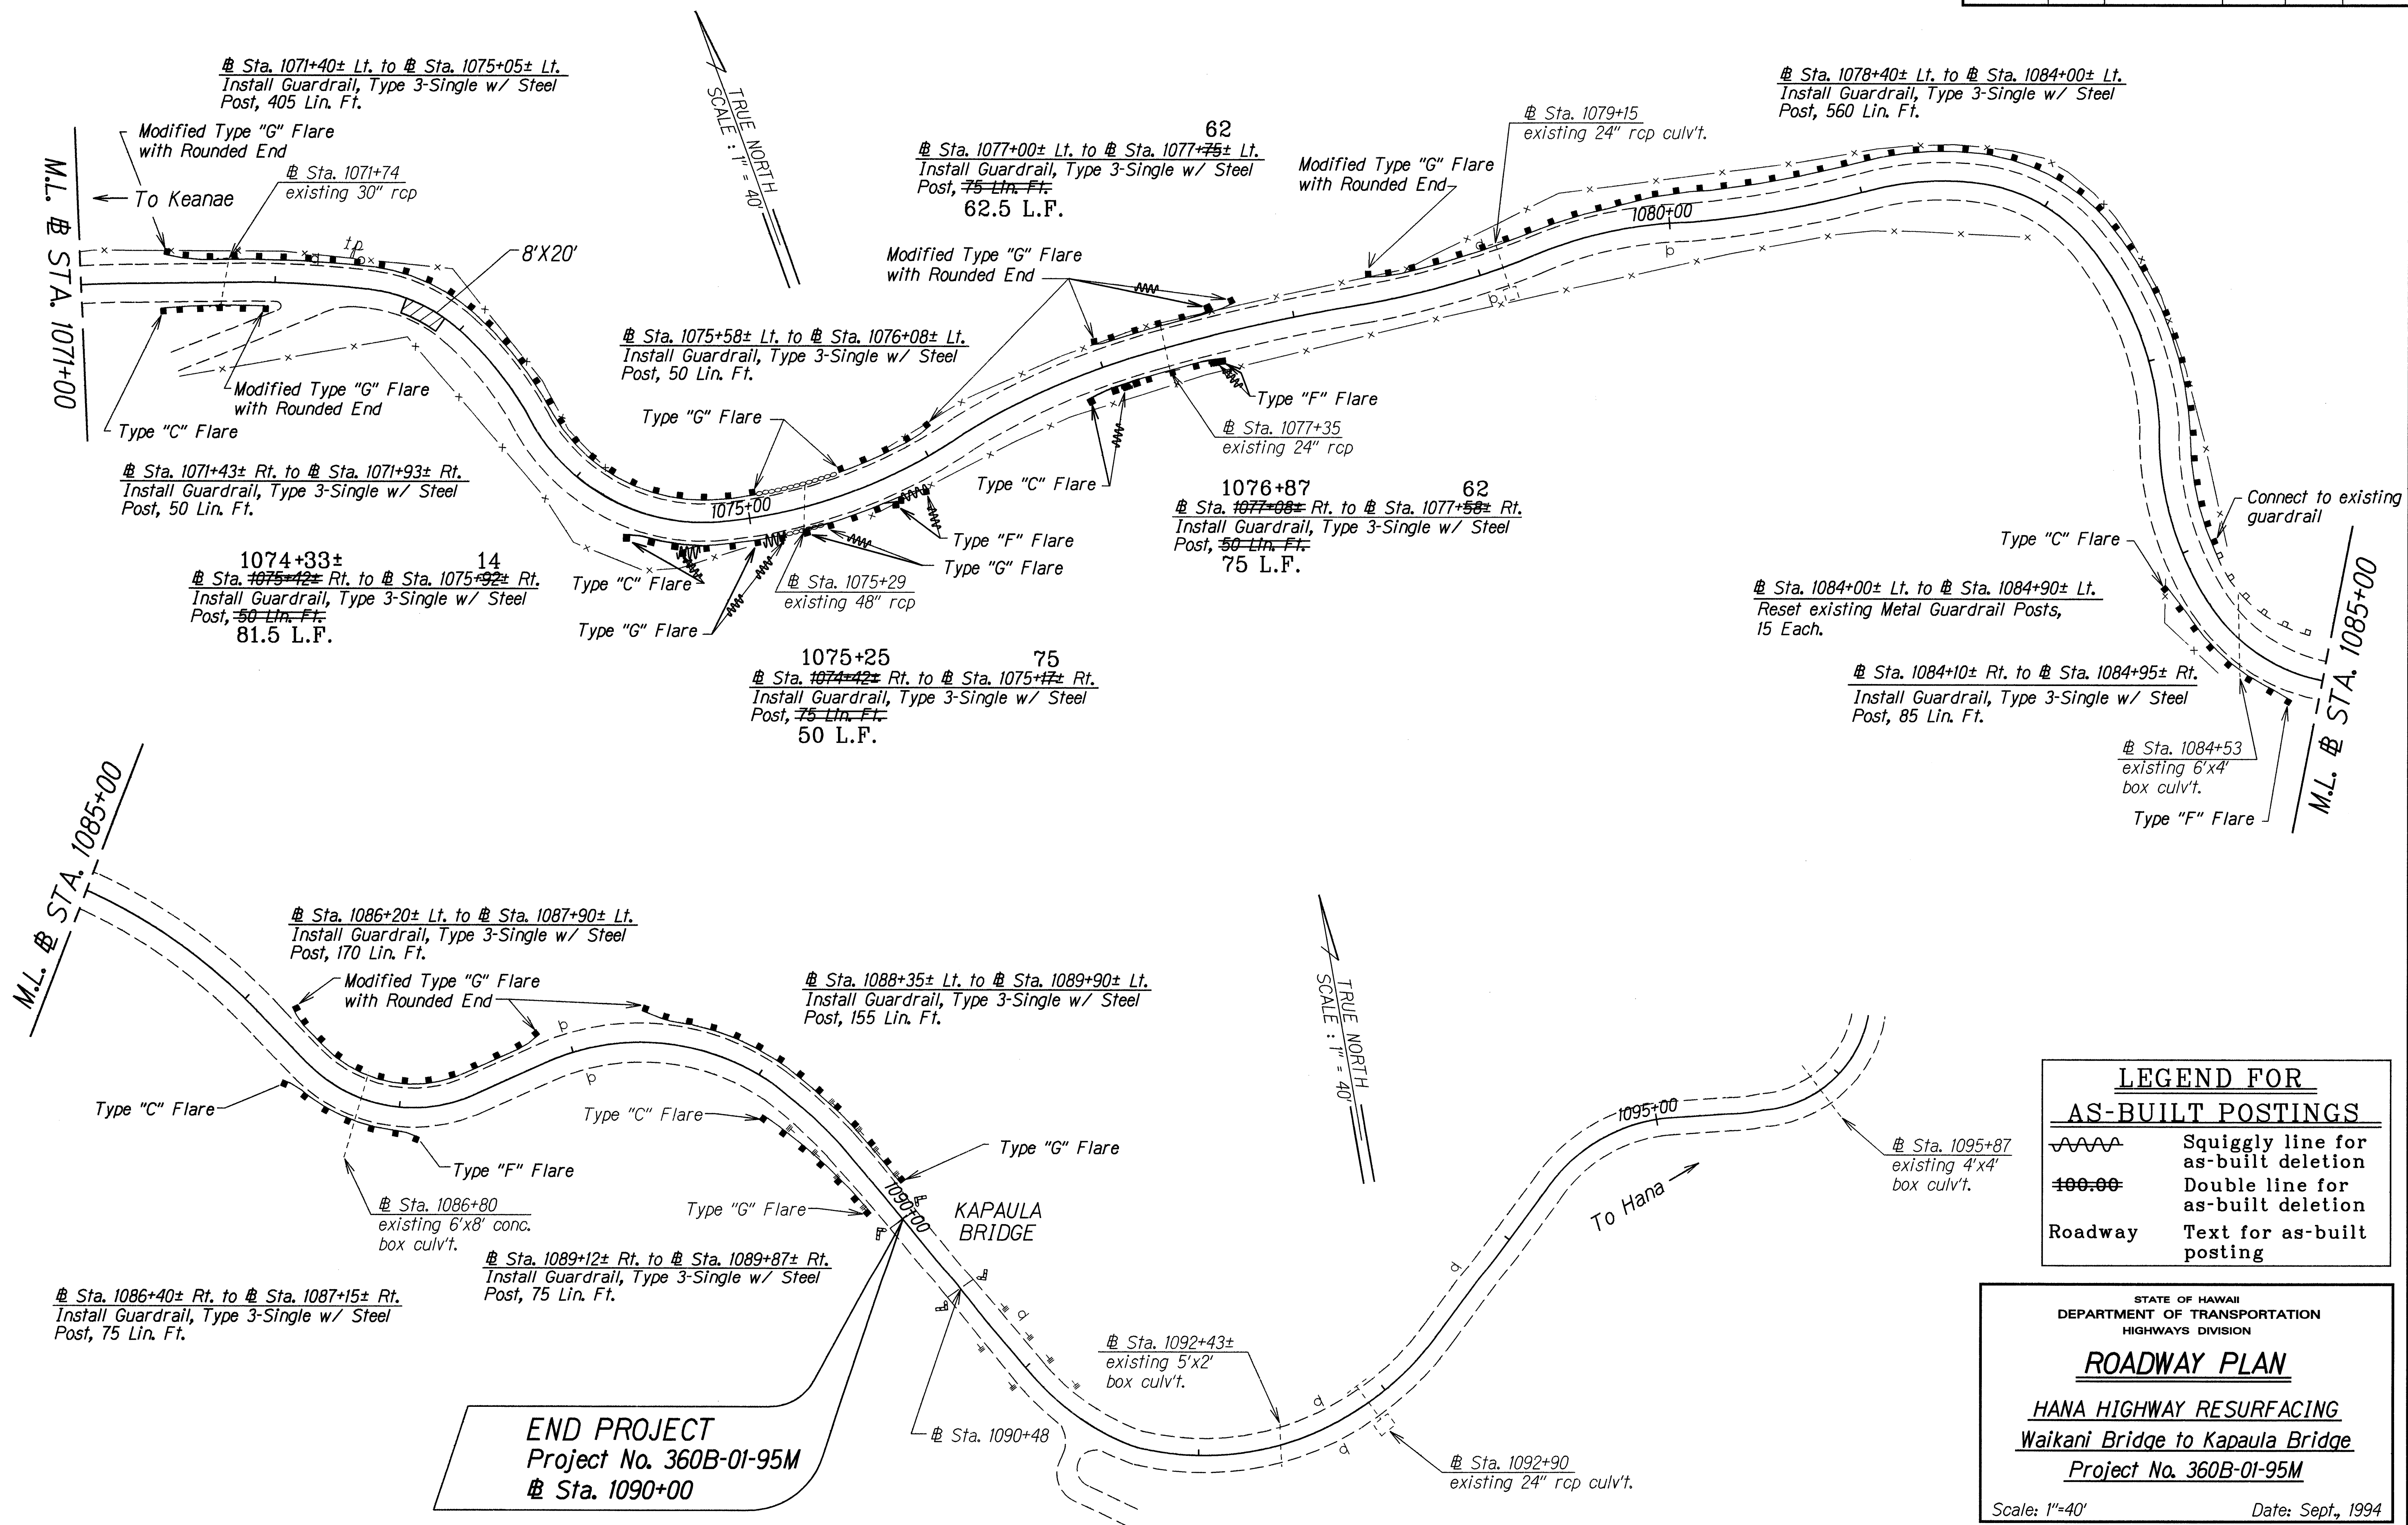

ORIGINAL PLAN	DATE
SURVEY PLOTTED BY	15-20-95
DRAWN BY	J. M. Ate
TRACED BY	M. Ate
NOTED BY	W. Ate
QUANTITIES BY	N. Ate
CHECKED BY	N. Ate