	INDEX TO DRAWINGS
SHEET NO.	DESCRIPTION
1	TITLE SHEET
2	STANDARD PLANS SUMMARY
3	GENERAL NOTES AND LEGEND
4 – 5	TYPICAL SECTIONS AND DETAILS
	AND PAVEMENT WIDTH SCHEDULE
6 – 13	ROADWAY PLANS
14	PAVEMENT MARKING AND SIGNING,
	LEGEND, DETAILS AND NOTES
15 – 22	PAVEMENT MARKING AND
	SIGNING PLAN
23	TRAFFIC SUMMARIES
①24 – 43	DRAINAGE PLANS
① Plan Shto CO 3/S-I and ADD/3S-I are	

① Plan Shts. C.O.34S-I and ADD43S-I are supplementary sheets to this project. TOTAL SHEET COUNT after "AS-BUILT" postings 45 Sheets.

## STATE OF HAWAII

## DEPARTMENT OF TRANSPORTATION


HIGHWAYS DIVISION
HONOLULU, HAWAII
"AS-BUILT"
PLANS FOR

## HANA HIGHWAY RESURFACING

WAIKANI BRIDGE TO KAPAULA BRIDGE PROJ. NO. 360B-01-95M


DISTRICT OF HANA ISLAND OF MAUI



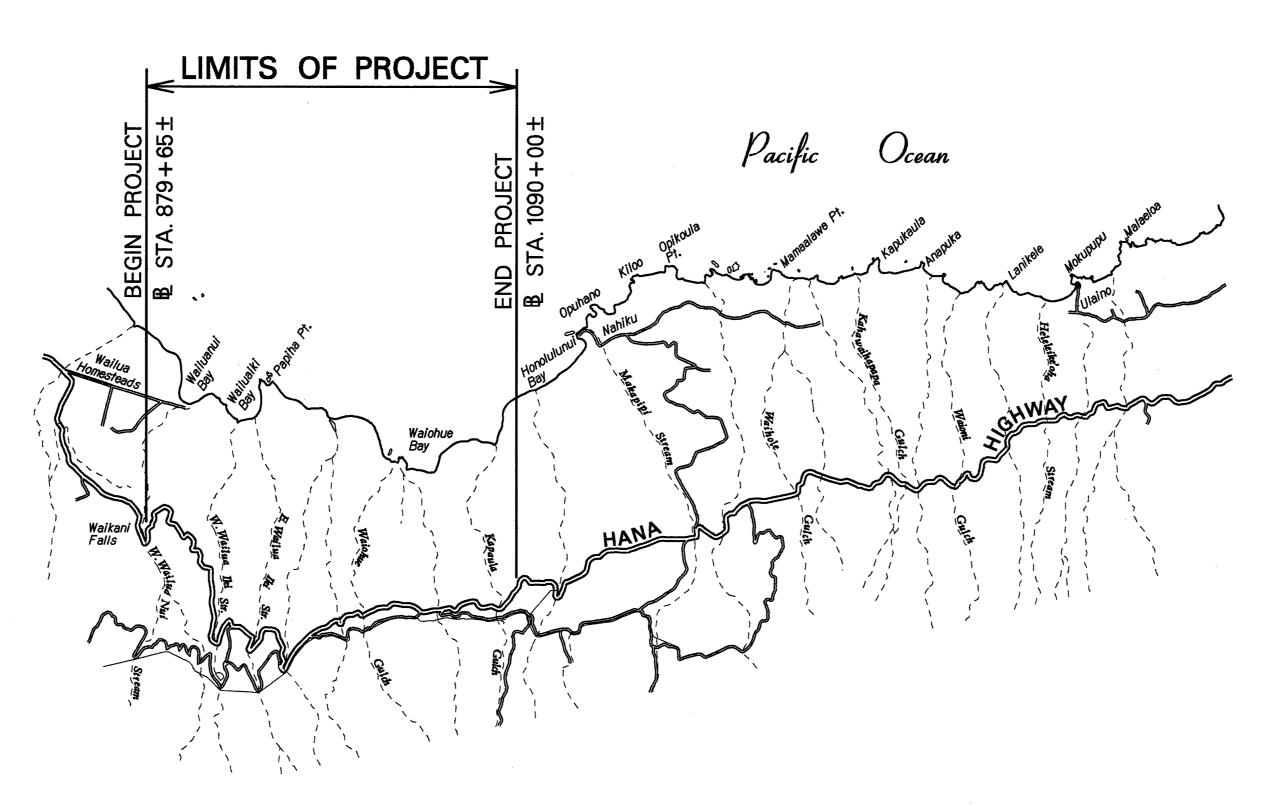


## LOCATION PLAN

GROSS LENGTH OF PROJECT..... 3.99 MILES NET LENGTH OF PROJECT..... 3.99 MILES

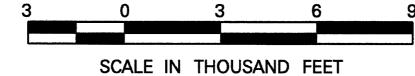

FED. ROAD DIST. NO. STATE PROJ. NO. FISCAL SHEET NO. SHEETS

HAWAII HAW. 360B-01-95M 1995 1 43

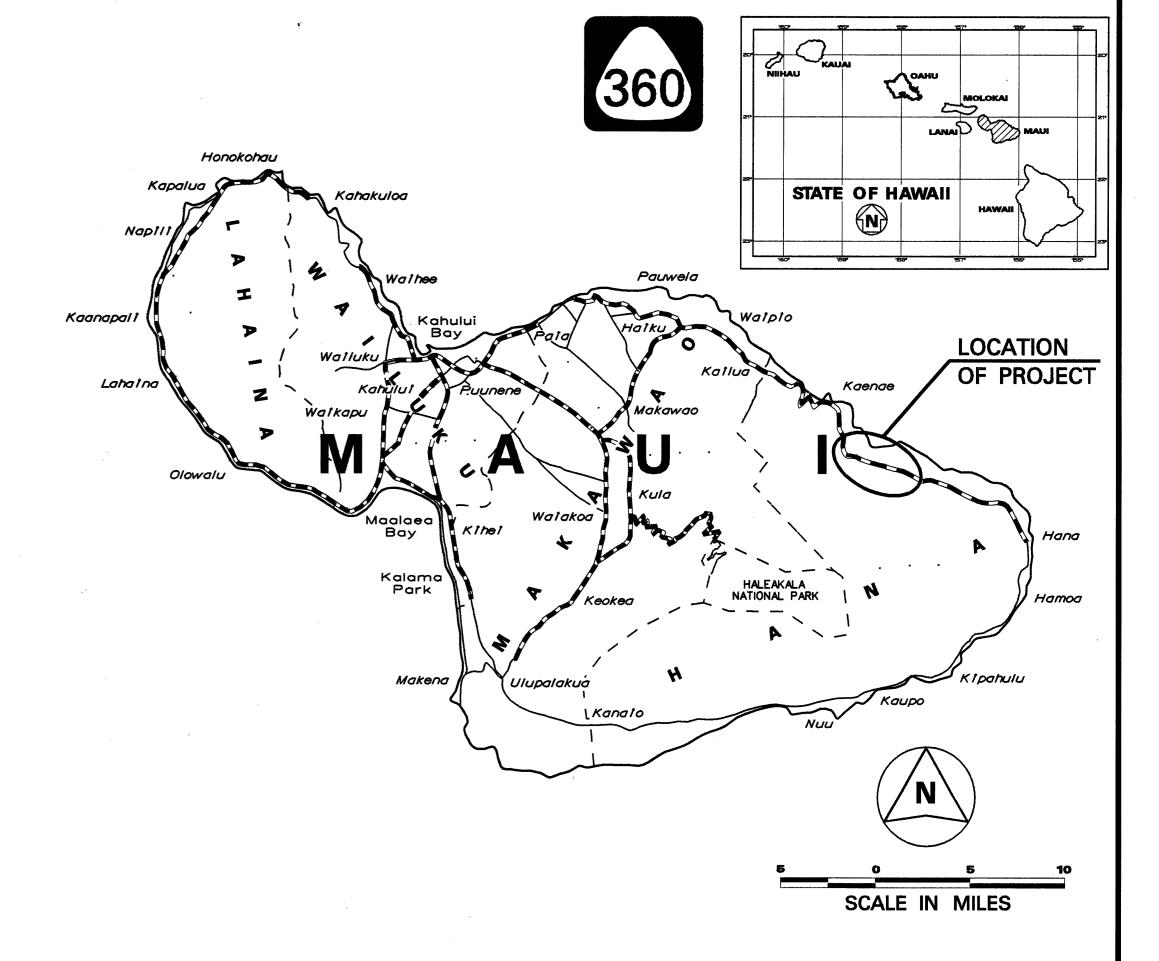

FEDERAL AID PROJECTS PREVIOUSLY CONSTRUCTED OR UNDER CONSTRUCTION

MILE POST 19.39 TO MILE POST 23.38

CHANGES MADE DURING CONSTRUCTION HAVE BEEN INCORPORATED ON THESE PLANS EXCEPT CHANGES IN THE ORIGINAL THEORETICAL QUANTITIES. FOR ACTUAL QUANTITIES, REFER TO PROJECT LEDGER AND/OR COMPUTATION BOOK.

RESIDENT ENGINEER DATE

DEPARTMENT OF TRANSPORTATION STATE OF HAWAII APPROVED:

DIR. OF TRANSPORTATION

1