	INDEX TO DRAWINGS
SHEET NO.	DESCRIPTION
1	TITLE SHEET
2	STANDARD PLANS SUMMARY
3	GENERAL NOTES AND LEGEND
4	NPDES NOTES
5	TYPICAL SECTIONS AND DETAILS
6 – 9	GUARDRAIL DETAILS
10	DRAINAGE DETAILS
11 – 28	ROADWAY PLANS
29	SIGN PANEL LAYOUT & NOTES
30	PAVEMENT MARKING LEGEND, DETAILS & NOTES
31 – 48	SIGNING AND PAVEMENT MARKING PLANS
49 - 50	MISCELLANEOUS SUMMARIES
51	DRAINAGE SUMMARY

STATE OF HAWAII

DEPARTMENT OF TRANSPORTATION

HIGHWAYS DIVISION HONOLULU, HAWAII "AS-BUILT"


PLANS FOR

HANA HIGHWAY RESURFACING


VALLEY ISLE CEMETERY TO HUELO FEDERAL-AID PROJECT NO. STP-0900(39)


> DISTRICT OF MAKAWAO ISLAND OF MAUI


> > LENGTH OF PROJECT.....6.95 MILES

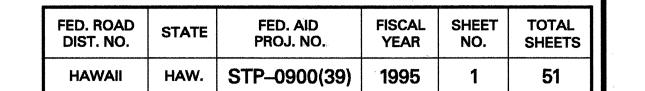



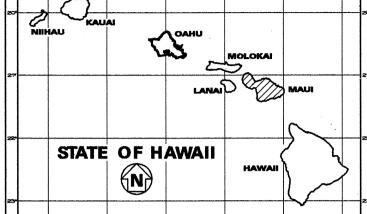

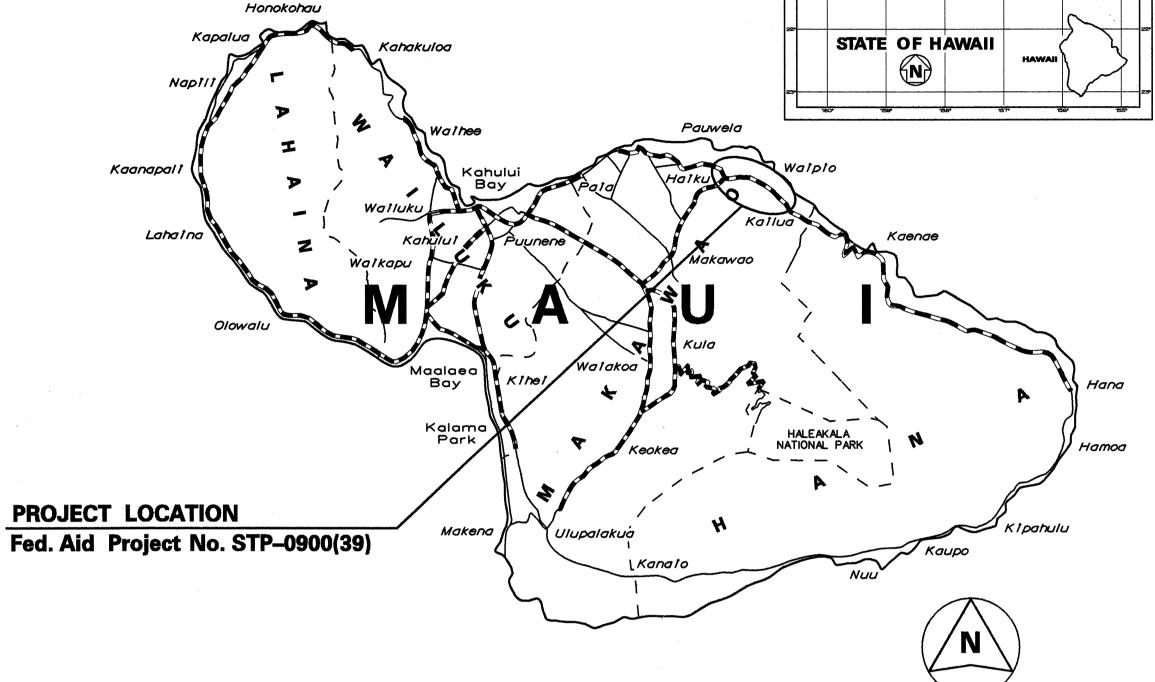

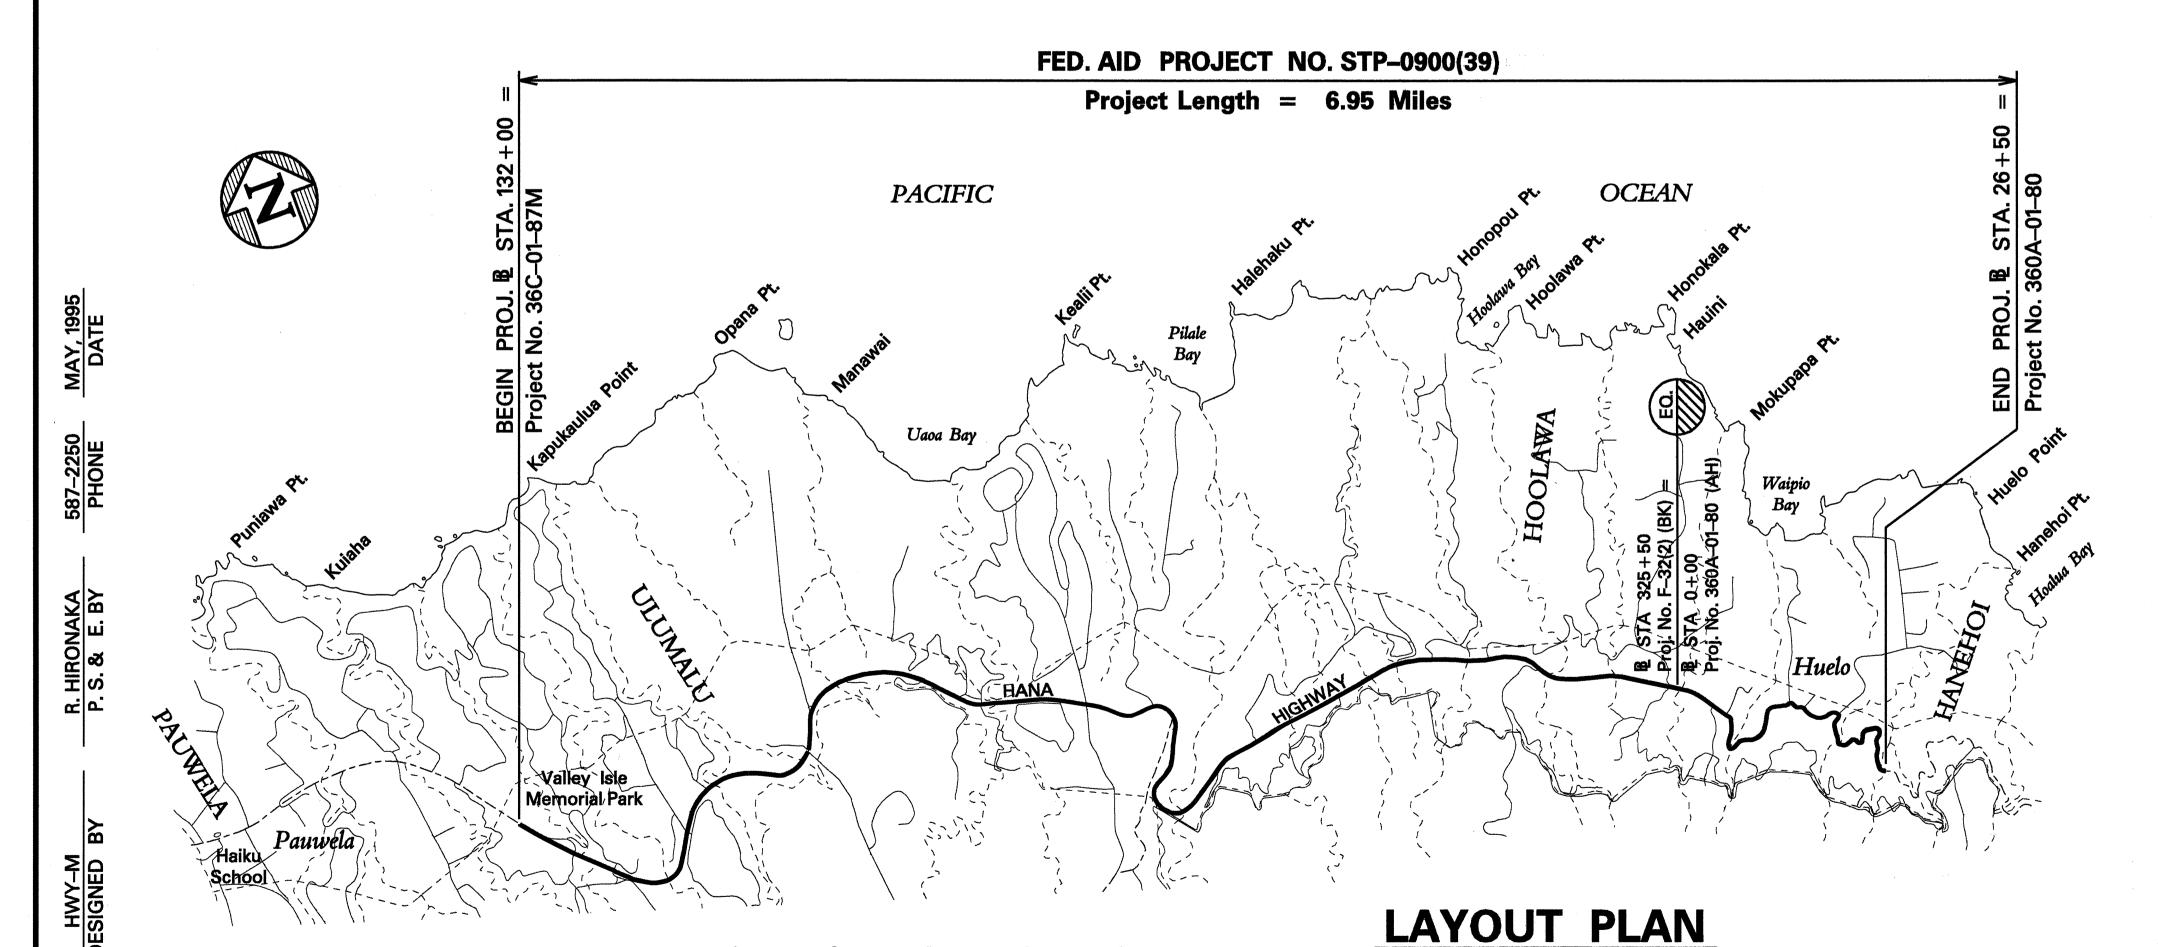

SCALE IN THOUSAND FEET

FEDERAL AID PROJECTS PREVIOUSLY CONSTRUCTED OR UNDER CONSTRUCTION

> ROUTE 36 - MILE POST 12.93 TO MILE POST 16.23 ROUTE 360 - MILE POST 0.00 TO MILE POST 3.65

DESIGN DESIGNATION

AD	Γ (1995)4,980
AD	(2005)
DH	/ 570
D	
T	4.0%
V	

CHANGES MADE DURING CONSTRUCTION HAVE BEEN INCORPORATED ON THESE PLANS EXCEPT CHANGES IN THE ORIGINAL THEORETICAL QUANTITIES. FOR ACTUAL QUANTITIES, REFER TO PROJECT LEDGER AND/OR COMPUTATION BOOK.

RESIDENT ENGINEER

DEPARTMENT OF TRANSPORTATION STATE OF HAWAII			
APPROVED:	7/7/95		

DIR. OF TRANSPORTATION

DATE