

STATE OF HAWAII

DEPARTMENT OF TRANSPORTATION


HIGHWAYS DIVISION HONOLULU, HAWAII "AS BUILT"

PLANS FOR

HANA HIGHWAY STORM DAMAGE REPAIR


VICINITY OF KEAWA PLACE PROJECT NO. 360B-02-93M

DISTRICT OF HANA

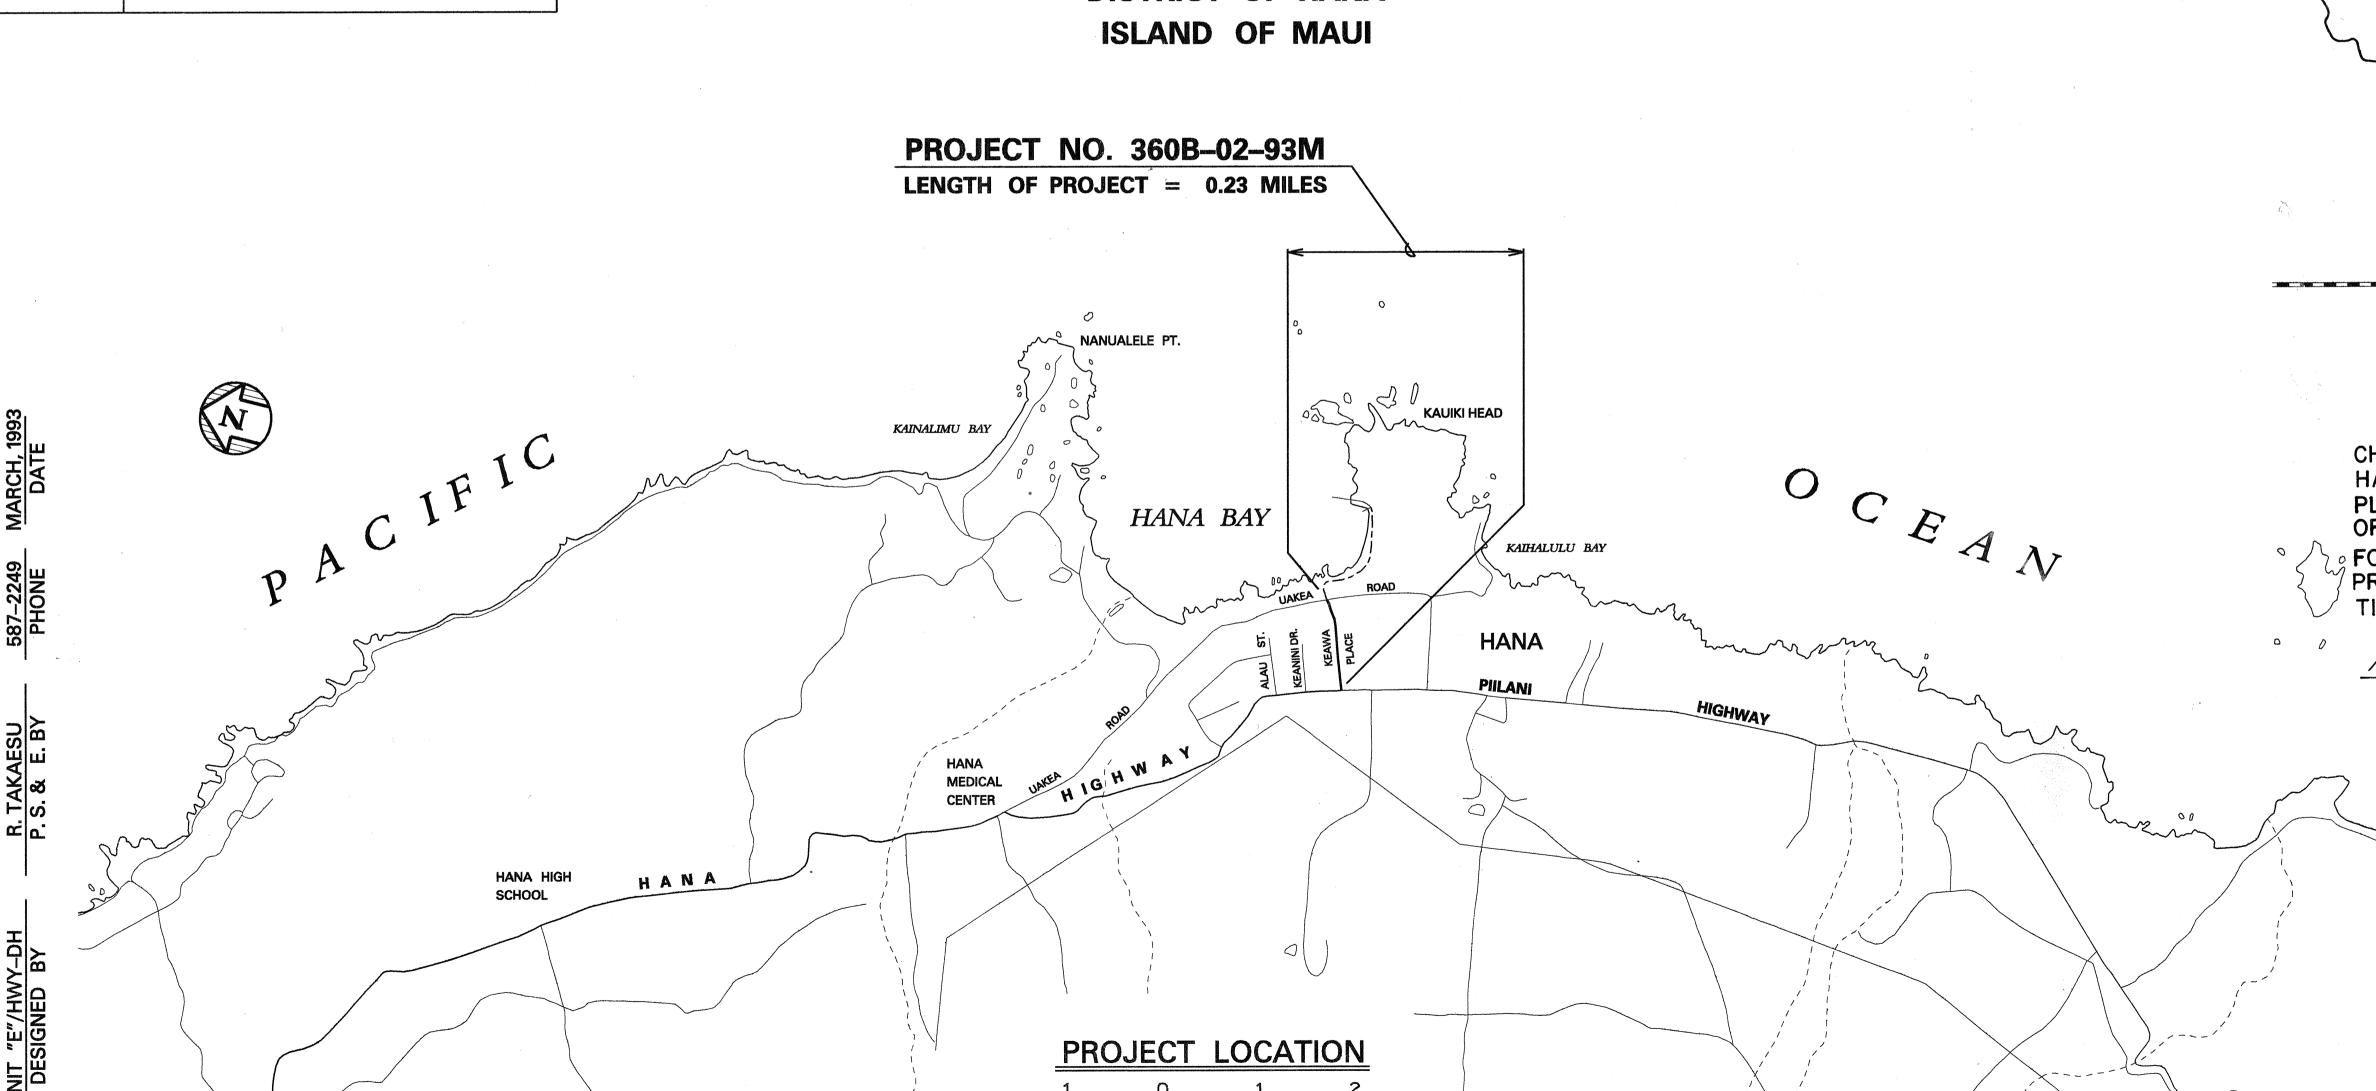

SCALE IN THOUSAND FEET

FED. ROAD DIST. NO. 360B-02-93M

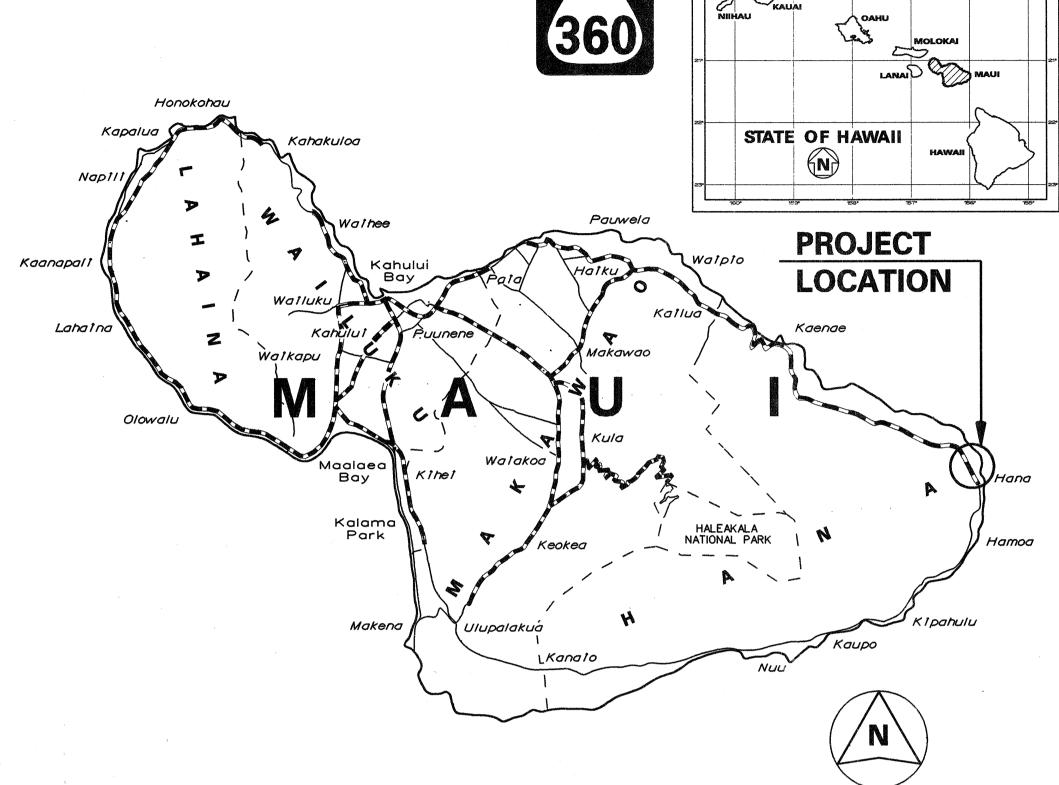

FEDERAL AID PROJECTS PREVIOUSLY CONSTRUCTED OR UNDER CONSTRUCTION

MILE POST 34.42 TO MILE POST 34.65

CHANGES MADE DURING CONSTRUCTION HAVE BEEN INCORPORATED ON THESE PLANS EXCEPT CHANGES IN THE ORIGINAL THEORETICAL QUANTITIES. FOR ACTUAL QUANTITIES, REFER TO PROJECT LEDGER AND/OR COMPUTA-TION BOOK.

DEPARTMENT OF TRANSPORTATION STATE OF HAWAII **APPROVED:** 5/19/93

THE DIR. OF TRANSPORTATION