


FED. ROAD DIST. NO.	STATE	PROJ. NO.	FISCAL YEAR	SHEET NO.	TOTAL SHEETS
HAWAII	HAW.	360AB-01-92	1992	C.O. 19	37

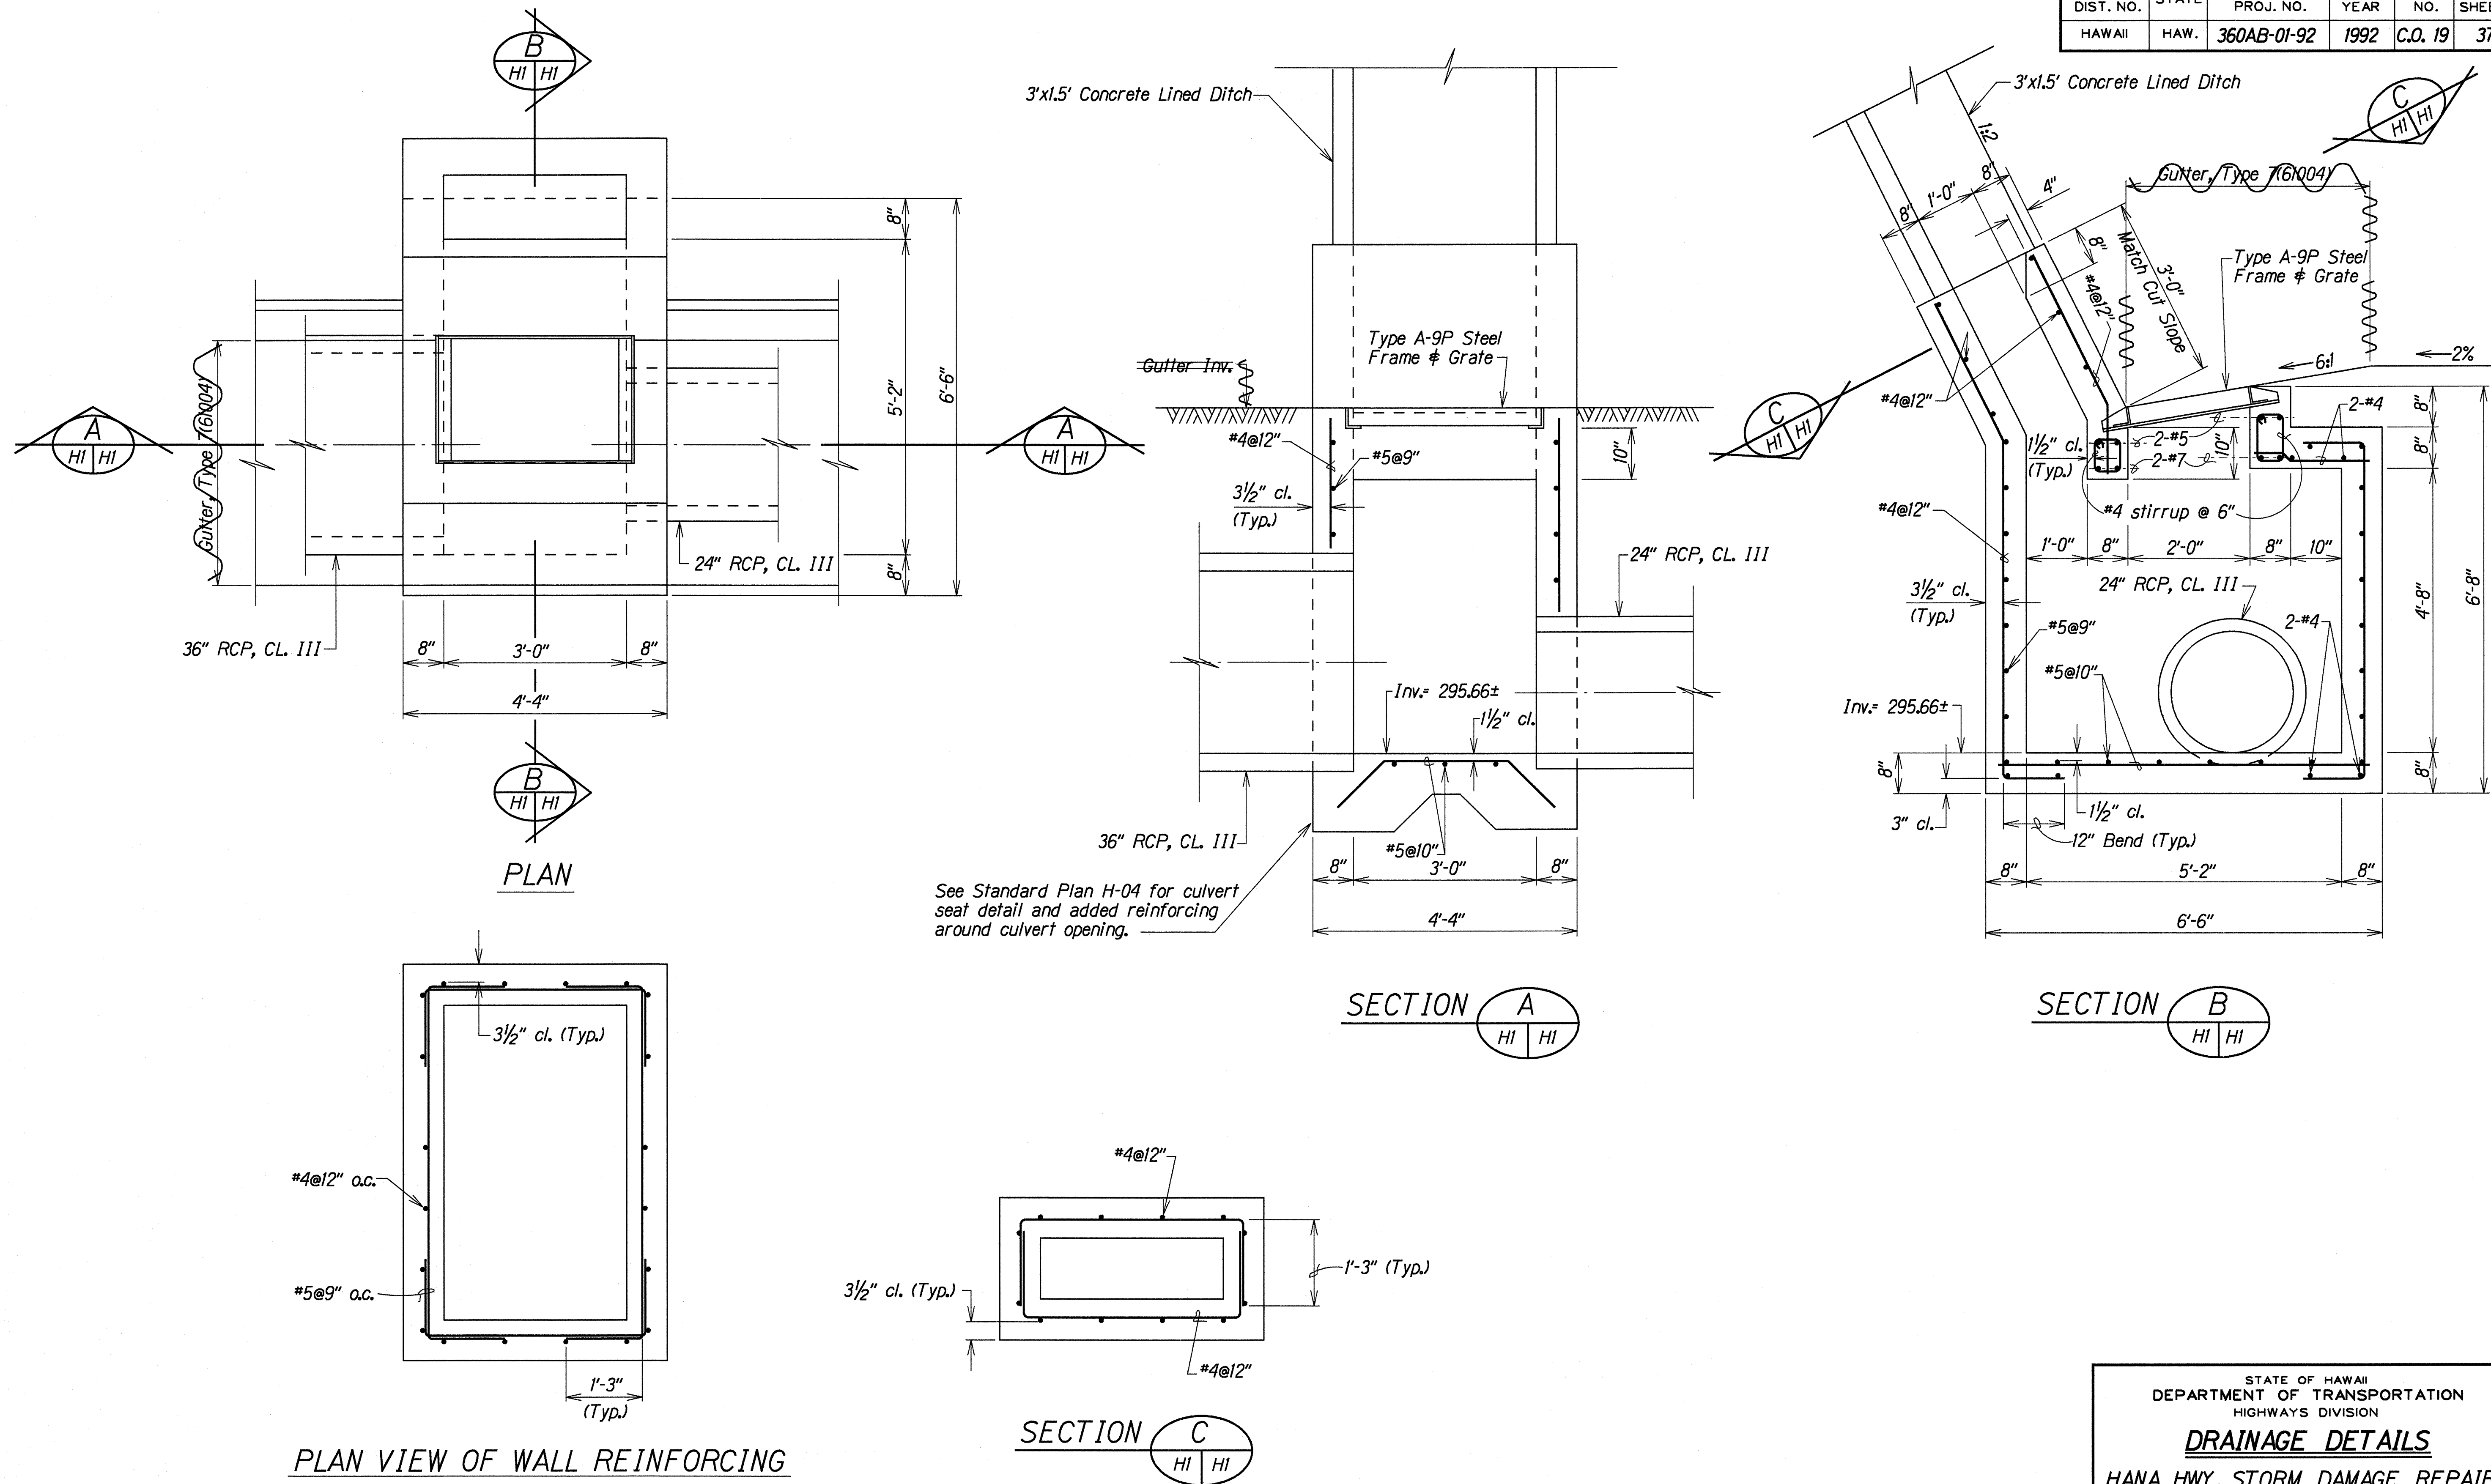

DETAIL OF TYPE C GRATED DROP INLET AT & STA. 699+30± RT.

6/30/97	Gutter Type 7(61004) not constructed
6/4/93	Added Detail of Type C Grated Drop Inlet.
DATE	REVISION


STATE OF HAWAII
DEPARTMENT OF TRANSPORTATION
HIGHWAYS DIVISION
DRAINAGE DETAILS
HANA HWY. STORM DAMAGE REPAIRS
Huelo Towards Nahiku
PROJ. NO. 360AB-01-92

Scale: 3/4" = 1'-0"
Date: June, 1993
SHEET No. HI OF 1 SHEETS


"AS-BUILT"

C.O. 19


FED. ROAD DIST. NO.	STATE	PROJ. NO.	FISCAL YEAR	SHEET NO.	TOTAL SHEETS
HAWAII	HAW.	360AB-01-92	1992	C0 19 S-1	37

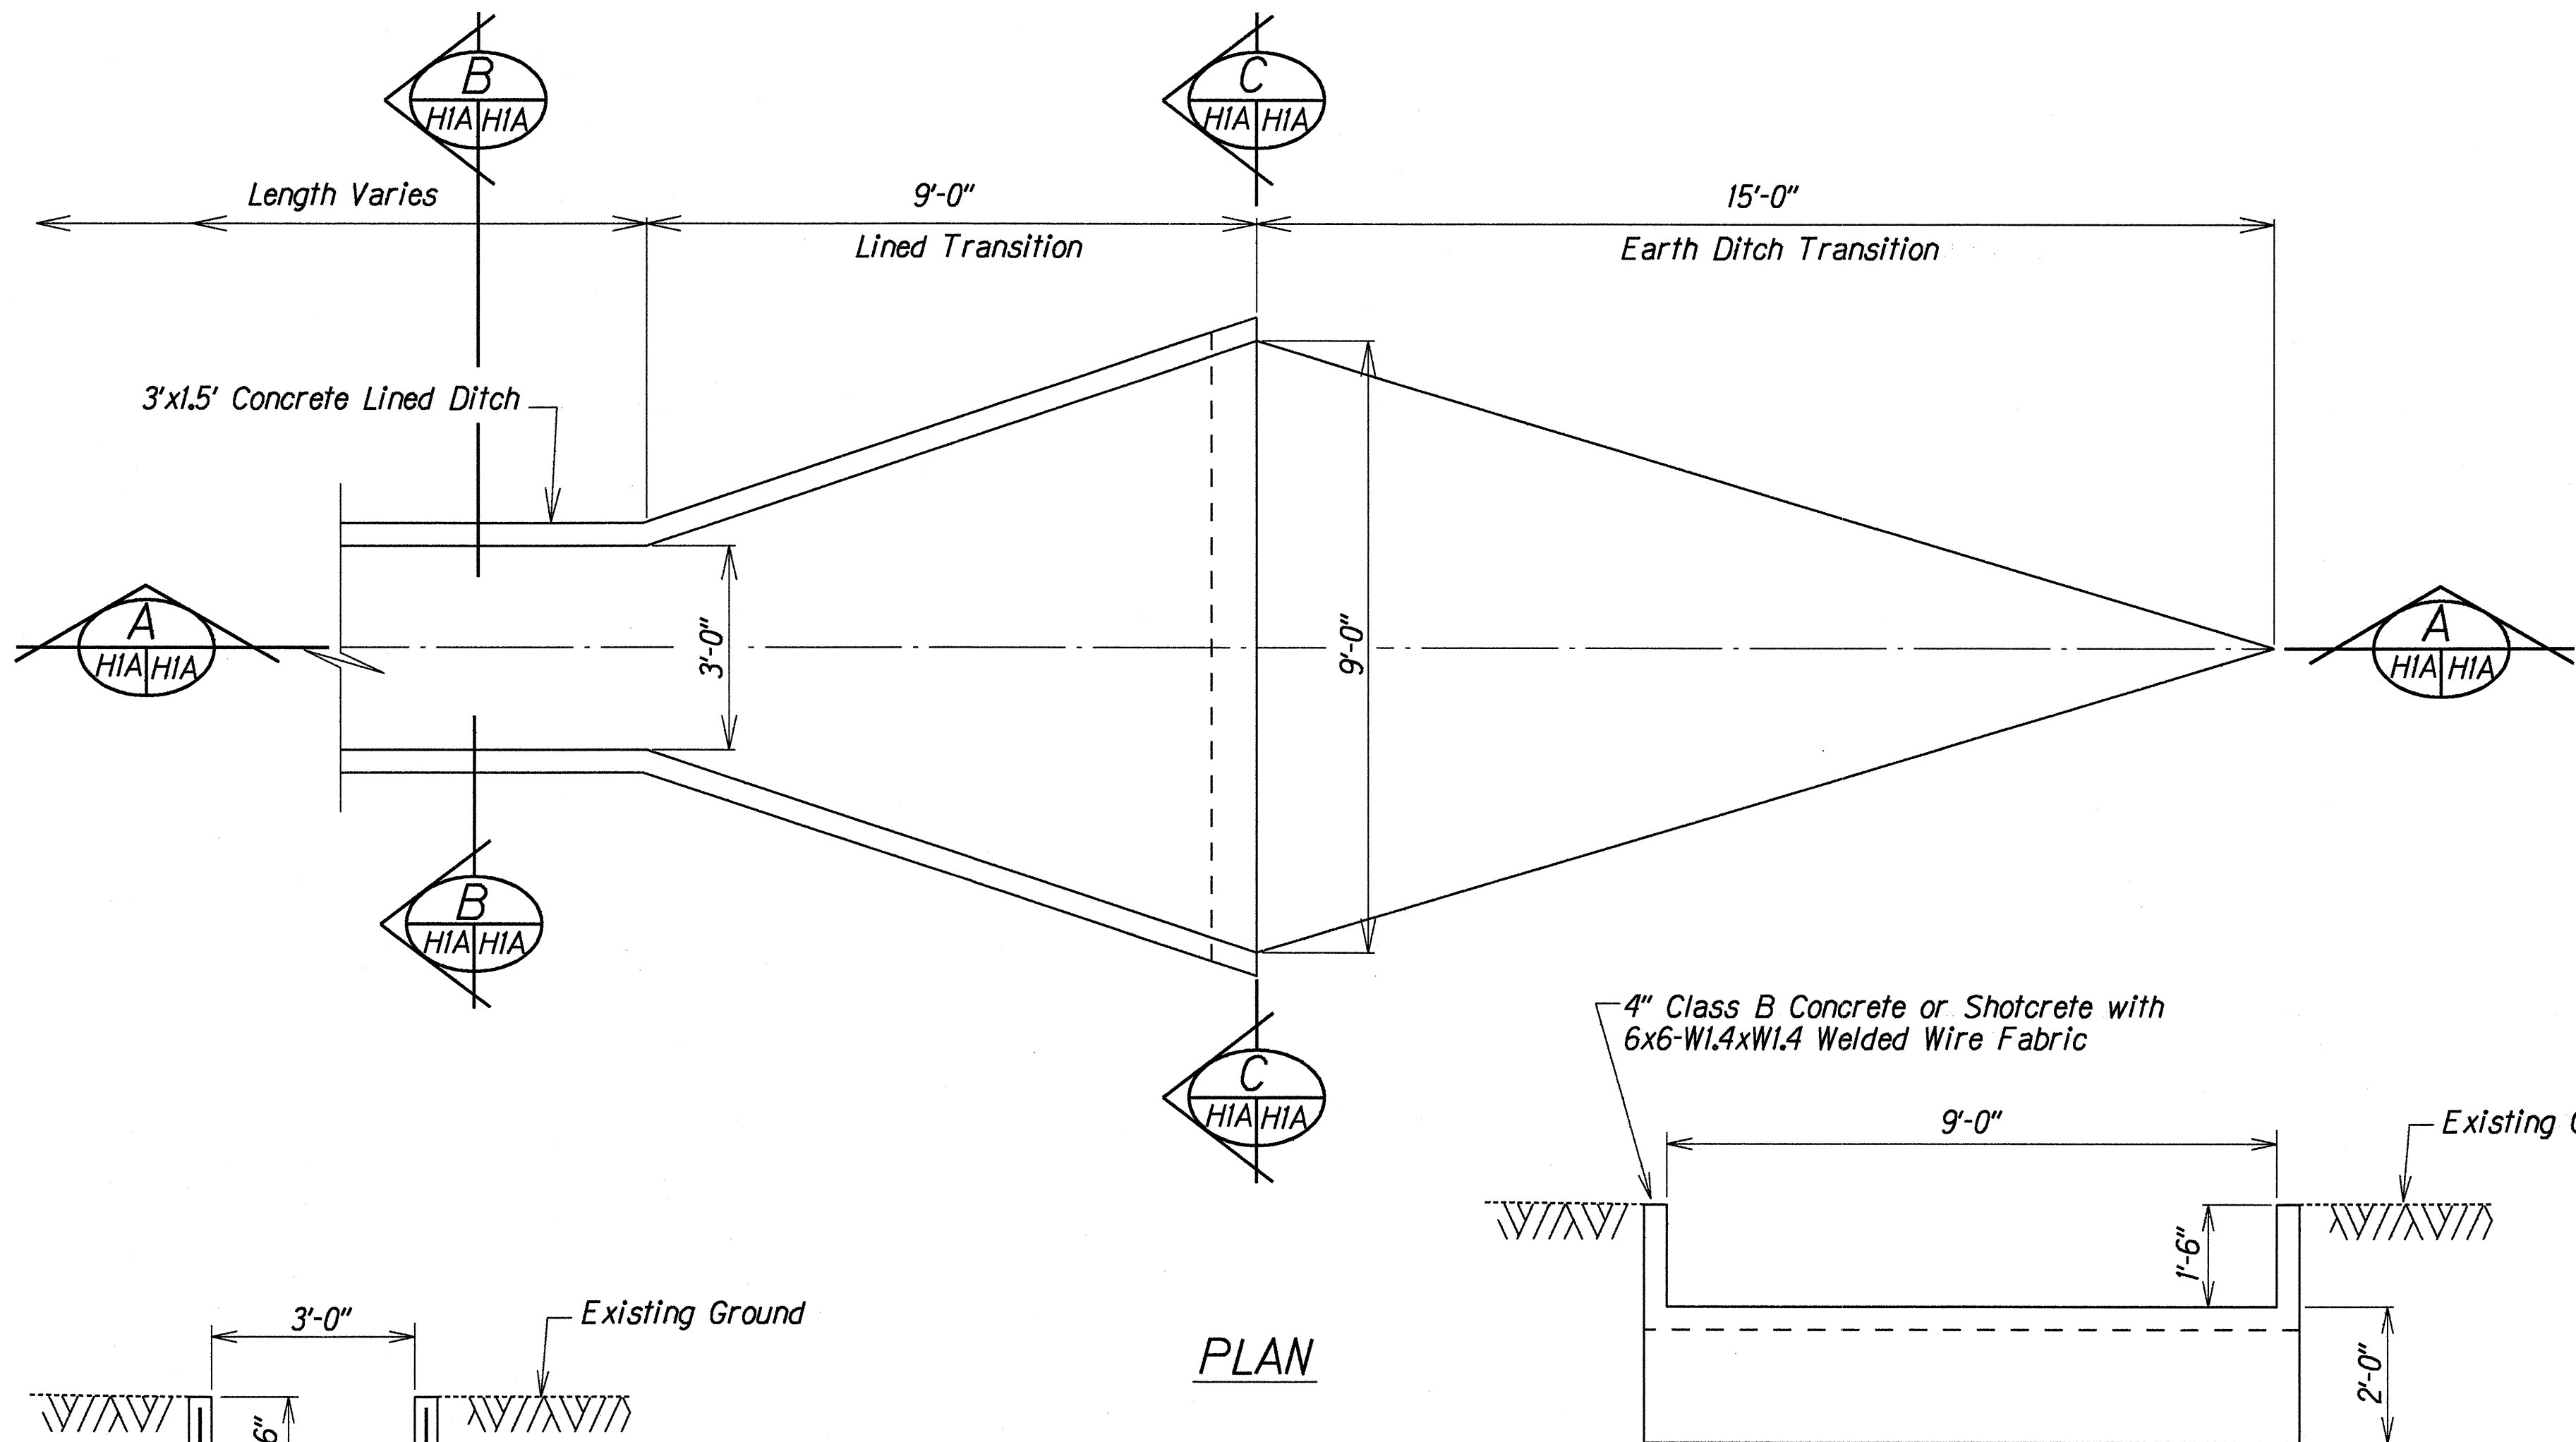


PLAN

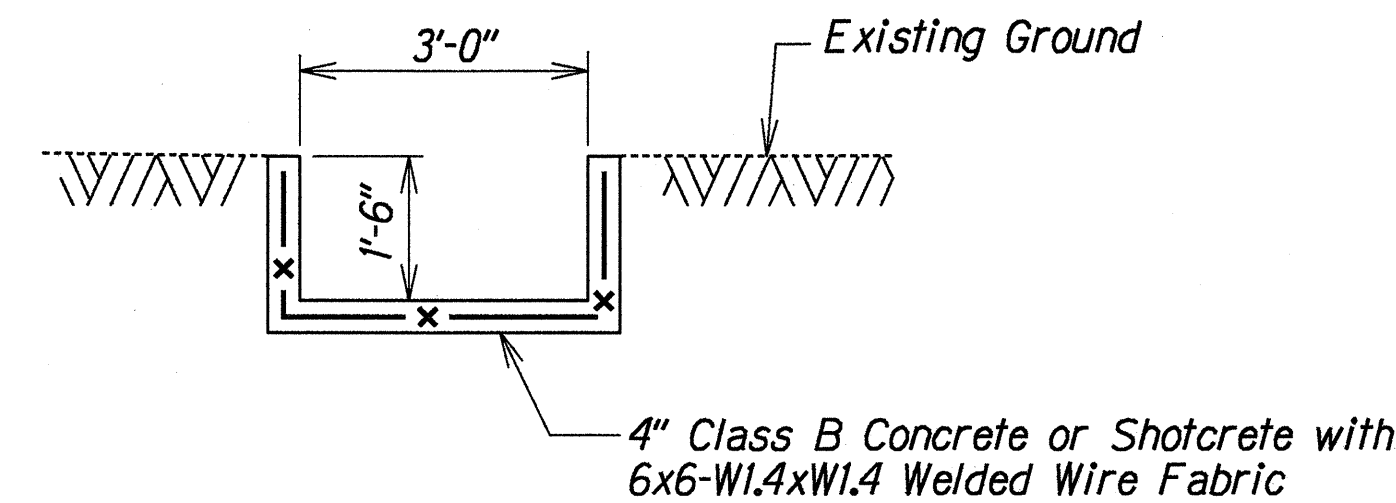

SECTION B
HIA HIA

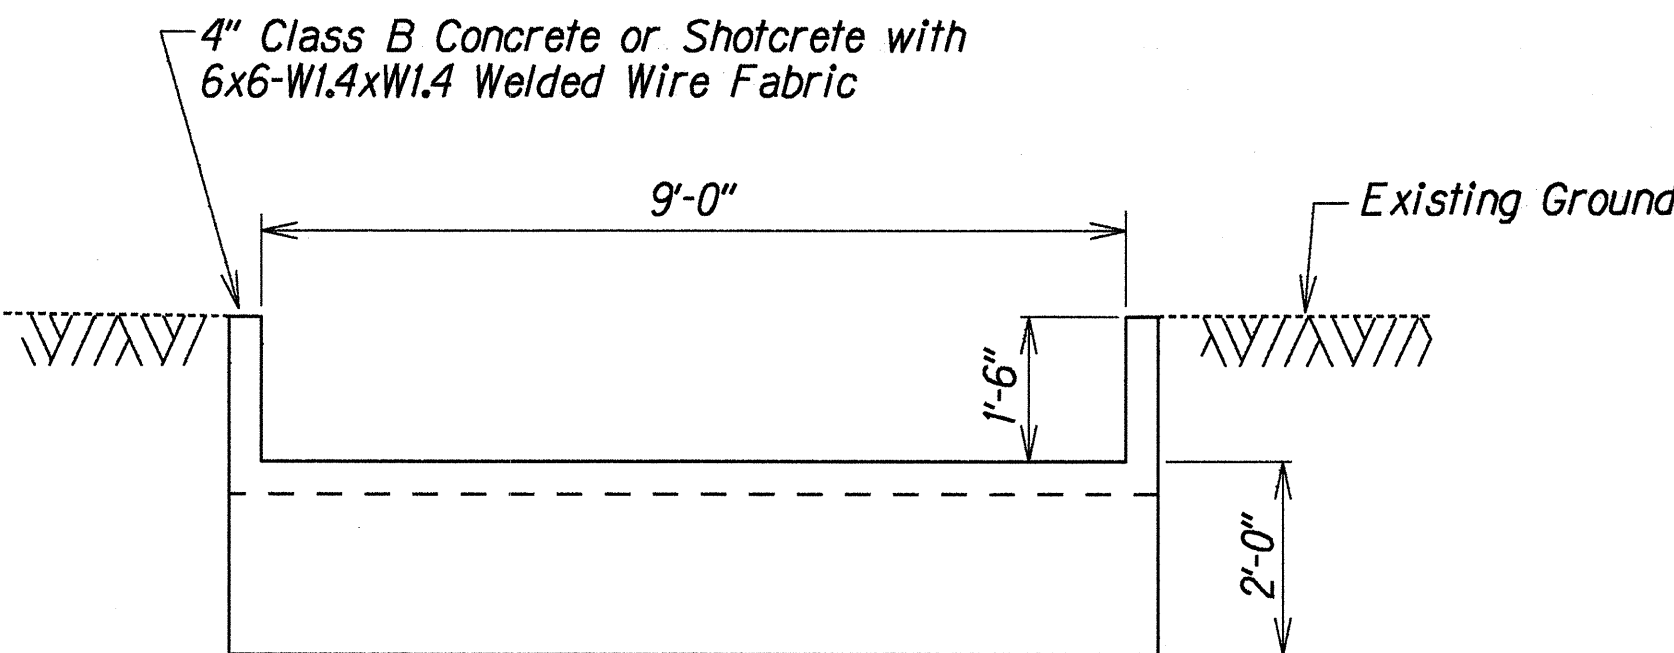


SECTION C
HIA HIA

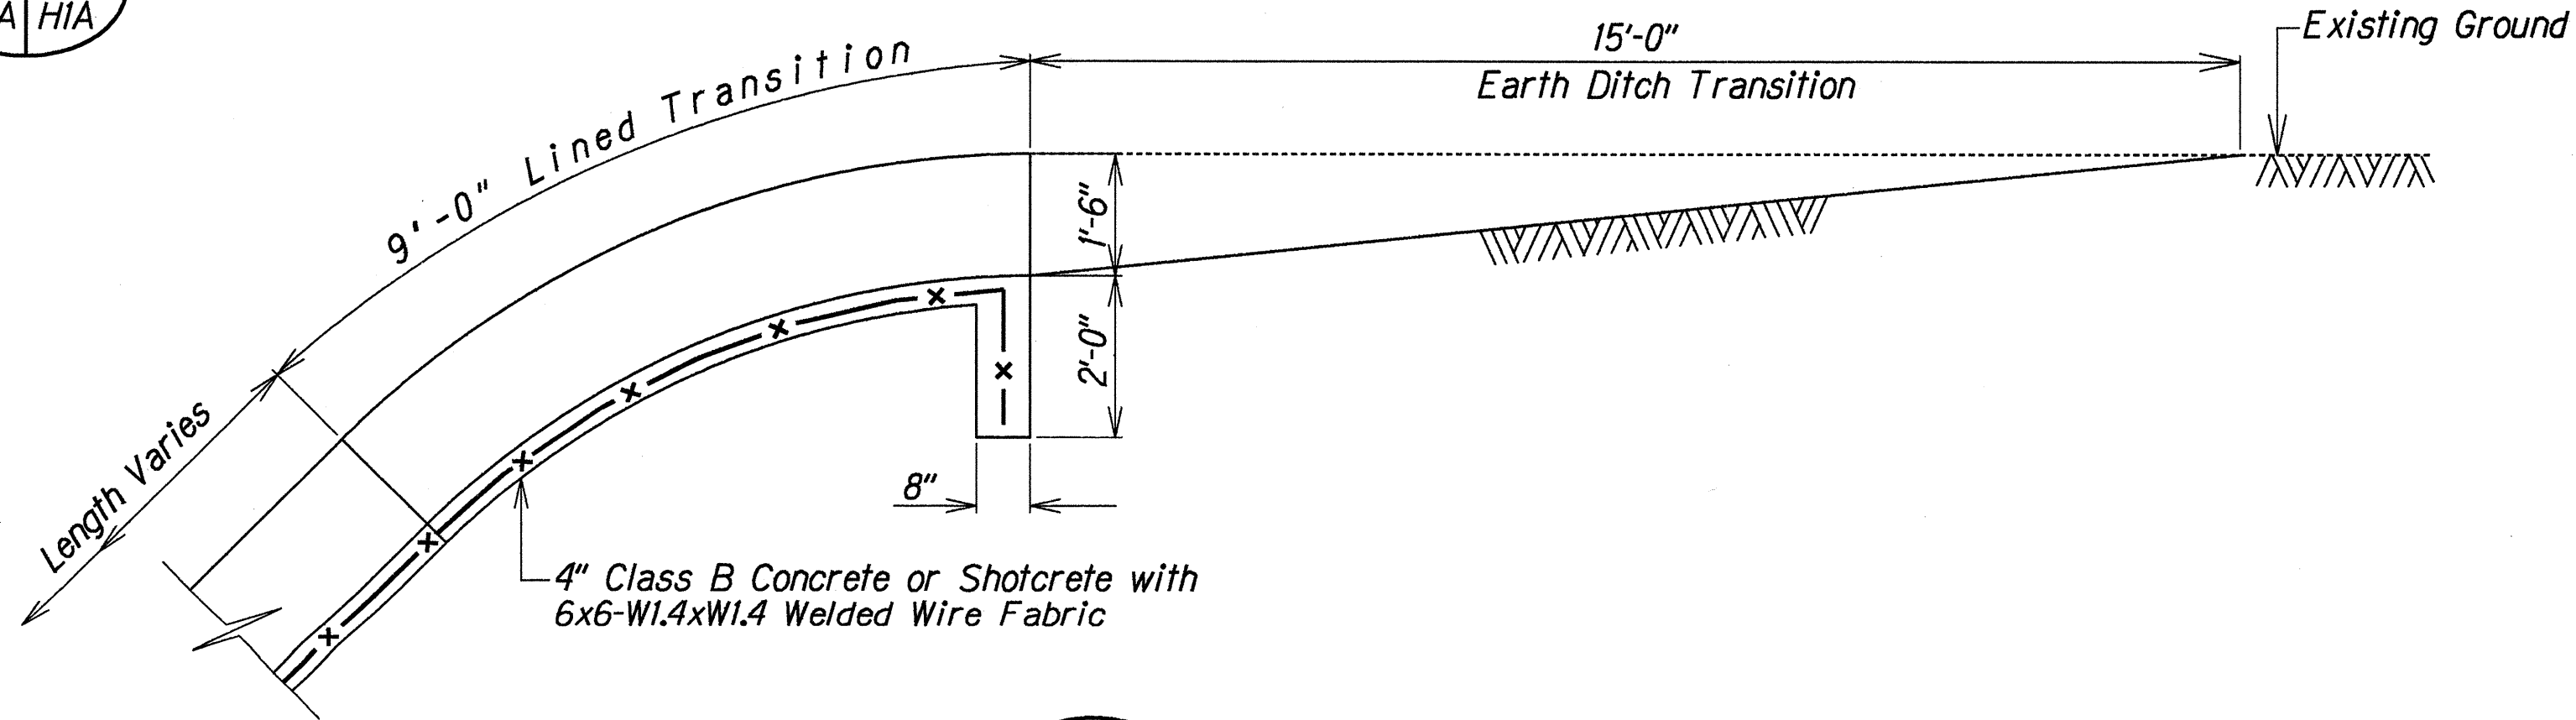


SECTION A
HIA HIA

DETAIL OF 3'-0" x 1'-6" CONCRETE LINED DITCH AND TRANSITION AT $\pm$ STA. 699+30 RT.


Scale: $\frac{1}{2}$ "=1'-0"

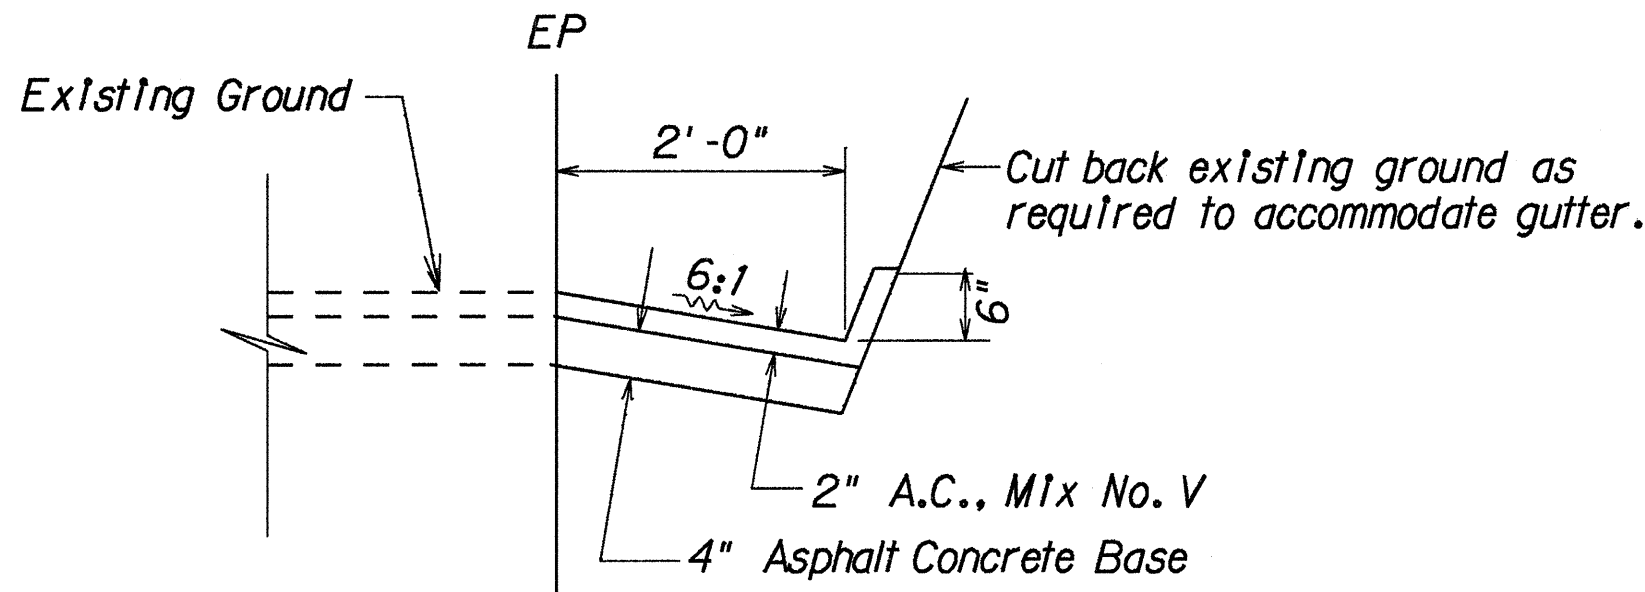

GUTTER TYPE 7(61002) AT MILE POST 20.9

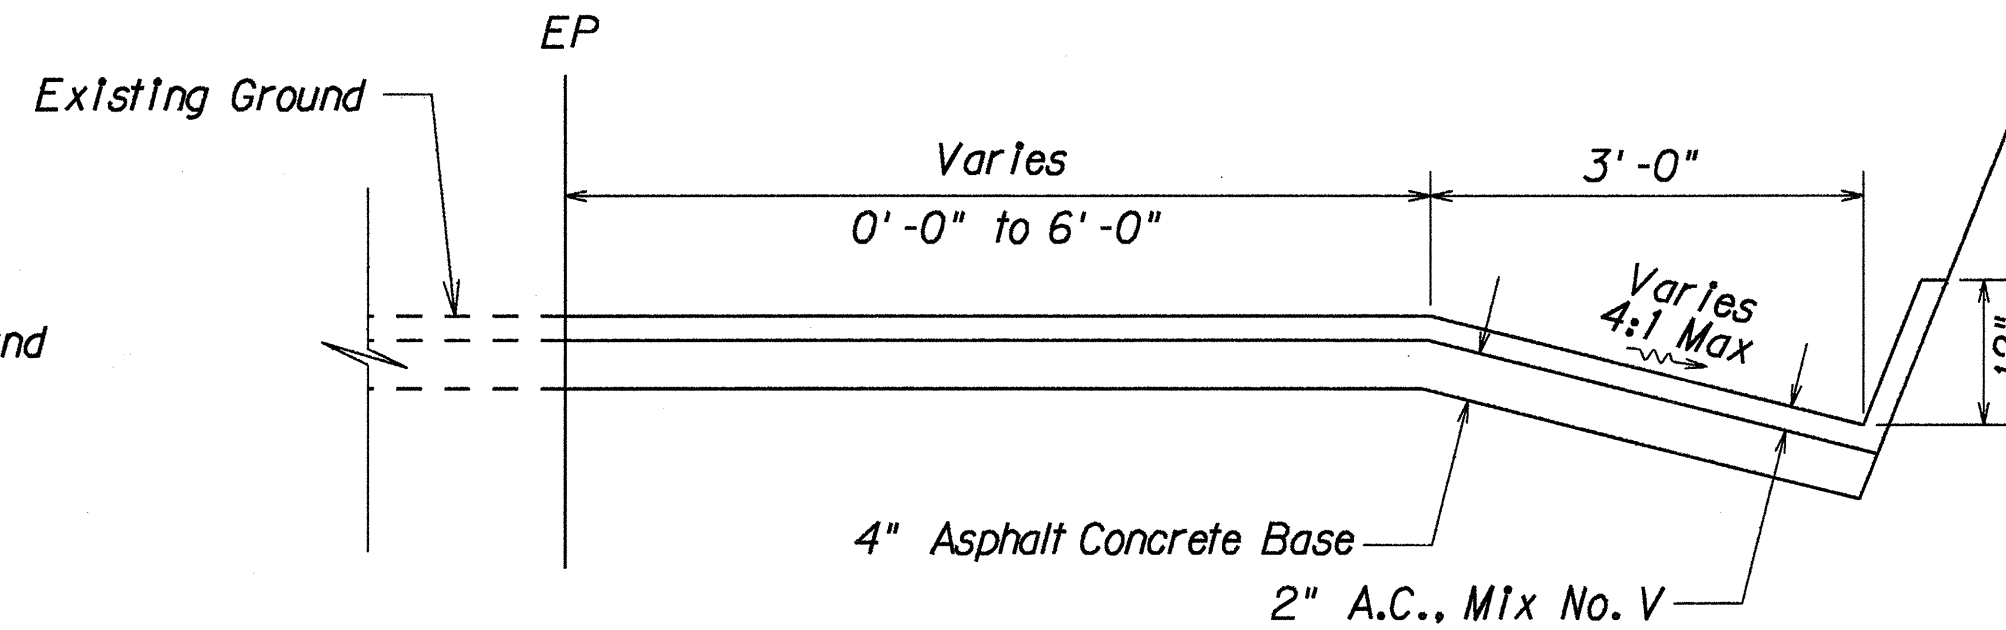

GUTTER TYPE 7(61003) AT MILE POST 8.15

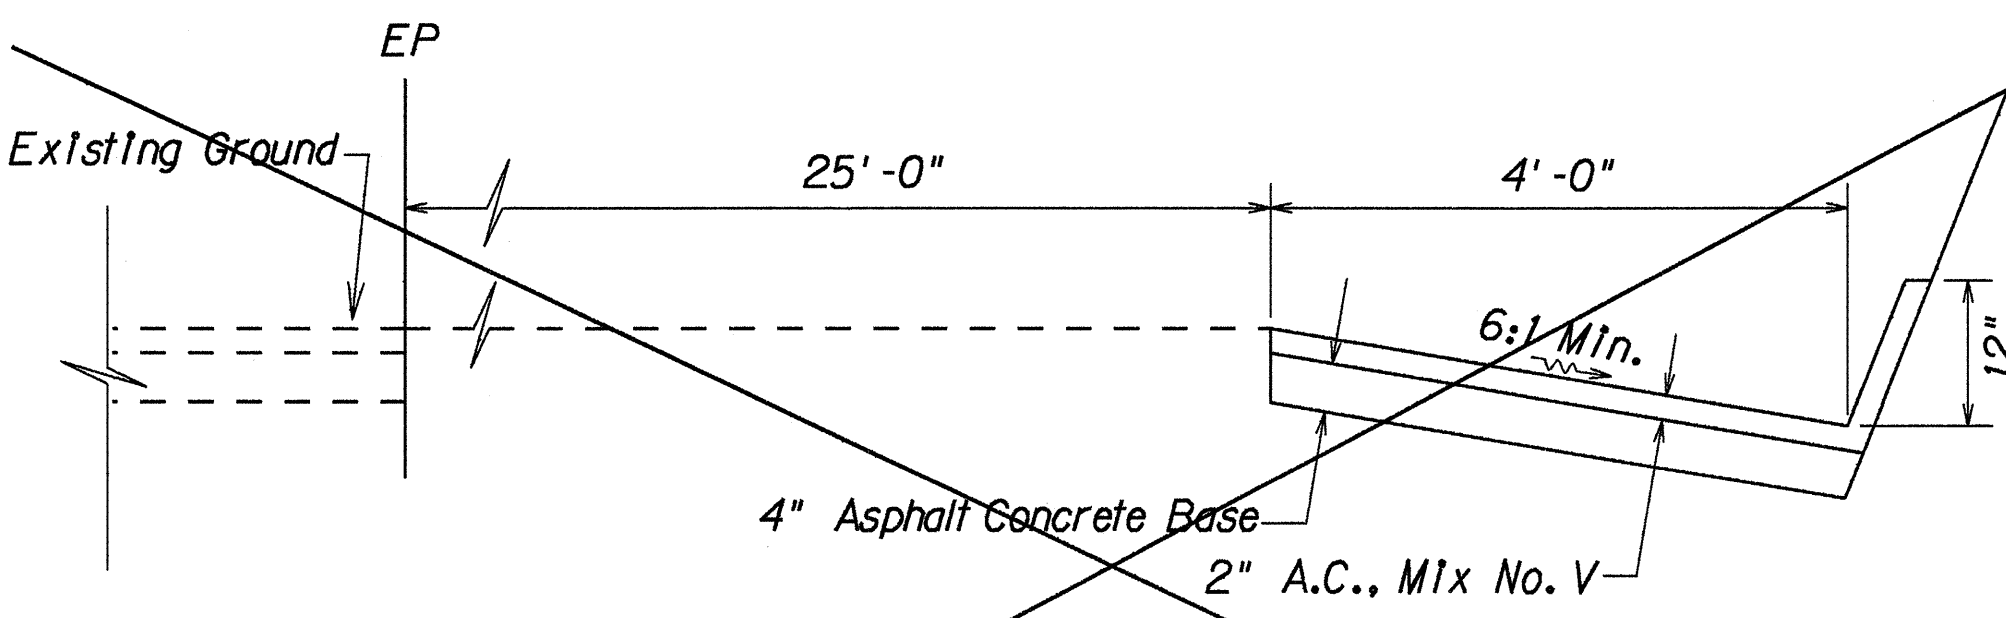

GUTTER, TYPE 7(61004) AT MILE POST 16.13

DETAILS OF GUTTERS, TYPE 7

Scale: $\frac{3}{4}$ "=1'-0"

ORIGINAL PLAN	DATE
DESIGNED BY	DATE
CHECKED BY	DATE
NOTED BY	DATE
QUANTITIES BY	DATE
CHECKED BY	DATE



6/30/97	Gutter Type 7(61004) not constructed
6/4/93	Added Details of Concrete Lined Drainage Ditch.
DATE	REVISION

STATE OF HAWAII DEPARTMENT OF TRANSPORTATION HIGHWAYS DIVISION
DRAINAGE DETAILS
HANA HWY, STORM DAMAGE REPAIRS Huelo Towards Nāhiku
PROJ. NO. 360AB-01-92
Scale: As Noted Date: June, 1993
SHEET No. HIA OF 1 SHEETS


"AS-BUILT"

C.O. 19 S-1


FED. ROAD DIST. NO.	STATE	PROJ. NO.	FISCAL YEAR	SHEET NO.	TOTAL SHEETS
HAWAII	HAW.	360AB-01-92	1993	CO 19 S-2	37

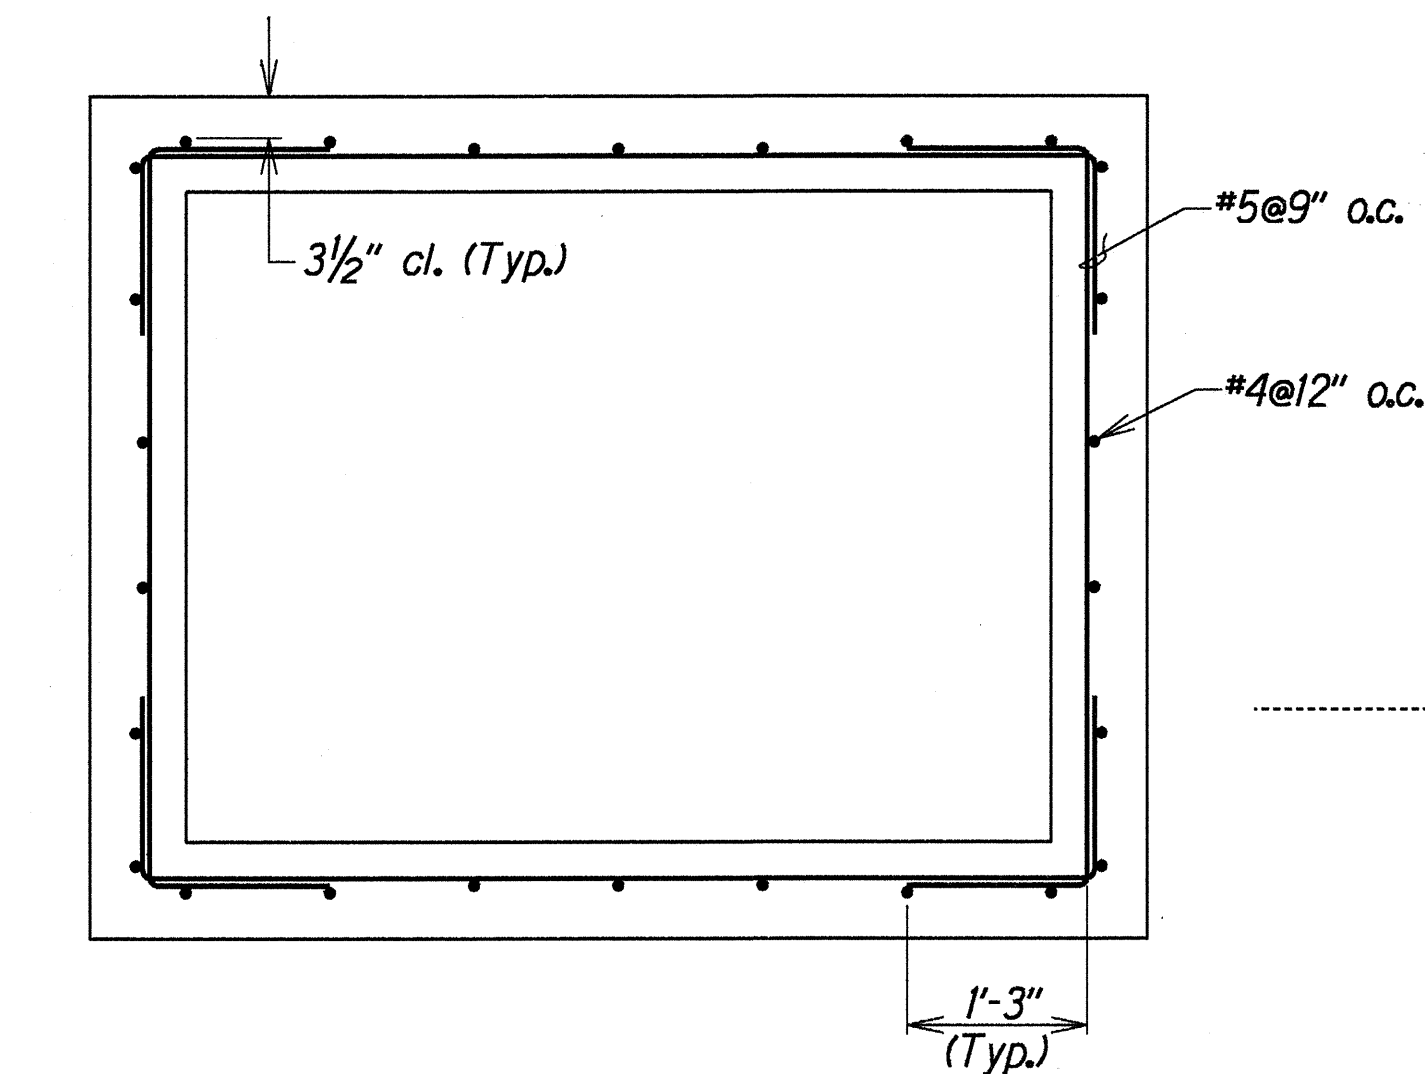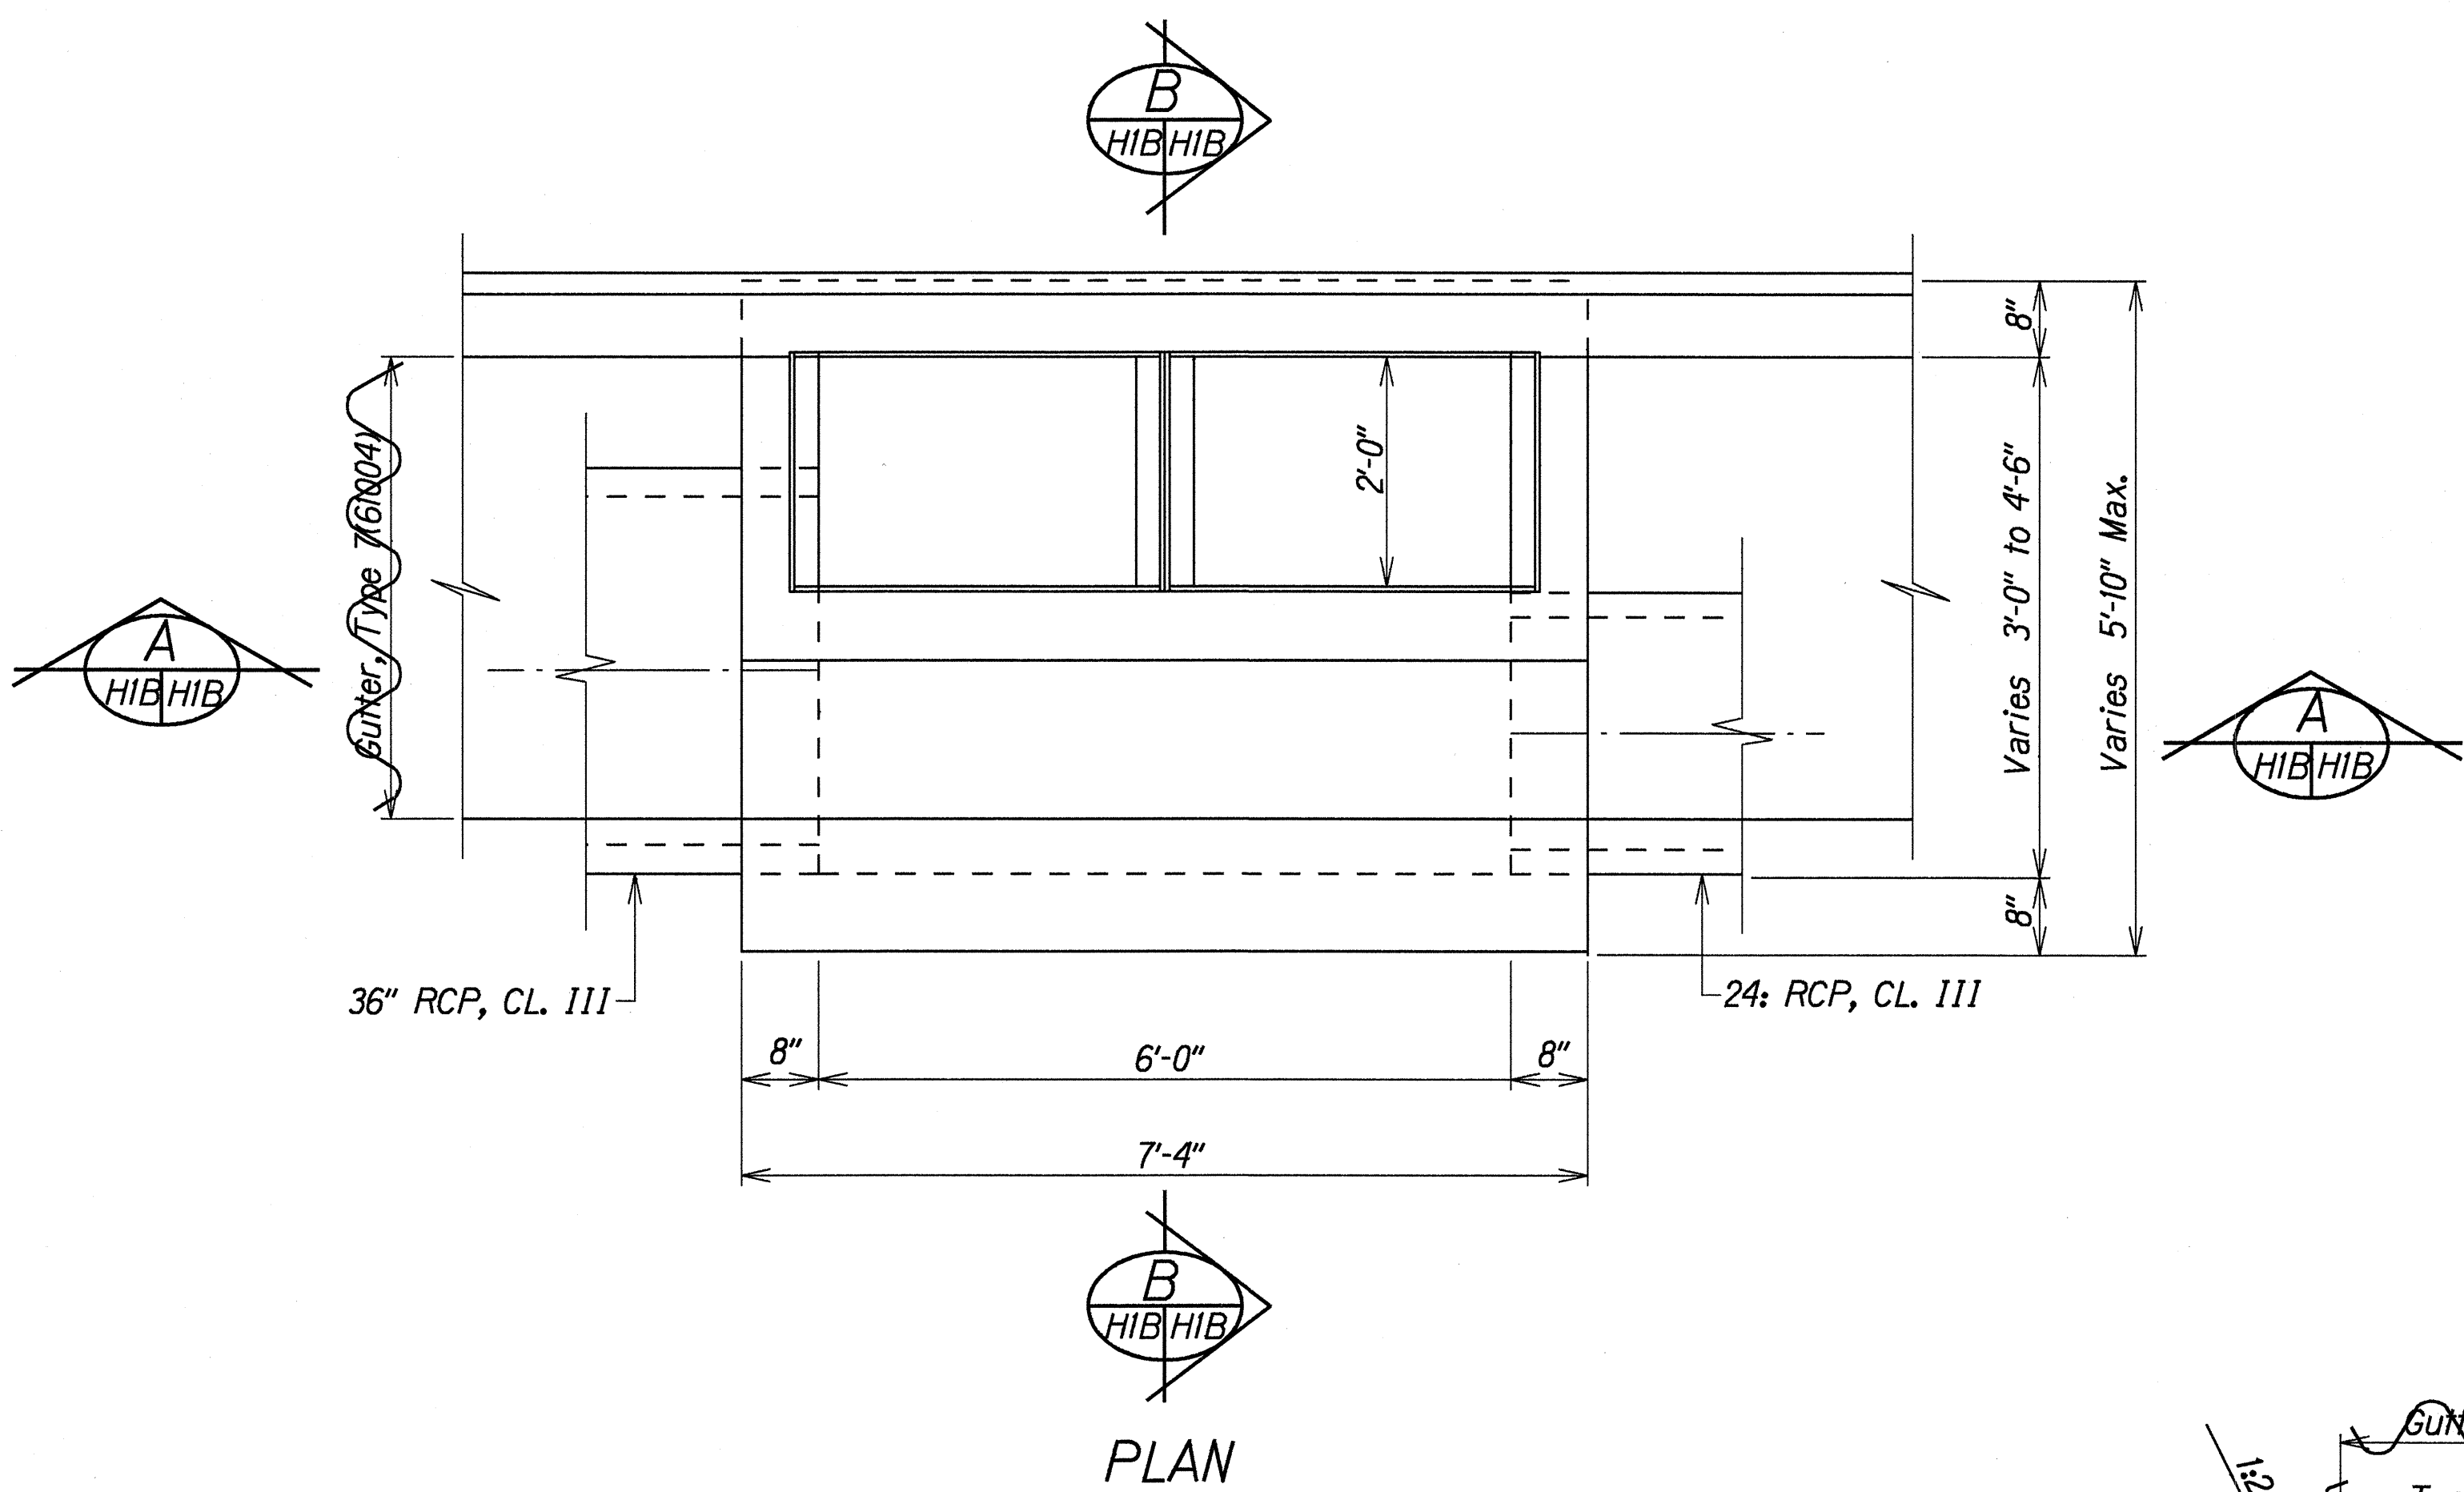

PLAN VIEW OF WALL REINFORCING

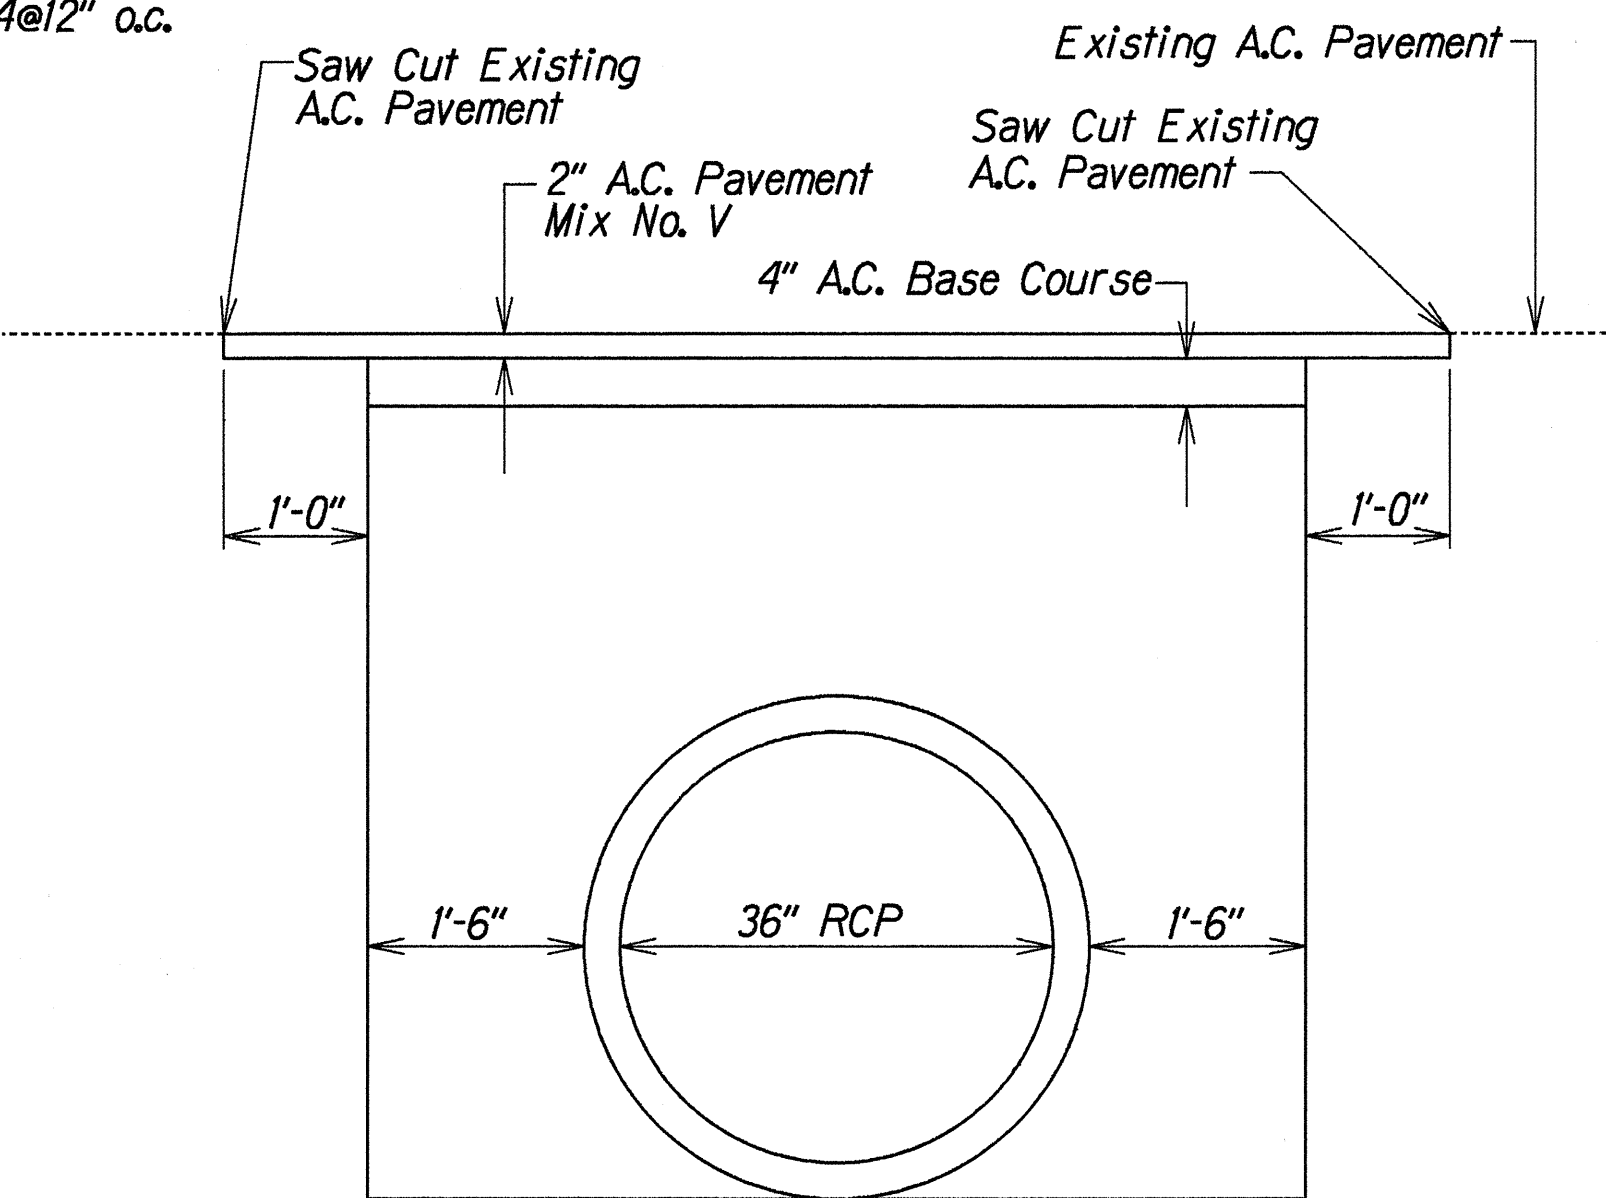


TRENCH DETAIL AT STA. 701+75

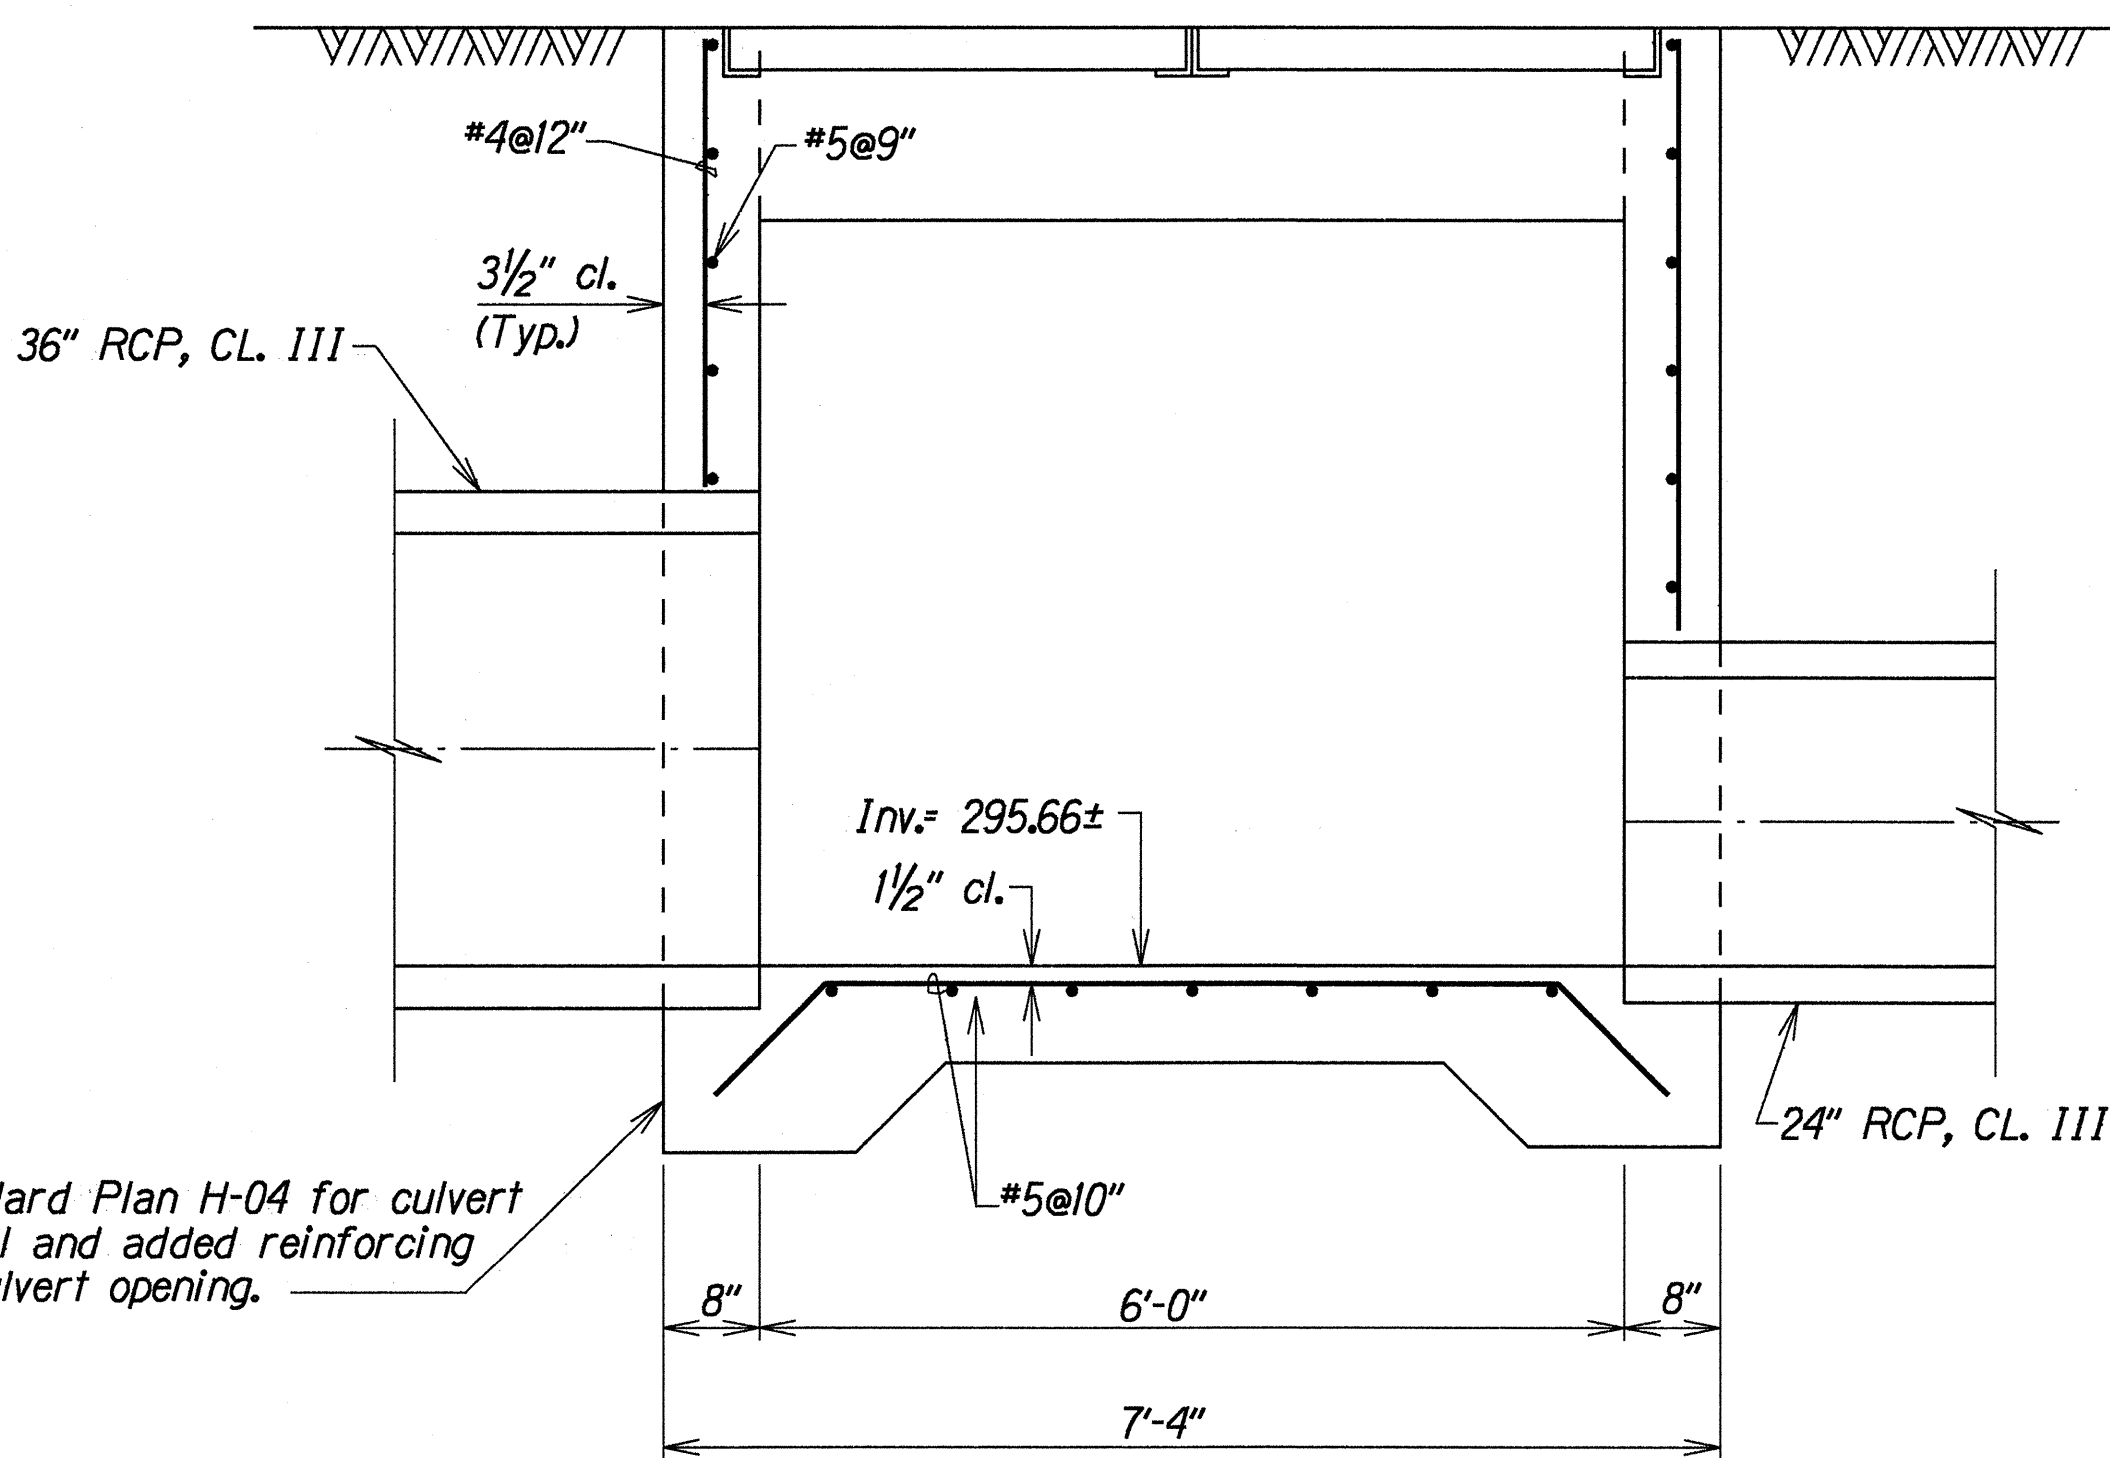


SECTION A
HIB HIB

TYPICAL DETAIL OF TYPE 2 GRATED DROP INLET

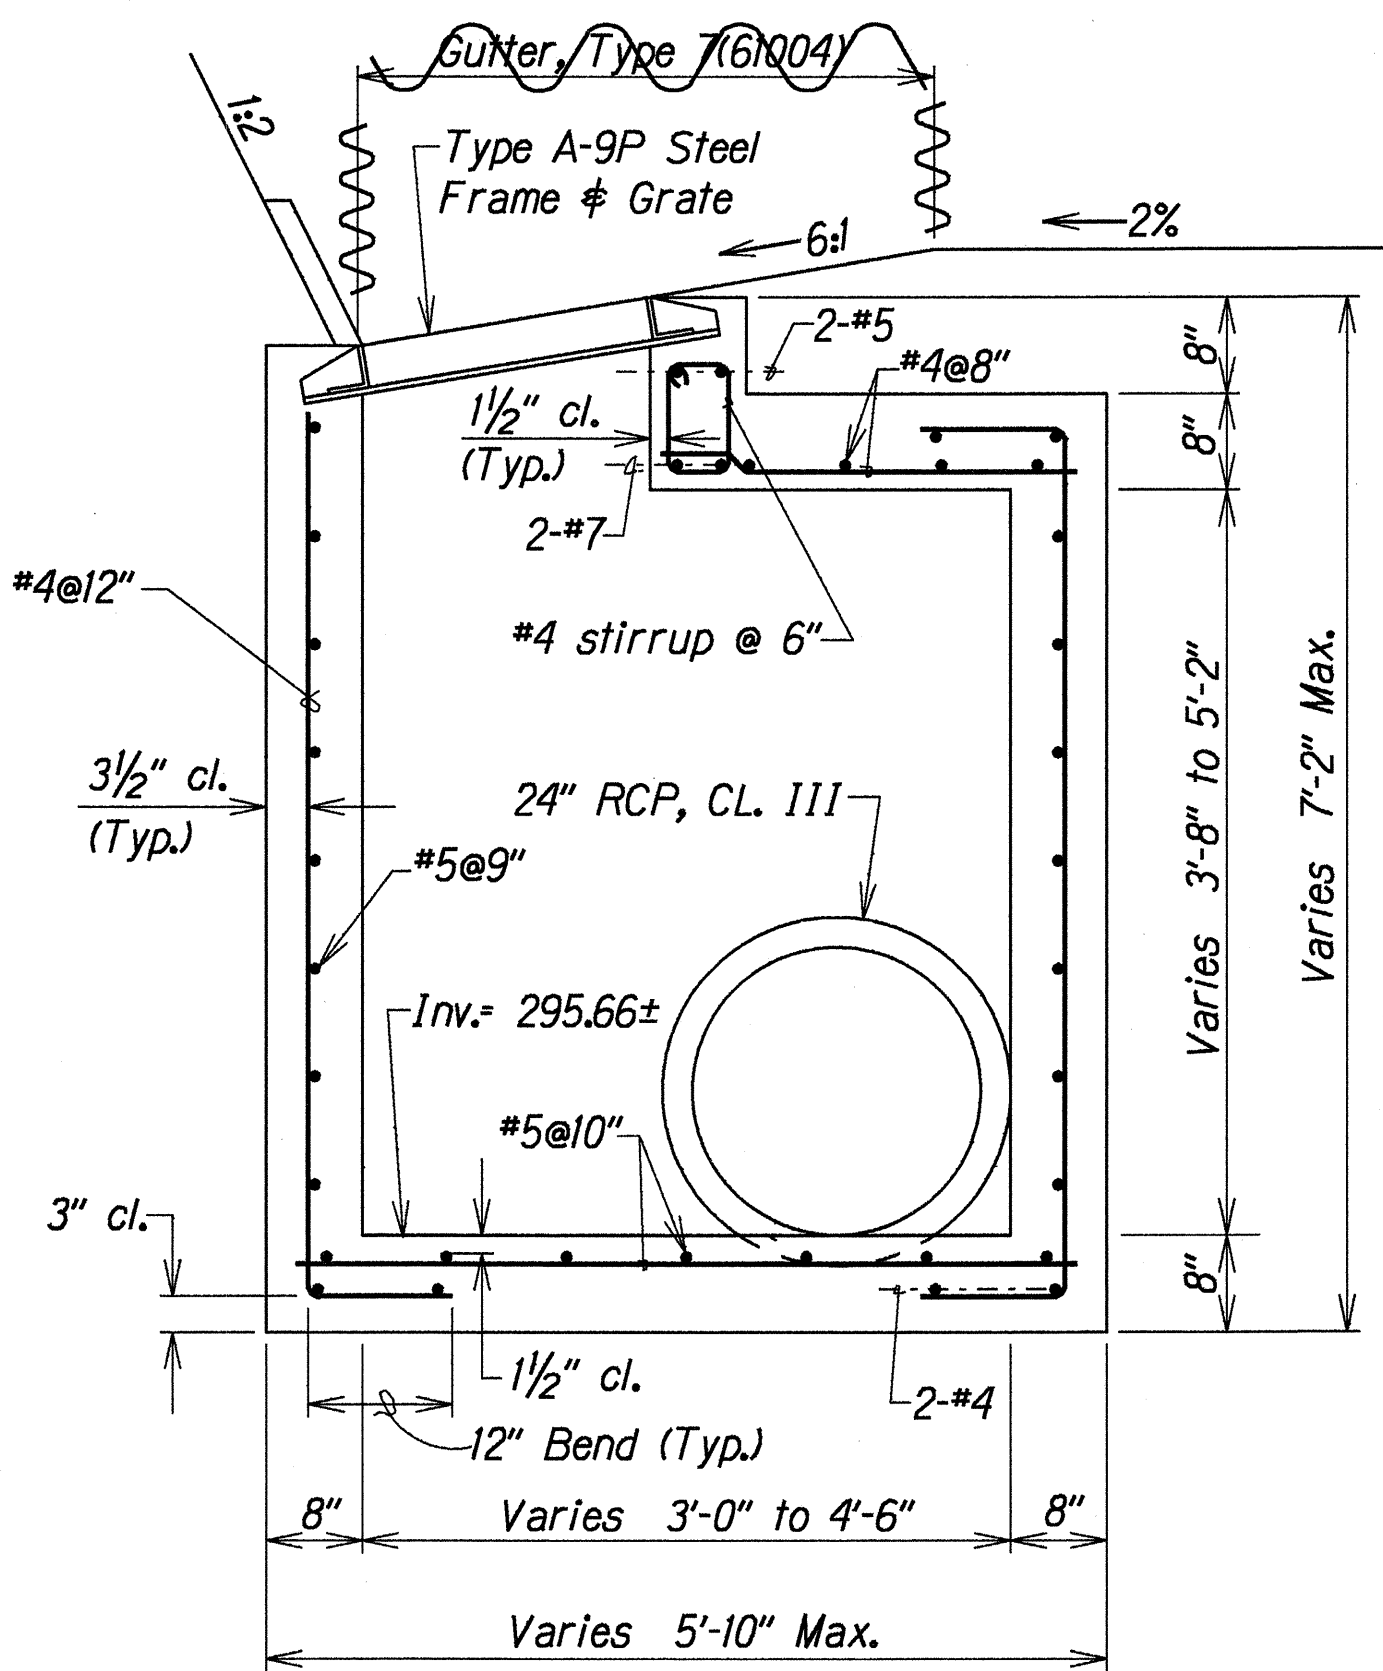

SECTION B
HIB HIB

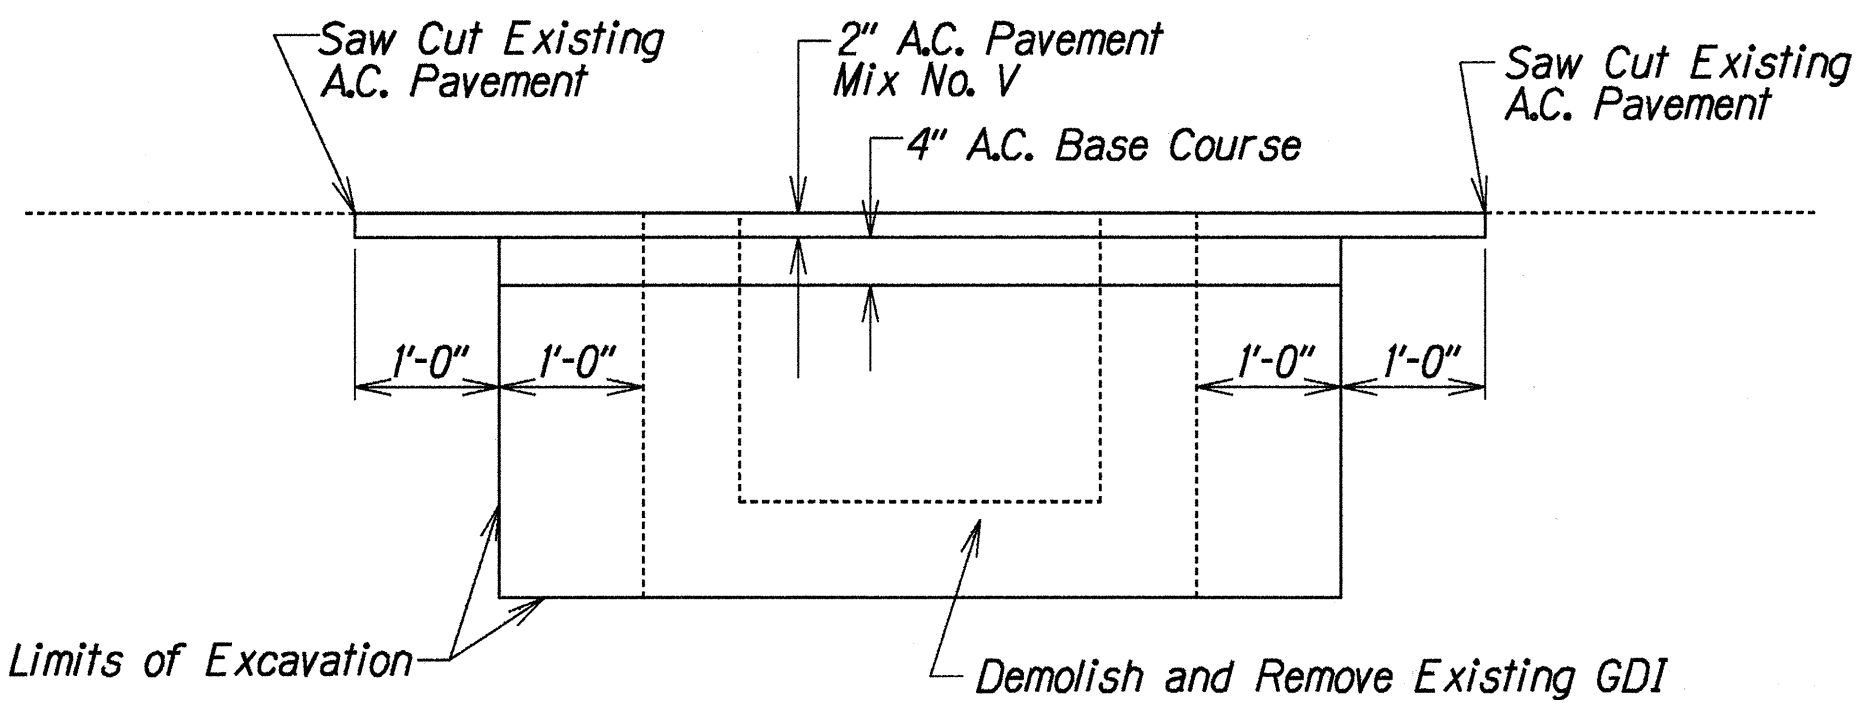

EXISTING GDI AT STA. 694+61 RT.

RESTORATION OF PAVEMENT

ORIGINAL PLAN	DATE
DESIGNED BY	DATE
NOTED BY	DATE
CHECKED BY	DATE

6/30/97	Gutter Type 7(61004) not constructed
6/4/93	Added Detail of Type 2 Grated Drop Inlet.
DATE	REVISION

STATE OF HAWAII DEPARTMENT OF TRANSPORTATION HIGHWAYS DIVISION
DRAINAGE DETAILS
HANA HWY. STORM DAMAGE REPAIRS
Huelo Towards Nahiku
PROJ. NO. 360AB-01-92
Scale: 3/4" = 1'-0"
Date: June, 1993
SHEET No. HIB OF 1 SHEETS

"AS-BUILT"

C.O. 19 S-2