


FED. ROAD DIST. NO.	STATE	PROJ. NO.	FISCAL YEAR	SHEET NO.	TOTAL SHEETS
HAWAII	HAW.	360AB-01-92	1992	6	37

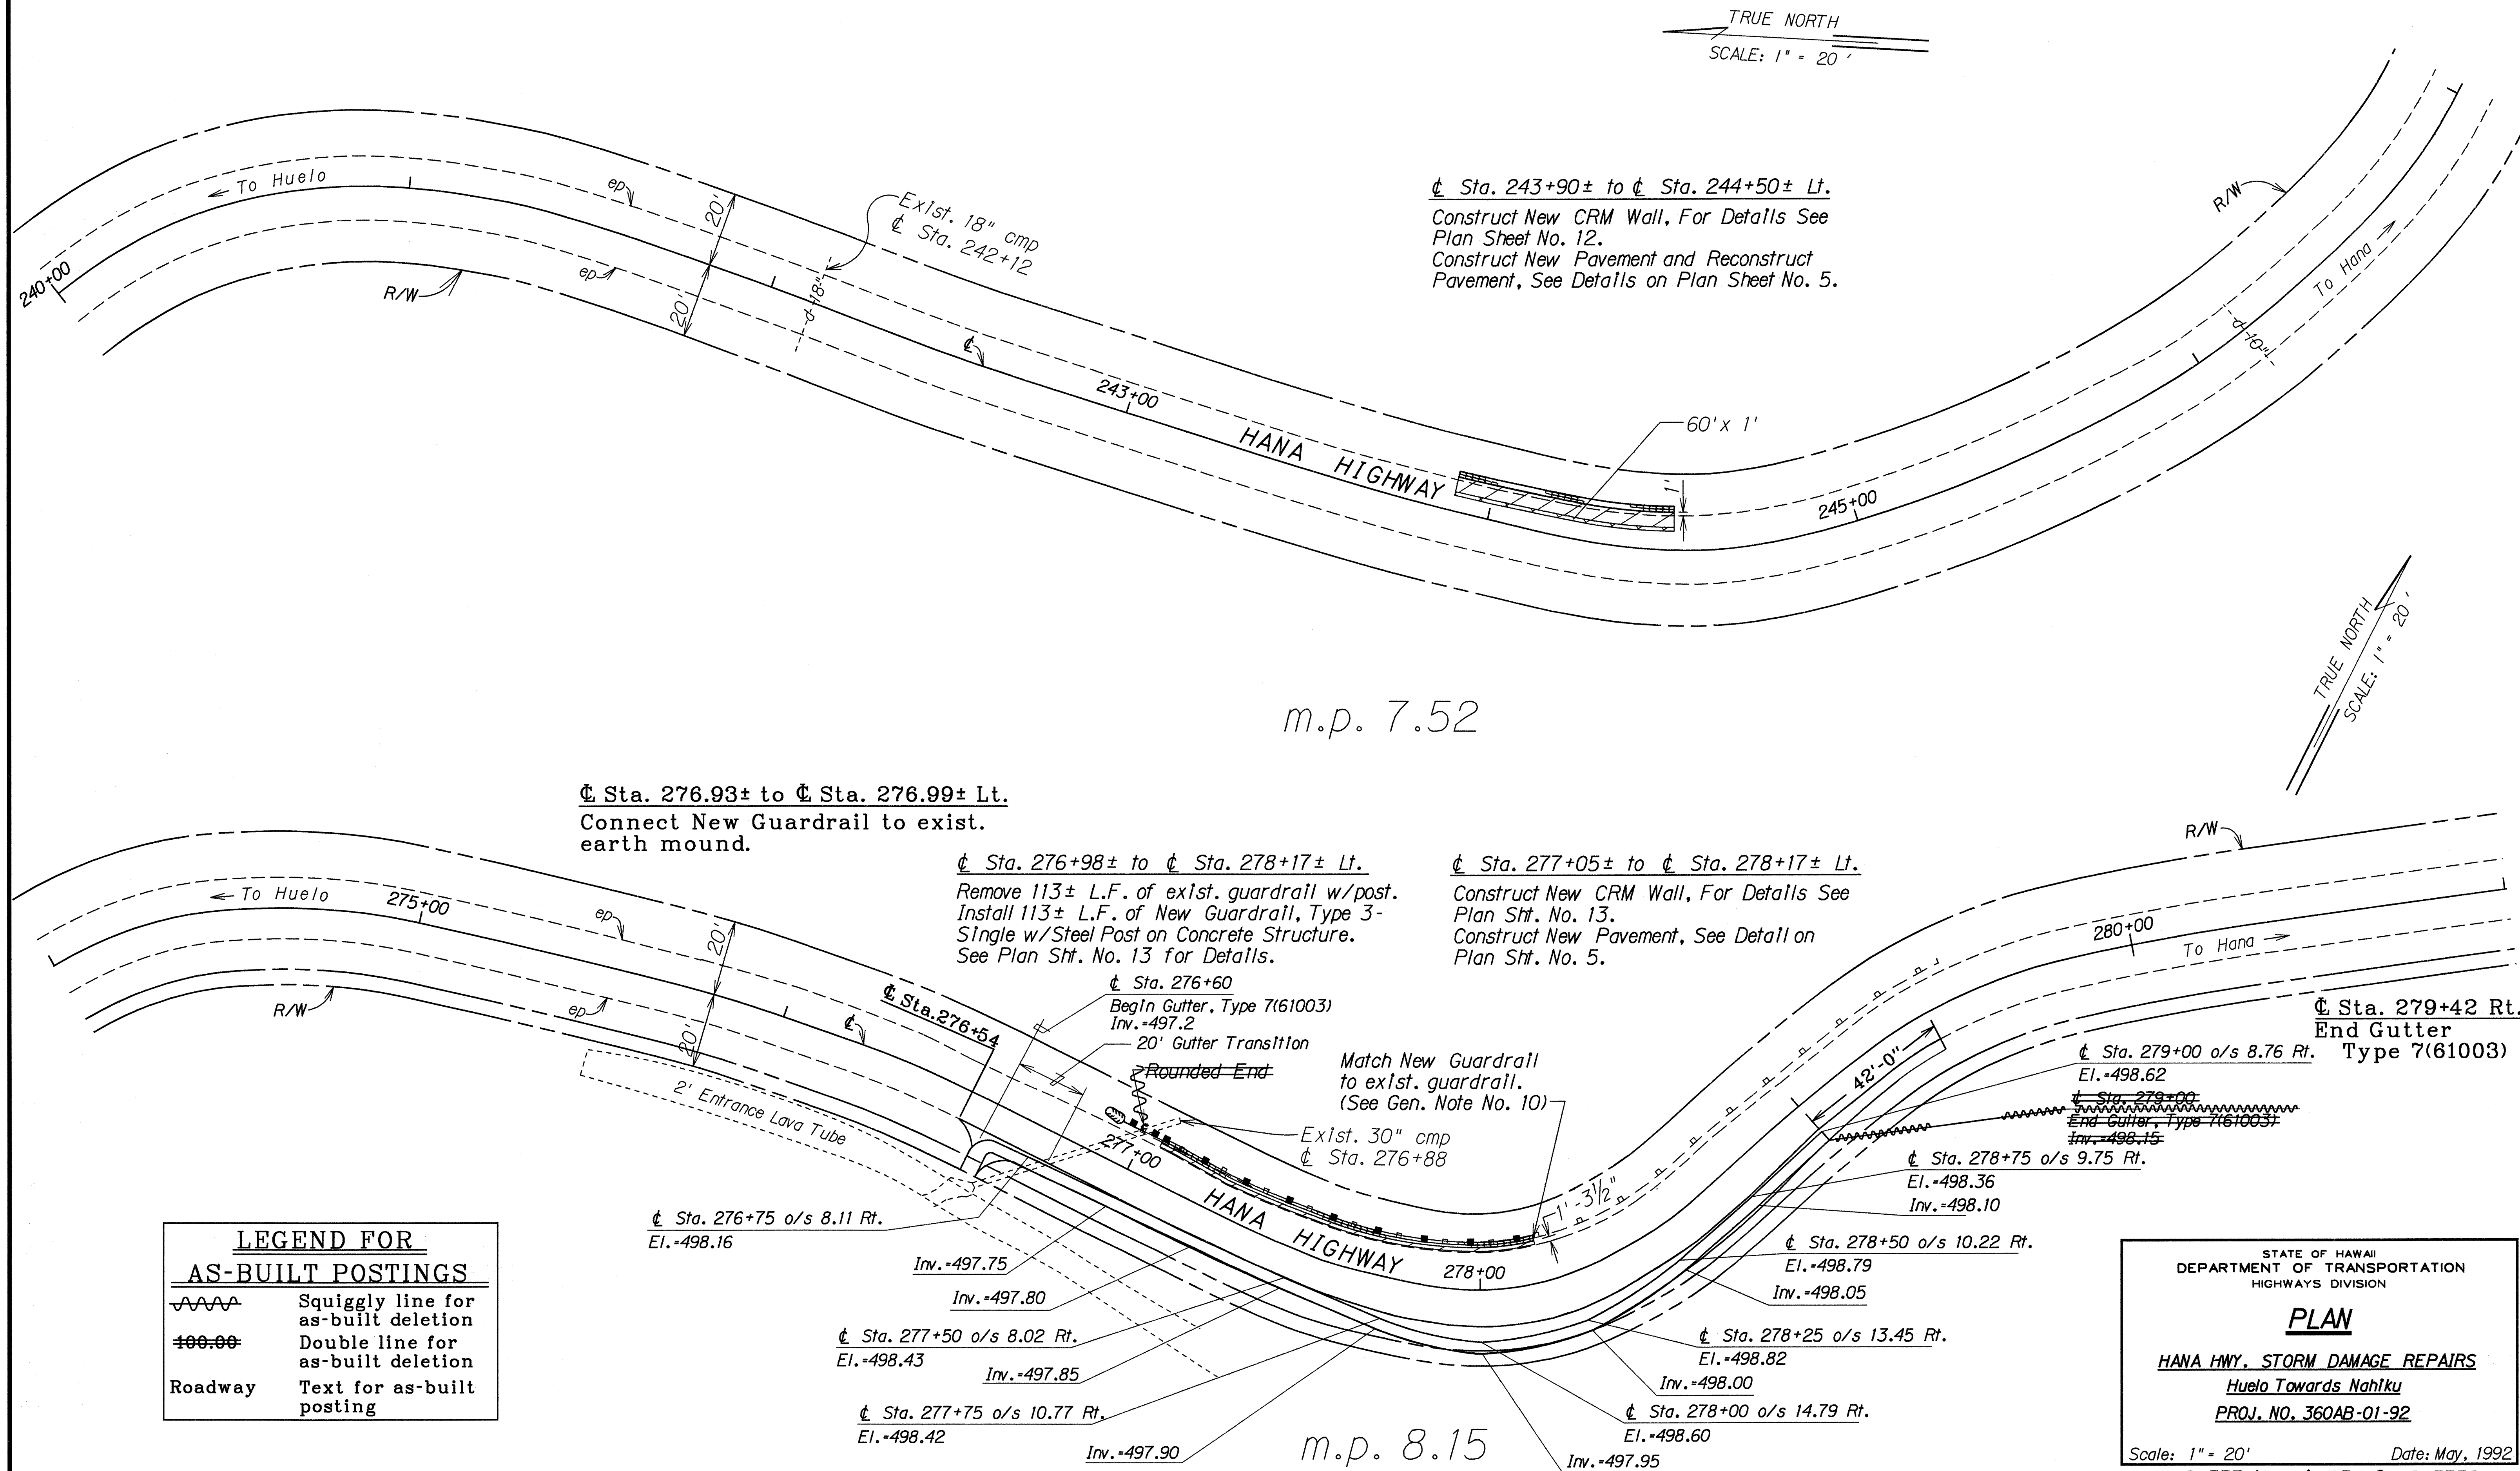

DESIGNED BY	DATE
DRAWN BY	
CHECKED BY	
NOTES	
QUANTITIES	
CHECKED BY	


LEGEND FOR AS-BUILT POSTINGS	
	Squiggly line for as-built deletion
	Double line for as-built deletion
Roadway	Text for as-built posting

STATE OF HAWAII
DEPARTMENT OF TRANSPORTATION
HIGHWAYS DIVISION

PLAN
HANA HWY. STORM DAMAGE REPAIRS
Huelo Towards Nahtku
PROJ. NO. 360AB-01-92

Scale: 1" = 20'
Date: May, 1992
SHEET No. 1 OF 6 SHEETS

FED. ROAD DIST. NO.	STATE	PROJ. NO.	FISCAL YEAR	SHEET NO.	TOTAL SHEETS
HAWAII	HAW.	360AB-01-92	1992	7	37

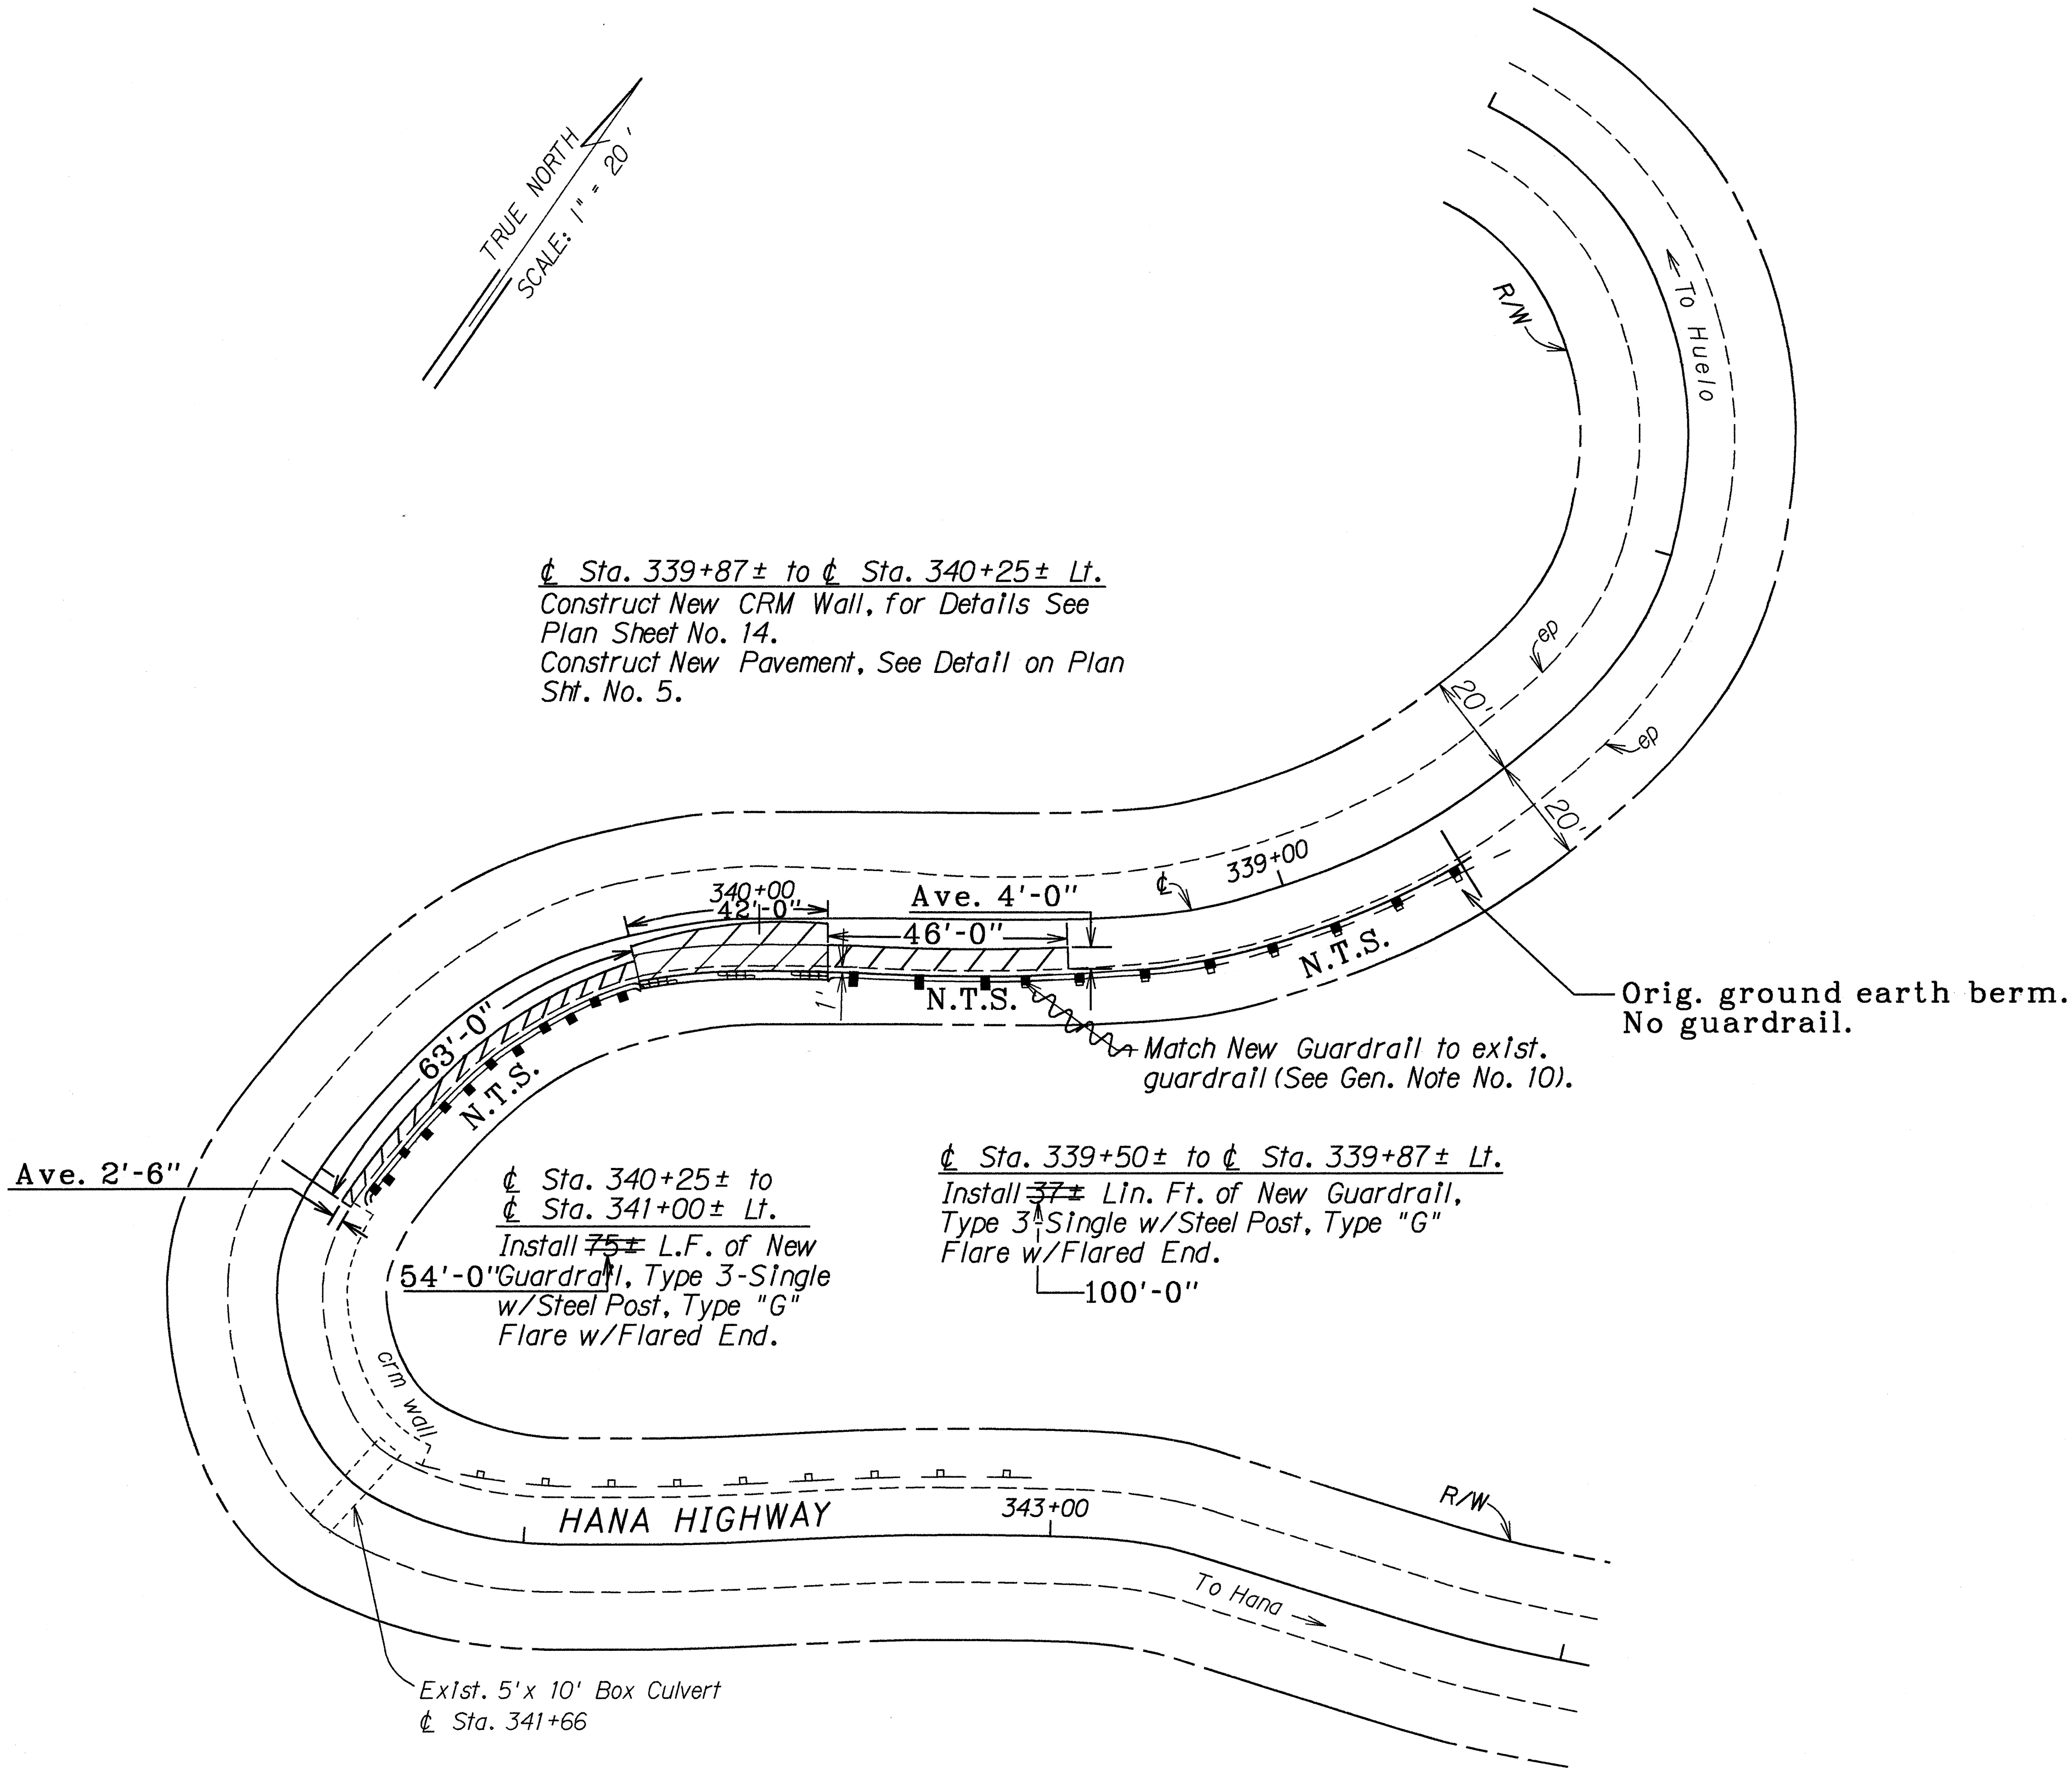

LEGEND FOR AS-BUILT POSTINGS	
	Squiggly line for as-built deletion
	Double line for as-built deletion
Roadway	Text for as-built posting

STATE OF HAWAII
DEPARTMENT OF TRANSPORTATION
HIGHWAYS DIVISION

PLAN

HANA HWY. STORM DAMAGE REPAIRS
Huelo Towards Nahlku
PROJ. NO. 360AB-01-92


Scale: 1" = 20'
SHEET No. 2 OF 6 SHEETS

Date: May, 1992

DESIGNED BY	DATE
DRIVEN BY	
NOTED BY	
QUANTITIES BY	
CHECKED BY	

"AS-BUILT"

FED. ROAD DIST. NO.	STATE	PROJ. NO.	FISCAL YEAR	SHEET NO.	TOTAL SHEETS
HAWAII	HAW.	360AB-01-92	1992	8	37

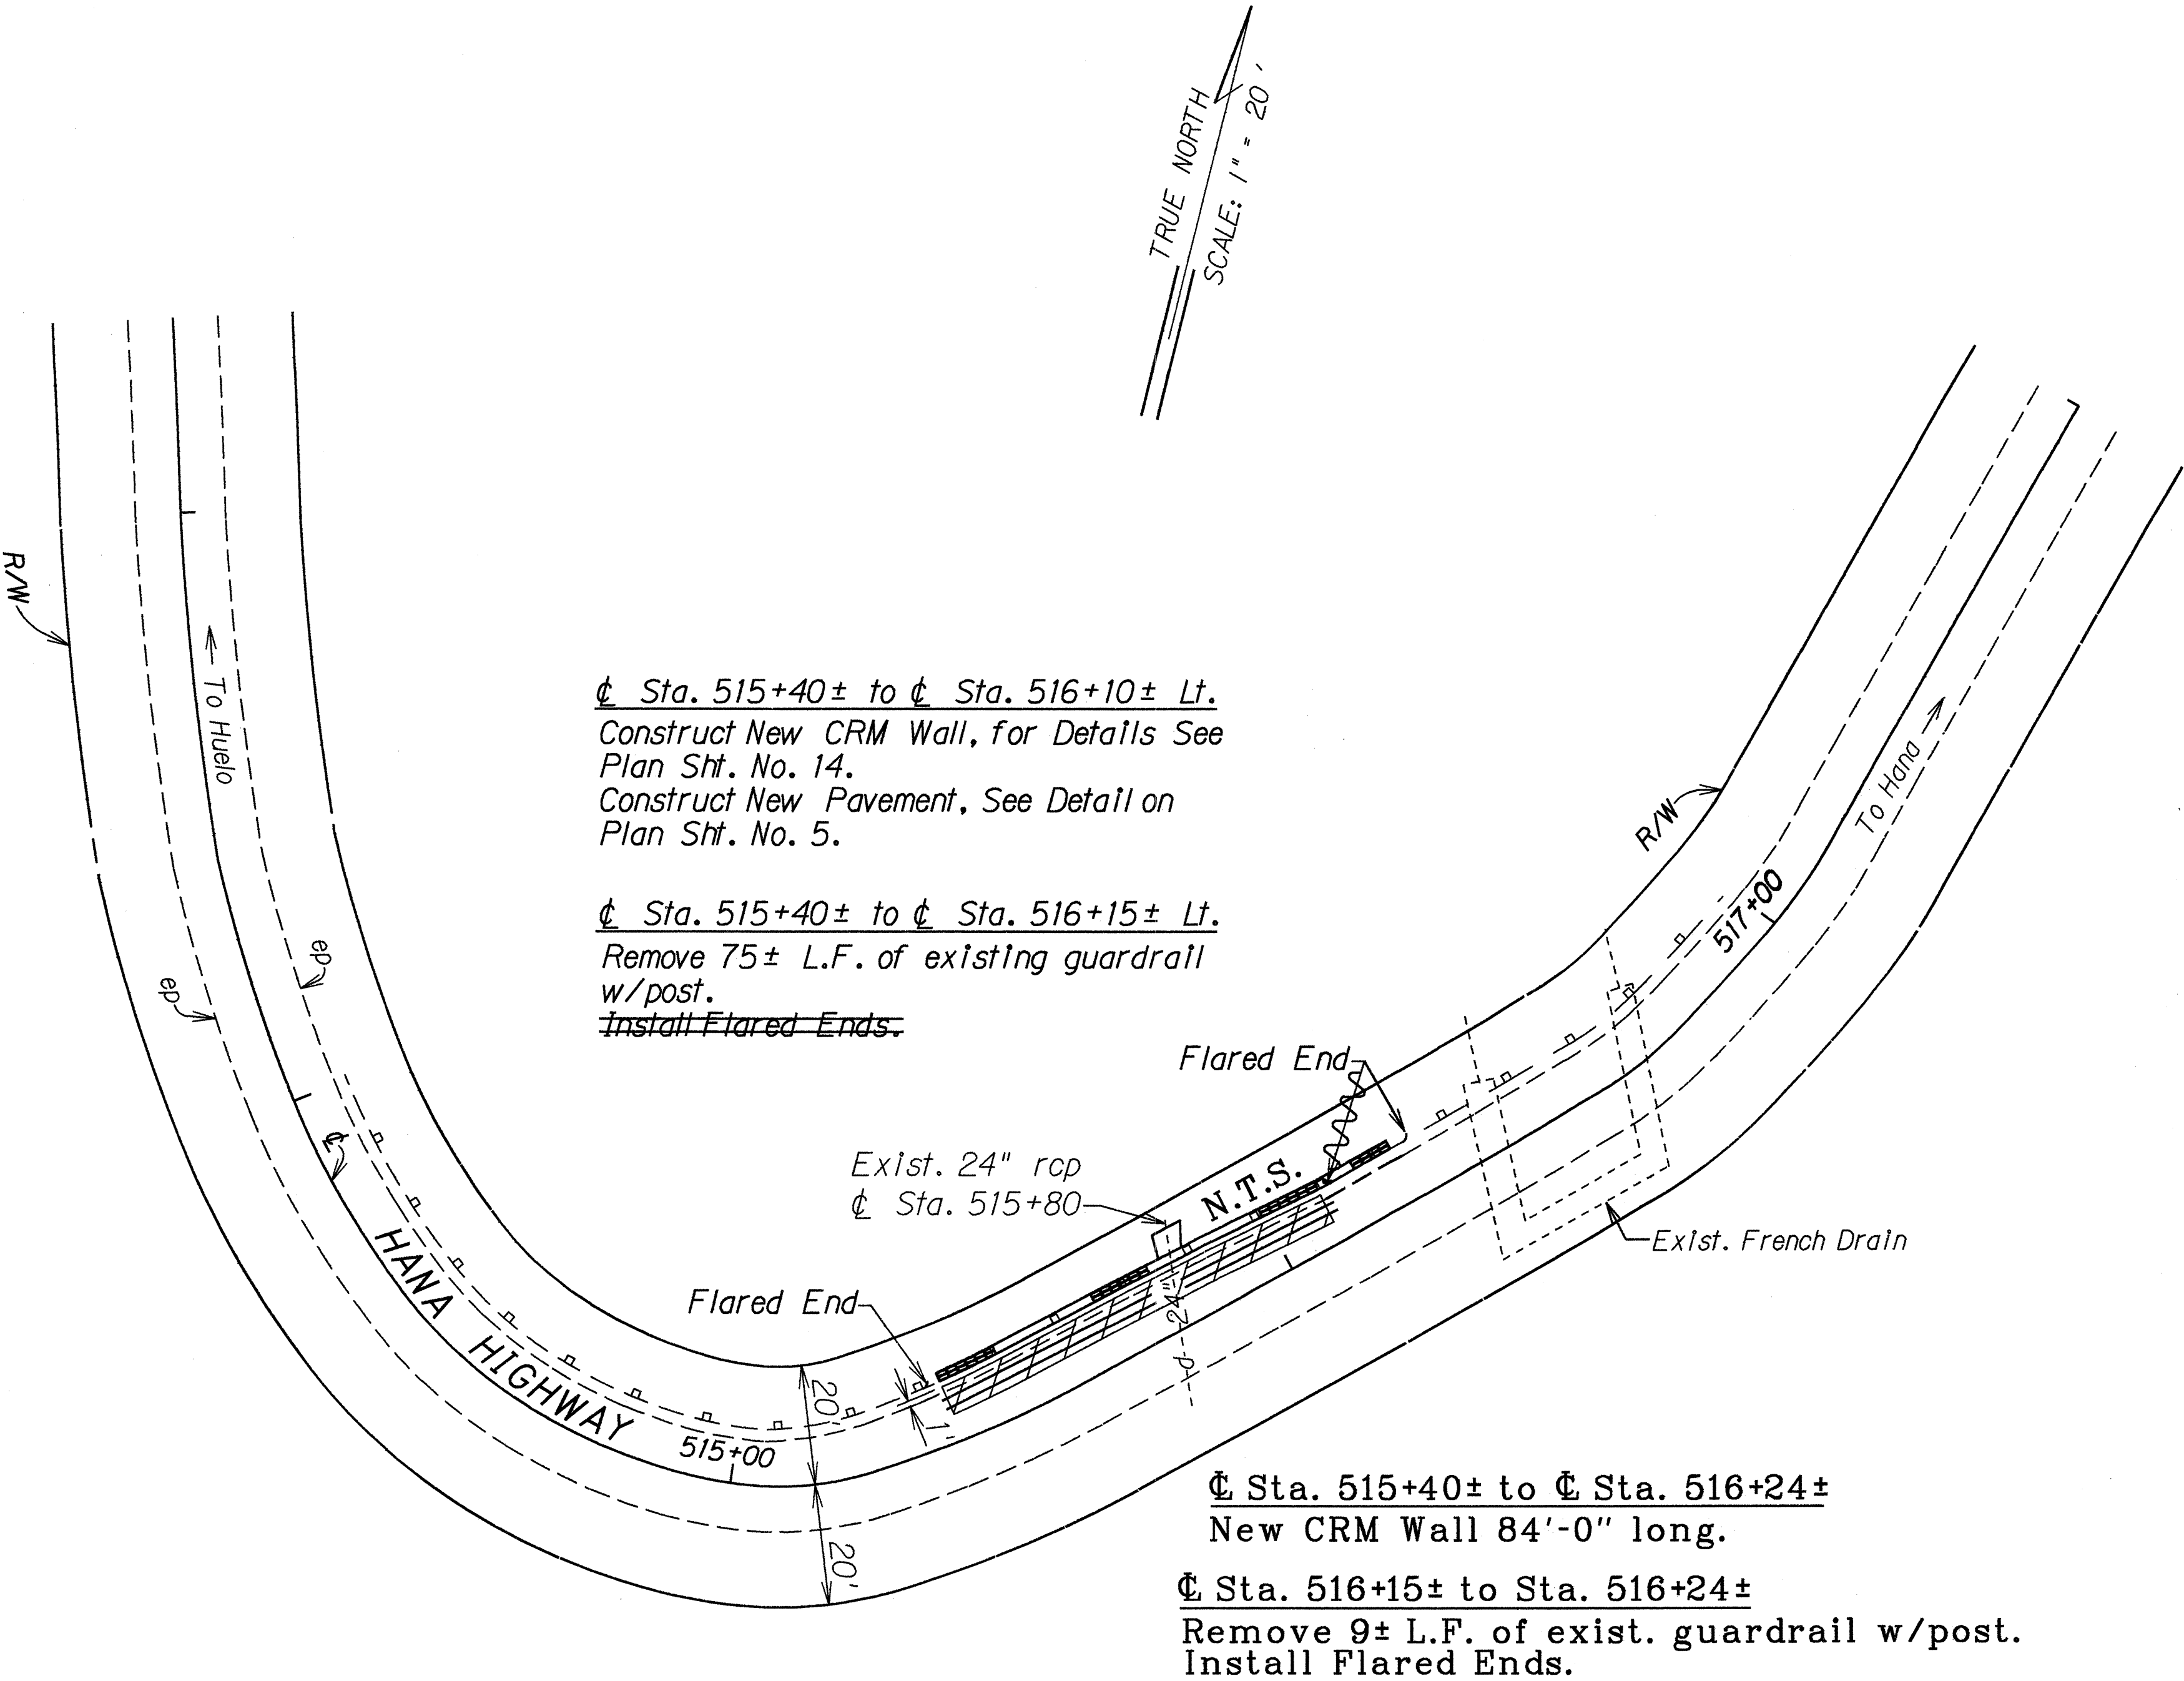

m.p. 12.66

LEGEND FOR AS-BUILT POSTINGS	
	Squiggly line for as-built deletion
	Double line for as-built deletion
Roadway	Text for as-built posting

STATE OF HAWAII
DEPARTMENT OF TRANSPORTATION
HIGHWAYS DIVISION

PLAN


HANA HWY. STORM DAMAGE REPAIRS
Huelo Towards Nahaiku
PROJ. NO. 360AB-01-92

Scale: 1" = 20' Date: May, 1992

SHEET No. 3 OF 6 SHEETS


DESIGNED BY	DATE
NOTED BY	
TRACED BY	
QUANTITIES BY	
CHECKED BY	

FED. ROAD DIST. NO.	STATE	PROJ. NO.	FISCAL YEAR	SHEET NO.	TOTAL SHEETS
HAWAII	HAW.	360AB-01-92	1992	9	37

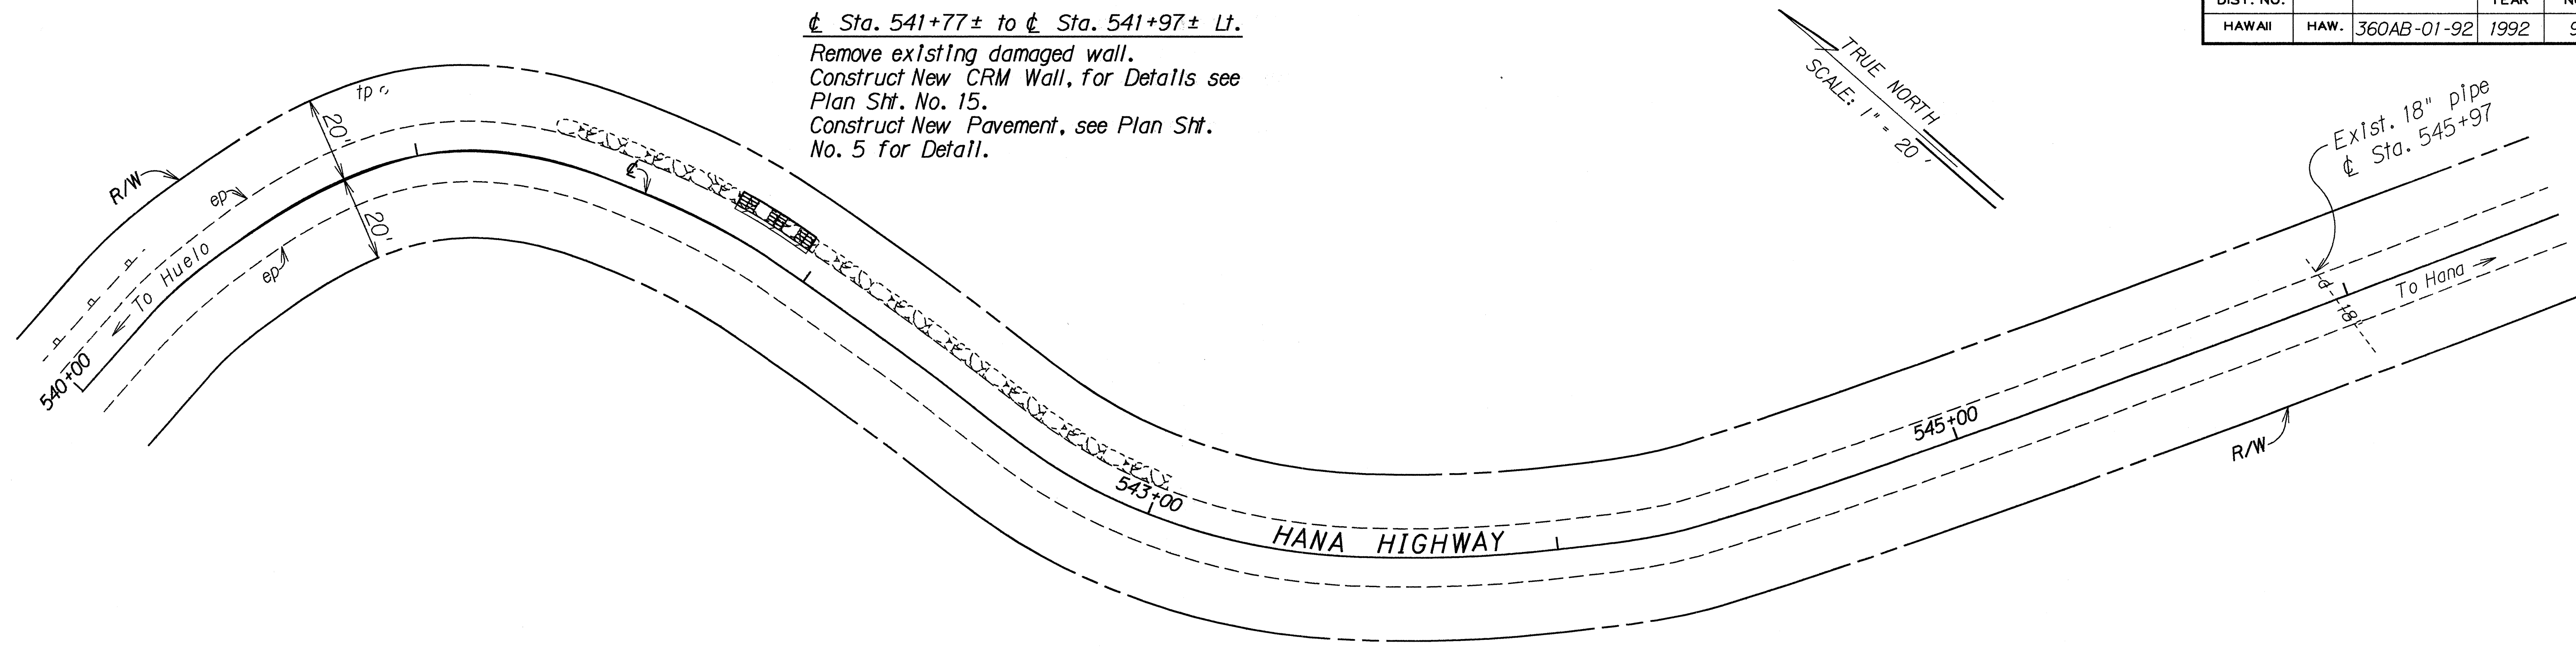

m.p. 13.14

ϕ Sta. 565+05± to ϕ Sta. 566+25± Lt.
 Construct G.R.P. Slope Protection, for
 Details see Plan Sht. No. 15.

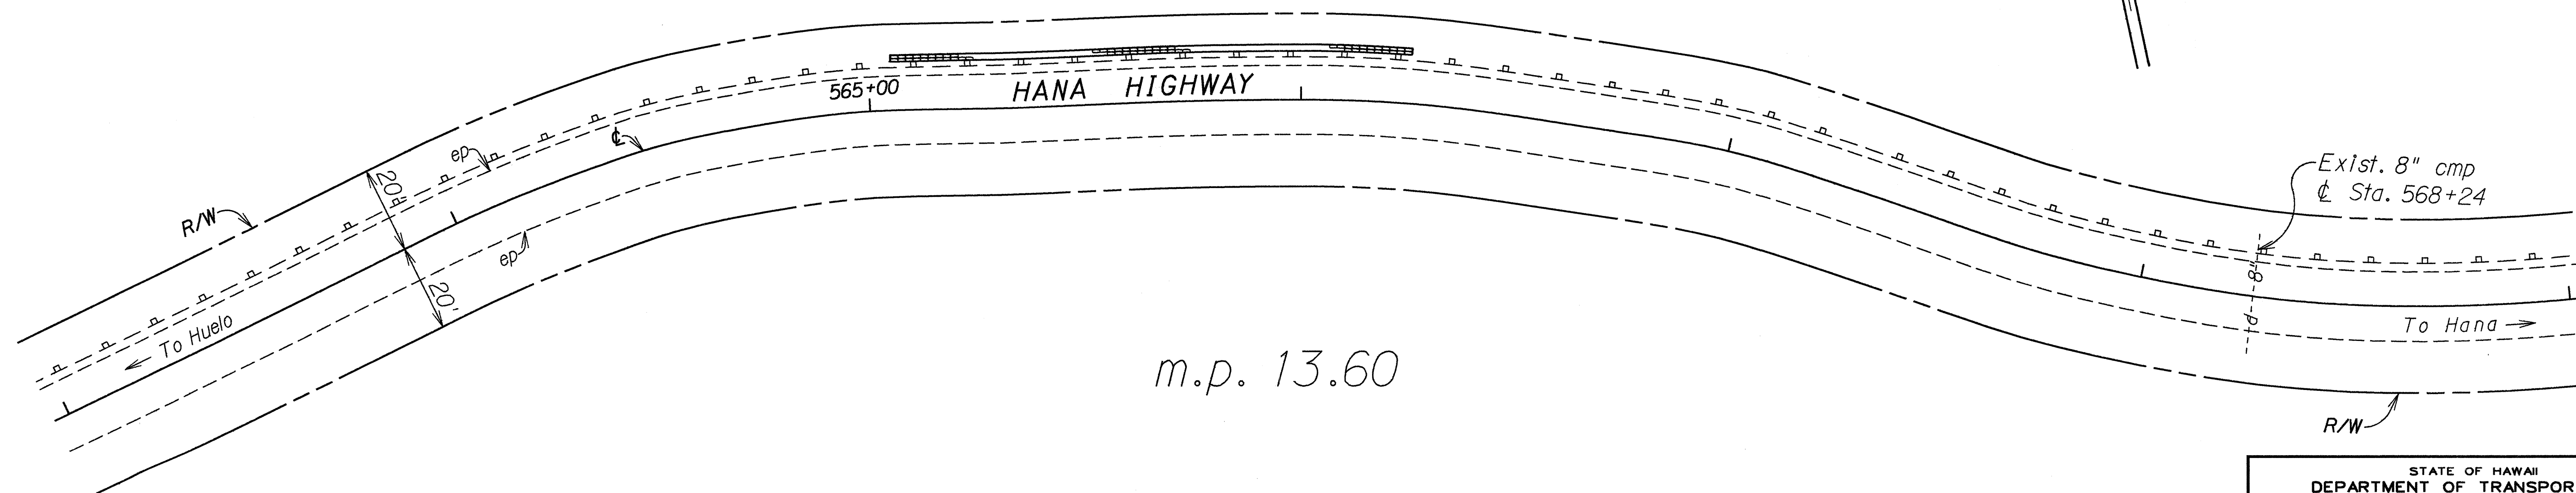

m.p. 13.60

STATE OF HAWAII
DEPARTMENT OF TRANSPORTATION
HIGHWAYS DIVISION

PLAN

HANA HWY. STORM DAMAGE REPAIRS

Huelo Towards Nahlku

PROJ. NO. 360AB-01-92


Scale: 1" = 20'

Date: May, 1992

SHEET No. 4 OF 6 SHEETS

SURVEY PLOTTED BY	DATE
DRAWN BY	
DESIGNED BY	
QUANTITIES BY	
CHECKED BY	
ORIGINAL PLAN	
NOTE BOOK	
N. 2/28/94 Lp	

FED. ROAD DIST. NO.	STATE	PROJ. NO.	FISCAL YEAR	SHEET NO.	TOTAL SHEETS
HAWAII	HAW.	360AB-01-92	1992	10	37

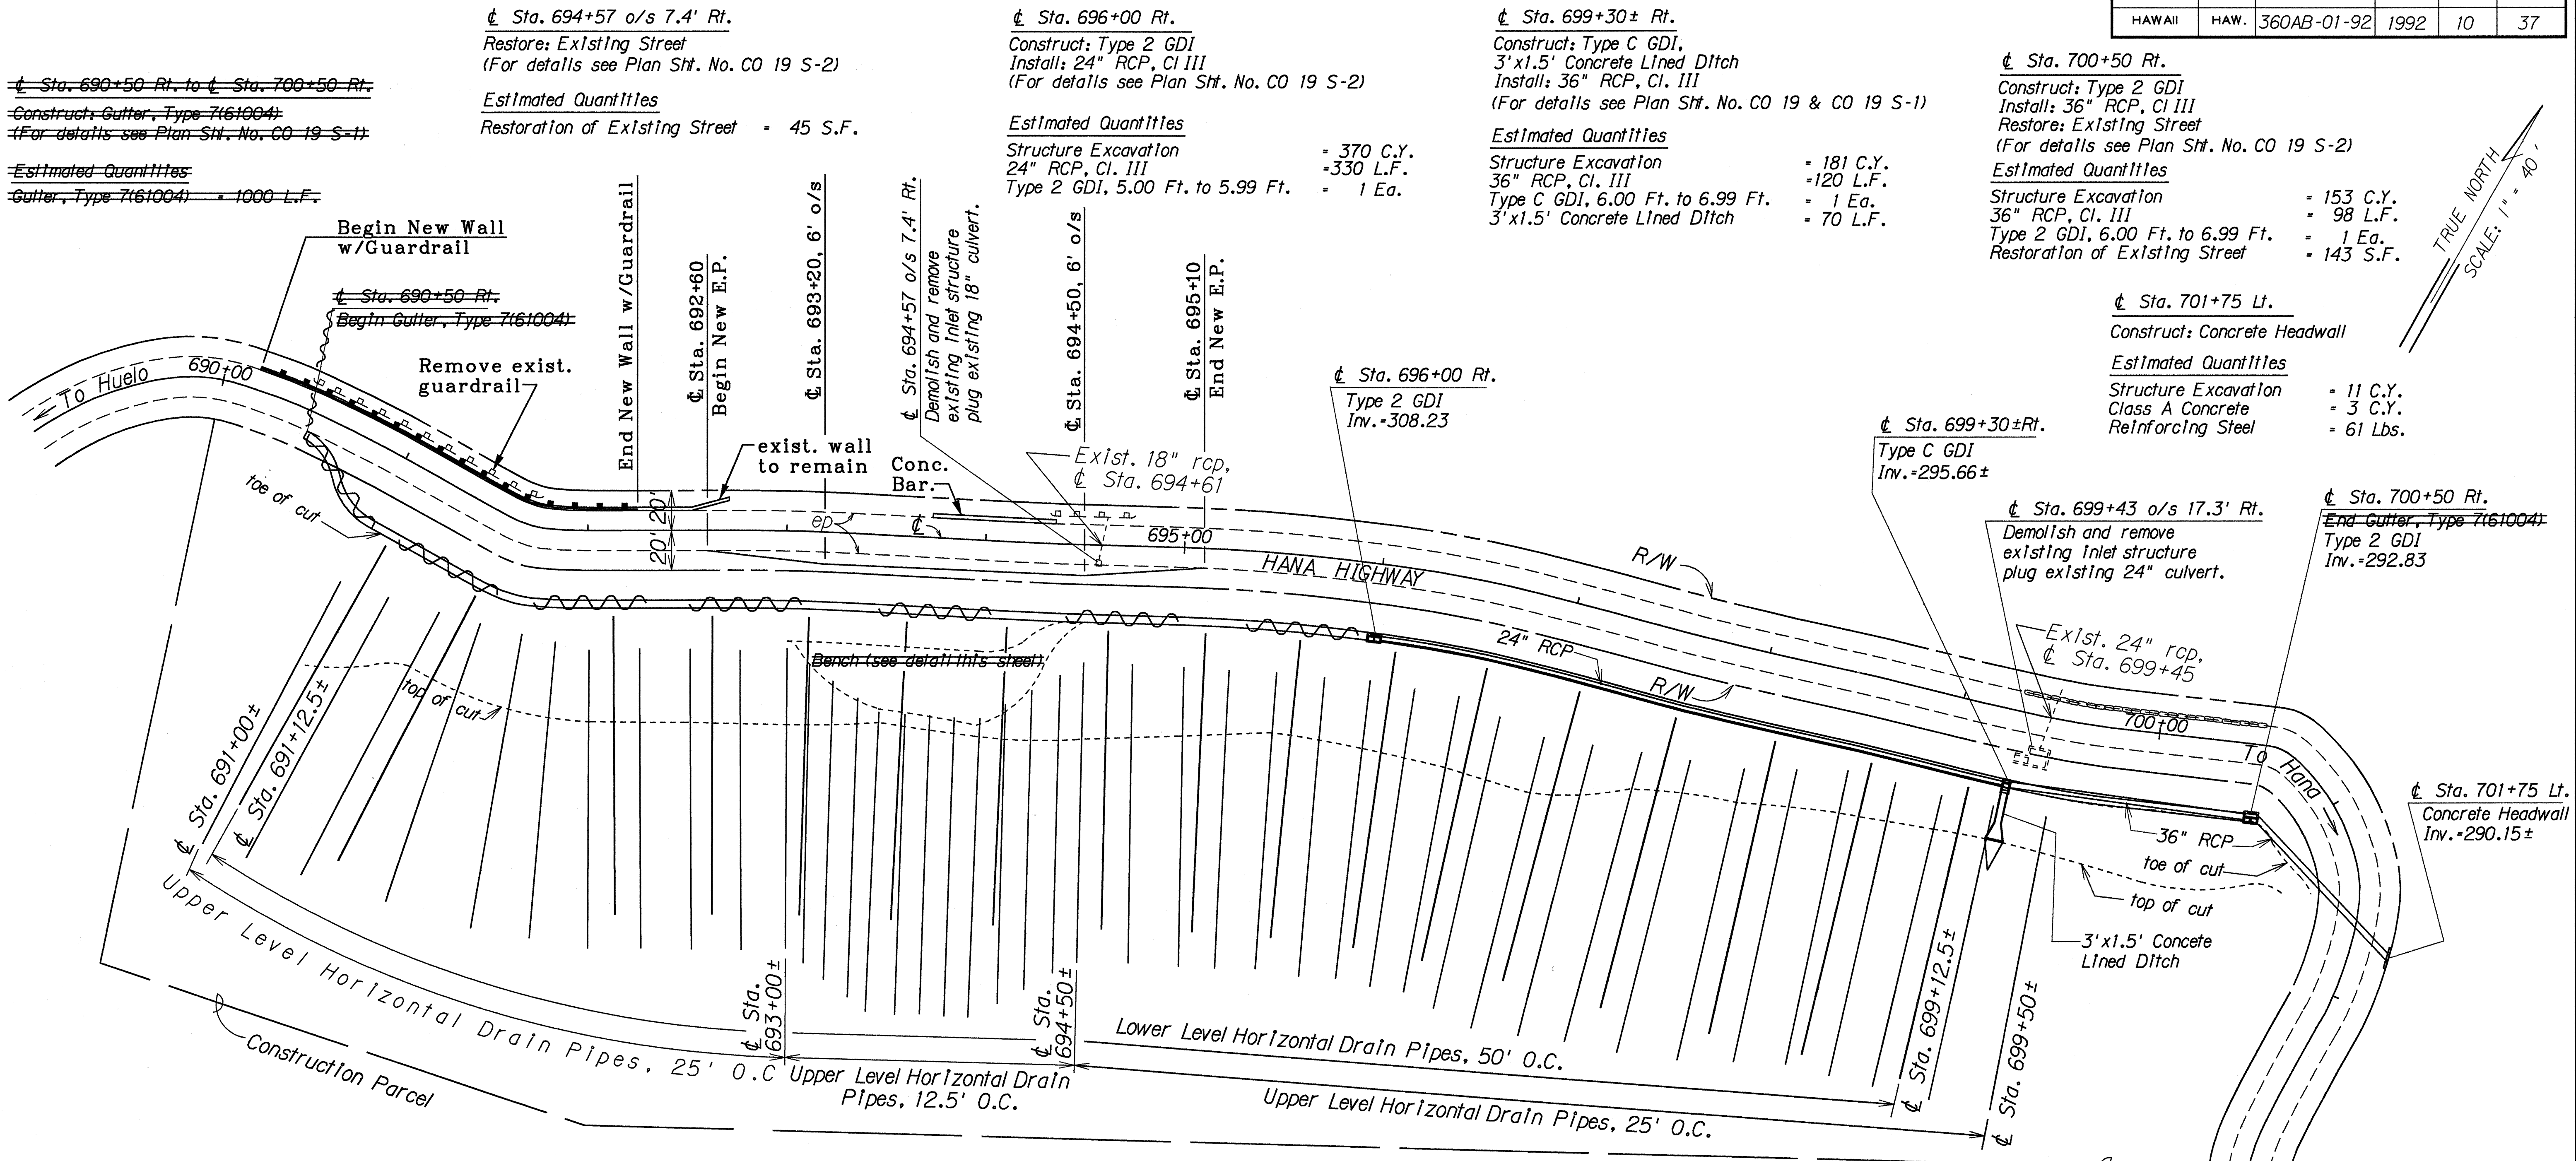


TRUE NORTH
SCALE: 1" = 40'

Sta. 691+00± to Sta. 693+00±
Install Horizontal Drain Pipes (perpendicular at tangents and radial to roadway on curves) at 25' Intervals on centerline roadway. See Detail on Plan Sht. No. 5.

Sta. 693+00± to Sta. 694+50±
Install Horizontal Drain Pipes (perpendicular at tangents and radial to roadway on curves) at 12.5' Intervals on centerline roadway. See Detail on Plan Sht. No. 5.

Sta. 690+00± Rt. to Sta. 700+00± Rt.
Install 4" White Edge Stripe (Tape, Type II or Thermoplastic Extrusion).

Sta. 691+12.5± to Sta. 699+12.5±
Install Horizontal Drain Pipes (perpendicular at tangents and radial to roadway on curves) at 50' Intervals on centerline roadway. See Detail on Plan Sht. No. 5.

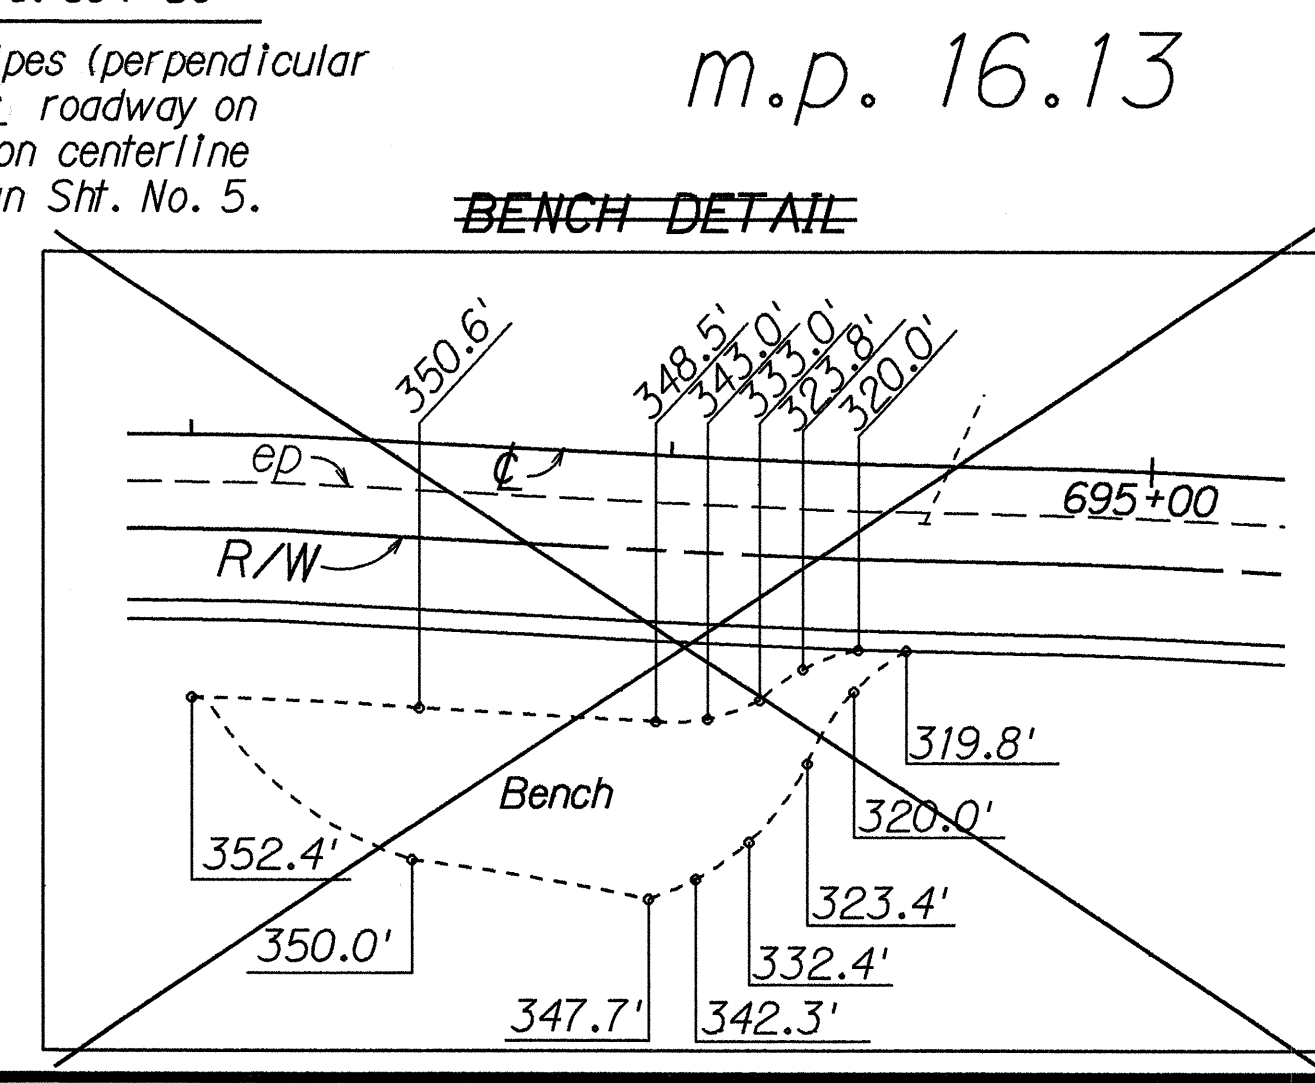

Sta. 694+00± to Sta. 694+50±
Construct Maintenance Access Road to Bench, 10' Minimum Width.

Sta. 694+50± to Sta. 699+50±
Install Horizontal Drain Pipes (perpendicular at tangents and radial to roadway on curves) at 25' Intervals on centerline roadway. See Detail on Plan Sht. No. 5.

LEGEND: ——— 150' Long, 2" Diameter, Horizontal Drain Pipe

6/30/97	Bench & Gutter, Type 7(61004), not constructed.
6/4/93	Revised drainage structures along gutter.
8/4/92	Added Lower Level Horizontal Drain Pipes
DATE	REVISION
STATE OF HAWAII DEPARTMENT OF TRANSPORTATION HIGHWAYS DIVISION	
PLAN	
HANA HWY. STORM DAMAGE REPAIRS Huelo Towards Nahaiku PROJ. NO. 360AB-01-92	
Scale: 1" = 40' Date: May, 1992	
SHEET No. 5 OF 6 SHEETS	

DESIGNED BY	DATE
DRAWN BY	
CHECKED BY	
NOTED BY	
QUANTITIES BY	
IN CHARGE	

"AS-BUILT"

C.O. 10R


FED. ROAD DIST. NO.	STATE	PROJ. NO.	FISCAL YEAR	SHEET NO.	TOTAL SHEETS
HAWAII	HAW.	360AB-01-92	1992	11	37

C Sta. 603+55 to C Sta. 604+12± Lt.
 New CRM Wall

C Sta. 603+52 to C 604+15± Lt.
 Remove 63± Lt. of Existing Guardrail w/Post
 Install 63± Lt. New Guardrail w/Stl Post
 on Concrete Structure

C Sta. 605+30± to C Sta. 606+81± Lt.
 Remove 150± L.F. of exist. guardrail
 w/post.
 Install 150± L.F. of New Guardrail,
 Type 3-Single w/Steel Post on Concrete
 Structure, See Plan Sht. No. 16 for
 Details.

C Sta. 605+31± to C Sta. 606+80± Lt.
 Construct New CRM Wall, for Details
 See Plan Sht. No. 16.
 Construct New Pavement And Reconstruct
 Pavement, See Details on Plan Sht. No. 5.

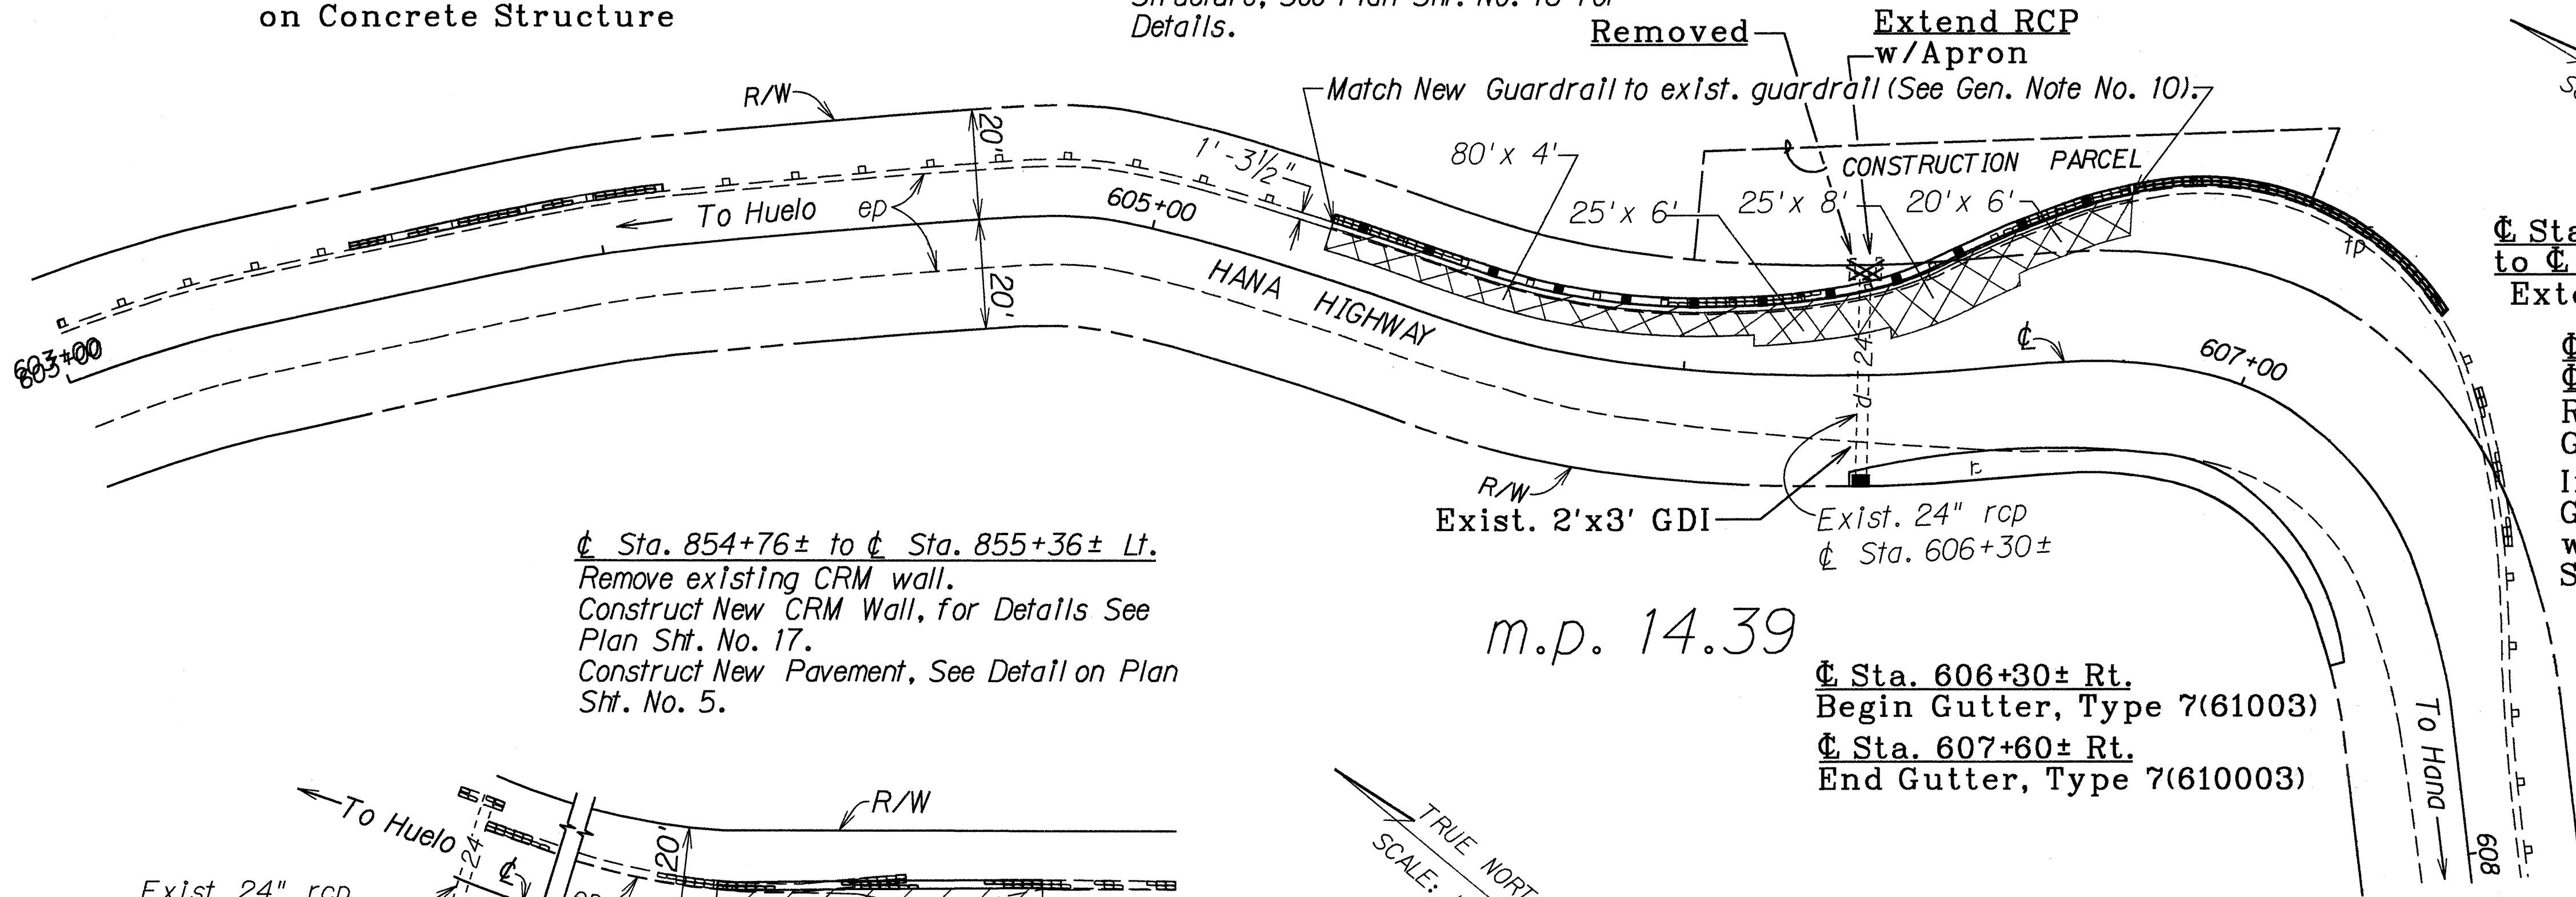


C Sta. 606+80± Lt.
 to C 607+19± Lt.
 Extension of CRM Wall

C Sta. 606+80± Lt. to
 C 607+21± Lt.
 Remove 41± L.F. of Exist.
 Guardrail w/Post
 Install 41± L.F. of New
 Guardrail Type 3-Single
 w/Stl Post on Concrete
 Structure


C Sta. 854+76± to C Sta. 855+36± Lt.
 Remove existing CRM wall.
 Construct New CRM Wall, for Details See
 Plan Sht. No. 17.
 Construct New Pavement, See Detail on Plan
 Sht. No. 5.

m.p. 14.39

C Sta. 606+30± Rt.
 Begin Gutter, Type 7(61003)
 C Sta. 607+60± Rt.
 End Gutter, Type 7(61003)

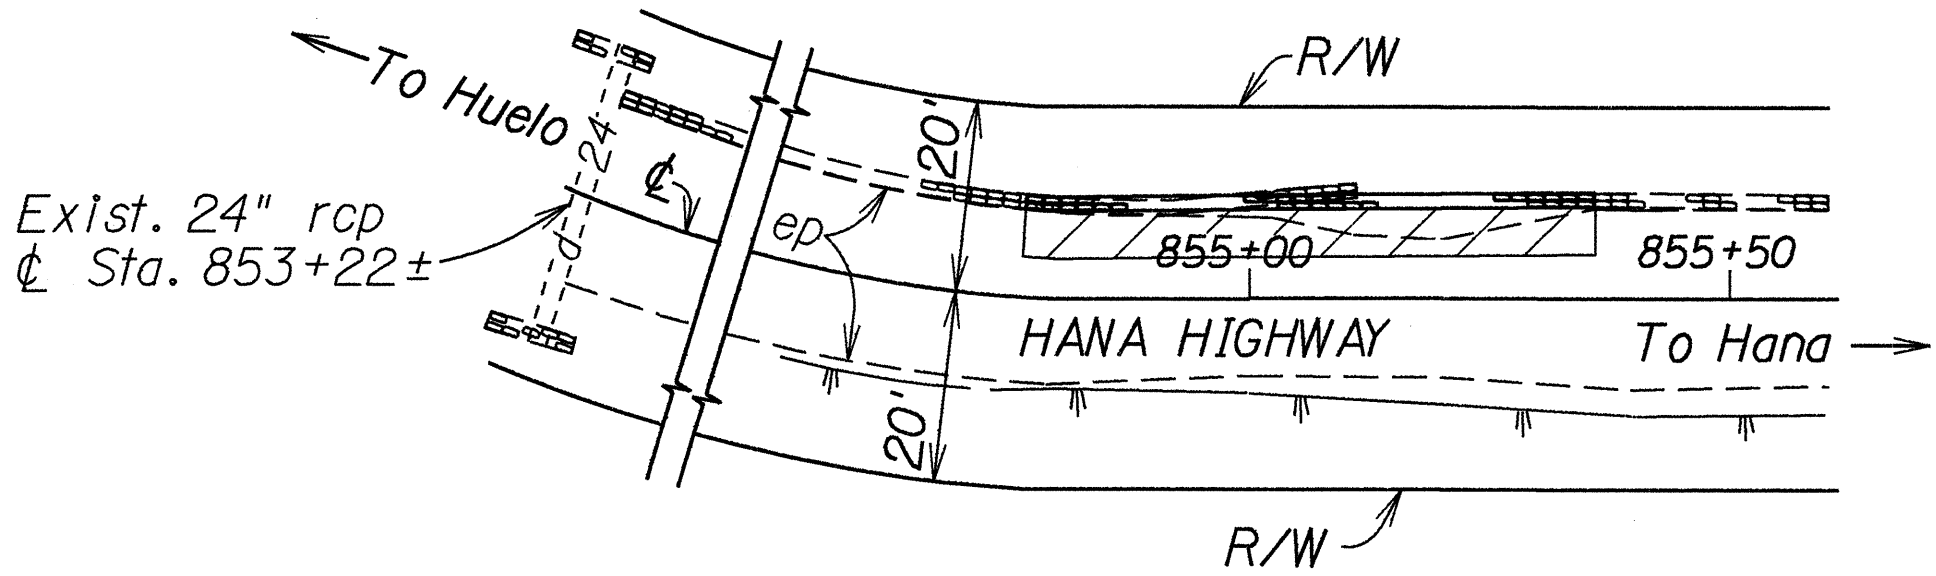

m.p.19.08

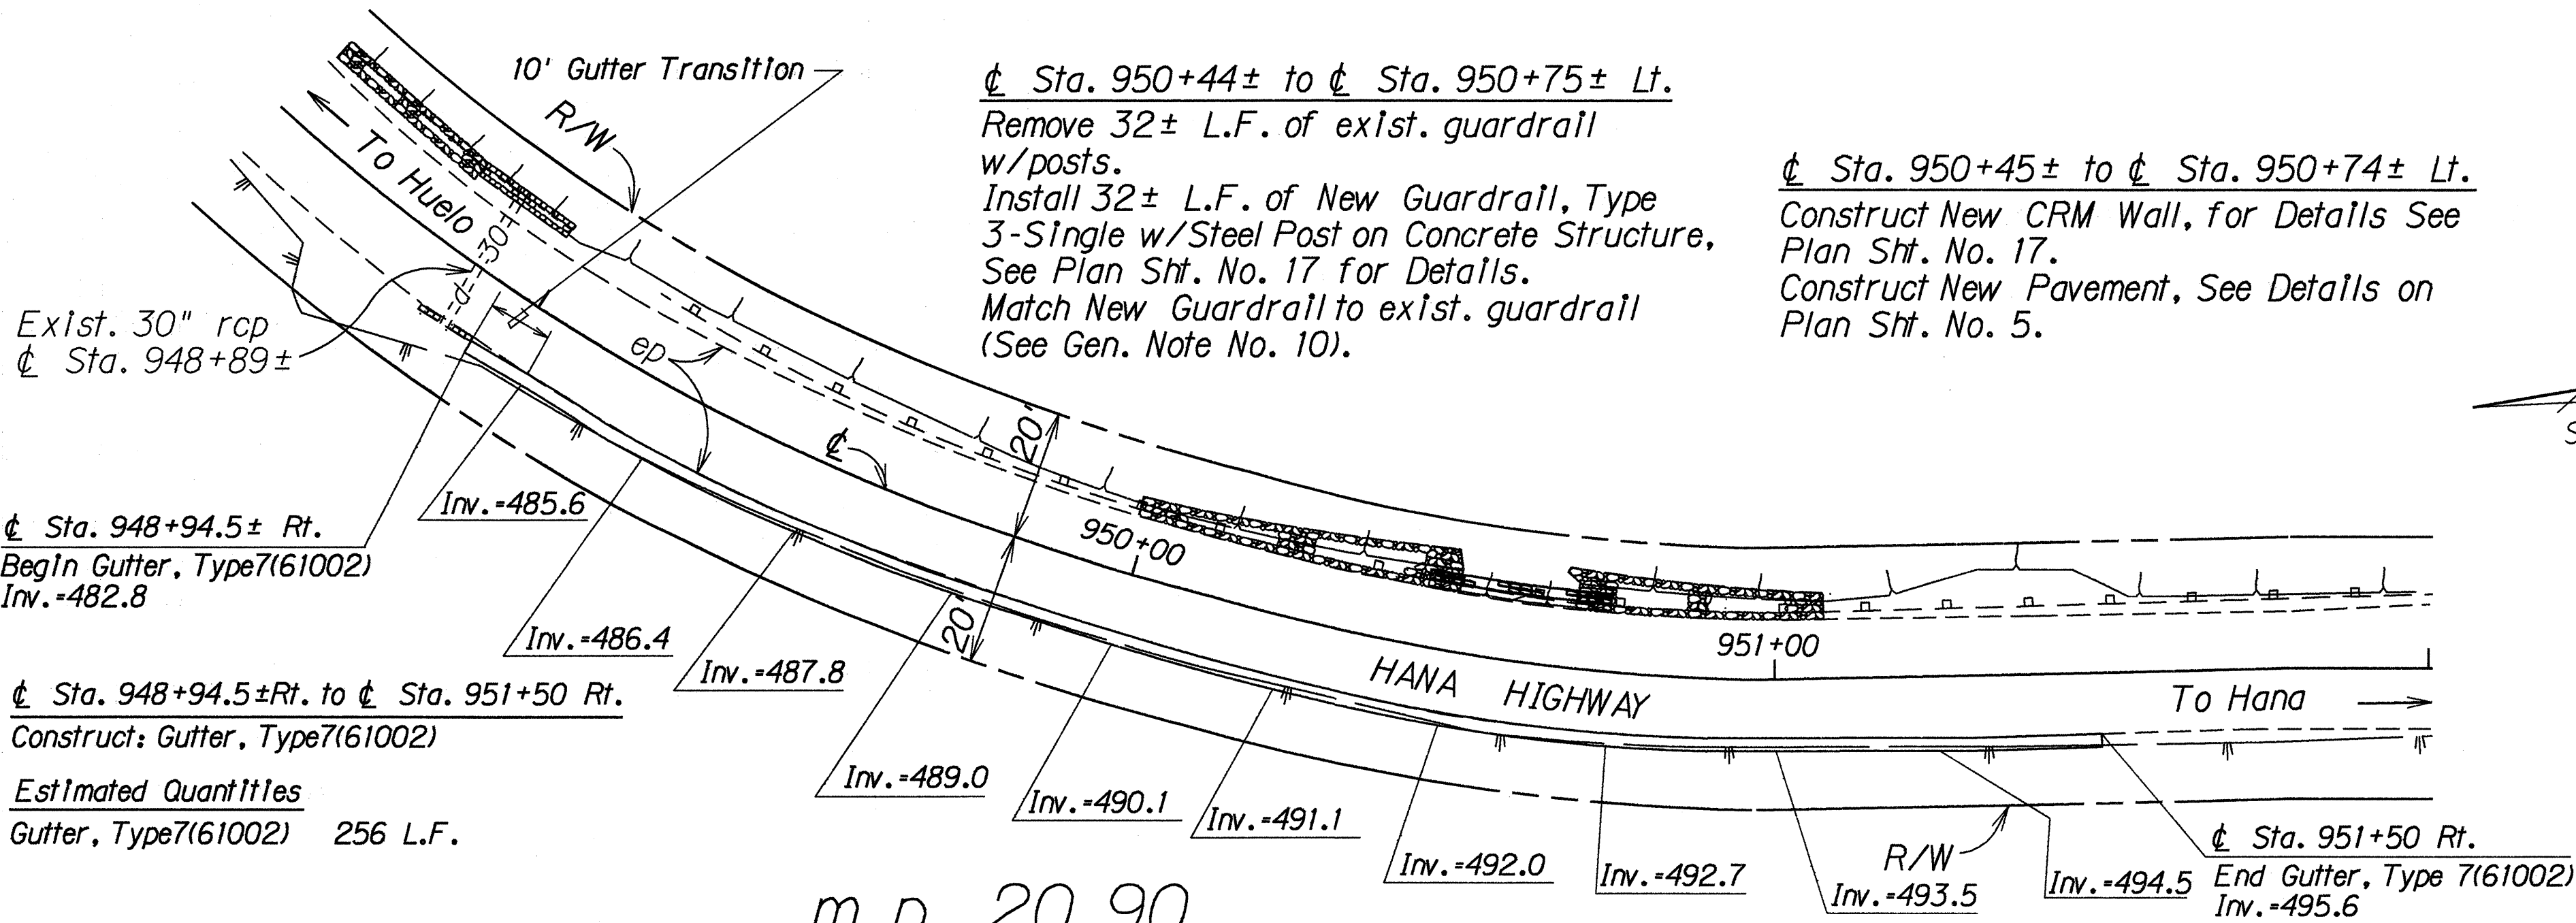

m.p. 20.90

LEGEND FOR AS-BUILT POSTINGS	
	Squiggly line for as-built deletion
	Double line for as-built deletion
Roadway	Text for as-built posting

STATE OF HAWAII DEPARTMENT OF TRANSPORTATION HIGHWAYS DIVISION	
PLAN	
HANA HWY. STORM DAMAGE REPAIRS	
Huelo Towards Nāhiku	
PROJ. NO. 360AB-01-92	
Scale: 1" = 20'	Date: May, 1992
SHEET No. 6 OF 6 SHEETS	

"AS-BUILT"