INDEX TO DRAWINGS	
SHEET NO.	DESCRIPTION
1	TITLE SHEET
2	STANDARD PLANS SUMMARY
3	GENERAL NOTES AND LEGEND
4	TYPICAL SECTIONS AND DETAILS
5 – 9	ROADWAY PLANS
10 – 12	MODIFIED ECCENTRIC LOADER
	TERMINAL (MELT) DETAILS
13	PAVEMENT MARKING LEGEND,
	DETAILS AND NOTES
14 – 18	SIGNING AND PAVEMENT
	MARKING PLAN
19	TRAFFIC SUMMARIES

STATE OF HAWAII


DEPARTMENT OF TRANSPORTATION


HIGHWAYS DIVISION
HONOLULU, HAWAII
"AS-BUILT"
PLANS FOR

HANA HIGHWAY RESURFACING

OILOWAI BRIDGE TO KALAHU PROJECT NO. 360B-01-96M

DISTRICT OF HANA
ISLAND OF MAUI

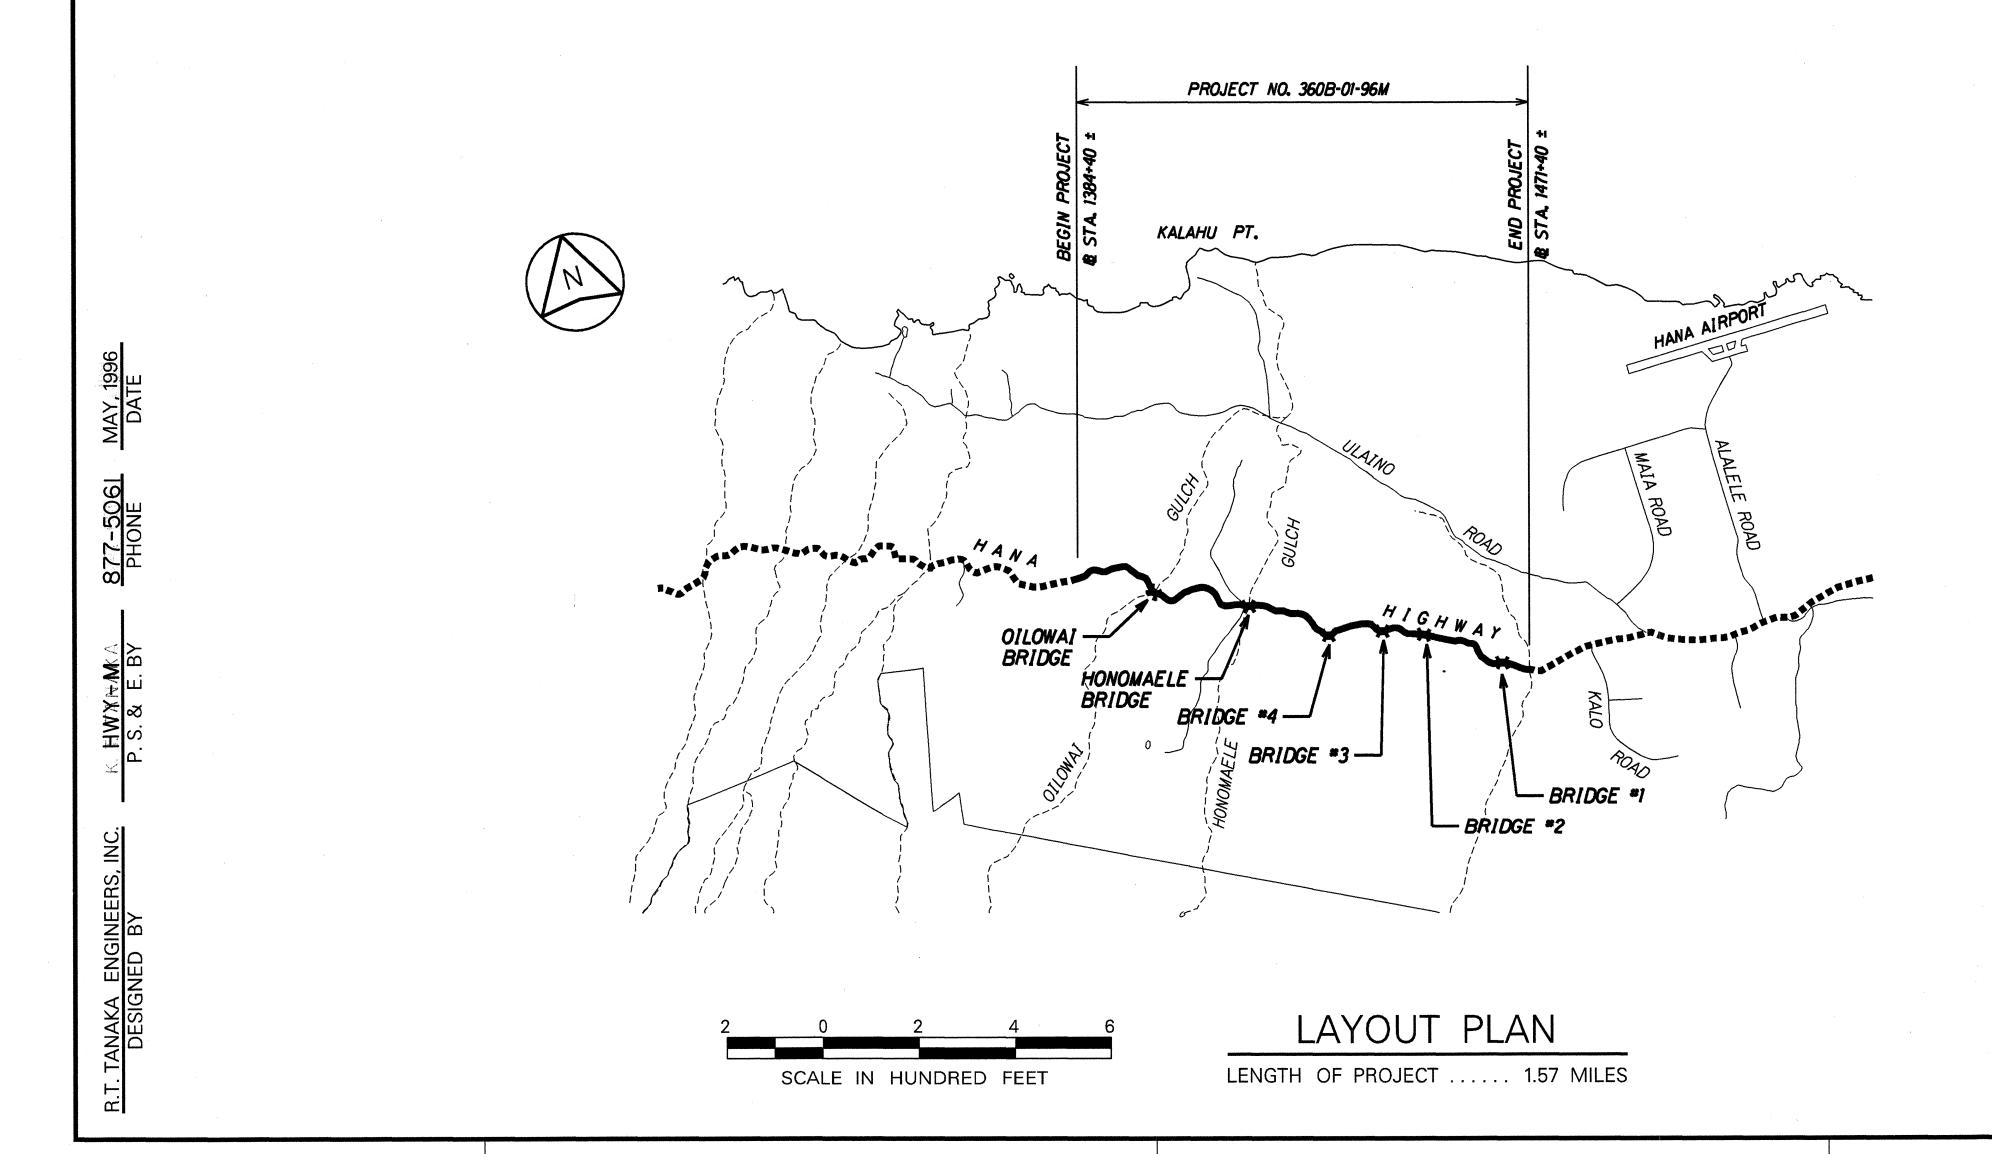

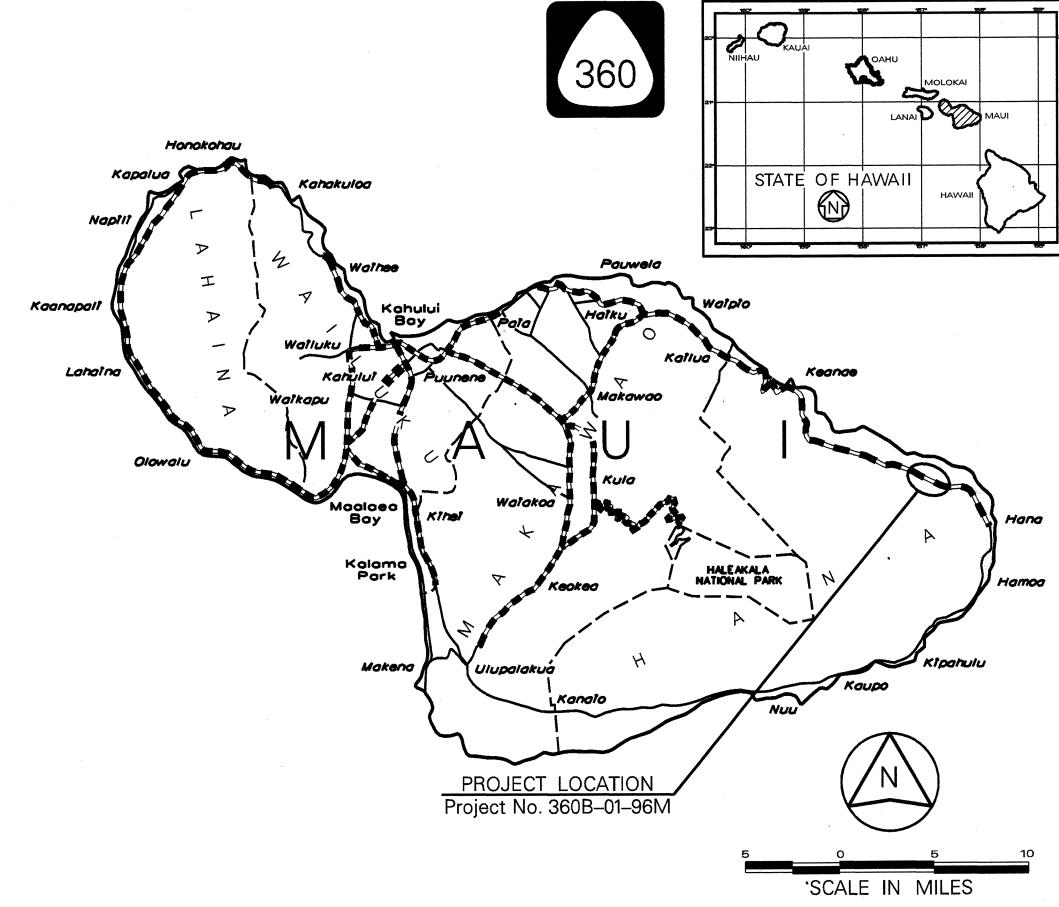

FED. ROAD DIST. NO. FISCAL YEAR

360B-01-96M

FEDERAL AID PROJECTS PREVIOUSLY CONSTRUCTED OR UNDER CONSTRUCTION

MILE POST 29.04 TO MILE POST 30.61

NO SIGNIFICANT CHANGES WERE MADE DURING CONSTRUCTION ON THESE PLANS EXCEPT CHANGES IN THE ORIGINAL THEORETICAL QUANTITIES. FOR ACTUAL QUANTITIES, REFER TO PROJECT LEDGER AND/OR COMPUTATION BOOK.

FOR RESIDENT ENGINEER

DEPARTMENT OF TRANSPORTATION
STATE OF HAWAII

APPROVED:

Lazis bayashida 5/22/96

DIR. OF TRANSPORTATION DATE

1