	INDEX TO DRAWINGS
SHEET NO.	DESCRIPTION
1	TITLE SHEET
2	STANDARD PLANS SUMMARY
3	GENERAL NOTES AND LEGEND
4	TYPICAL SECTIONS AND DETAILS
5 - 16	ROADWAY PLANS
17	PAVEMENT MARKING LEGEND, DETAILS AND NOTES
18 - 29	SIGNING AND PAVEMENT MARKING PLAN
30	SIGN DETAILS
31 - 32	MISCELLANEOUS SUMMARY
33	CURVE DATA

SCALE IN THOUSAND FEET

STATE OF HAWAII

DEPARTMENT OF TRANSPORTATION


HIGHWAYS DIVISION HONOLULU, HAWAII

"AS-BUILT"


PLANS FOR


HANA HIGHWAY RESURFACING VICINITY OF HONOMANU BRIDGE TO WAILUA ROAD PROJECT NO. 360AB-01-98M

DISTRICT OF HANA ISLAND OF MAUI

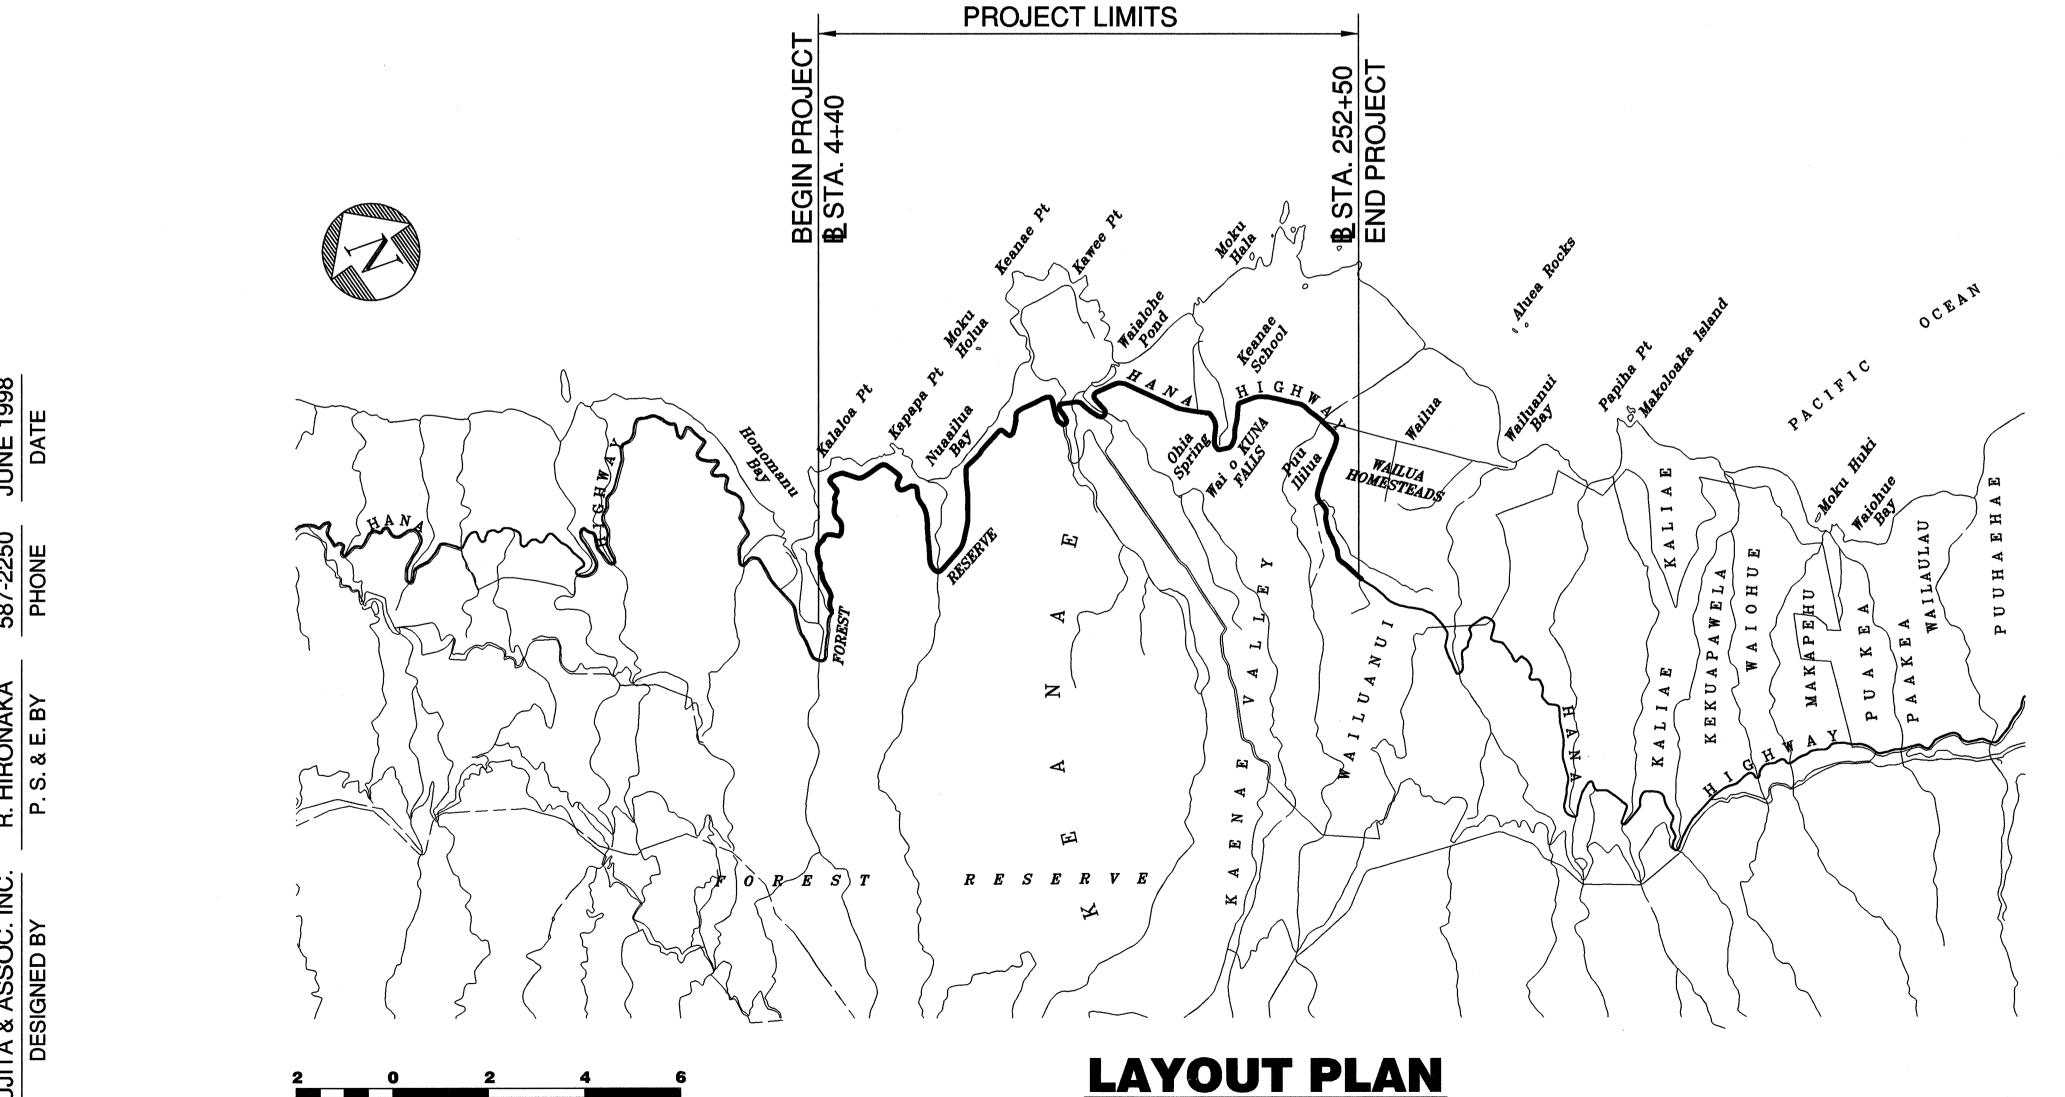

FISCAL SHEET TOTAL YEAR NO. SHEETS PROJ. NO. HAW. 360AB-01-98M 1998

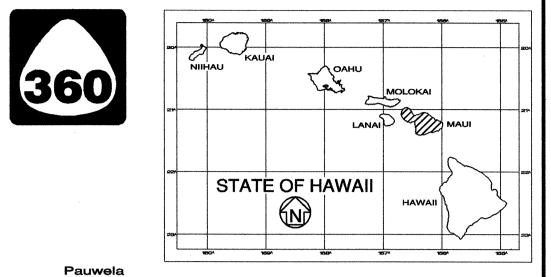

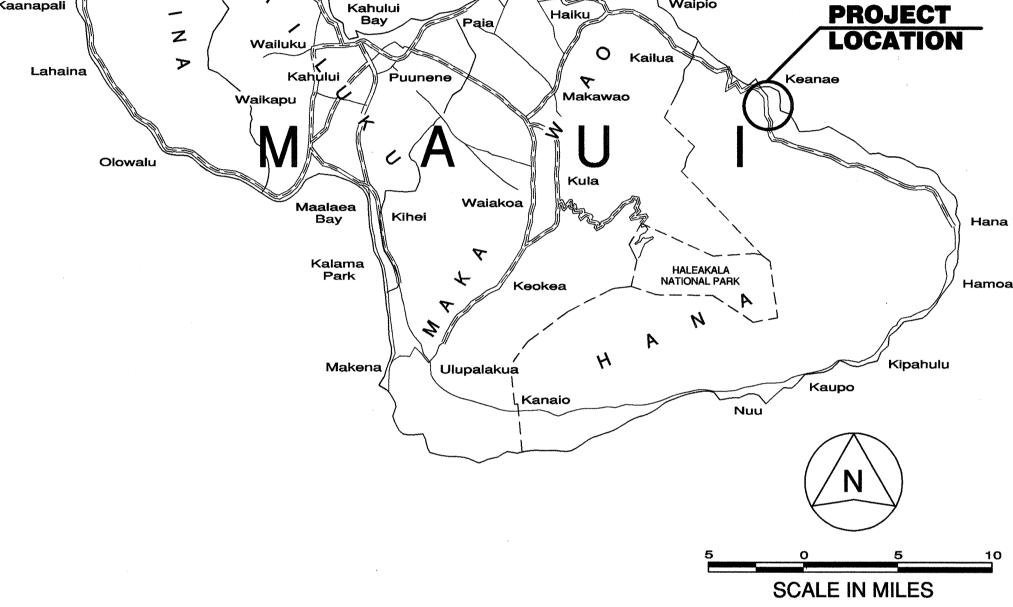

FEDERAL AID PROJECTS PREVIOUSLY CONSTRUCTED OR UNDER CONSTRUCTION

> MILE POST 14.04 TO MILE POST 18.74

STATE OF HAWAII **APPROVED:**

NET LENGTH OF PROJECT.....4.70 MILES

DIR. OF TRANSPORTATION

DEPARTMENT OF TRANSPORTATION