


INDEX TO DRAWINGS	
SHEET NO.	DESCRIPTION
1	TITLE SHEET
2	LAYOUT PLANS
3	STANDARD PLANS SUMMARY
4	TYPICAL ACCELERATION AND DECELERATION LANE MARKINGS
5	PAVEMENT MARKING LEGEND DETAILS AND GENERAL NOTES
6 - 21	SIGNING AND PAVEMENT MARKING PLANS
22 - 23	STRIPING & RAISED PAVEMENT MARKINGS SUMMARY
24	STRIPING, RAISED PAVEMENT & MISCELLANEOUS SUMMARIES


STATE OF HAWAII
DEPARTMENT OF TRANSPORTATION
HIGHWAYS DIVISION
HONOLULU, HAWAII
"AS-BUILT" PLANS FOR
**PIILANI HIGHWAY, NORTH KIHAI ROAD
AND HANA HIGHWAY**
PAVEMENT MARKING AND STRIPING
PROJECT NO. HWY-M-01-98M

DISTRICTS OF MAKAWAO, WAILUKU AND HANA
ISLAND OF MAUI

PROJECT LOCATION
Project No. HWY-M-01-98M

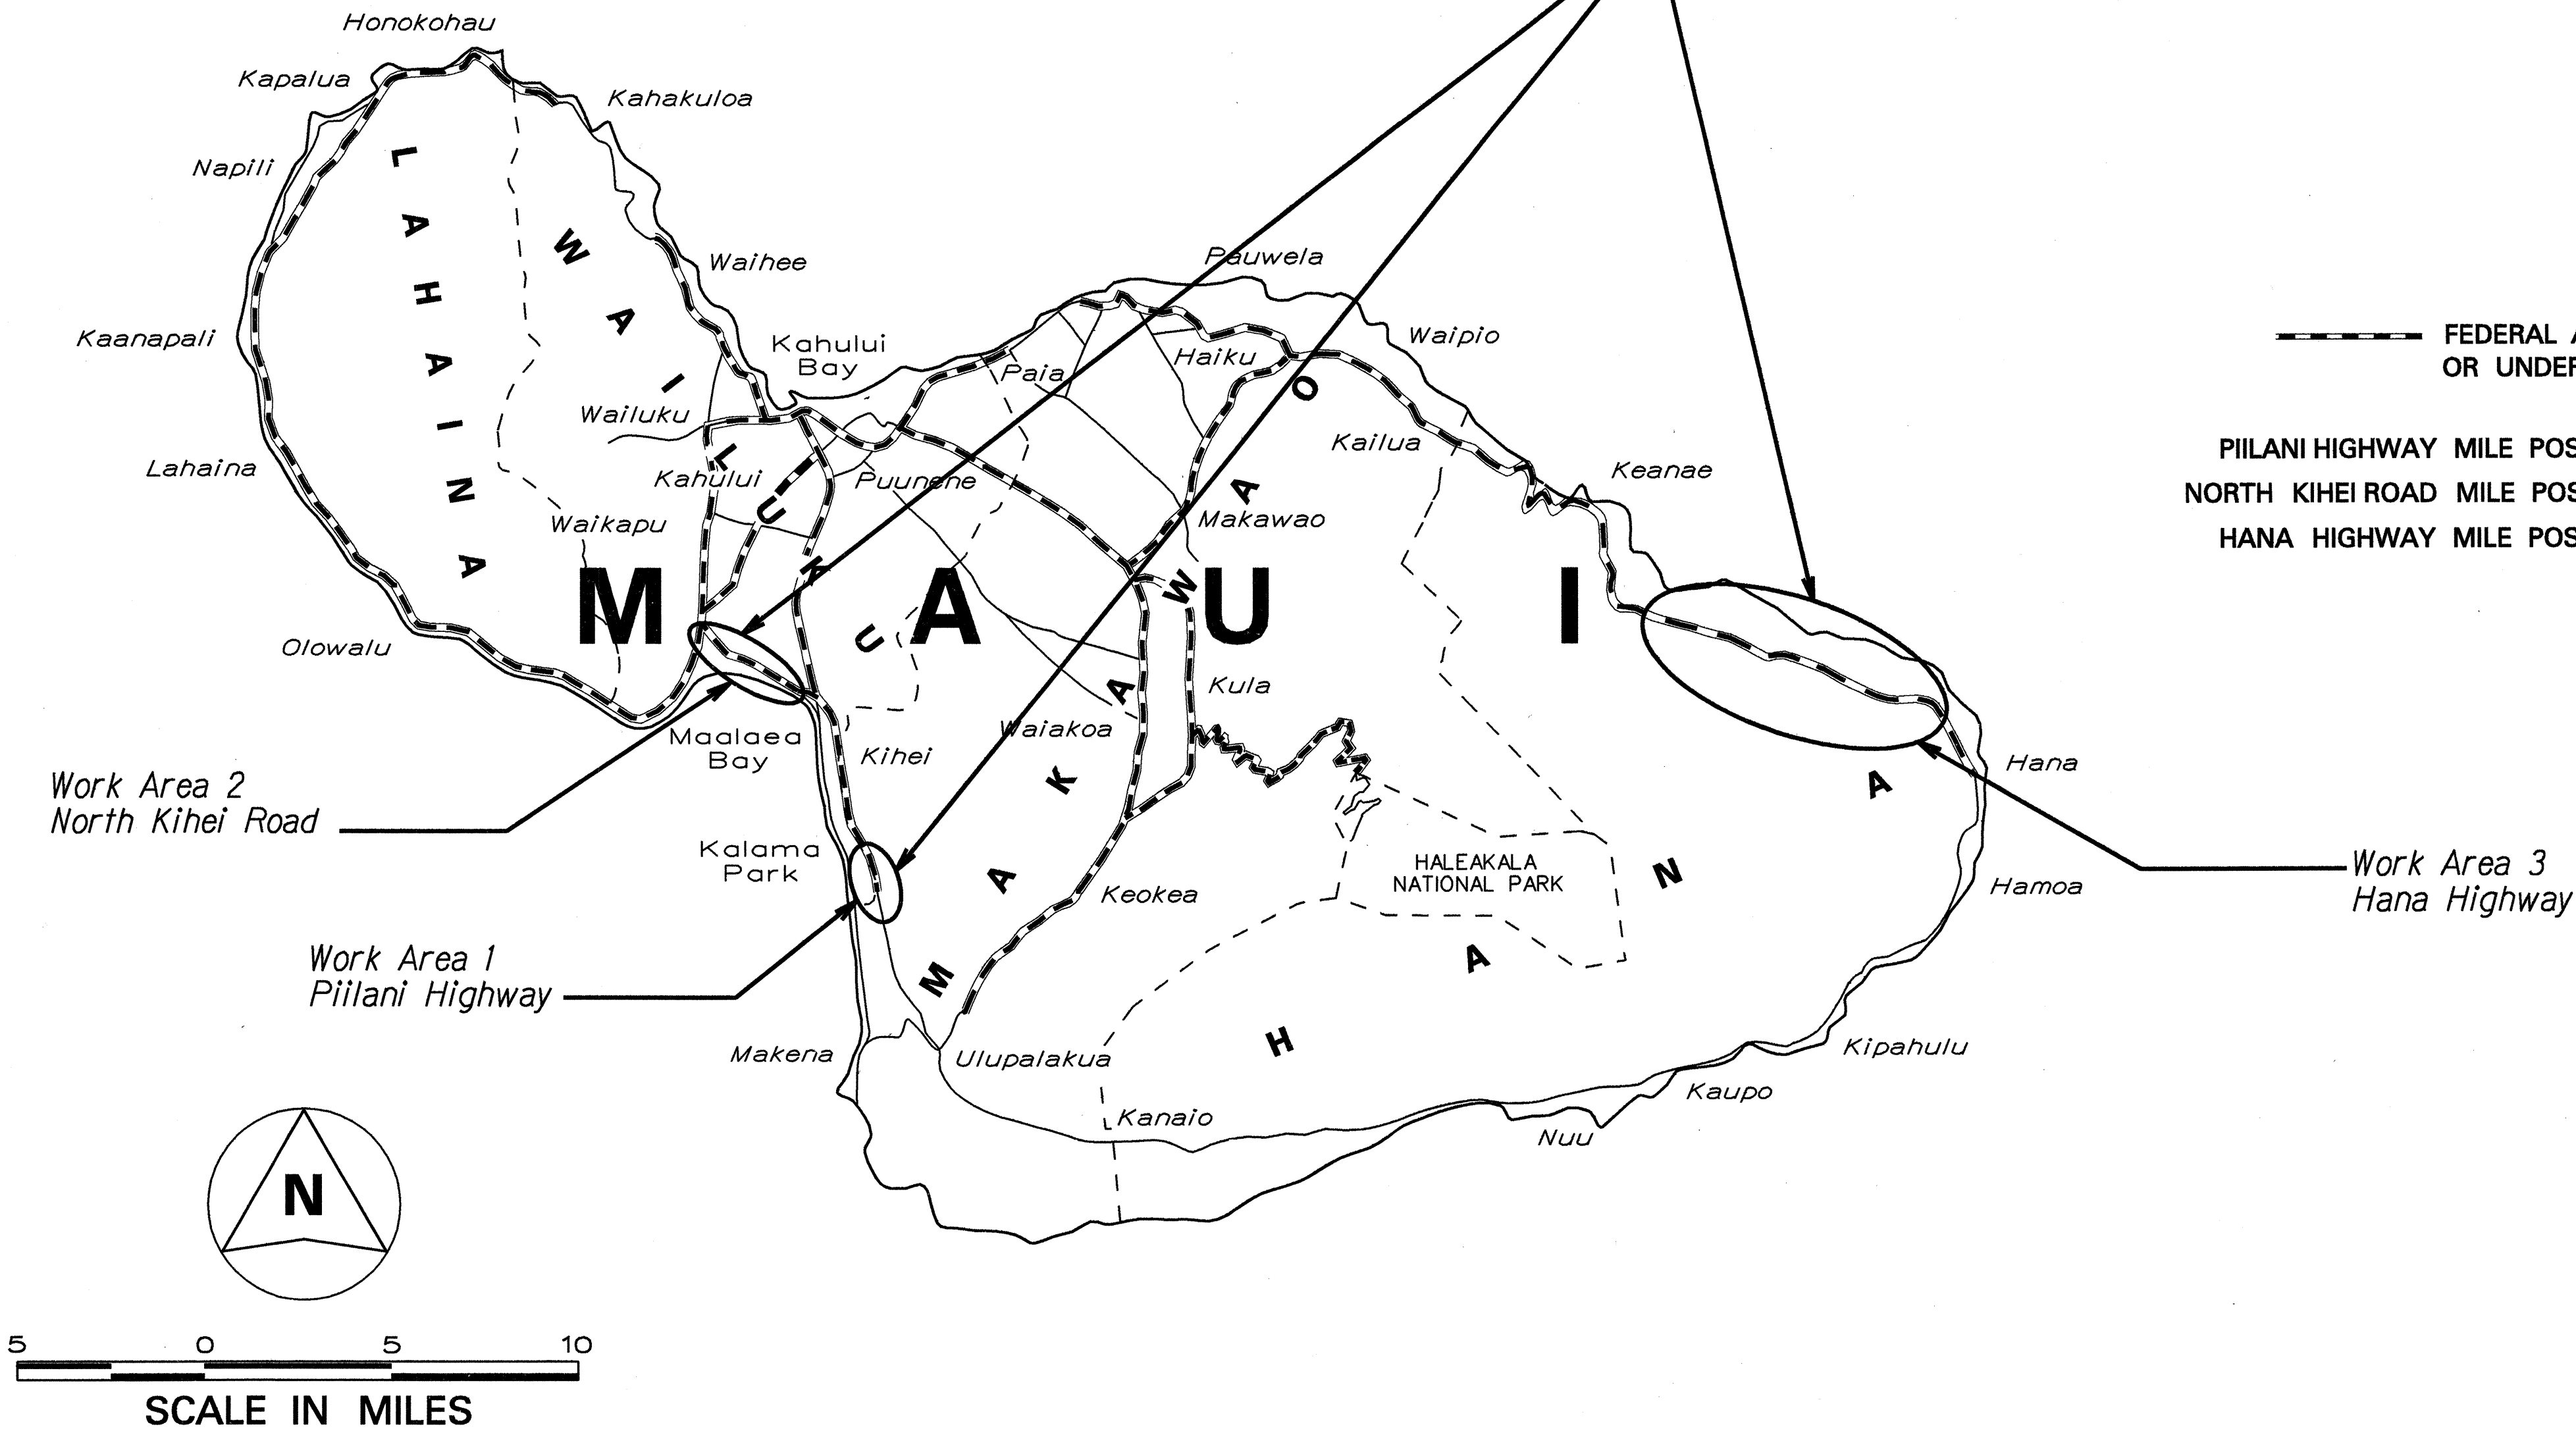

FED. ROAD DIST. NO.	STATE	PROJ. NO.	FISCAL YEAR	SHEET NO.	TOTAL SHEETS
HAWAII	HAW.	HWY-M-01-98M	1998	1	24

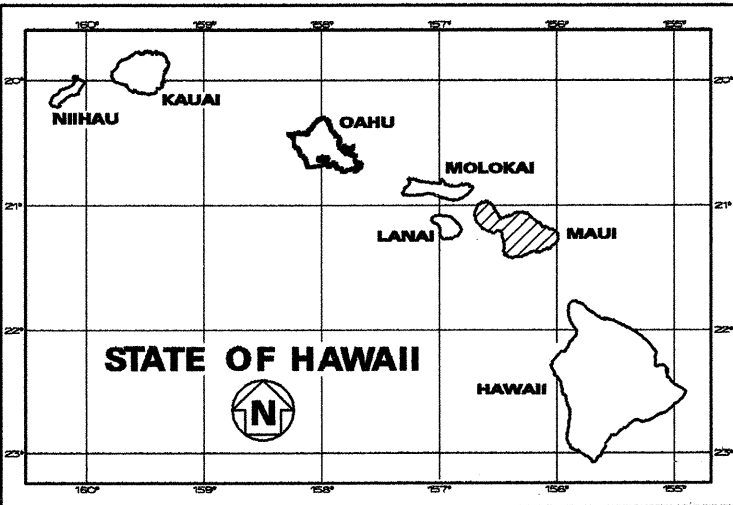

HWY-M
DESIGNED BY
R. HIRONAKA
P. S. & E. BY
587-2250
PHONE
APRIL, 1998
DATE

NO SIGNIFICANT CHANGES WERE MADE DURING CONSTRUCTION ON THESE PLANS EXCEPT CHANGES IN THE ORIGINAL THEORETICAL QUANTITIES. FOR ACTUAL QUANTITIES, REFER TO PROJECT LEDGER AND/OR COMPUTATION BOOK.

Robert F. Funch June 9, 2003
RESIDENT ENGINEER DATE

DEPARTMENT OF TRANSPORTATION STATE OF HAWAII	
APPROVED: <i>Gregory K. Kuykendall</i>	4/27/99
DIR. OF TRANSPORTATION	DATE