


INDEX TO DRAWINGS	
SHEET NO.	DESCRIPTION
1	TITLE SHEET
2	STANDARD PLANS SUMMARY
3	GENERAL NOTES & LEGEND
4	TYPICAL SECTION AND DETAIL
① 5	PLAN
6	PROFILE
7	DRAINAGE PLAN
8	DRAINAGE PROFILE
9 - 11	DRAINAGE DETAILS
12 - 18	CROSS SECTIONS
19	TRAFFIC CONTROL PLAN
20	TRAFFIC STRIPING PLAN


Sheet No. ①55-1 is a supplementary sheet to this project. Total sheet count after "As-Built" posting 21 sheets.

STATE OF HAWAII
DEPARTMENT OF TRANSPORTATION
HIGHWAYS DIVISION
HONOLULU, HAWAII
"AS-BUILT"
PLANS FOR
HANA HIGHWAY
IMPROVEMENTS AT MILE POST 14.39
PROJECT NO. 360A-04-95
DISTRICT OF HANA
ISLAND OF MAUI


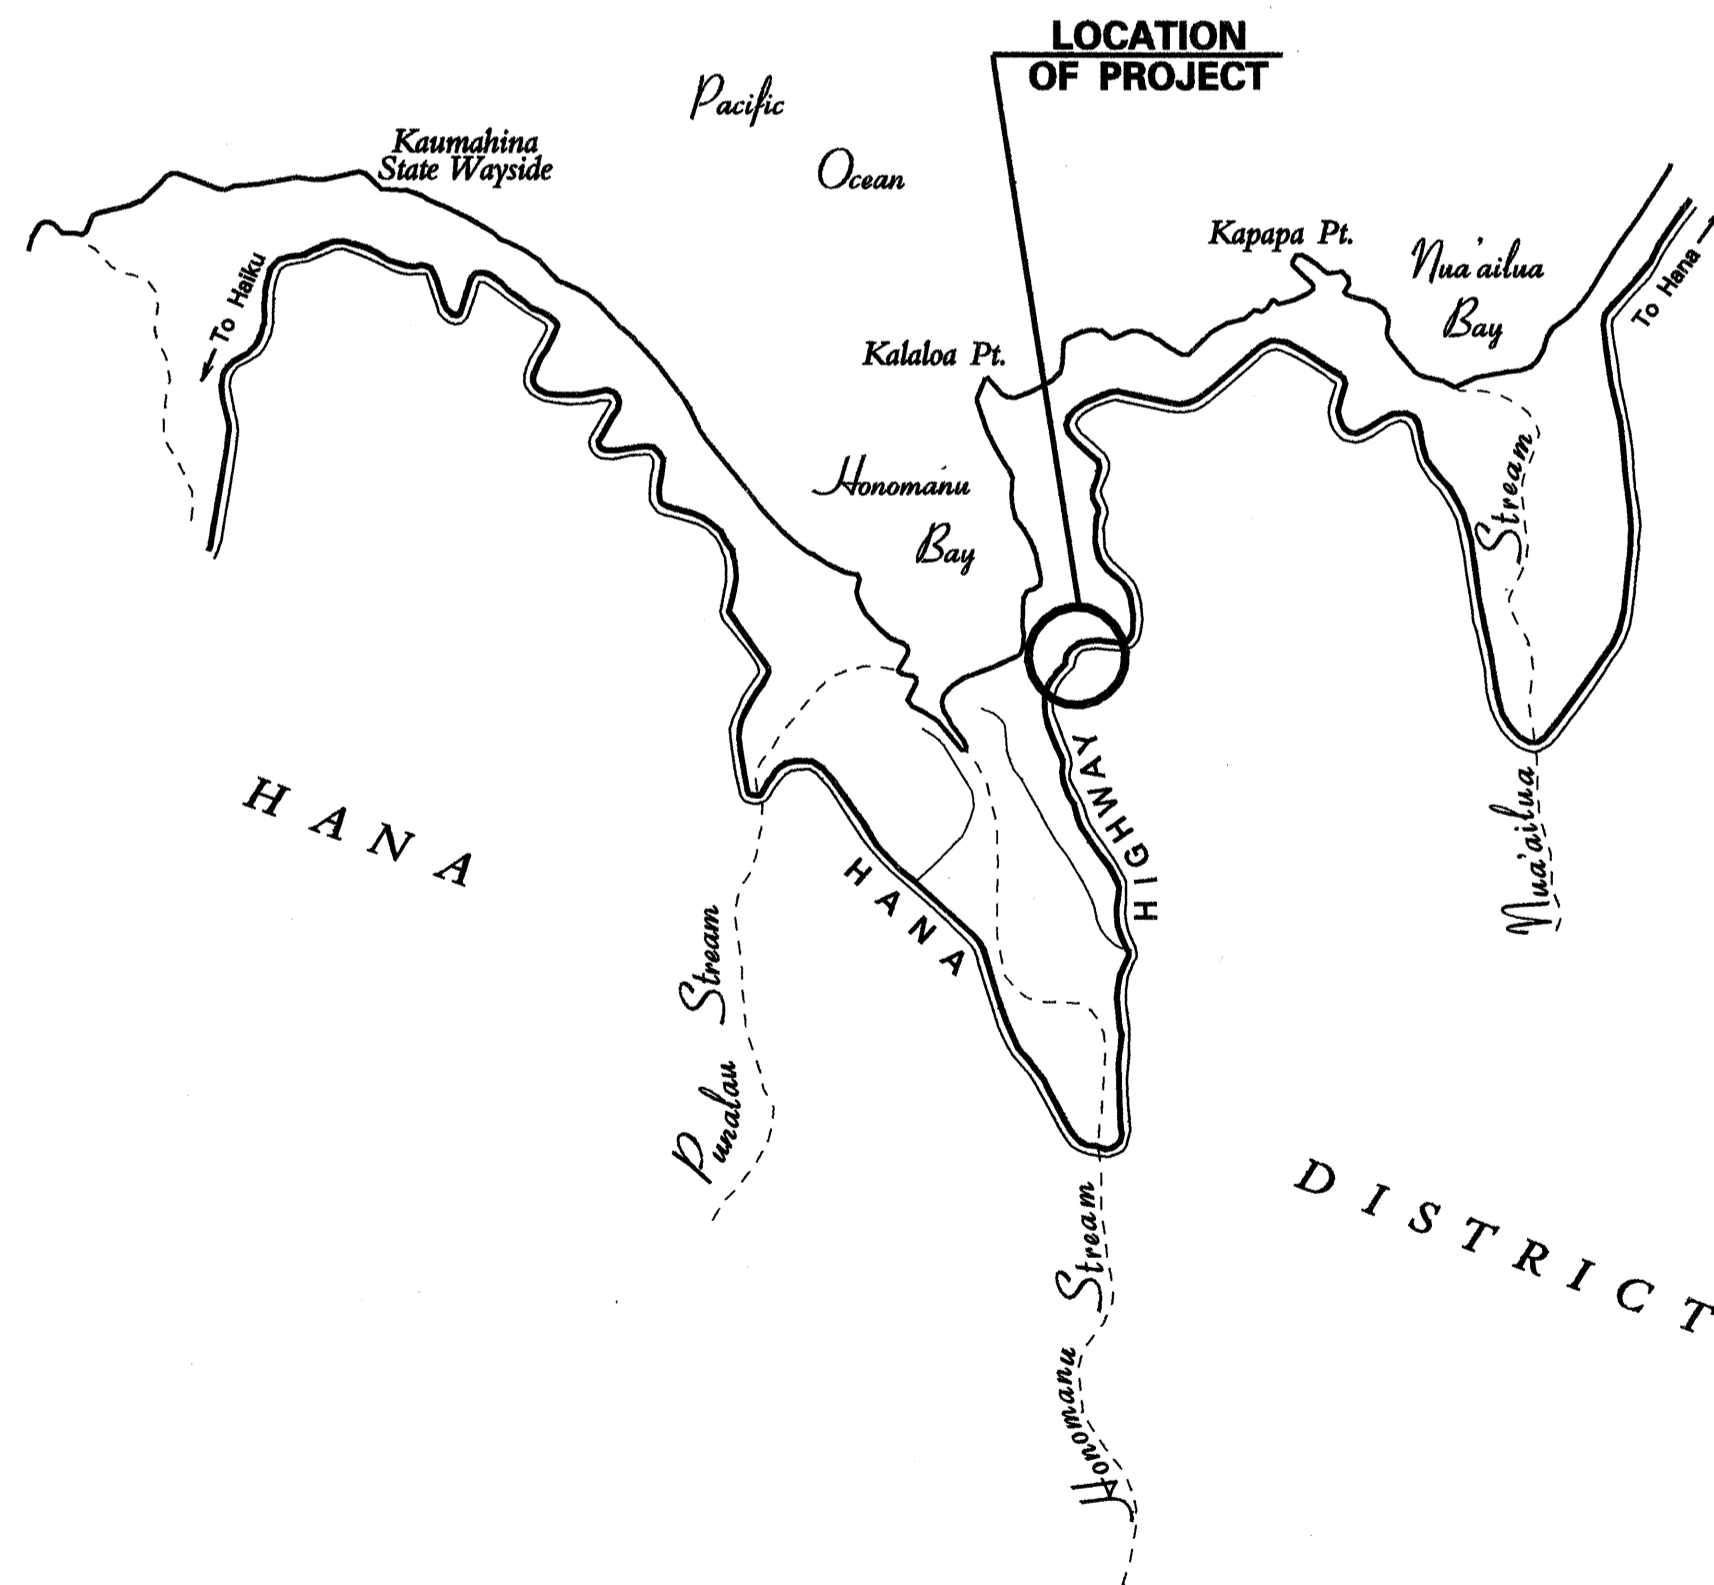


LAYOUT PLAN


GROSS LENGTH OF PROJECT.....0.12 MILES
NET LENGTH OF PROJECT.....0.12 MILES

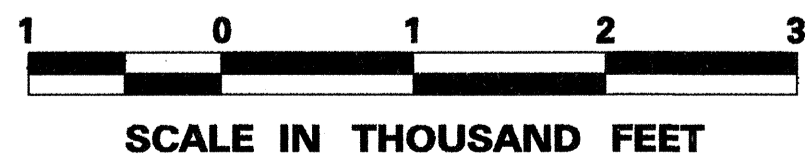

FED. ROAD DIST. NO.	STATE	PROJ. NO.	FISCAL YEAR	SHEET NO.	TOTAL SHEETS
HAWAII	HAW.	360A-04-95	1998	1	20

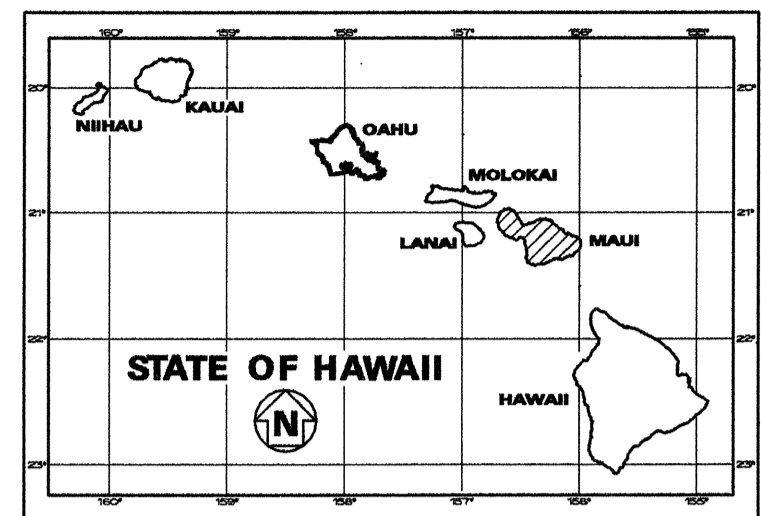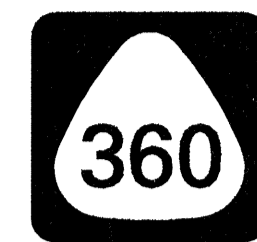

LOCATION OF PROJECT

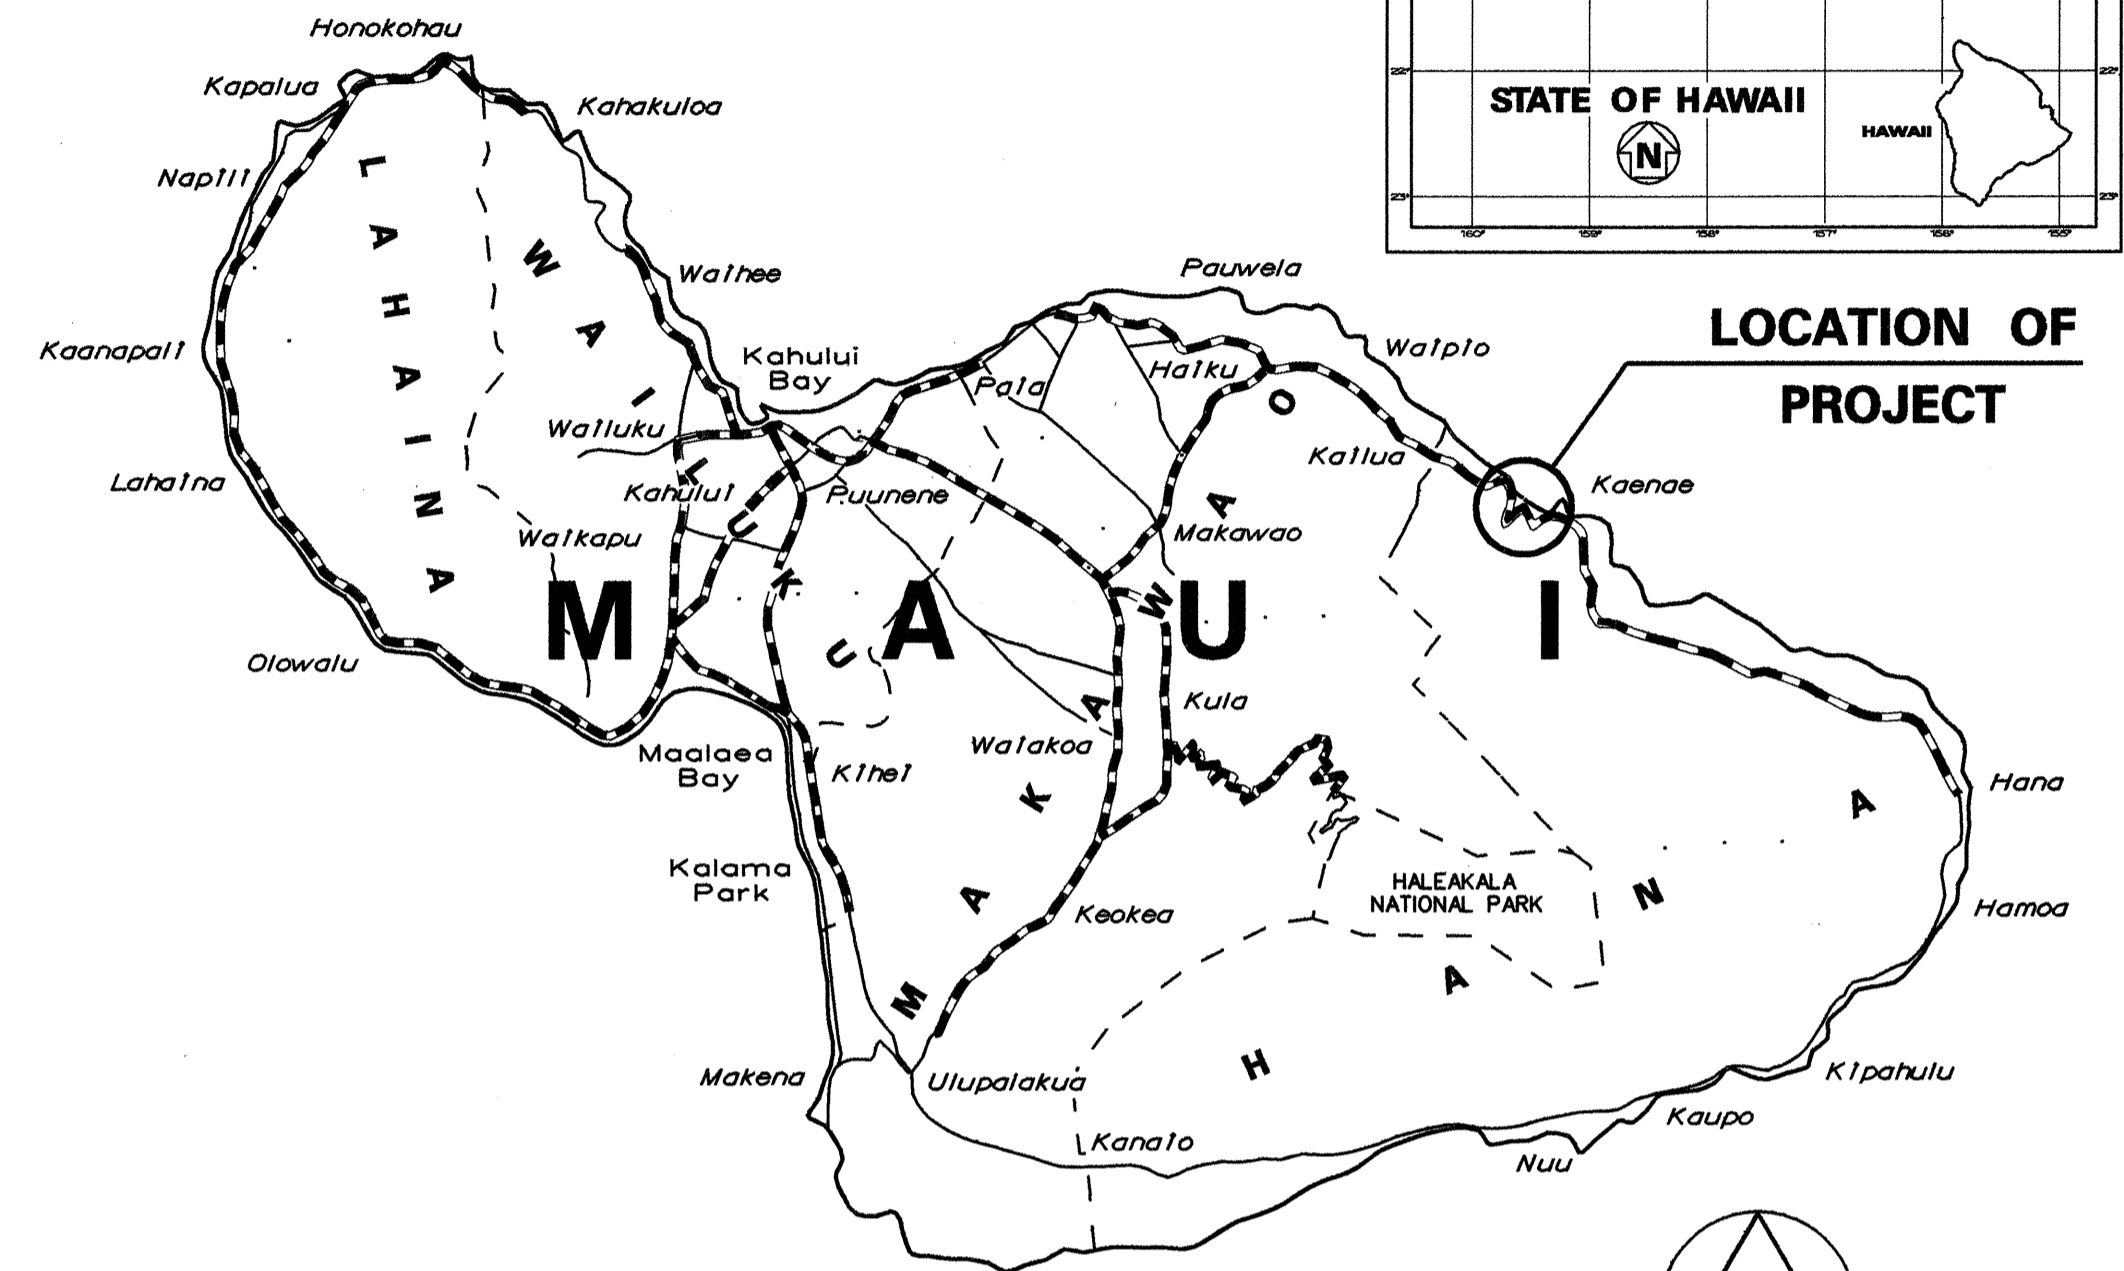

SCALE IN MILES

FEDERAL AID PROJECTS PREVIOUSLY CONSTRUCTED OR UNDER CONSTRUCTION

MILE POST 14.39

CHANGES MADE DURING CONSTRUCTION HAVE BEEN INCORPORATED ON THESE PLANS EXCEPT CHANGES IN THE ORIGINAL THEORETICAL QUANTITIES. FOR ACTUAL QUANTITIES, REFER TO PROJECT LEDGER AND/OR COMPUTATION BOOK.
Resident Engineer 8/12/05 DATE

DEPARTMENT OF TRANSPORTATION
STATE OF HAWAII

APPROVED:
for DIR. OF TRANSPORTATION 4/1/98 DATE

HWY-DD DESIGNED BY KEN TATSUGUCHI P.S. & E.BY JUNE 1998 DATE 587-2244 PHONE