
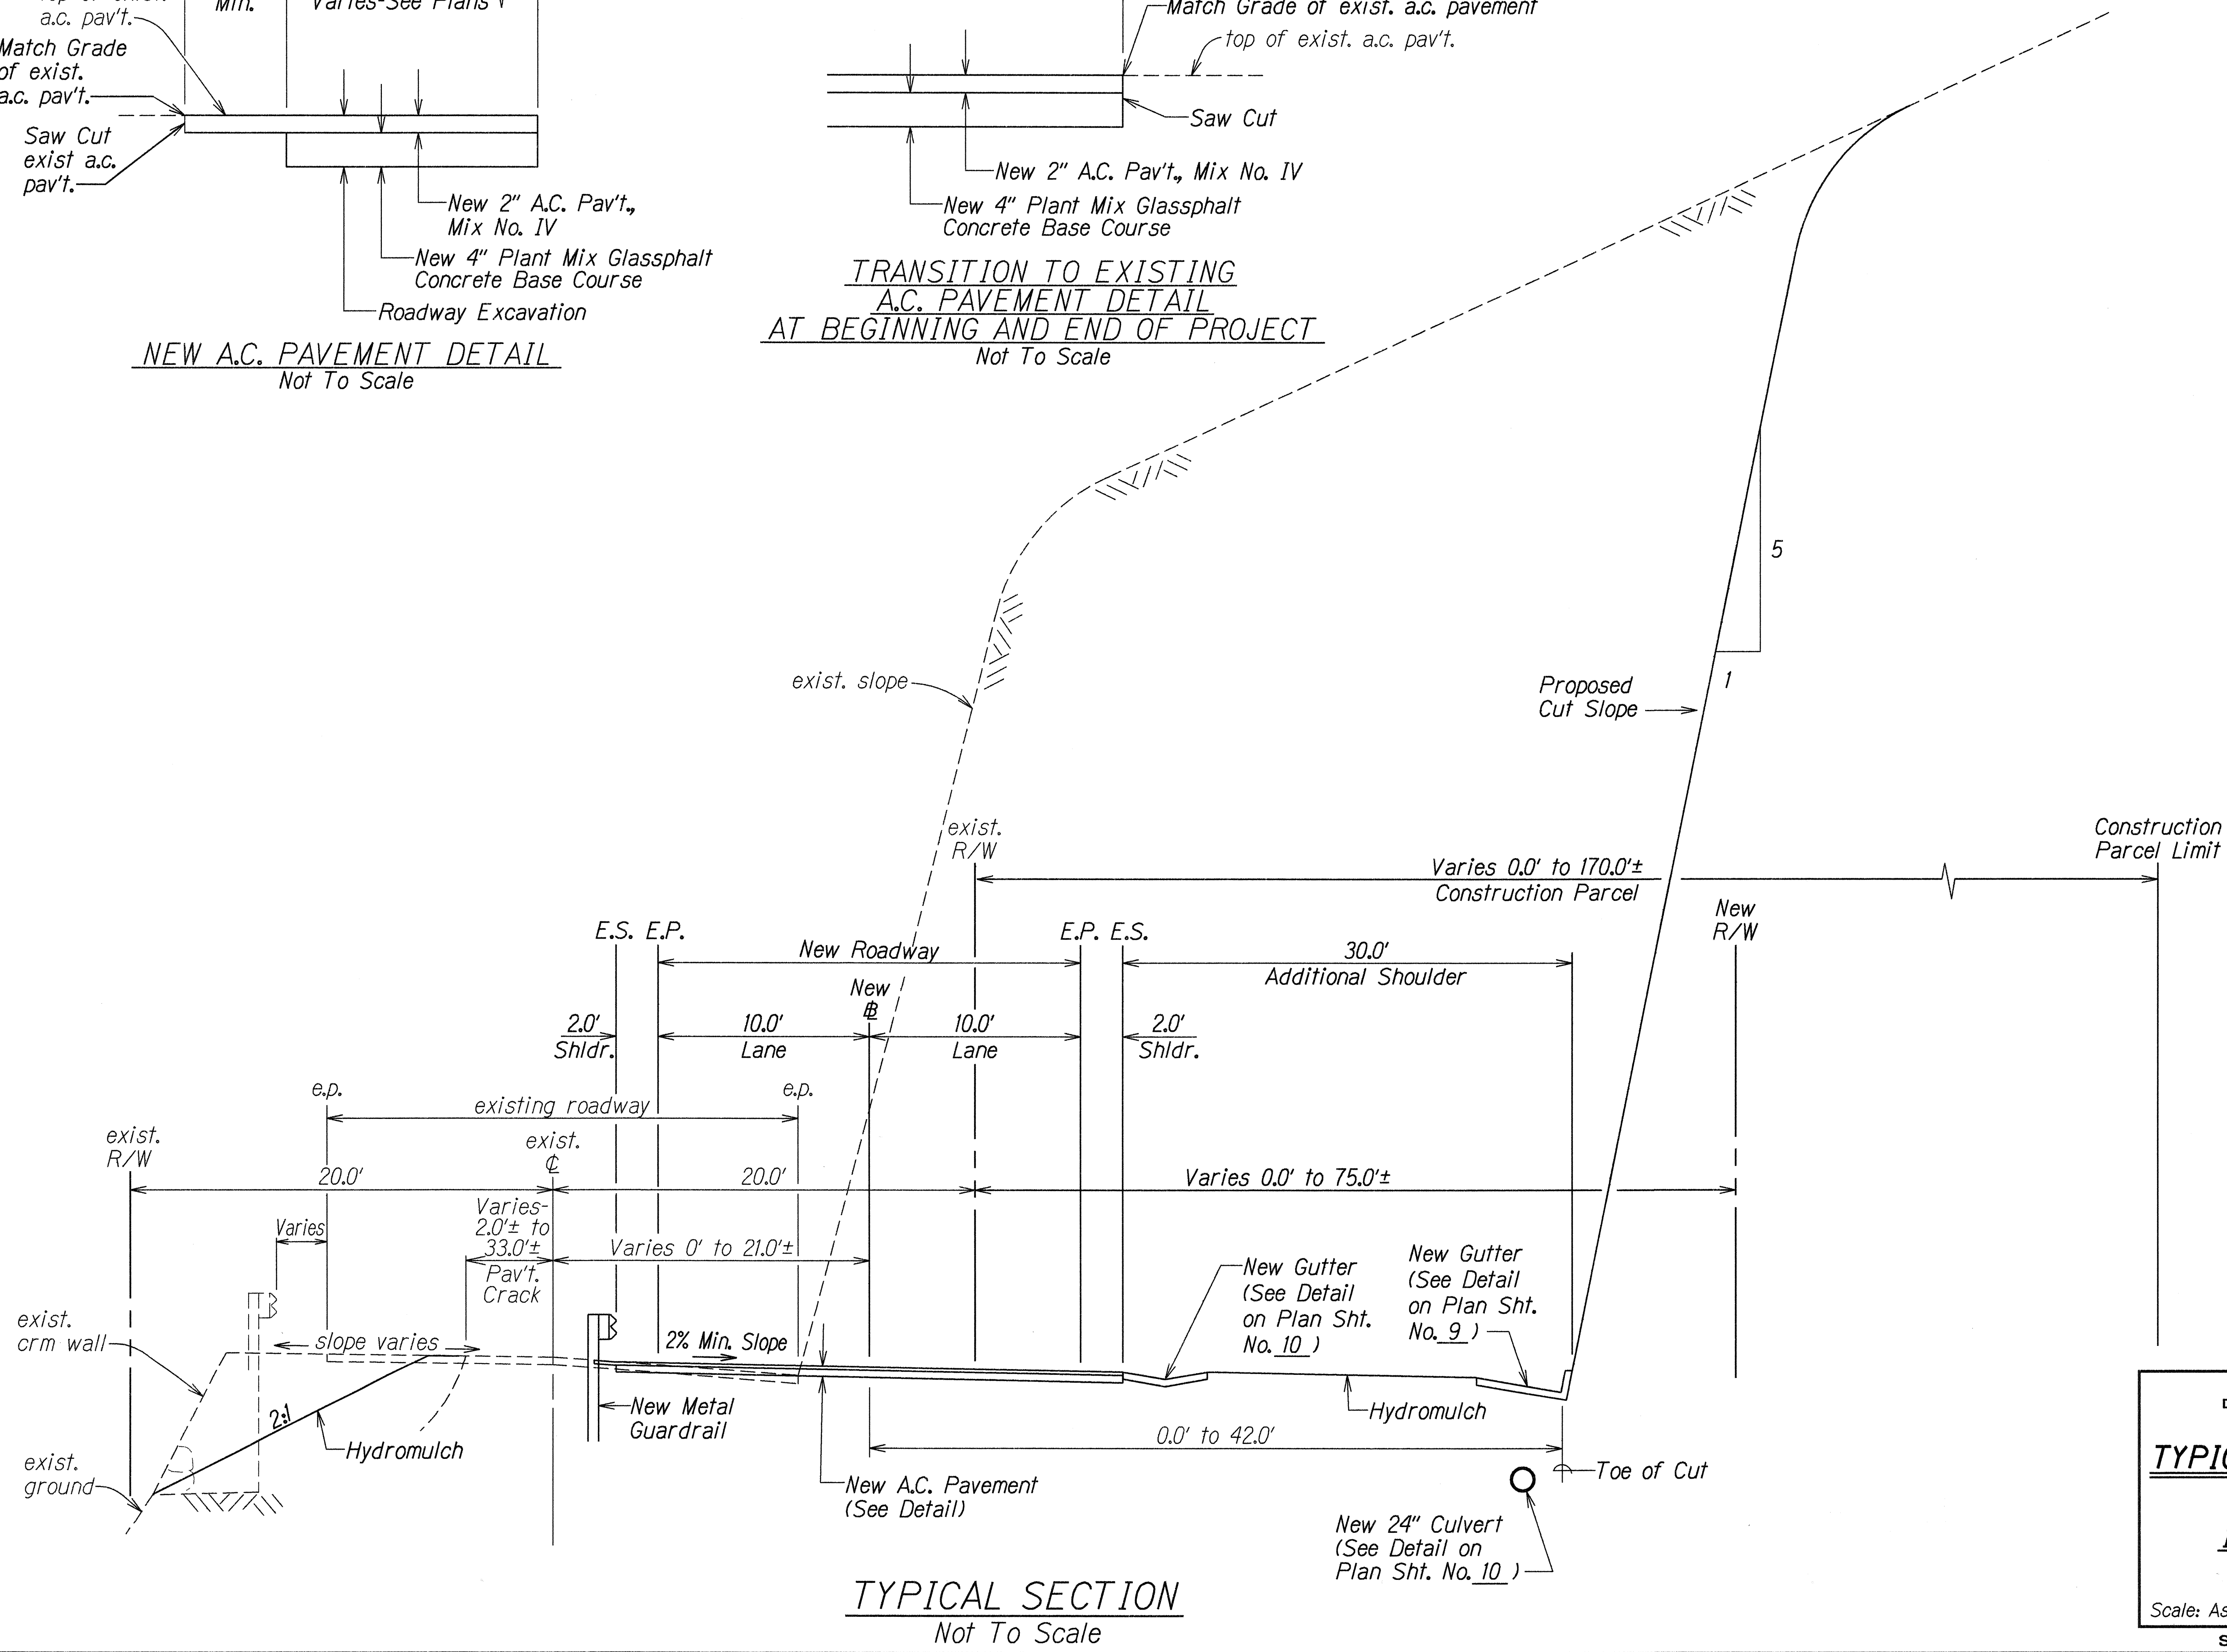
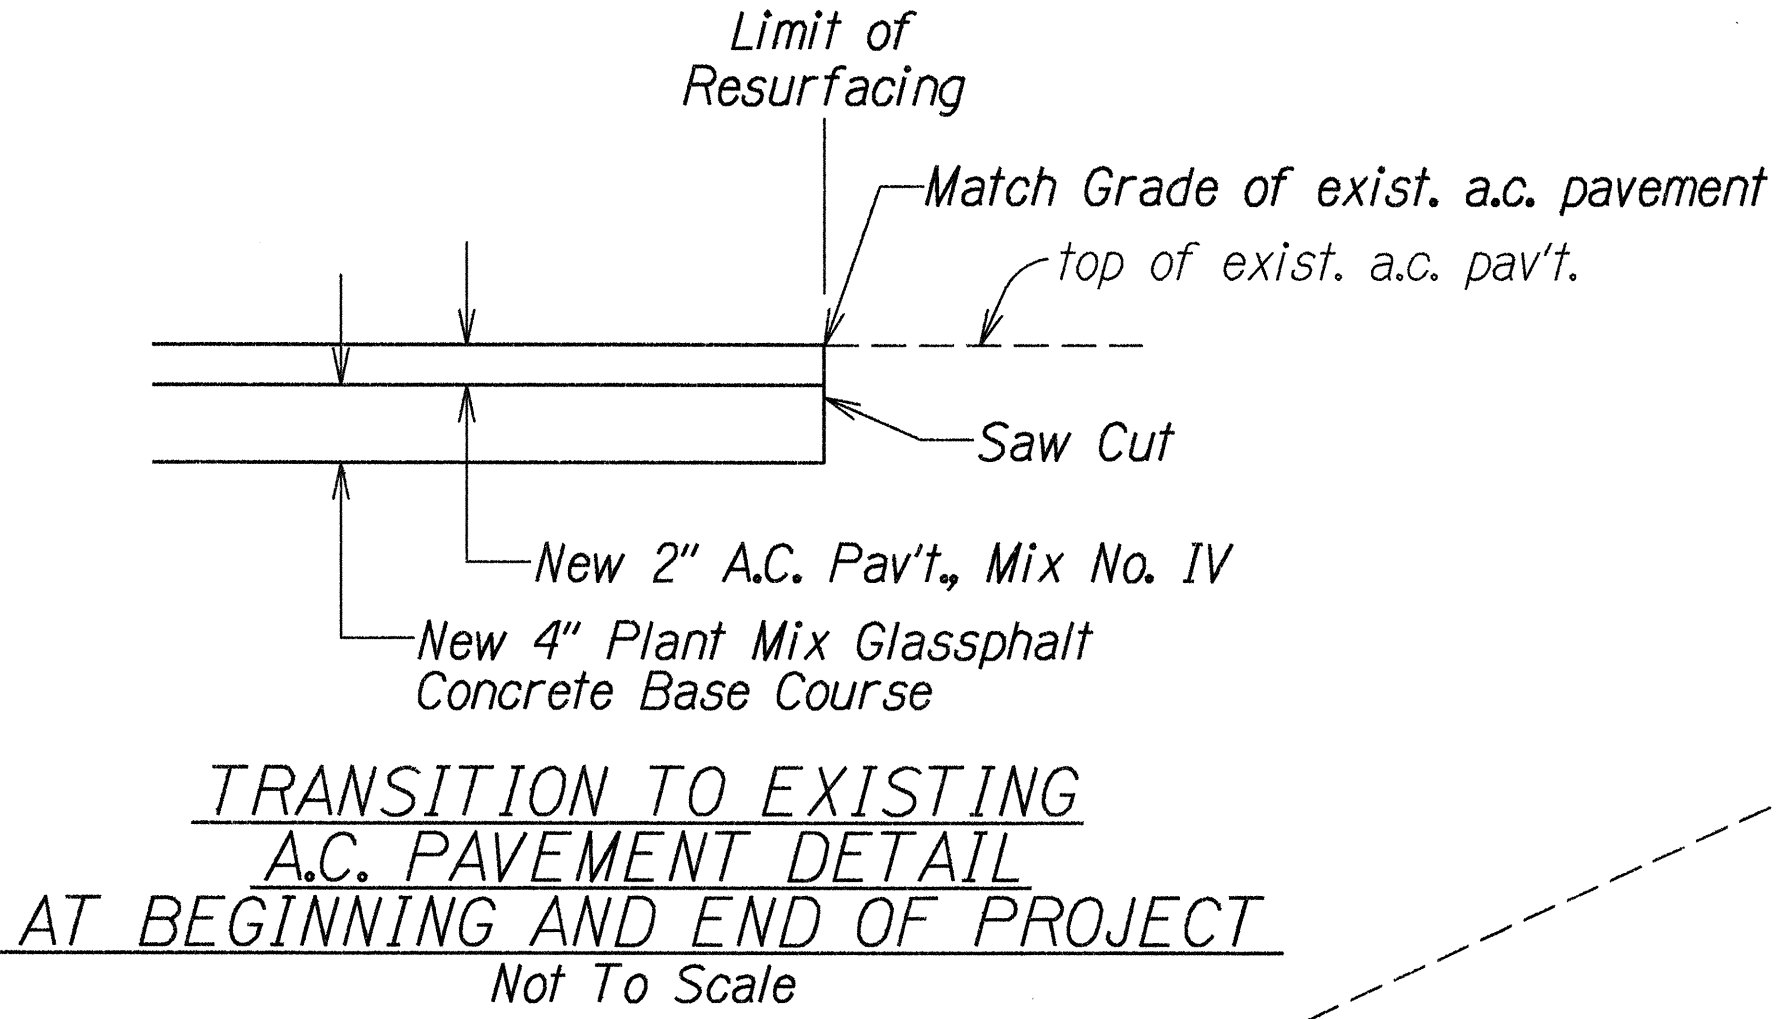


| FED. ROAD DIST. NO. | STATE | PROJ. NO. | FISCAL YEAR | SHEET NO. | TOTAL SHEETS |
|---------------------|-------|------------|-------------|-----------|--------------|
| HAWAII | HAW. | 360A-04-95 | 1998 | 4 | 20 |

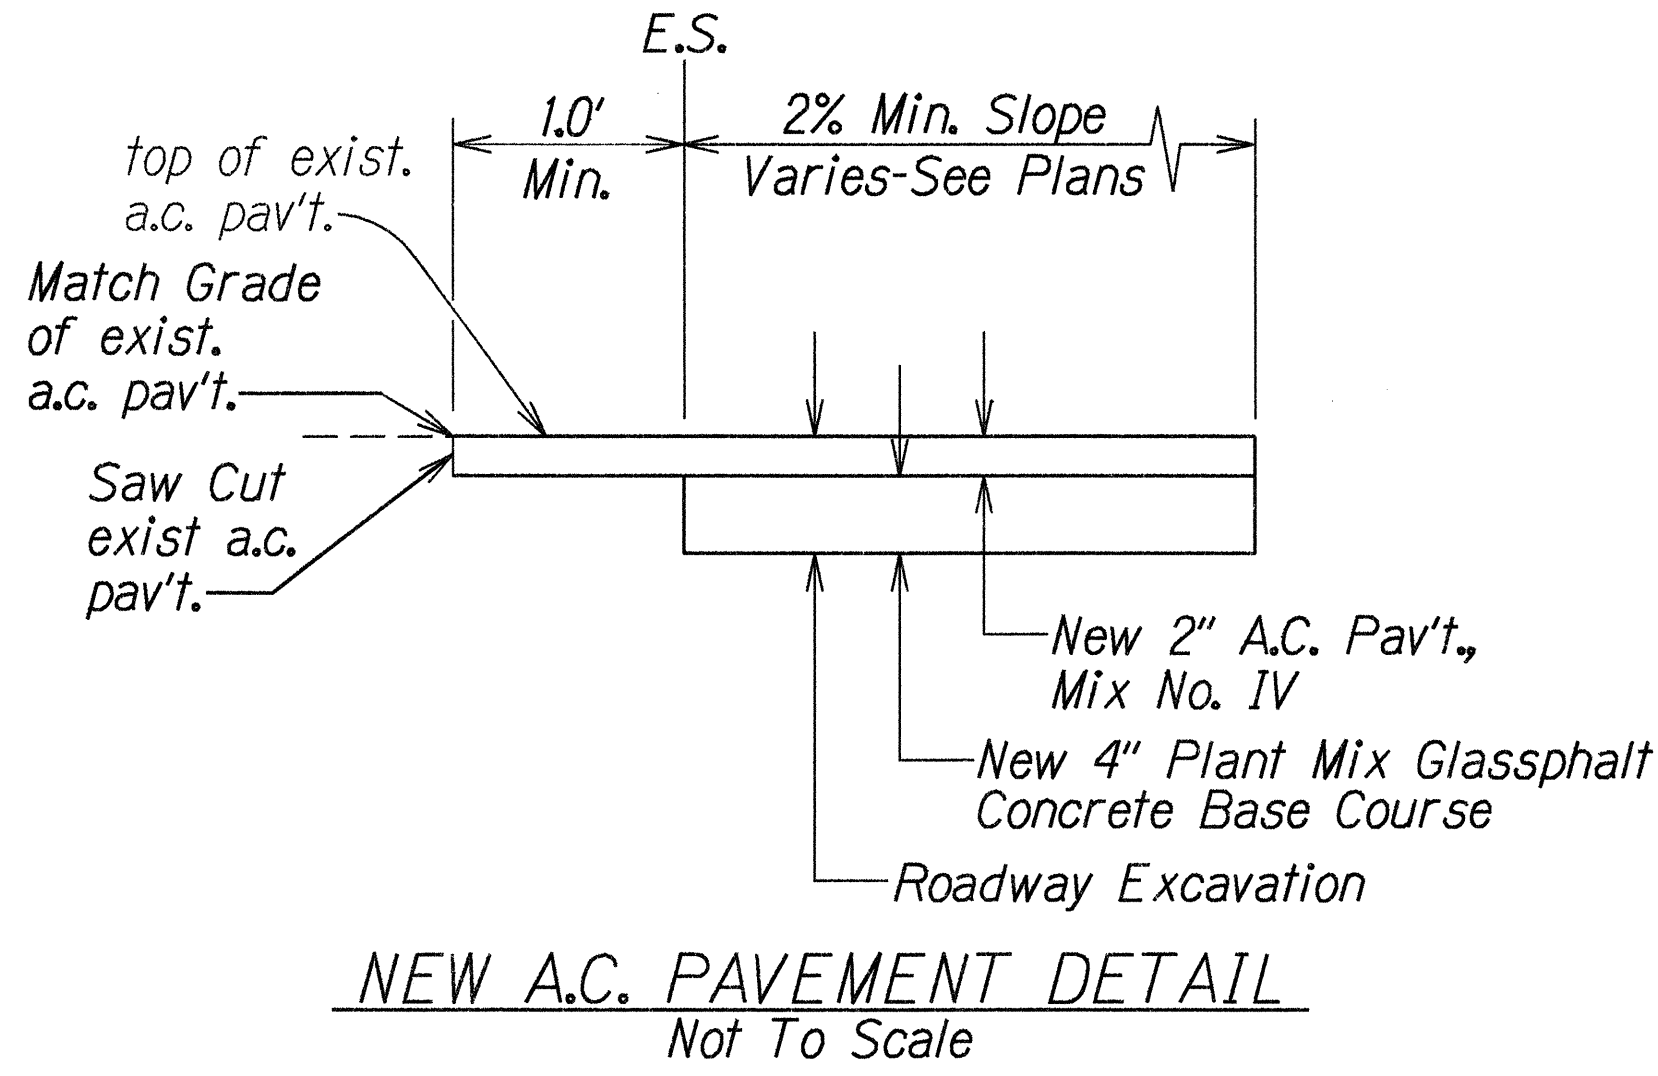

| | |
|-------------------|---------|
| ORIGINAL PLAN | DATE |
| SURVEY PLANNED BY | 11-7-96 |
| DRAWN BY | 16/4/98 |
| DESIGNED BY | |
| NOTES | |
| QUANTITIES BY | |
| CHECKED BY | |

STATE OF HAWAII
DEPARTMENT OF TRANSPORTATION
HIGHWAYS DIVISION

TYPICAL SECTION & DETAIL
HANA HIGHWAY
Improvements At M.P. 14.39
Project No. 360A-04-95
Scale: As Shown
Date: May 1998

SHEET No. 1 OF 1 SHEETS