
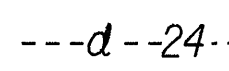
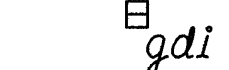
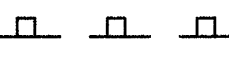


FED. ROAD DIST. NO.	STATE	PROJ. NO.	FISCAL YEAR	SHEET NO.	TOTAL SHEETS
HAWAII	HAW.	360A-01-97	1998	3	9

GENERAL NOTES

1. The scope of work for this project consists of constructing a concrete gutter and gabion walls.
2. The Contractor is reminded of the requirements of Subsection 108.01 - Subletting of Contract, which requires him to perform work amounting to not less than 50 percent of the total contract cost less deductible items. Non-compliance with this Subsection may be grounds for rejection of bid.
3. The Contractor's attention is directed to the following Sections of the Special Provisions : Subsection 107.13 - Public Convenience and Safety; Subsection 107.21 - Contractor's Responsibility For Utility Property And Services; and Section 645 -Traffic Control.
4. At the end of each day's work, the Contractor shall remove all equipment and other obstructions to permit free and safe passage of public traffic.
5. The existence and location of underground utilities, manholes, monuments and structures as shown on the plans are from the latest available data but the accuracy is not guaranteed. The encountering of other obstacles during the course of work is possible. The Contractor shall be held liable for any damages incurred to the existing facilities and/or improvements as a result of his operations.
6. The Contractor shall notify the Engineer in writing, two (2) weeks prior to starting paving operations.
7. Dressing of shoulder shall consist of clearing, grubbing, grading, reshaping and compactingthe unpaved shoulders with suitable material as shown on the plans and/or as directed by the Engineer. This work shall be considered incidental to the various contract items.
8. Existing drainage system will be functional at all times during construction. The Contractor is to furnish materials, equipment, labor, tools and incidentals necessary to maintain flow. This work shall be considered incidental to various contract items.
9. Earth swale shall be graded to drain. This work shall be considered incidental to the various contract items.

LEGEND

-  New Gabion Wall
-  Existing 24" Drain Line
-  Existing Grated Drop Inlet
-  Existing Guardrail

ORIGINAL PLAN	SURVEY DATED BY	DATE
NOTE BOOK	DRAWN BY	15/3/98
dd3/mme	TRACED BY	
N. Ibarra	DESIGNED BY	
	CHECKED BY	

STATE OF HAWAII DEPARTMENT OF TRANSPORTATION HIGHWAYS DIVISION
<b>GENERAL NOTES AND LEGEND</b>
<u>HANA HIGHWAY</u>
<u>Improvements in the Vicinity of Keanae (M.P. 16J3)</u>
<u>Project No. 360A-01-97</u>
Date: May 1998
SHEET No. 1 OF 1 SHEETS