

INDEX TO DRAWINGS	
SHEET NO.	DESCRIPTION
1	TITLE SHEET
2	STANDARD PLAN SUMMARY
3	GENERAL NOTES & LEGEND
4	TYPICAL SECTION
5	PLAN
6	GABION WALL DETAILS
7	DRAINAGE PLAN
8 - 9	DRAINAGE DETAILS

STATE OF HAWAII

DEPARTMENT OF TRANSPORTATION

HIGHWAYS DIVISION

HONOLULU, HAWAII

"AS-BUILT"

PLANS FOR

HANA HIGHWAY, IMPROVEMENTS




IN THE VICINITY OF KEANAE (M.P. 16.13)

PROJECT NO. 360A-01-97

DISTRICT OF HANA

ISLAND OF MAUI

FED. ROAD DIST. NO.	STATE	PROJ. NO.	FISCAL YEAR	SHEET NO.	TOTAL SHEETS
HAWAII	HAW.	360A-01-97	1998	1	9

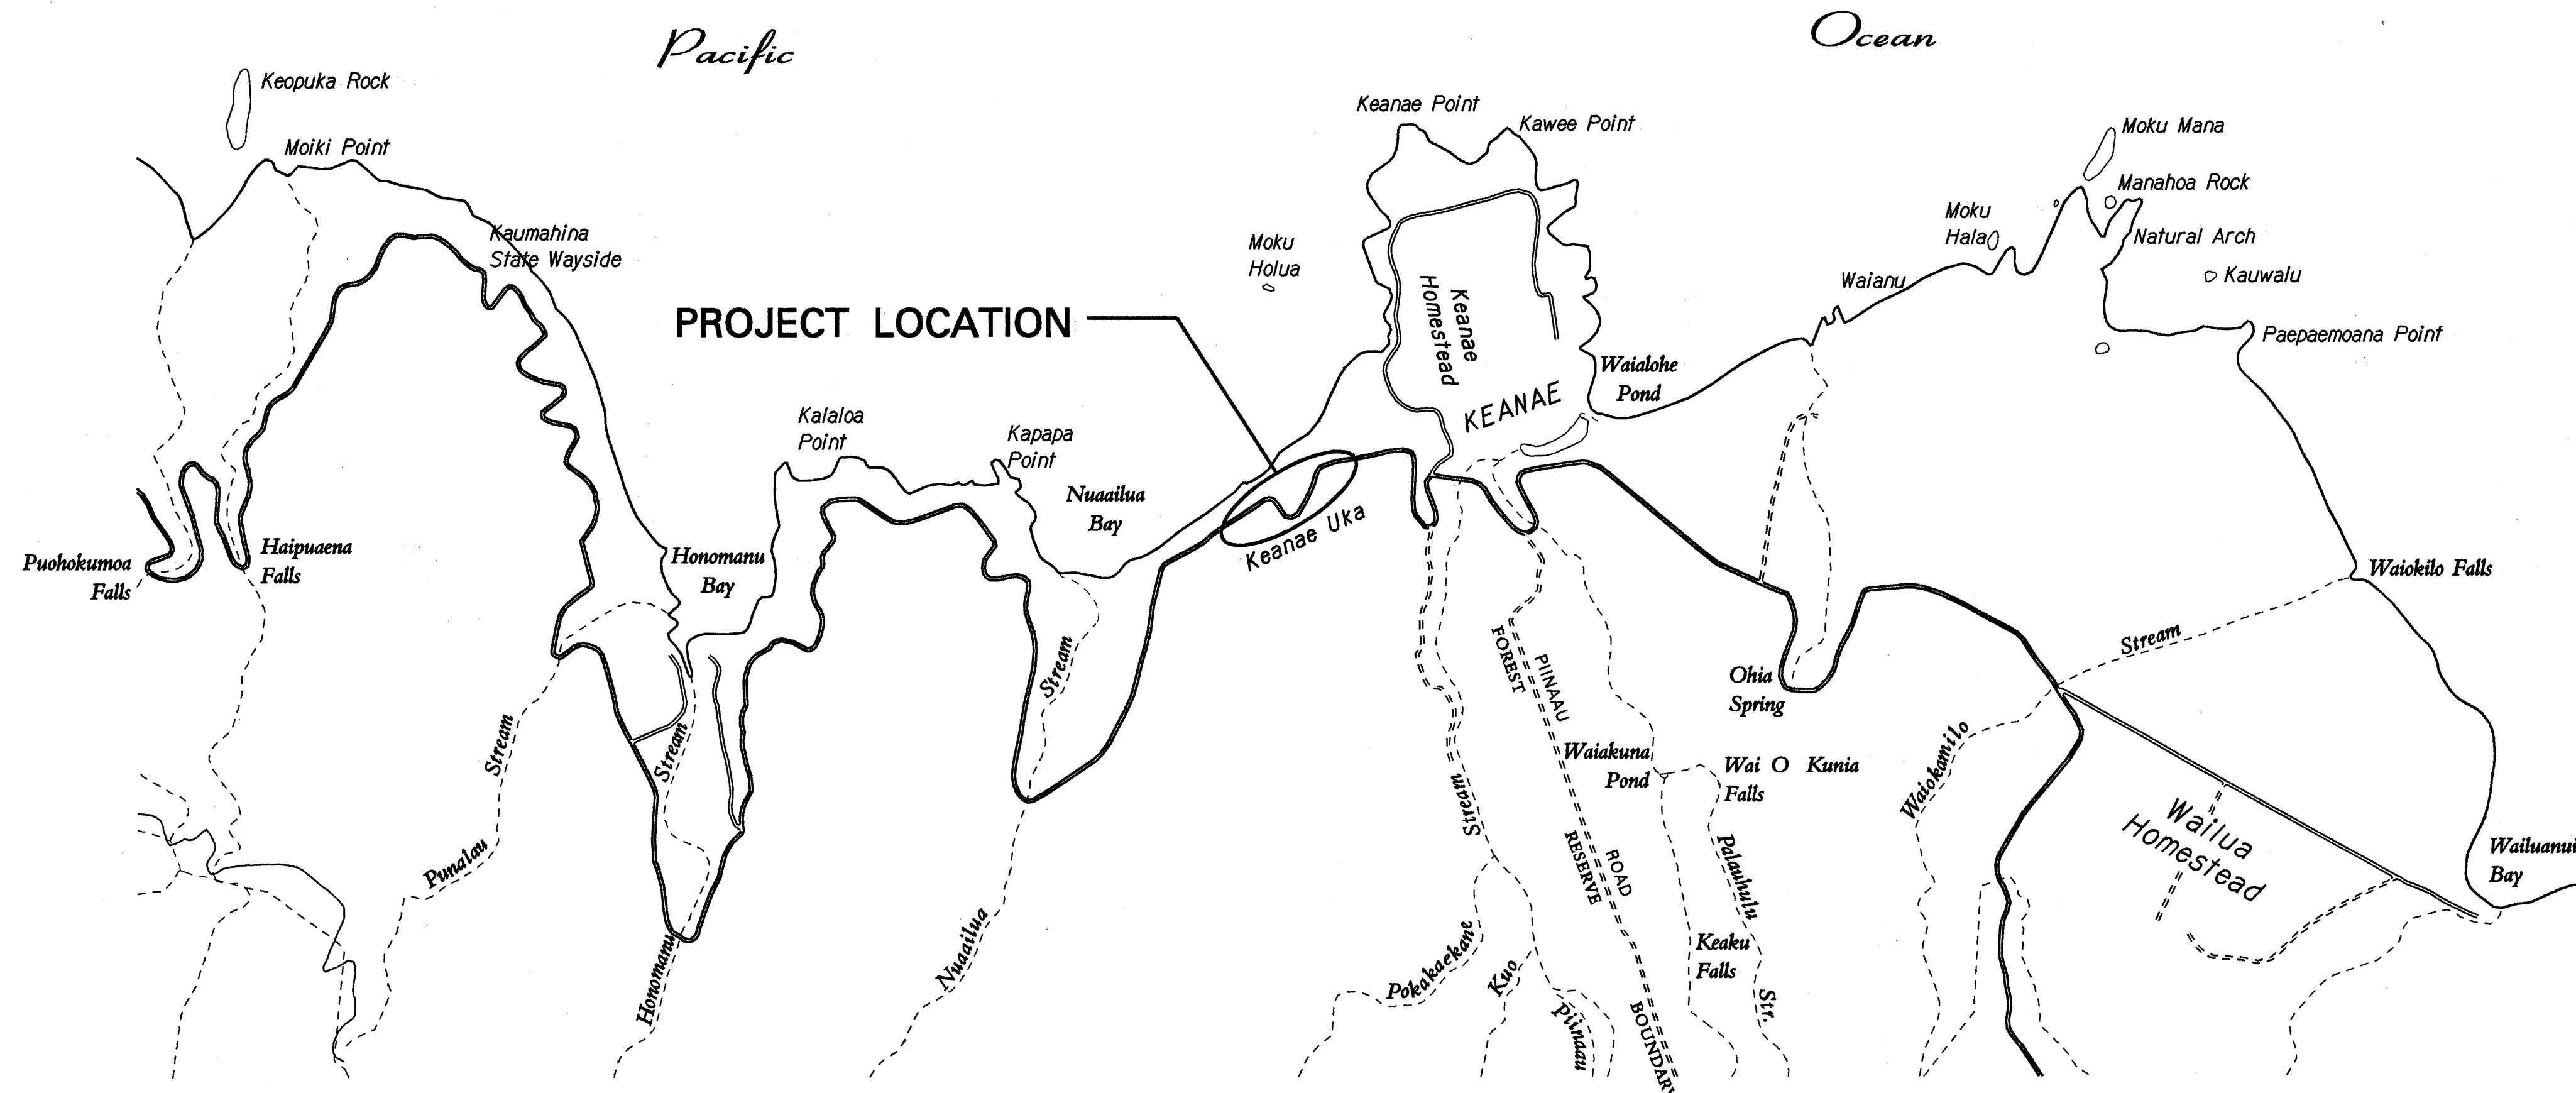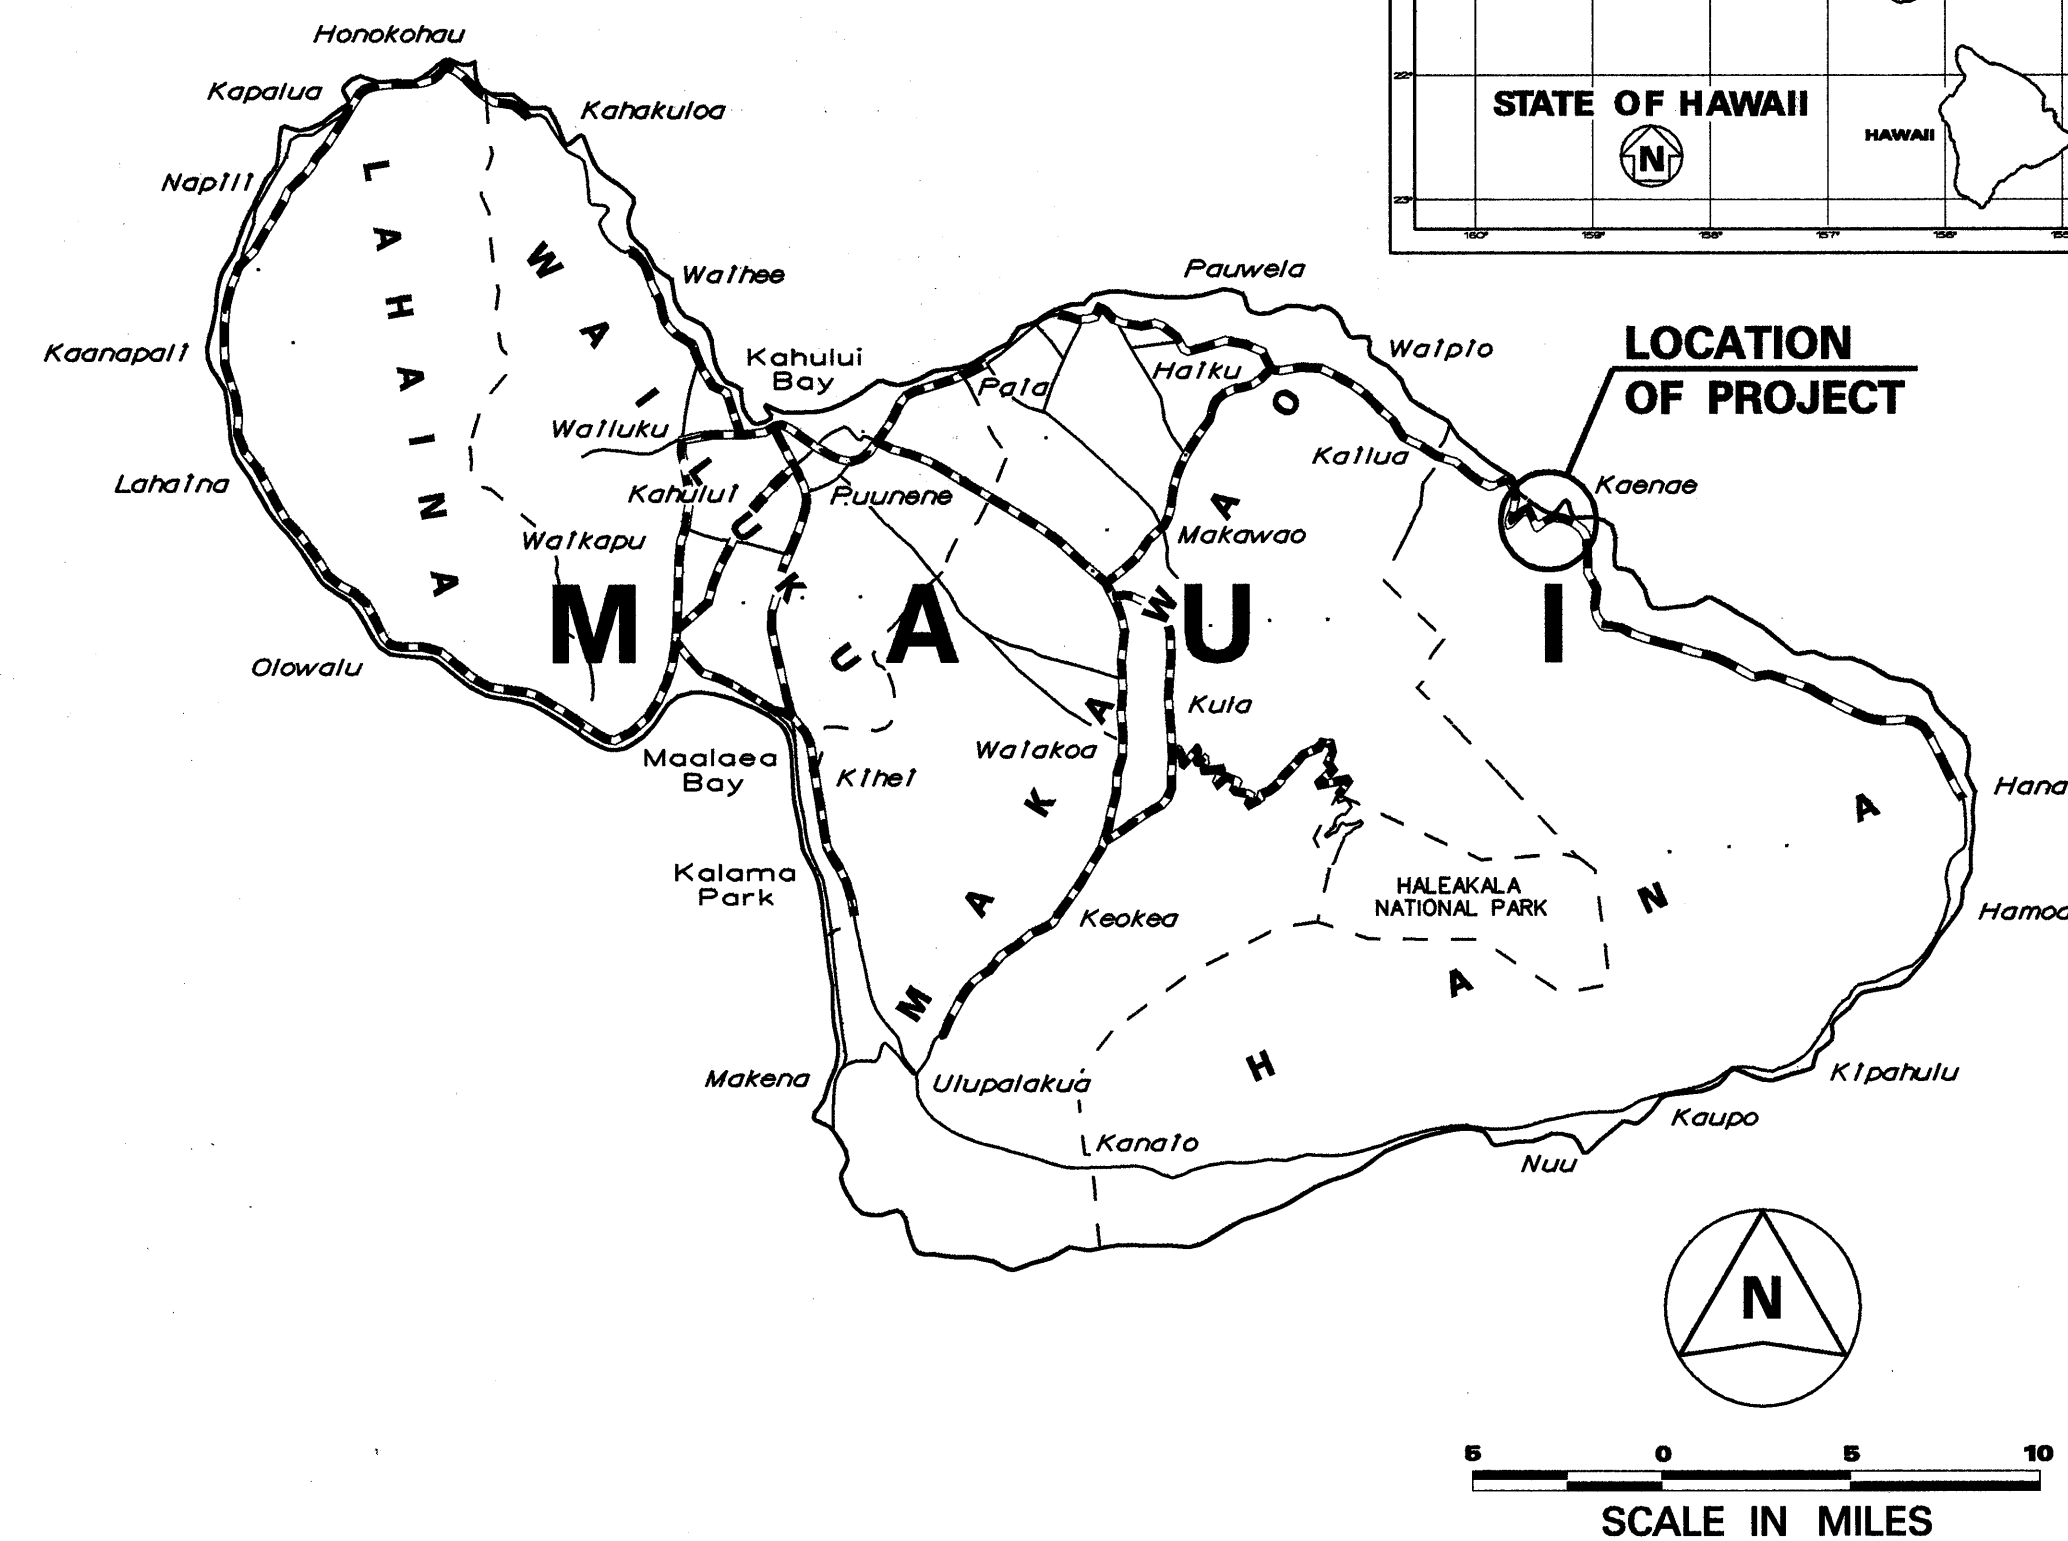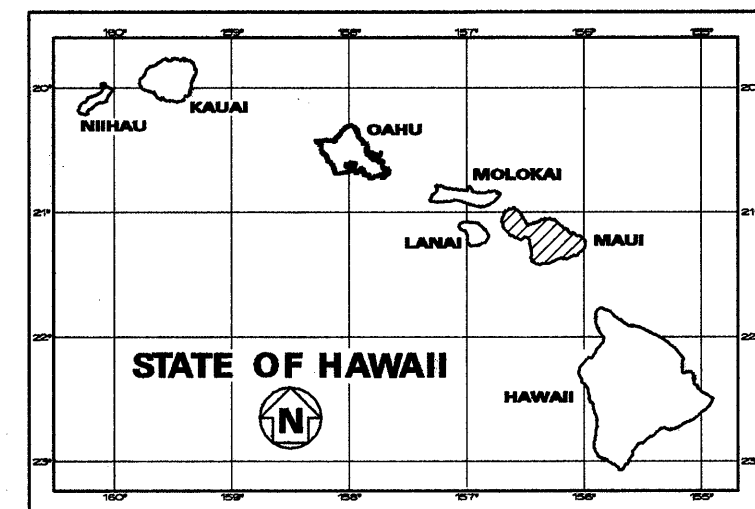

FEDERAL AID PROJECTS PREVIOUSLY CONSTRUCTED OR UNDER CONSTRUCTION

MILE POST 6.03 TO MILE POST 6.23

NO SIGNIFICANT CHANGES WERE MADE DURING CONSTRUCTION ON THESE PLANS EXCEPT CHANGES IN THE ORIGINAL THEORETICAL QUANTITIES. FOR ACTUAL QUANTITIES, REFER TO PROJECT LEDGER AND/OR COMPUTATION BOOK.

Michael J. Smith 1/10/2000
PROJECT ENGINEER DATE

DEPARTMENT OF TRANSPORTATION STATE OF HAWAII	
APPROVED: <i>Raymond K. Hyslop</i>	5/26/98
DIR. OF TRANSPORTATION	DATE

HWY-DD UNIT "D" DESIGNED BY

KEN TATSUGUCHI


P.S. & E. BY

587-2244

PHONE

MAY 1998

DATE

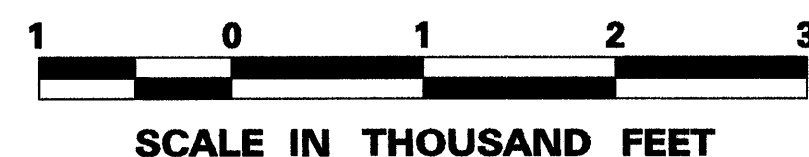

LAYOUT PLAN

GROSS LENGTH OF PROJECT.....0.20 MILES

NET LENGTH OF PROJECT.....0.20 MILES