


FED. ROAD DIST. NO.	STATE	PROJ. NO.	FISCAL YEAR	SHEET NO.	TOTAL SHEETS
HAWAII	HAW.	360A-01-97	1998	4	9

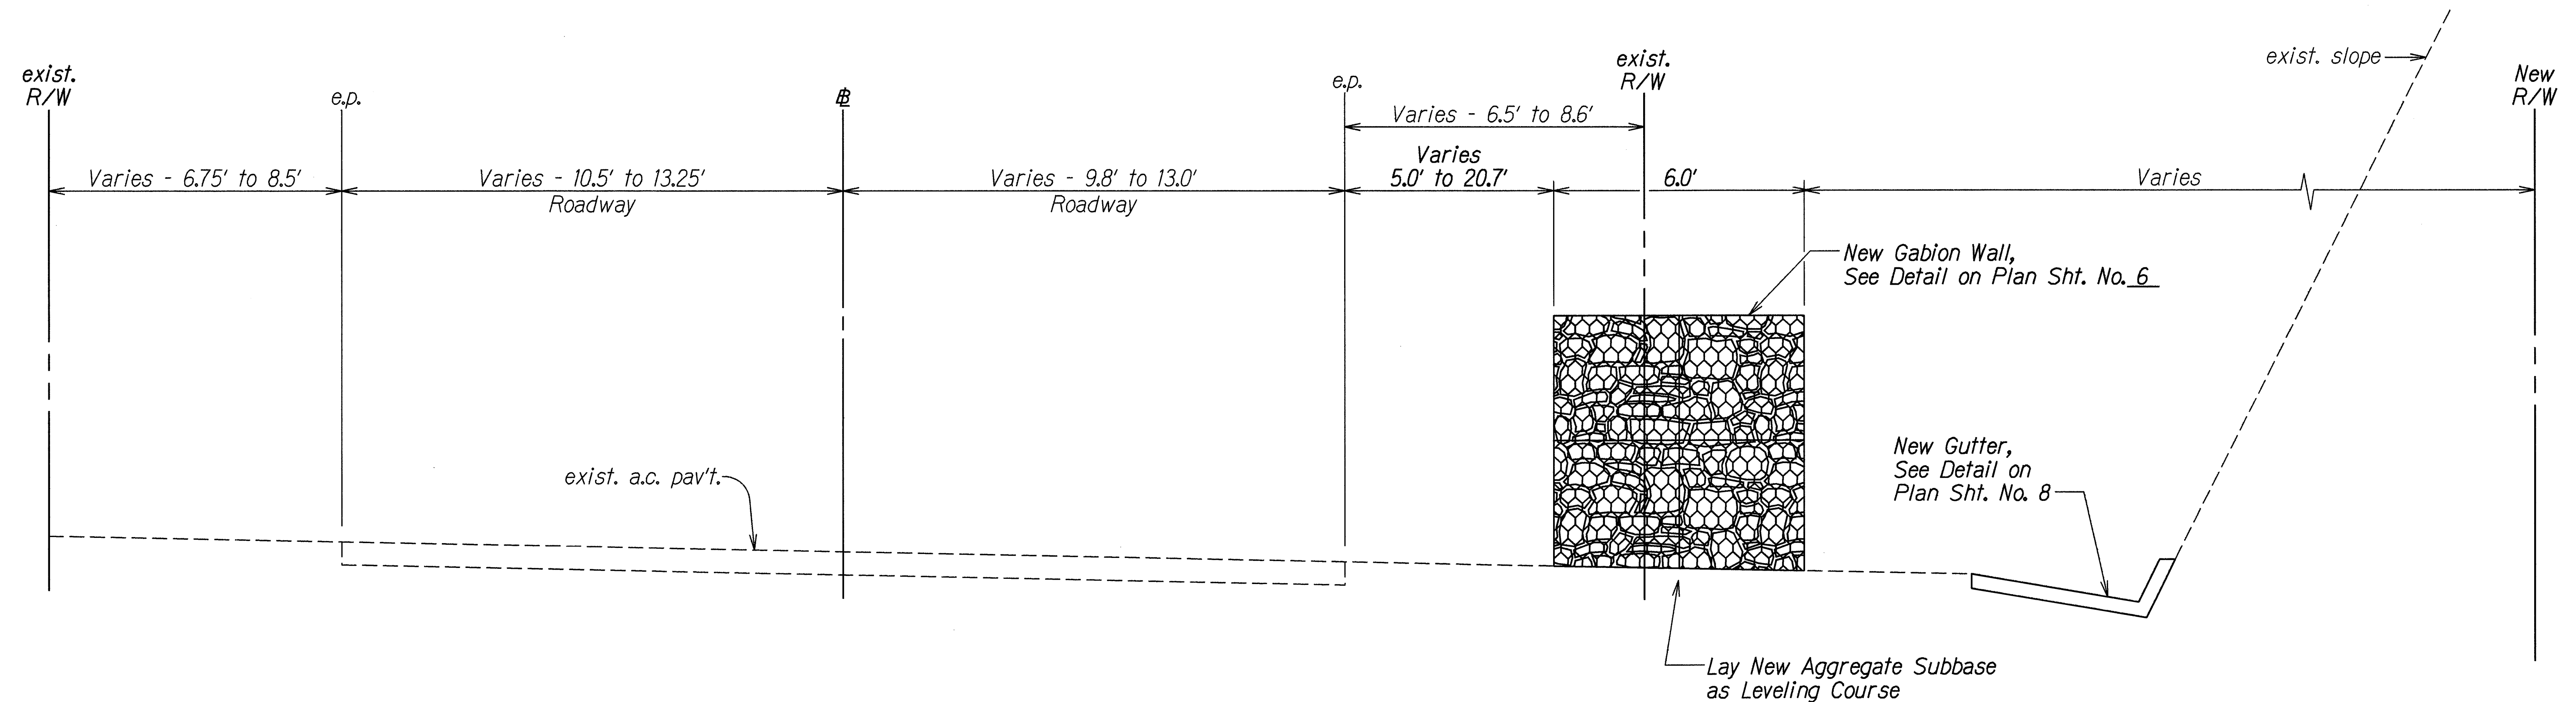

TYPICAL SECTION
STA. 692+83± TO # STA. 695+95±
Scale: 1/2"=1.0'

ORIGINAL PLAN	SURVEY PLOTTED BY _____	DATE <u>5.31/98</u>
	DRAWN BY <u>J.M.</u>	
	TRACED BY _____	
	DESIGNED BY <u>K. Chun</u>	
	QUANTITIES BY _____	
	CHECKED BY _____	

STATE OF HAWAII
DEPARTMENT OF TRANSPORTATION
HIGHWAYS DIVISION

TYPICAL SECTION

HANA HIGHWAY

Improvements in the Vicinity of Keanae (M.P. 16J3)

Project No. 360A-01-97

Date: As Shown Date: May 1998

SHEET No. 1 OF 1 SHEETS