
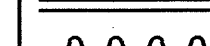


FED. ROAD DIST. NO.	STATE	FED. AID PROJ. NO.	FISCAL YEAR	SHEET NO.	TOTAL SHEETS
HAWAII	HAW.	STP-0360(7)	2000	4	26

LEGEND FOR AS-BUILT POSTINGS

 Squiggly line for as-built deletion
 Double line for as-built deletion
Roadway Text for as-built posting

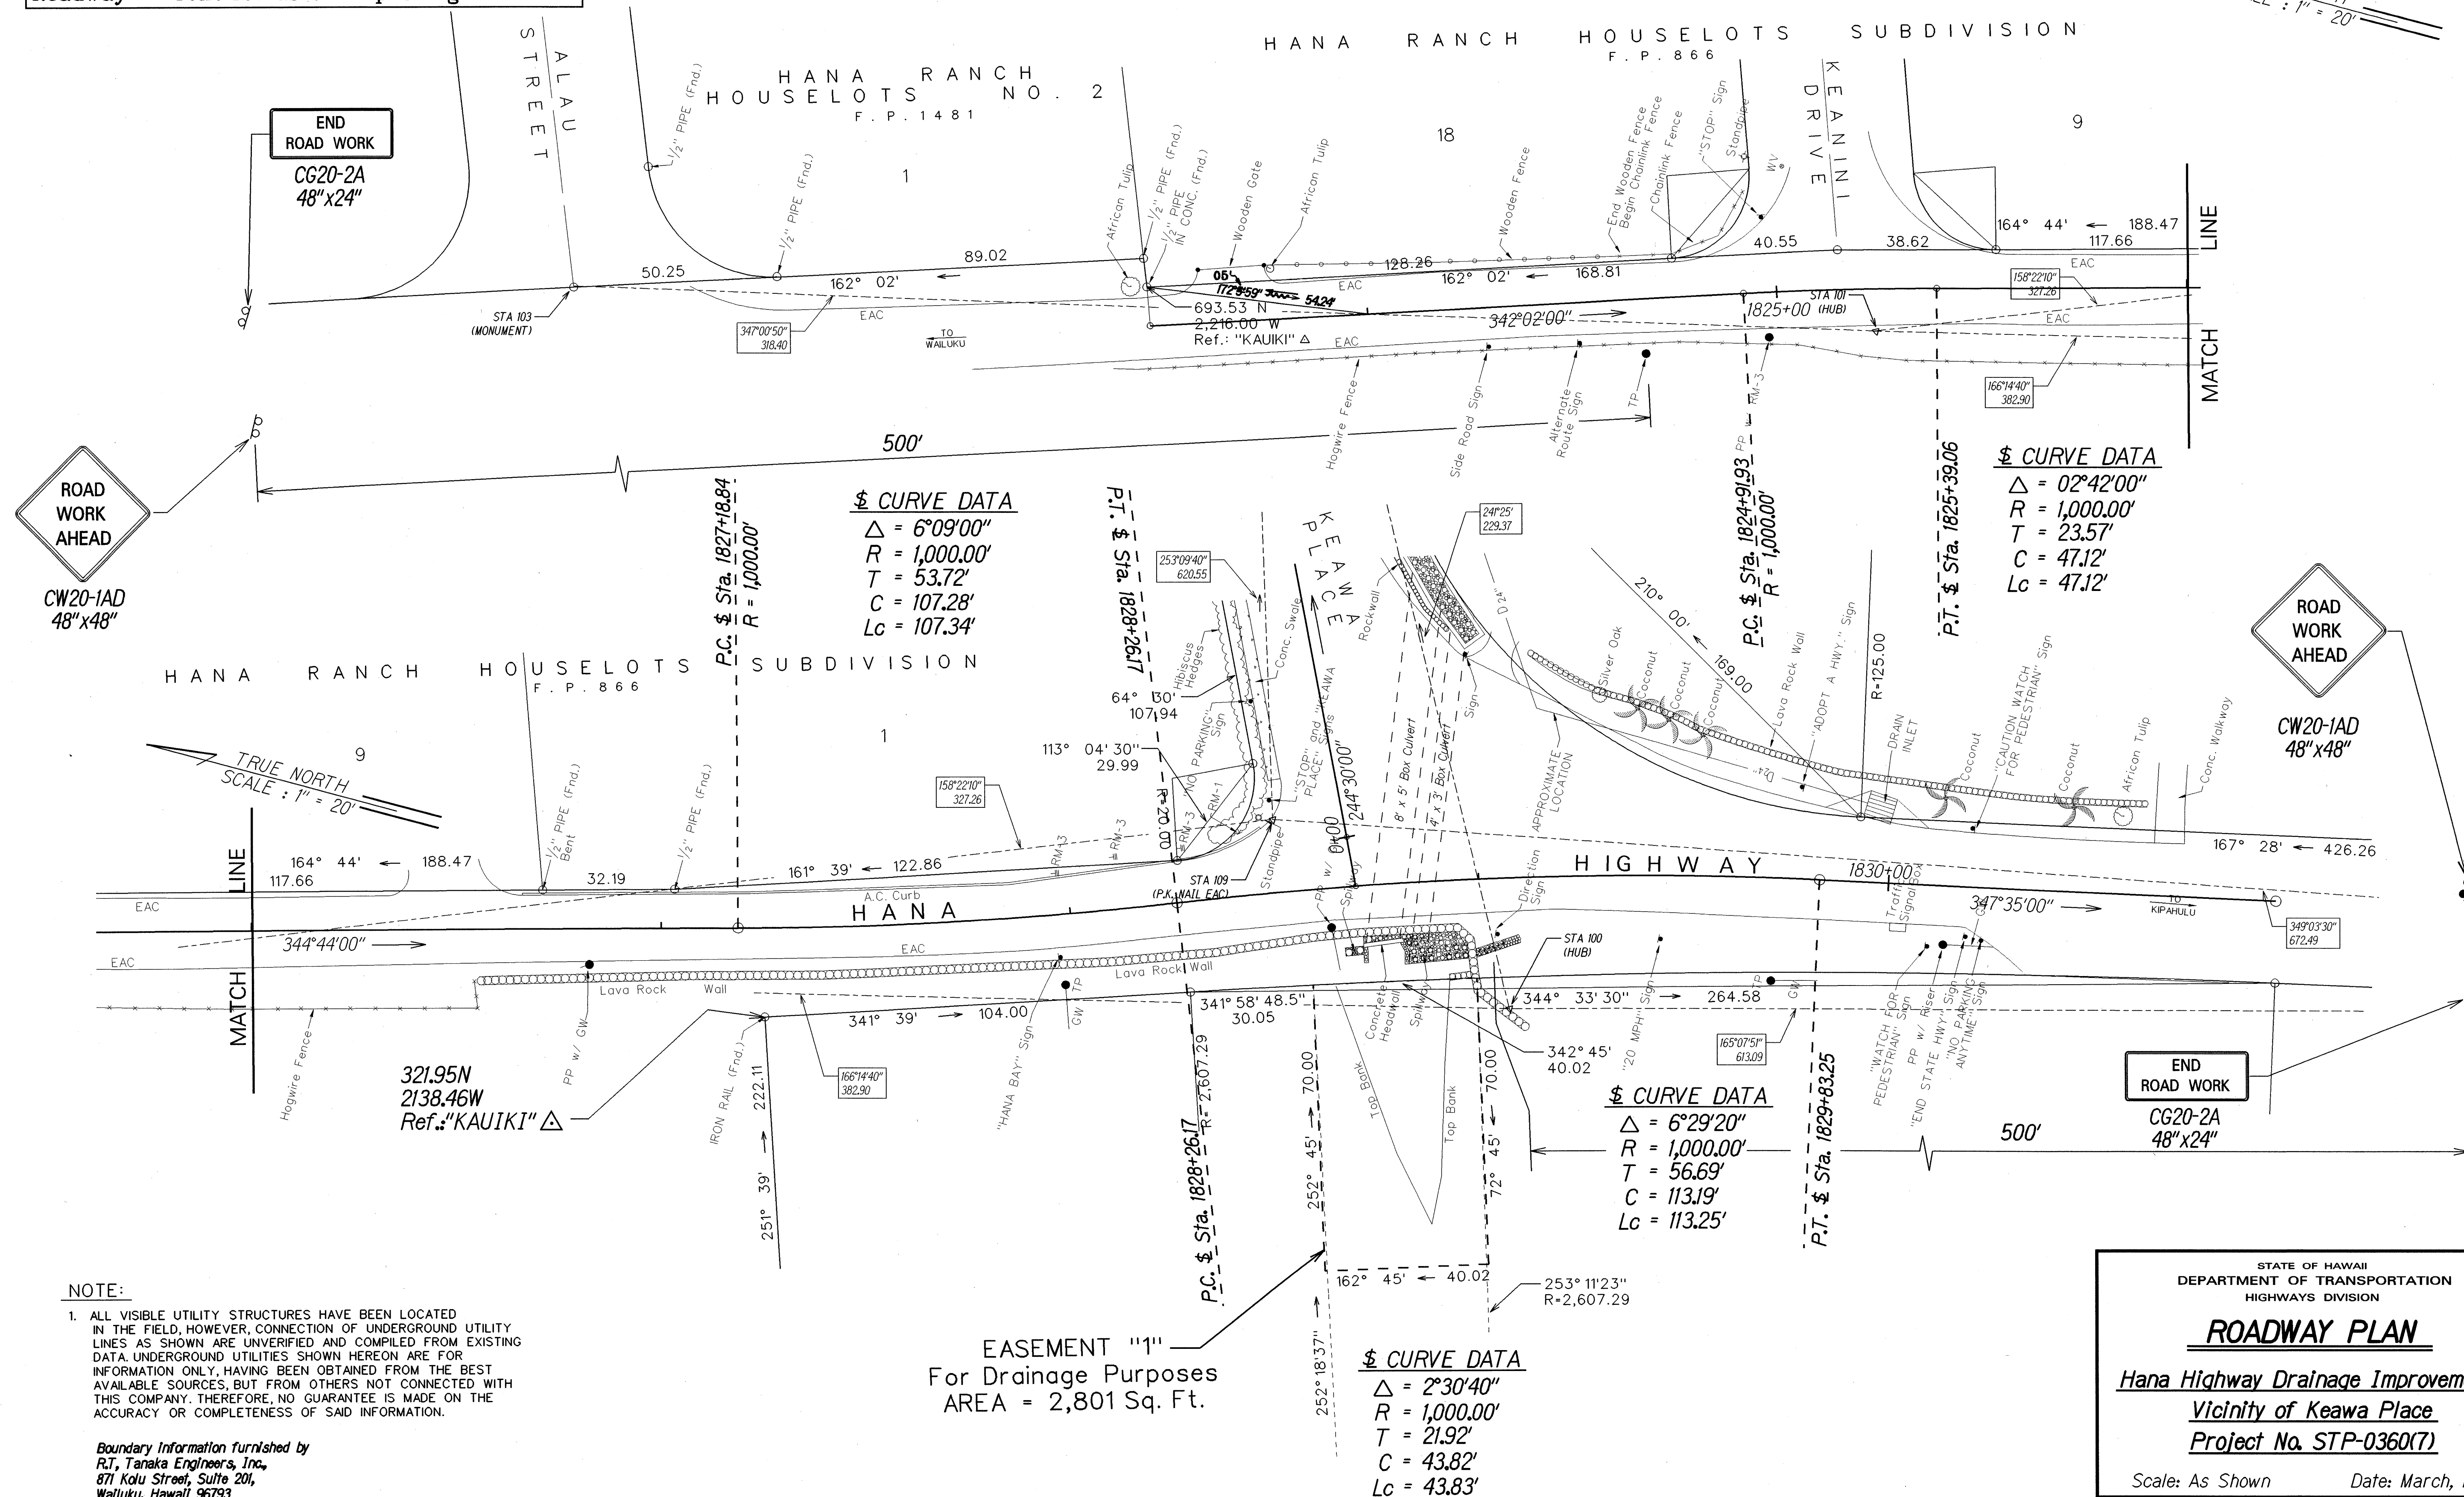

NOTE:

- ALL VISIBLE UTILITY STRUCTURES HAVE BEEN LOCATED IN THE FIELD, HOWEVER, CONNECTION OF UNDERGROUND UTILITY LINES AS SHOWN ARE UNVERIFIED AND COMPILED FROM EXISTING DATA. UNDERGROUND UTILITIES SHOWN HEREON ARE FOR INFORMATION ONLY, HAVING BEEN OBTAINED FROM THE BEST AVAILABLE SOURCES, BUT FROM OTHERS NOT CONNECTED WITH THIS COMPANY. THEREFORE, NO GUARANTEE IS MADE ON THE ACCURACY OR COMPLETENESS OF SAID INFORMATION.

Boundary Information furnished by
R.T. Tanaka Engineers, Inc.,
871 Kolu Street, Suite 201,
Wailuku, Hawaii 96793

STATE OF HAWAII
DEPARTMENT OF TRANSPORTATION
HIGHWAYS DIVISION


ROADWAY PLAN

Hana Highway Drainage Improvements
Vicinity of Keawana Place
Project No. STP-0360(7)

Scale: As Shown Date: March, 1999


SHEET No. 1 OF 3 SHEETS

"AS-BUILT"

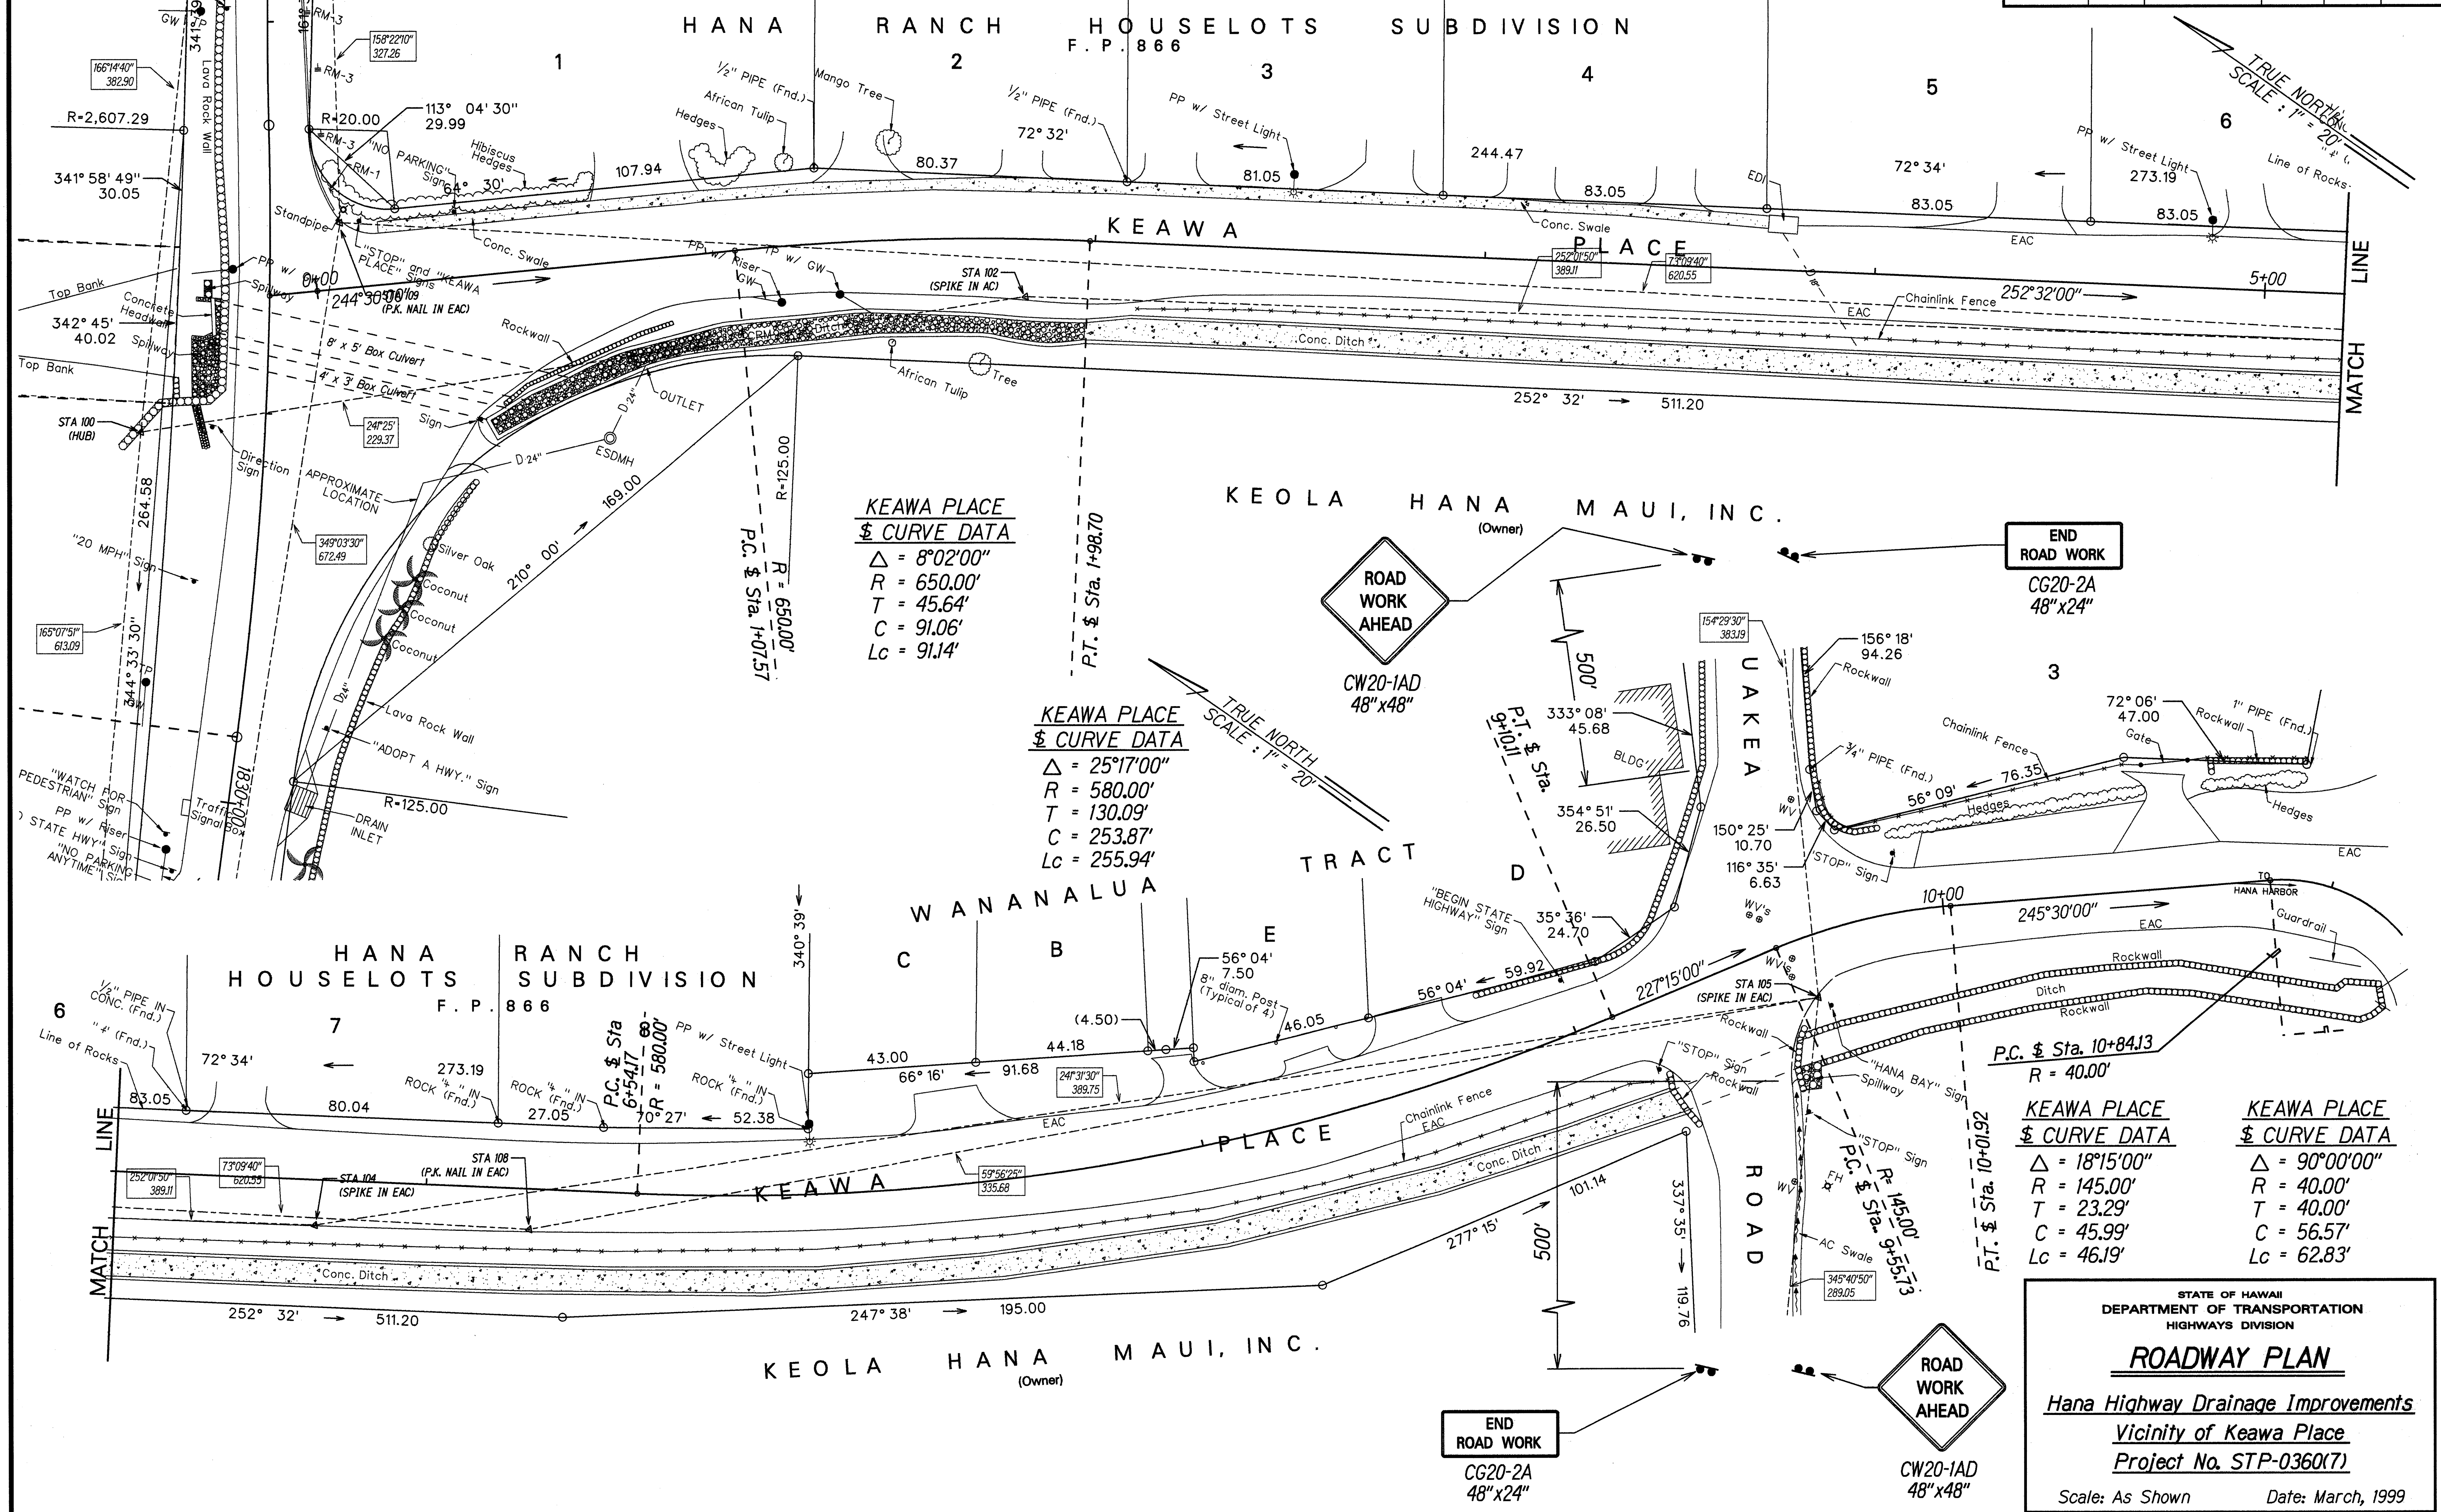

ORIGINAL PLAN	SURVEY PLOTTED BY _____	DATE <u>12/24/97</u>
NOTE BOOK dd6geroge thiandbp2	DRAWN BY <u>G. Athurdo</u>	•
	TRACED BY _____	•
	DESIGNED BY <u>R. Hironaka, J. Sawa</u>	•
	QUANTITIES BY _____	•
	CHECKED BY _____	•
	IN CHARGE BY _____	•

FED. ROAD DIST. NO.	STATE	FED. AID PROJ. NO.	FISCAL YEAR	SHEET NO.	TOTAL SHEETS
HAWAII	HAW.	STP-0360(7)	2000	6	26

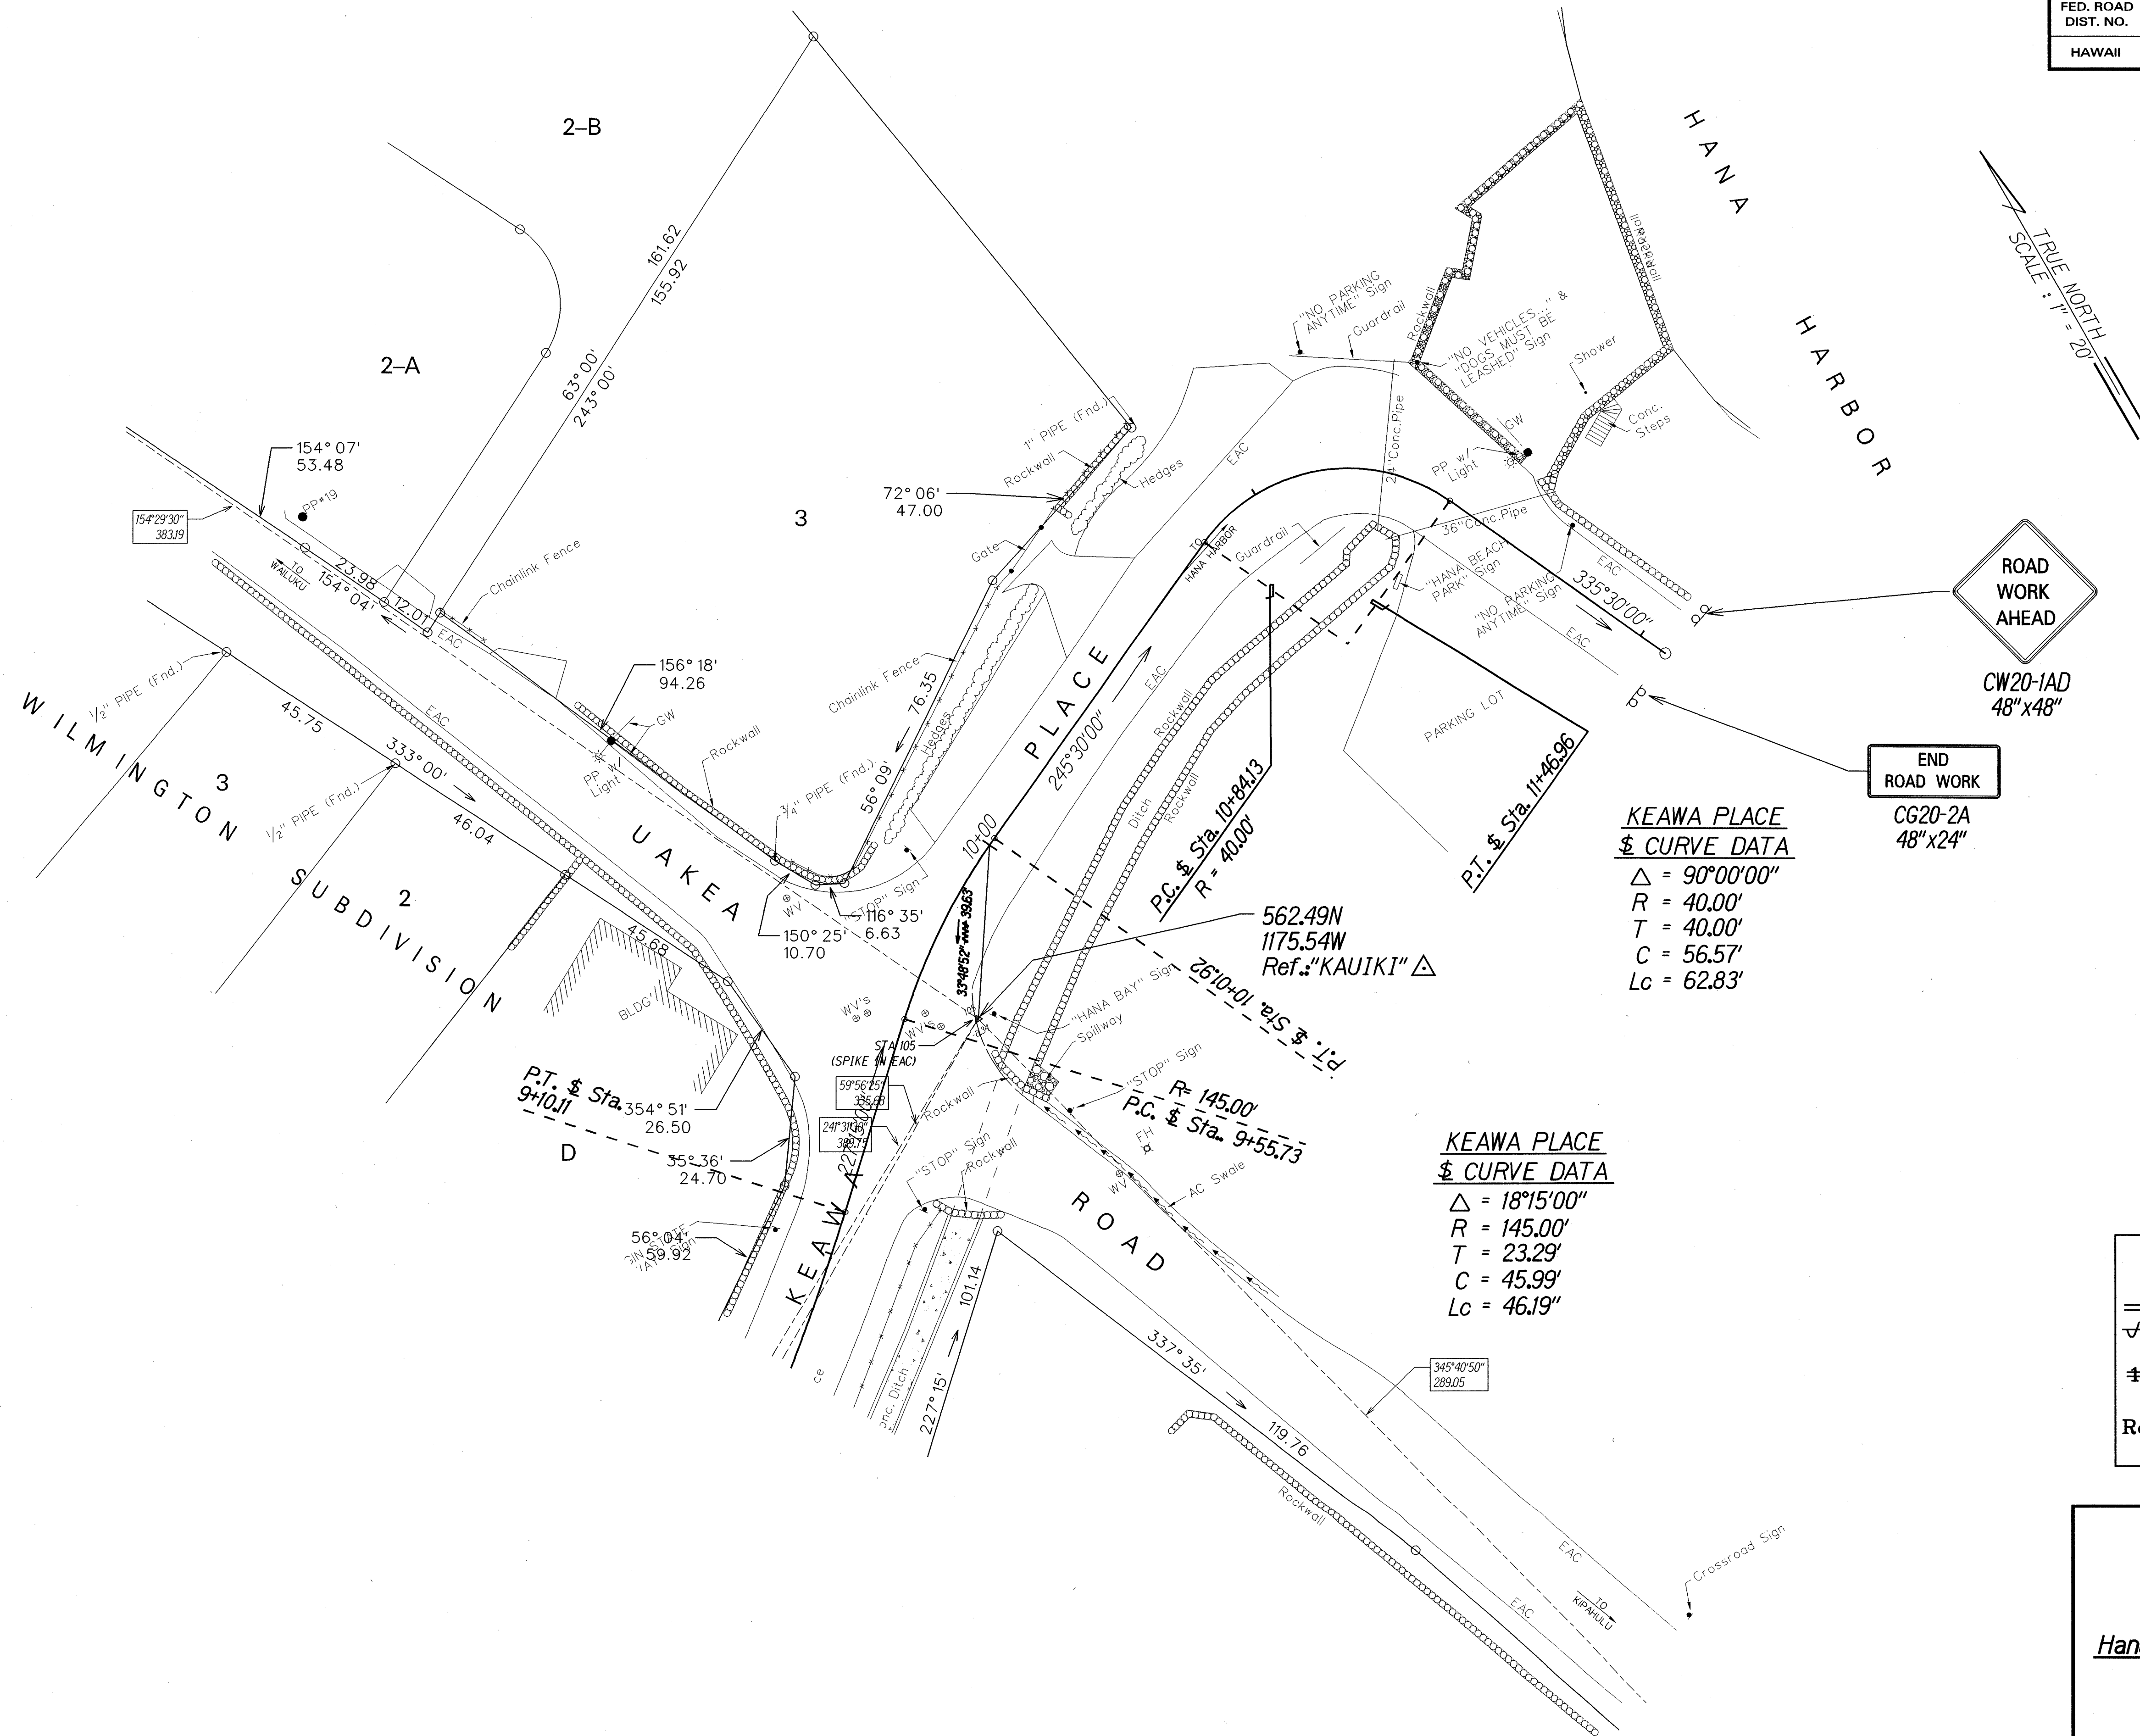

ORIGINAL PLAN	DATE
DESIGNED BY	DATE
CHECKED BY	DATE
APPROVED BY	DATE

STATE OF HAWAII
 DEPARTMENT OF TRANSPORTATION
 HIGHWAYS DIVISION

ROADWAY PLAN

*Hana Highway Drainage Improvements
 Vicinity of Keawa Place
 Project No. STP-0360(7)*

Scale: As Shown Date: March, 1999

SHEET No. 3 OF 3 SHEETS

"AS-BUILT"