

[illegible]

**360**

**LOCATION OF PROJECT**

**SCALE IN MILES**

Map of Maui showing the location of the project. The map includes labels for various towns and landmarks, a scale bar, and a north arrow. An inset map shows the location of Maui within the State of Hawaii.

**MILE POST 34.35 TO MILE POST 34.65**


DESIGN DESIGNATION

|                       |       |
|-----------------------|-------|
| ADT (1999).....       | 2,800 |
| ADT (2019).....       | 4,200 |
| DHV .....             | 500   |
| K .....               | 12.0  |
| D .....               | 65/35 |
| T <sub>24</sub> ..... | 3.0 % |

CHANGES MADE DURING CONSTRUCTION HAVE BEEN  
INCORPORATED ON THESE PLANS EXCEPT CHANGES  
IN THE ORIGINAL THEORETICAL QUANTITIES. FOR  
ACTUAL QUANTITIES, REFER TO PROJECT LEDGER  
AND/OR COMPUTATION BOOK.

*Michael J. Manning* 8-1-200  
RESIDENT ENGINEER DATE

|   |         |
|---|---------|
| DEPARTMENT OF TRANSPORTATION<br>STATE OF HAWAII |         |
| APPROVED:<br><i>Kayn Kayashida</i>              | 6/10/99 |
| DIR. OF TRANSPORTATION                          | DATE    |

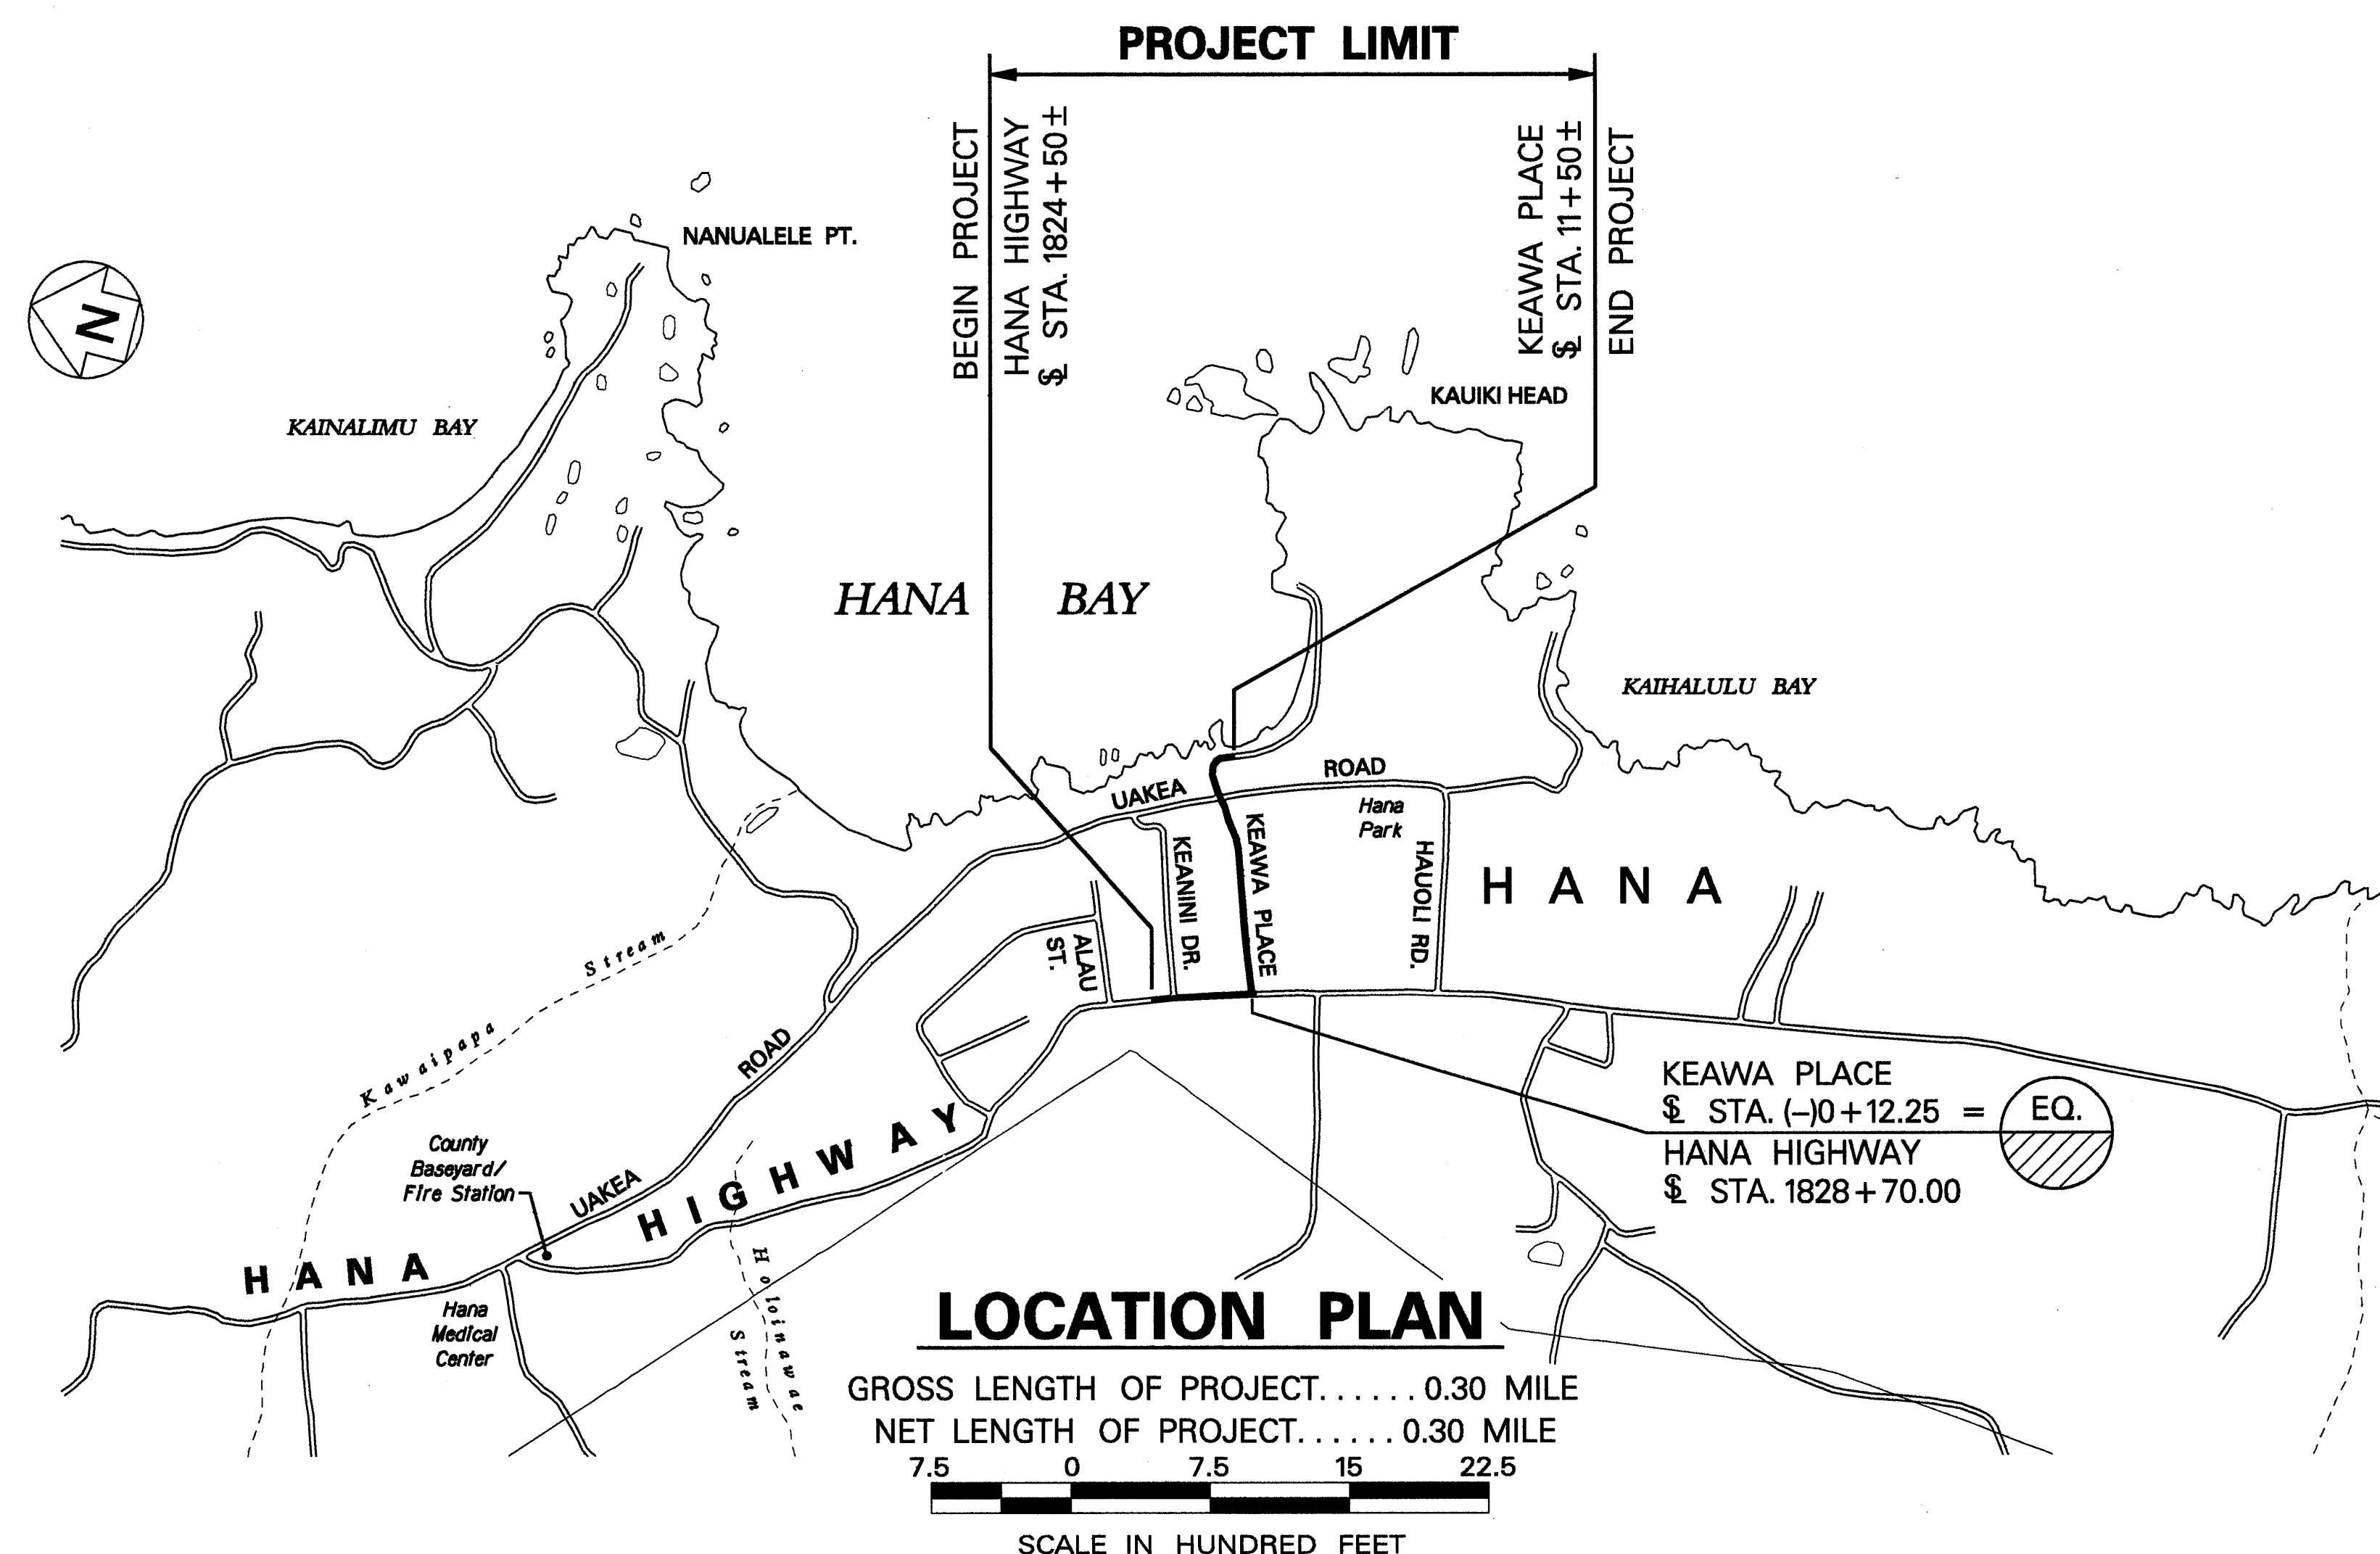

HWY-DH \_\_\_\_\_ R. HIRONAKA \_\_\_\_\_ MAY, 1999  
DESIGNED BY \_\_\_\_\_ P. S. & E. BY \_\_\_\_\_ DATE  
692-7575 \_\_\_\_\_ PHONE

ogin: george  
hhandstst.dgn  
19-9-98