

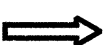


| FED. ROAD DIST. NO. | STATE | PROJ. NO.    | FISCAL YEAR | SHEET NO. | TOTAL SHEETS |
|---------------------|-------|--------------|-------------|-----------|--------------|
| HAWAII              | HAW.  | 360AB-01-00M | 2001        | 26        | 42           |


TRUE NORTH  
SCALE : NTS

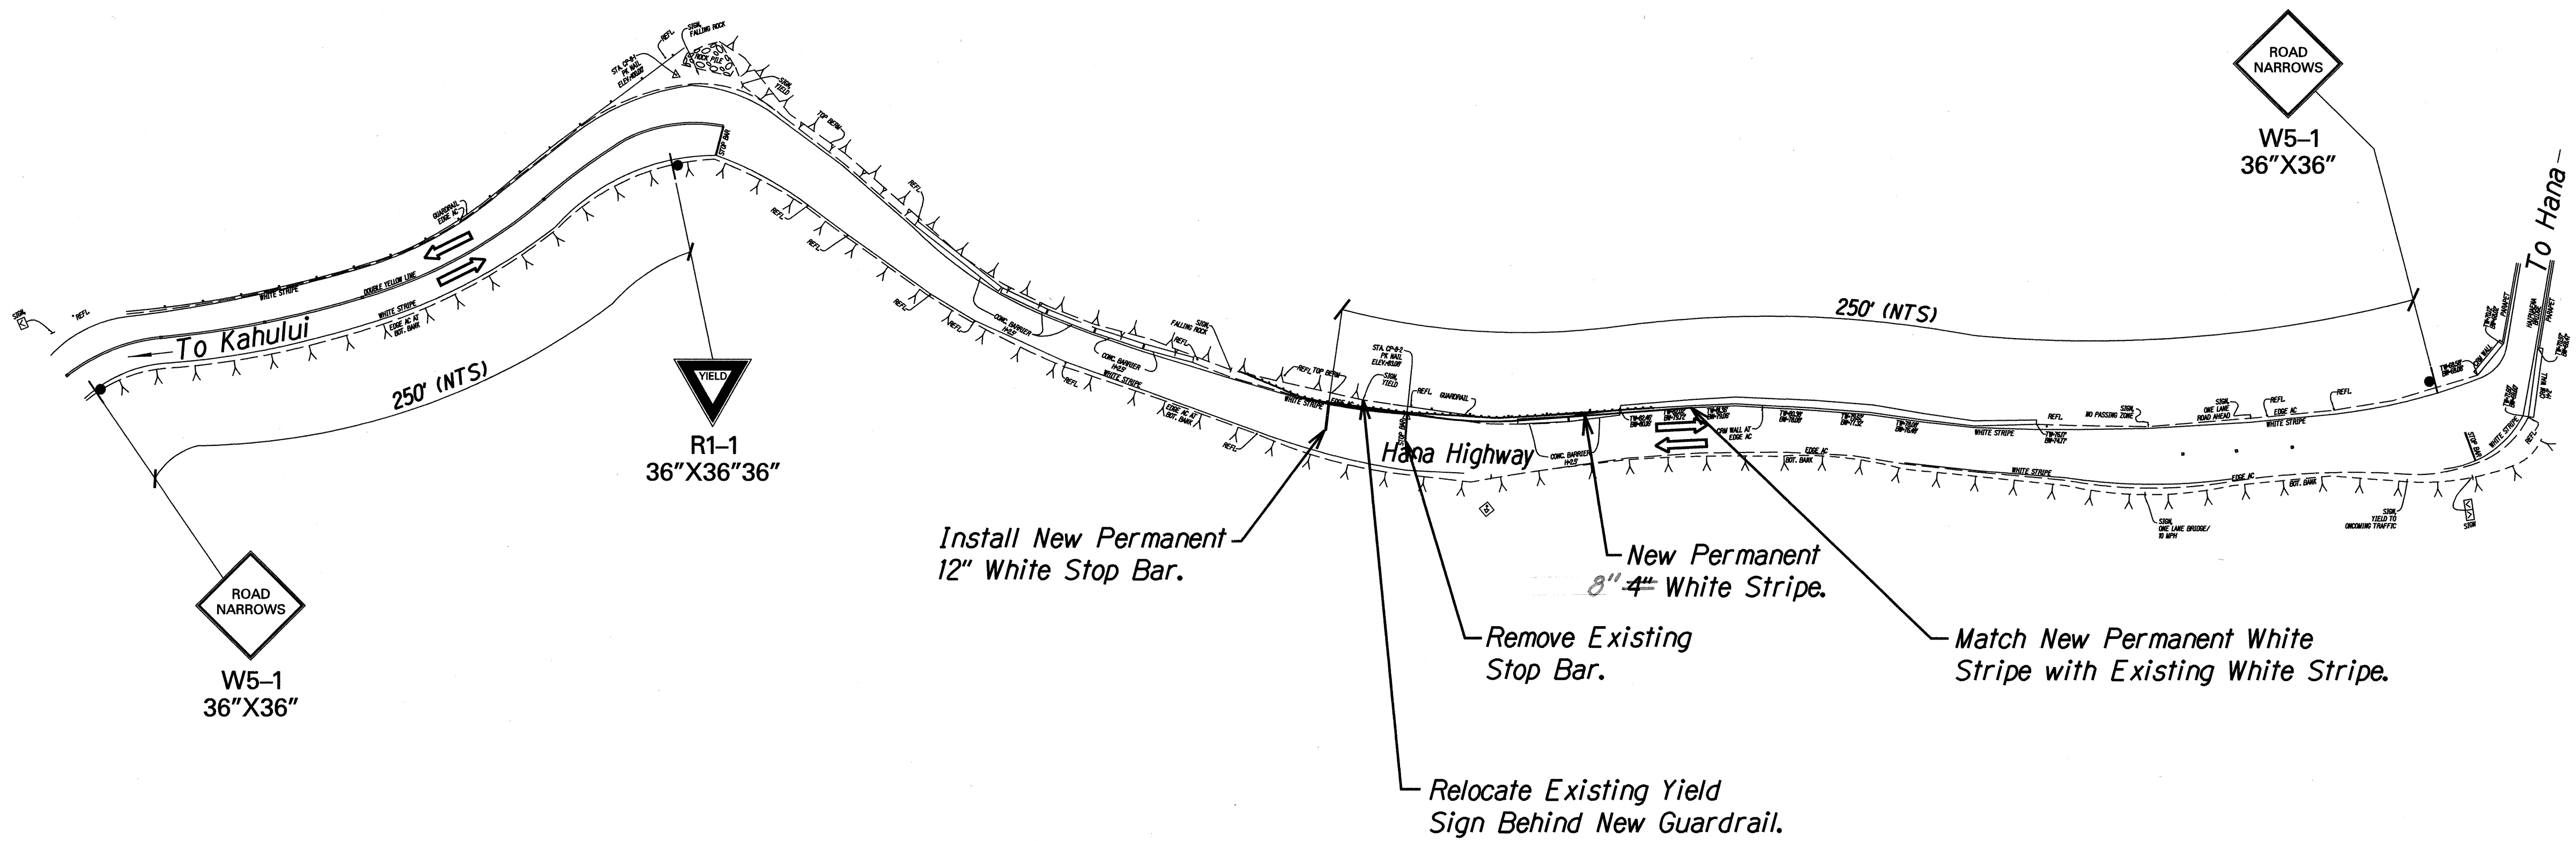

**LEGEND:**

-  Sign
-  Direction of Traffic

|                   |      |
|-------------------|------|
| SURVEY PLOTTED BY | DATE |
| DESIGNED BY       |      |
| NOTED BY          |      |
| CHECKED BY        |      |
| ORIGINAL PLAN     |      |
| NOTE BOOK         |      |
| QUANTITIES BY     |      |
| CHECKED BY        |      |
| N.                |      |

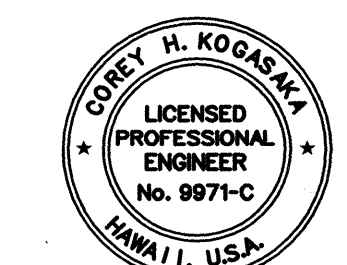

THIS WORK WAS PREPARED BY ME OR UNDER MY SUPERVISION AND CONSTRUCTION OF THIS PROJECT WILL BE UNDER MY OBSERVATION.  
*Corey H. Kogasaka*  
DATE: 4/27/01

STATE OF HAWAII  
DEPARTMENT OF TRANSPORTATION  
HIGHWAYS DIVISION

**FINAL STRIPING PLAN**

**SITE 6, M.P. 11.4**

HANA HIGHWAY  
REPAIRS AND MAINTENANCE  
PROJECT NO. 360AB-01-00M


Scale: NTS      Date: March, 2001

SHEET No. 1 OF 5 SHEETS



"AS-BUILT"

| FED. ROAD DIST. NO. | STATE | PROJ. NO.    | FISCAL YEAR | SHEET NO. | TOTAL SHEETS |
|---------------------|-------|--------------|-------------|-----------|--------------|
| HAWAII              | HAW.  | 360AB-01-00M | 2001        | 27        | 56           |

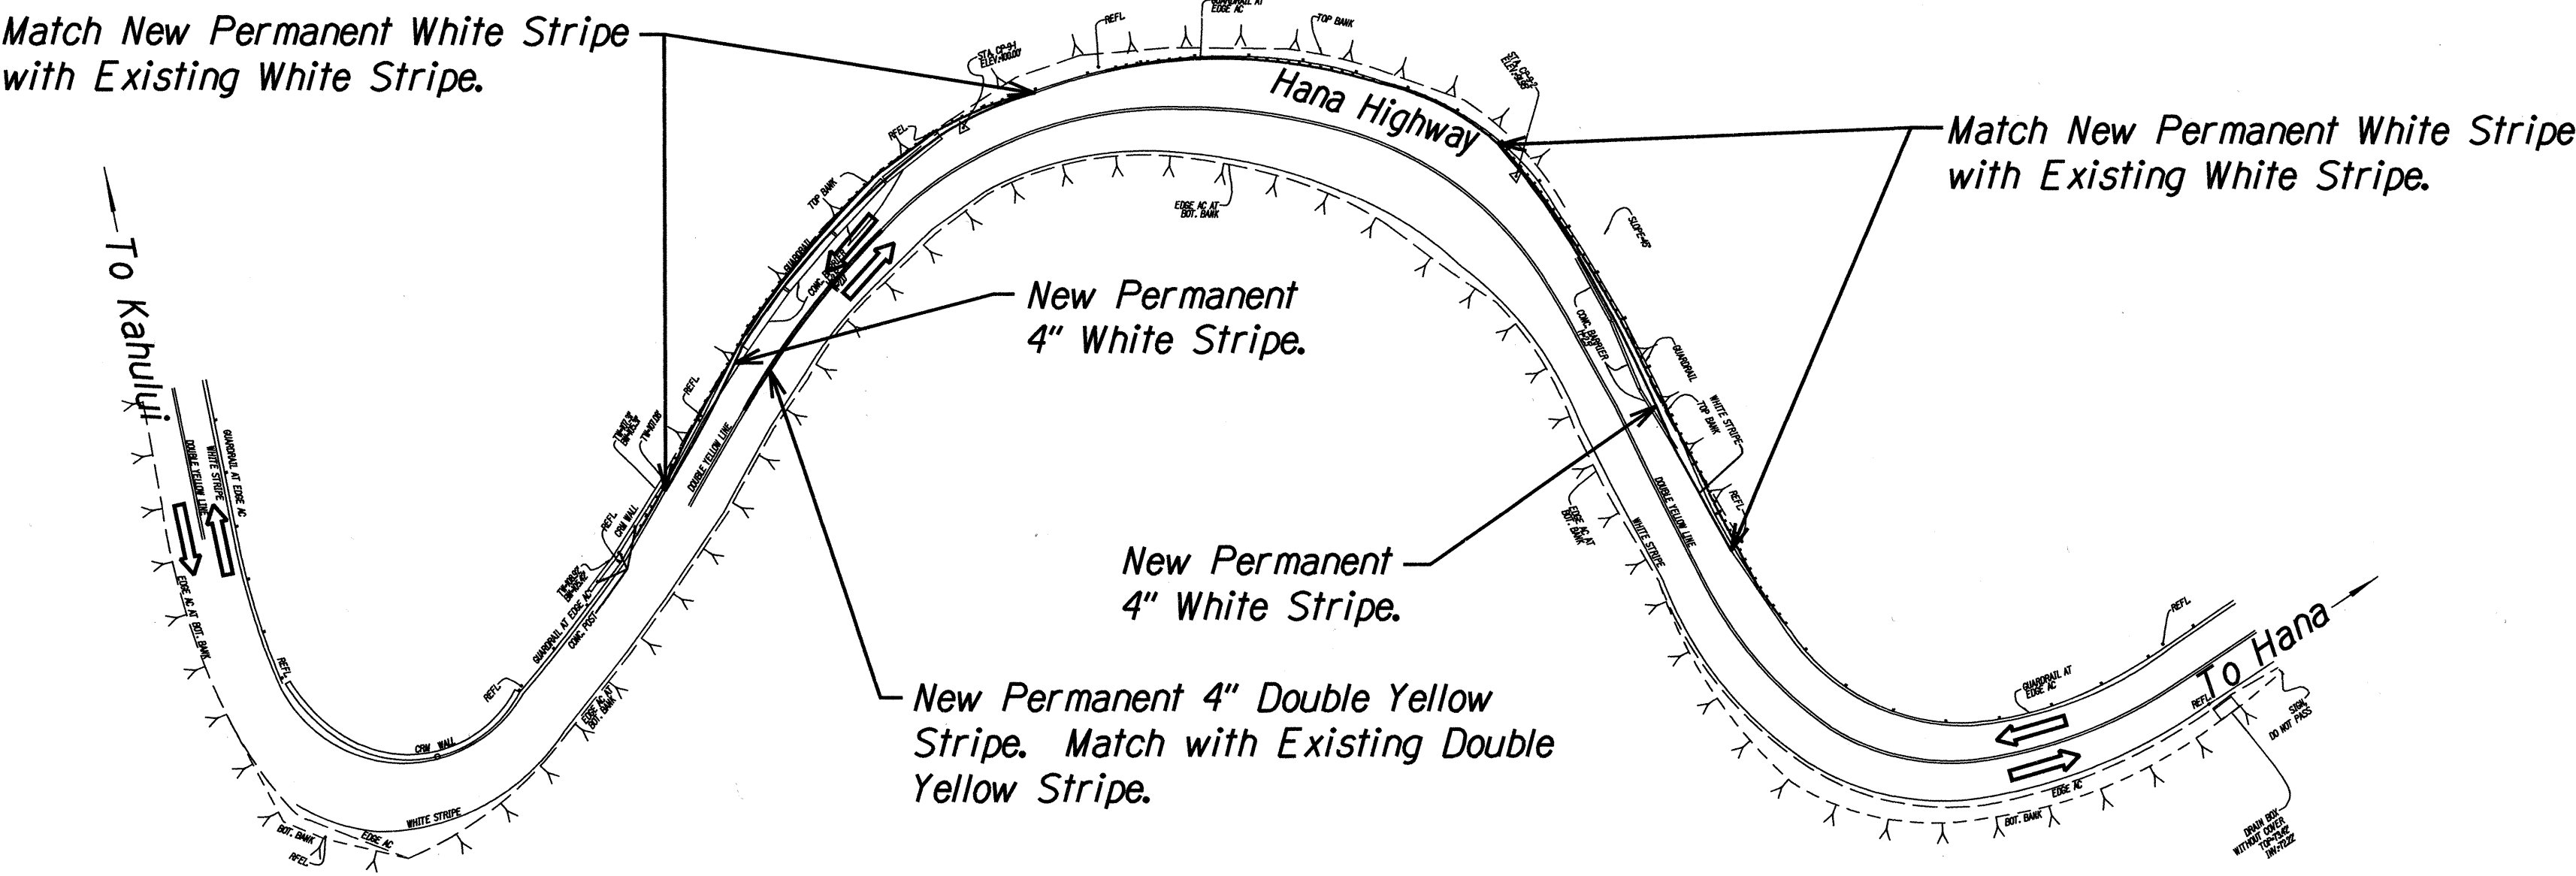
TRUE NORTH  
SCALE : NTS



**LEGEND:**

 Sign
  Direction of Traffic

|                   |      |
|-------------------|------|
| SURVEY PLOTTED BY | DATE |
| DRAWN BY          |      |
| CHECKED BY        |      |
| DESIGNED BY       |      |
| QUANTITIES BY     |      |
| CHECKED BY        |      |
| ORIGINAL PLAN     |      |
| NOTE BOOK         |      |
| N <sub>o</sub> .  |      |

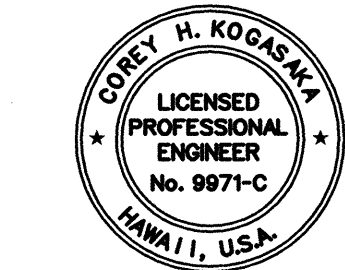

THIS WORK WAS PREPARED BY ME OR UNDER MY SUPERVISION AND CONSTRUCTION OF THIS PROJECT WILL BE UNDER MY OBSERVATION.

*Corey H. Kogawa*

DATE: 4/27/01

STATE OF HAWAII  
DEPARTMENT OF TRANSPORTATION  
HIGHWAYS DIVISION

**FINAL STRIPING PLAN**

**SITE 7, M.P. 12.8**


HANA HIGHWAY  
REPAIRS AND MAINTENANCE  
PROJECT NO. 360AB-01-00M

Scale: NTS Date: March, 2001

SHEET No. 2 OF 5 SHEETS

| FED. ROAD DIST. NO. | STATE | PROJ. NO.    | FISCAL YEAR | SHEET NO. | TOTAL SHEETS |
|---------------------|-------|--------------|-------------|-----------|--------------|
| HAWAII              | HAW.  | 360AB-01-00M | 2001        | 28        | 56           |


TRUE NORTH  
SCALE : NTS

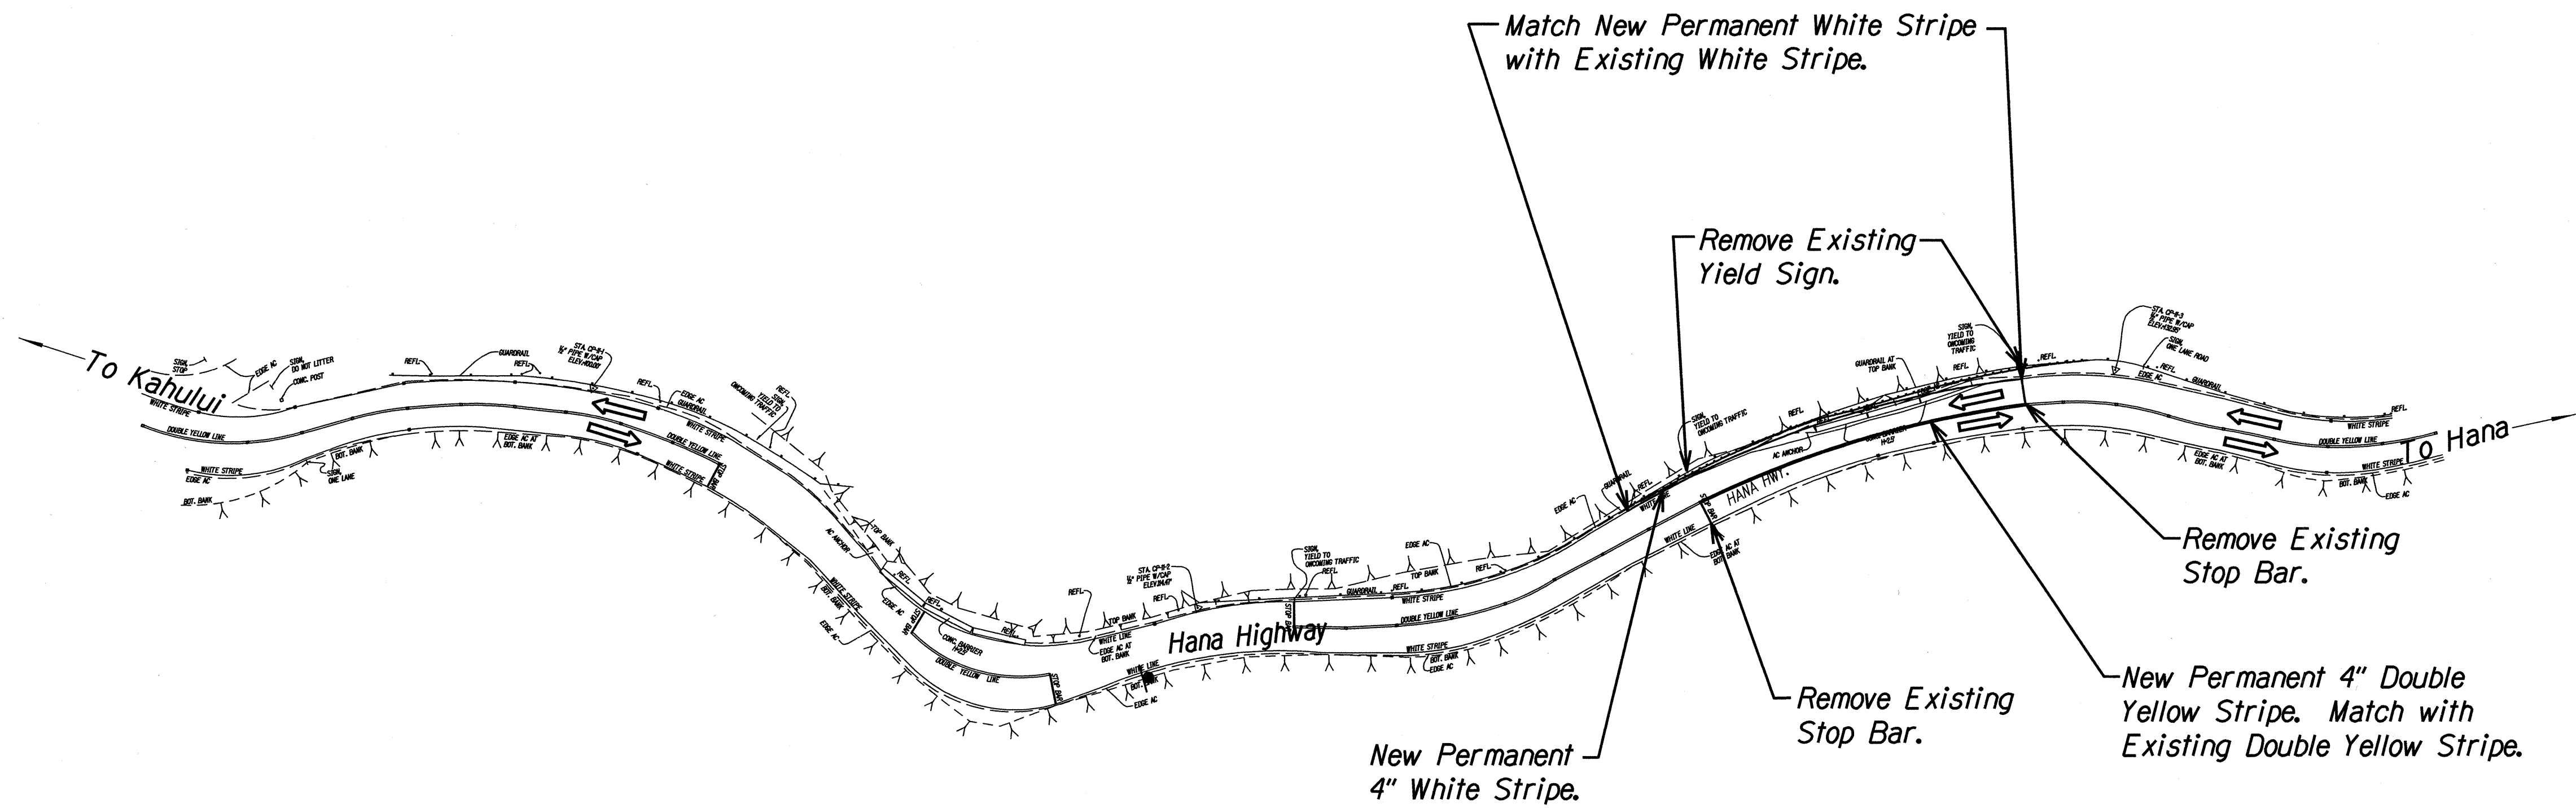

# LEGEND:

- ▬ Sign
- ⇒ Direction of Traffic

|                   |      |
|-------------------|------|
| SURVEY PLATTED BY | DATE |
| DESIGNED BY       |      |
| NOTED BY          |      |
| CHECKED BY        |      |
| ORIGINAL PLAN     |      |
| NOTE BOOK         |      |
| N.                |      |

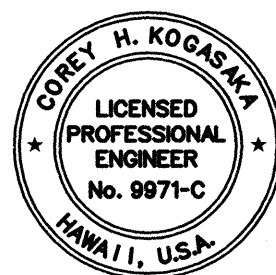


THIS WORK WAS PREPARED BY ME OR UNDER MY SUPERVISION AND CONSTRUCTION OF THIS PROJECT WILL BE UNDER MY OBSERVATION.  
 Date: 4/27/01

STATE OF HAWAII  
DEPARTMENT OF TRANSPORTATION  
HIGHWAYS DIVISION

**FINAL STRIPING PLAN**  
**SITE 9 AND 10, M.P. 14.3**  
HANA HIGHWAY  
REPAIRS AND MAINTENANCE  
PROJECT NO. 360AB-01-00M  
Scale: NTS Date: March, 2001  
SHEET No. 3 OF 5 SHEETS

| FED. ROAD DIST. NO. | STATE | PROJ. NO.    | FISCAL YEAR | SHEET NO. | TOTAL SHEETS |
|---------------------|-------|--------------|-------------|-----------|--------------|
| HAWAII              | HAW.  | 360AB-01-00M | 2001        | 29        | 56           |

TRUE NORTH  
SCALE: NTS

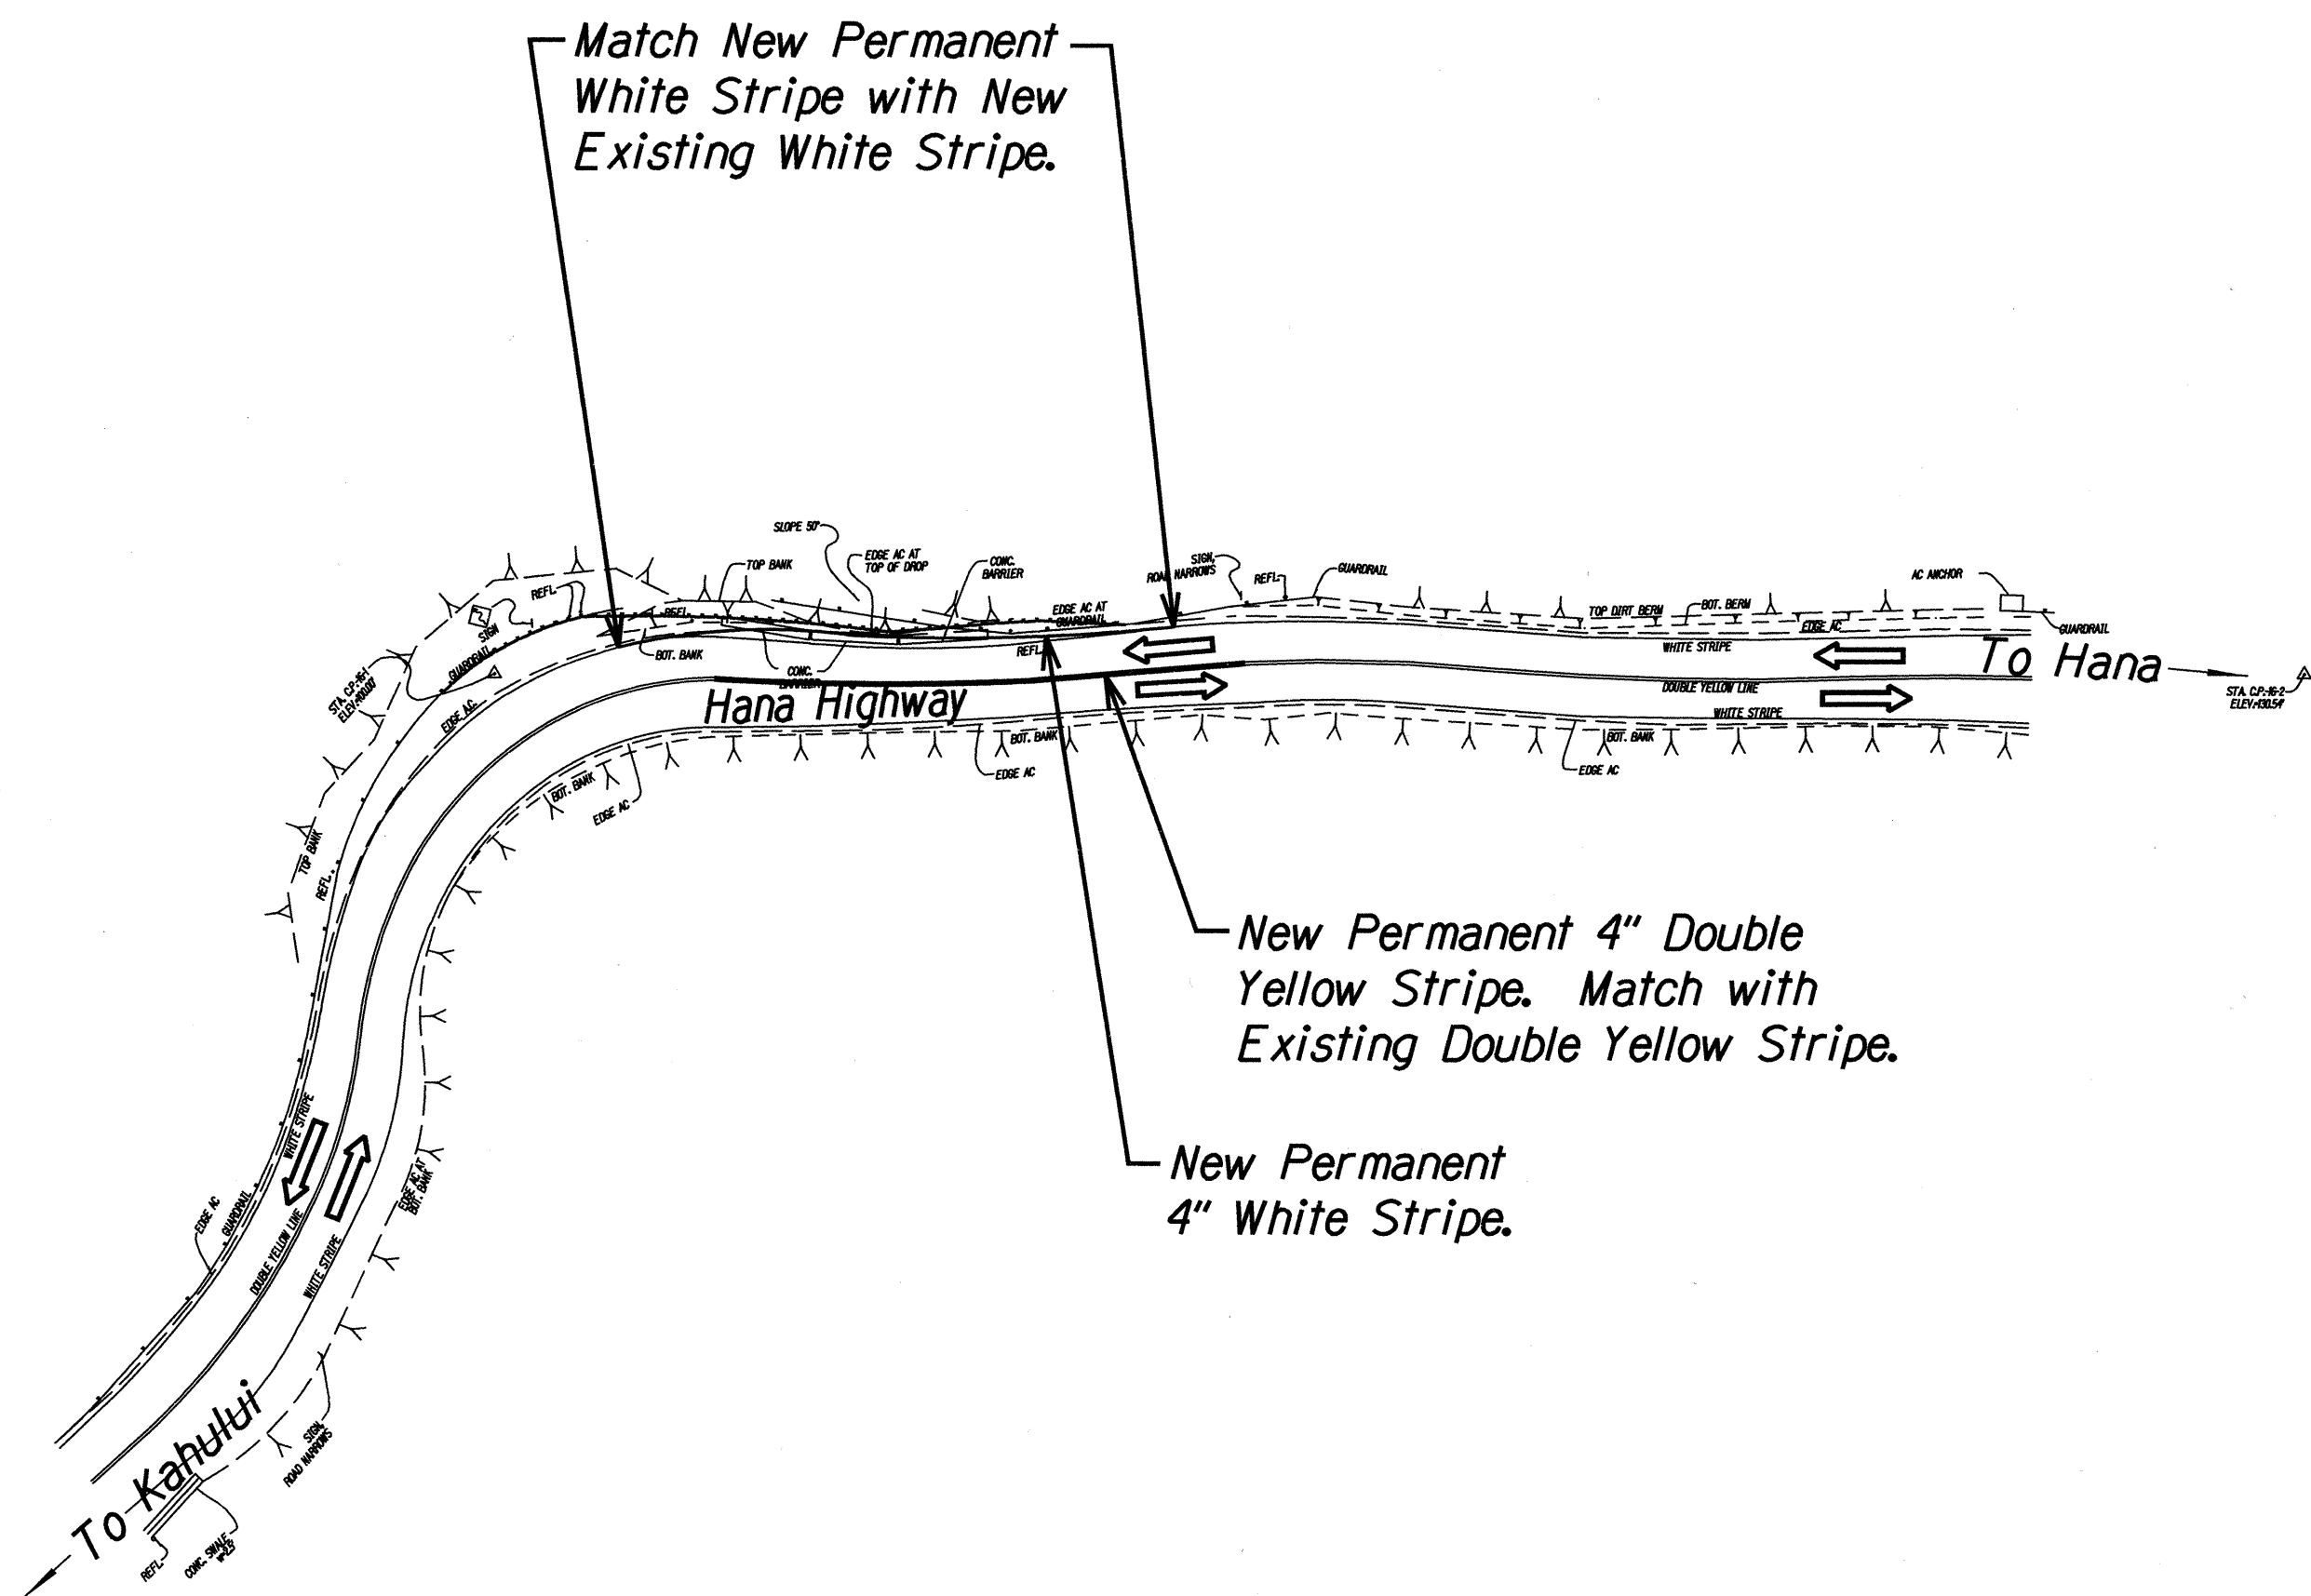

**LEGEND:**

• Sign

⇒ Direction of Traffic

|                   |      |
|-------------------|------|
| SURVEY PLOTTED BY | DATE |
| DESIGNED BY       |      |
| TRACED BY         |      |
| NOTE BOOK         |      |
| DESIGNED BY       |      |
| QUANTITIES BY     |      |
| CHECKED BY        |      |
| N.                |      |




THIS WORK WAS PREPARED BY ME OR UNDER MY SUPERVISION AND CONSTRUCTION OF THIS PROJECT WILL BE UNDER MY OBSERVATION.

*Corey H. Kogawa*

DATE: 4/27/01

STATE OF HAWAII  
DEPARTMENT OF TRANSPORTATION  
HIGHWAYS DIVISION  
**FINAL STRIPING PLAN**  
**SITE 14, M.P. 19.8**  
HANA HIGHWAY  
REPAIRS AND MAINTENANCE  
PROJECT NO. 360AB-01-00M  
Scale: NTS Date: March, 2001  
SHEET No. 4 OF 5 SHEETS


| FED. ROAD DIST. NO. | STATE | PROJ. NO.    | FISCAL YEAR | SHEET NO. | TOTAL SHEETS |
|---------------------|-------|--------------|-------------|-----------|--------------|
| HAWAII              | HAW.  | 360AB-01-00M | 2001        | 30        | 42           |

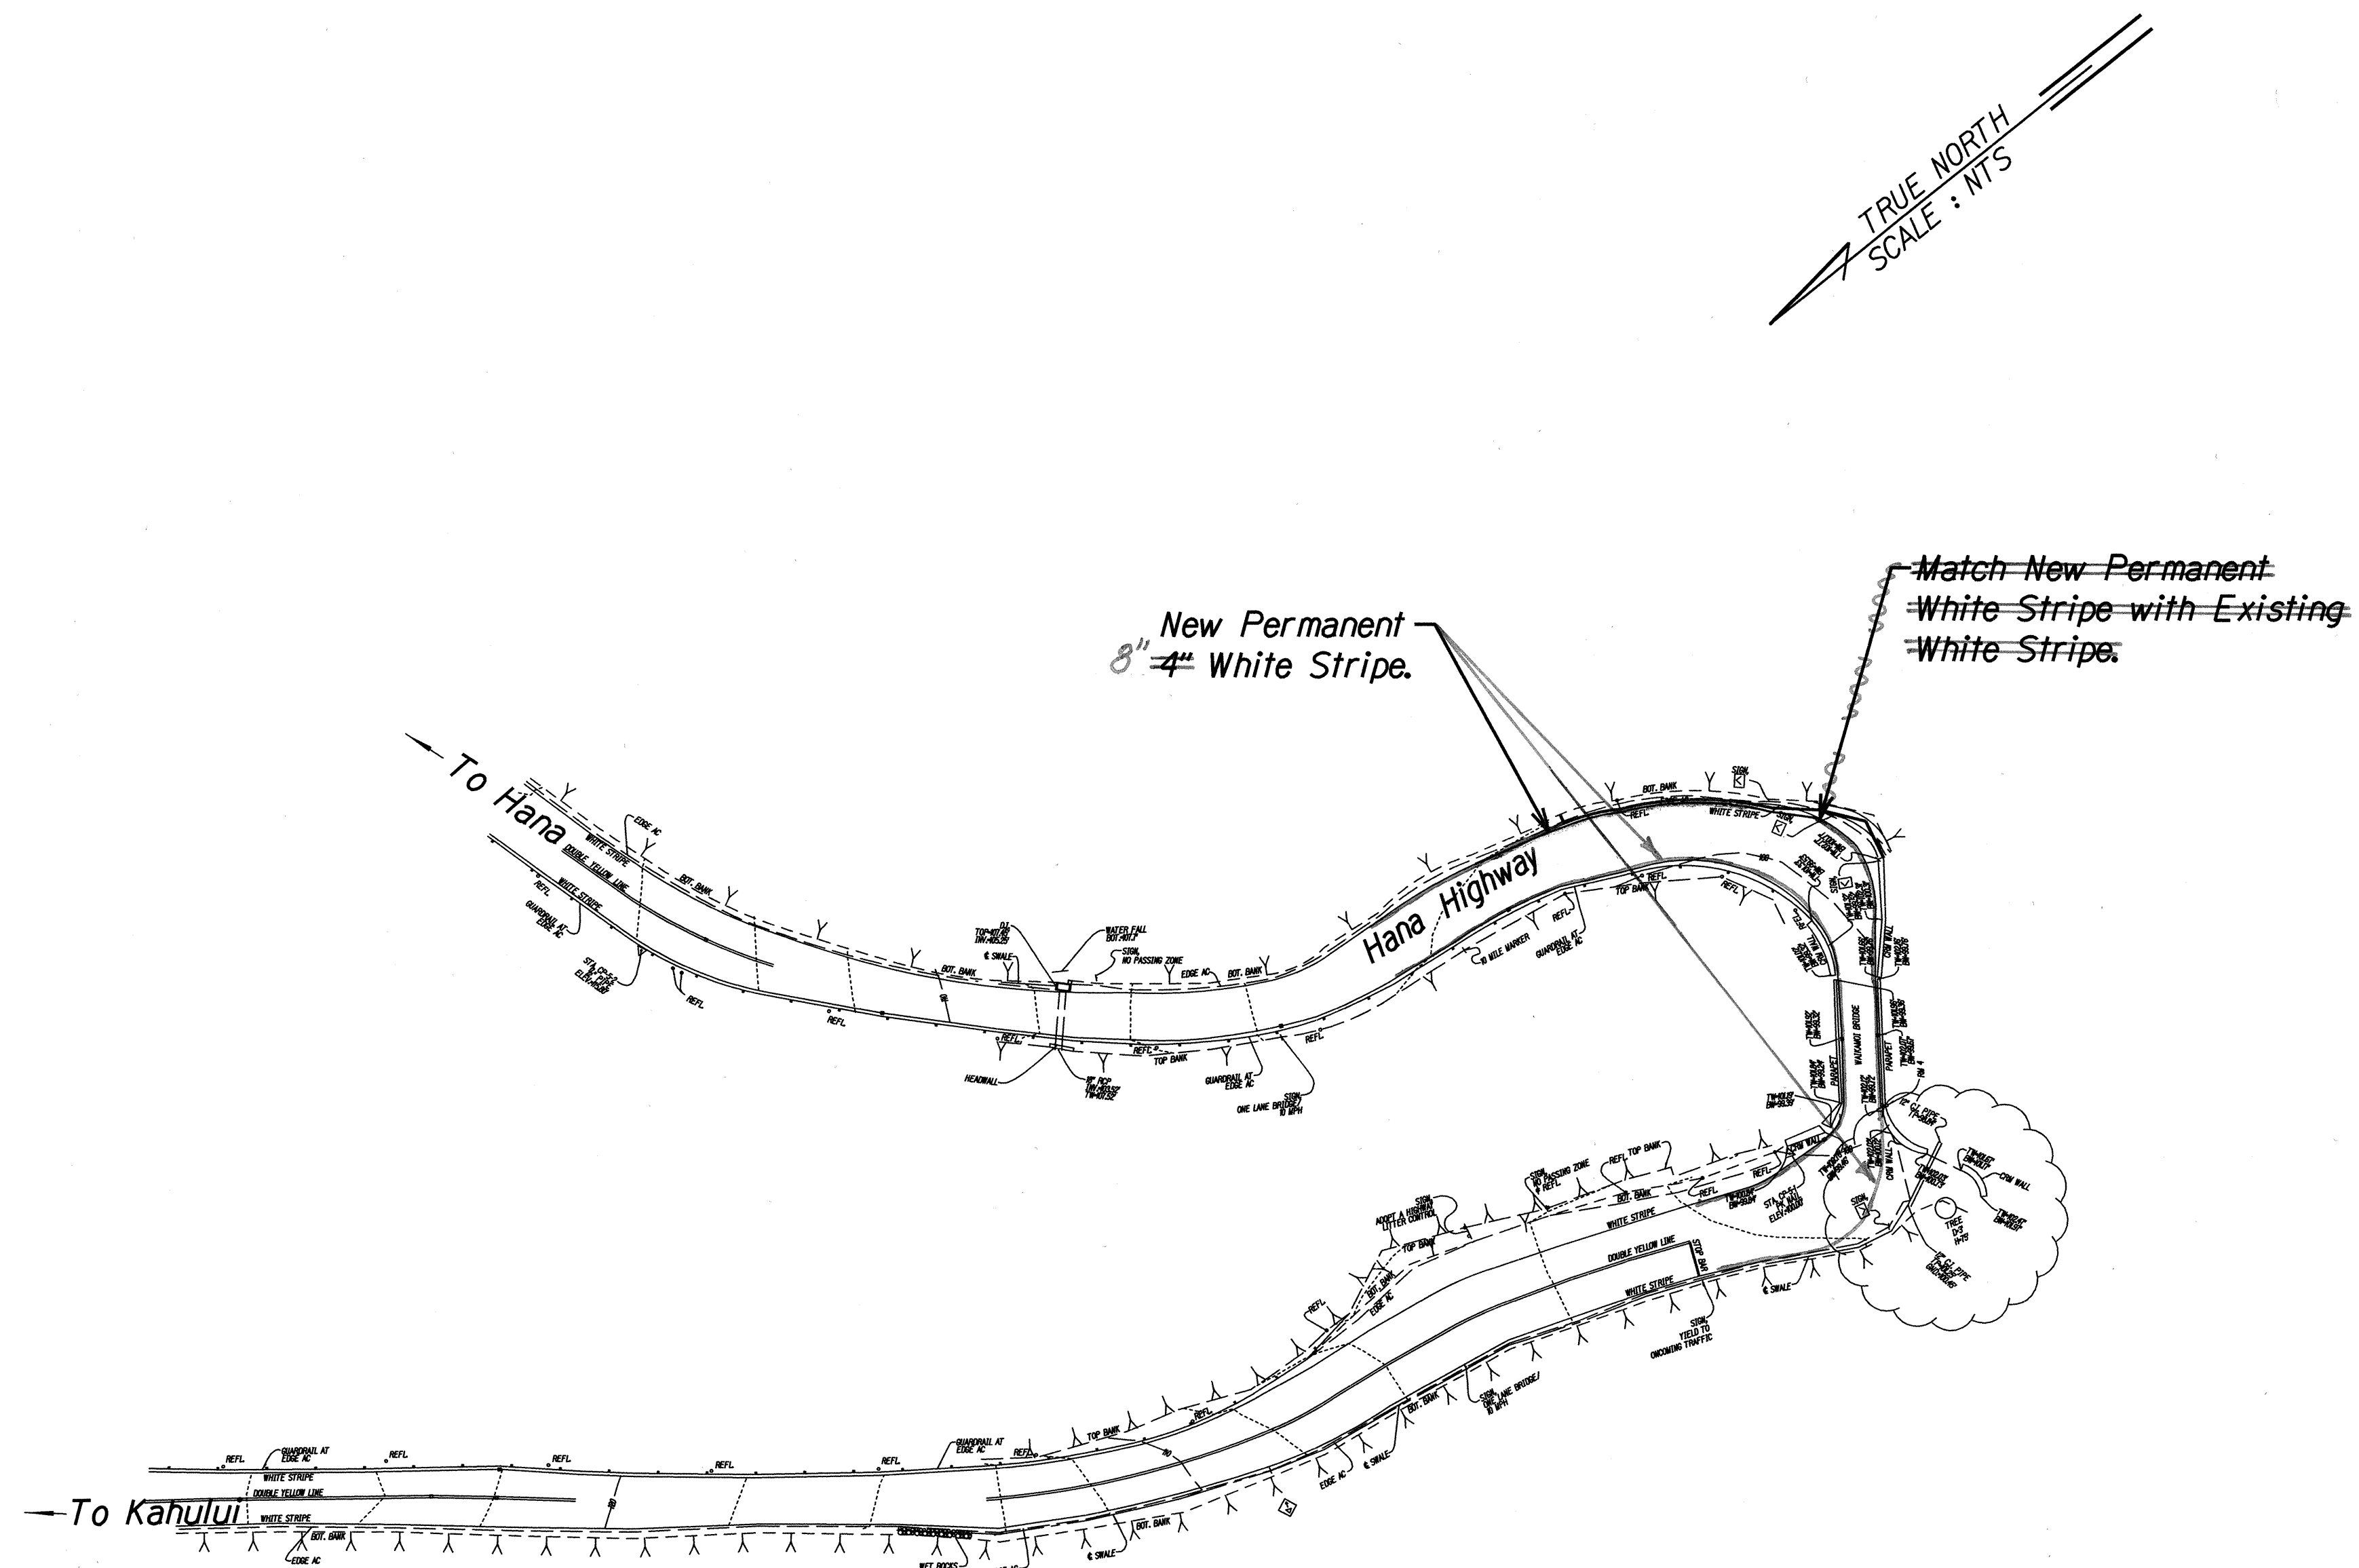

# **LEGEND:**

-  Sign
-  Direction of Traffic

|                   |      |
|-------------------|------|
| SURVEY PLOTTED BY | DATE |
| DESIGNED BY       |      |
| TRACED BY         |      |
| NOTE BOOK         |      |
| DESIGNED BY       |      |
| QUANTITIES BY     |      |
| CHECKED BY        |      |
| No.               |      |

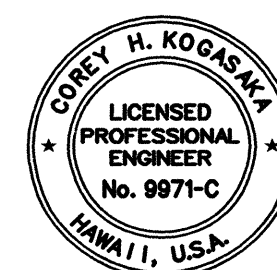

THIS WORK WAS PREPARED BY ME OR UNDER MY SUPERVISION AND CONSTRUCTION OF THIS PROJECT WILL BE UNDER MY OBSERVATION.  
*Corey H. Kookana*  
 DATE: 4/27/01

STATE OF HAWAII  
 DEPARTMENT OF TRANSPORTATION  
 HIGHWAYS DIVISION  
**FINAL STRIPING PLAN**  
**SITE 1, M.P. 10.0**  
**HANA HIGHWAY**  
**REPAIRS AND MAINTENANCE**  
**PROJECT NO. 360AB-01-00M**  
 Scale: NTS Date: March, 2001

SHEET No. 5 OF 5 SHEETS

"AS-BUILT"