





INDEX TO DRAWINGS	
SHEET NO.	DESCRIPTION
1	TITLE SHEET
2	STANDARD PLANS SUMMARY
3 - 6	GUARDRAIL DETAILS
7 - 8	WATER POLLUTION AND EROSION CONTROL NOTES
9	GENERAL NOTES AND LEGEND
10	PAVEMENT MARKINGS AND SIGNS, DETAILS, NOTES AND MISCELLANEOUS SUMMARIES
11 - 16	ROADWAY REPAIRS AT MILE POST 19.2
17 - 20	ROADWAY REPAIRS AT MILE POST 28.3
21 - 24	DRAINAGE REPAIRS AT MILE POST 34 (VICINITY OF KEAWA PLACE INTERSECTION)
25 - 26	DRAINAGE REPAIRS AT MILE POST 34 (VICINITY AT END OF KEAWA PLACE)

STATE OF HAWAII
DEPARTMENT OF TRANSPORTATION
HIGHWAYS DIVISION
HONOLULU, HAWAII
"AS-BUILT"
PLANS FOR
HANA HIGHWAY
EMERGENCY FEDERAL-AID PROJECT
ROADWAY REPAIRS
AT VARIOUS LOCATIONS

DISTRICT OF HANA
ISLAND OF MAUI

FEDERAL AID PROJECT NO. ER-12(5)

FED. ROAD DIST. NO.	STATE	FEDERAL AID PROJ. NO.	FISCAL YEAR	SHEET NO.	TOTAL SHEETS
HAWAII	HAW.	ER-12(5)	2001	1	26

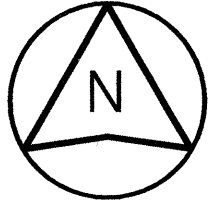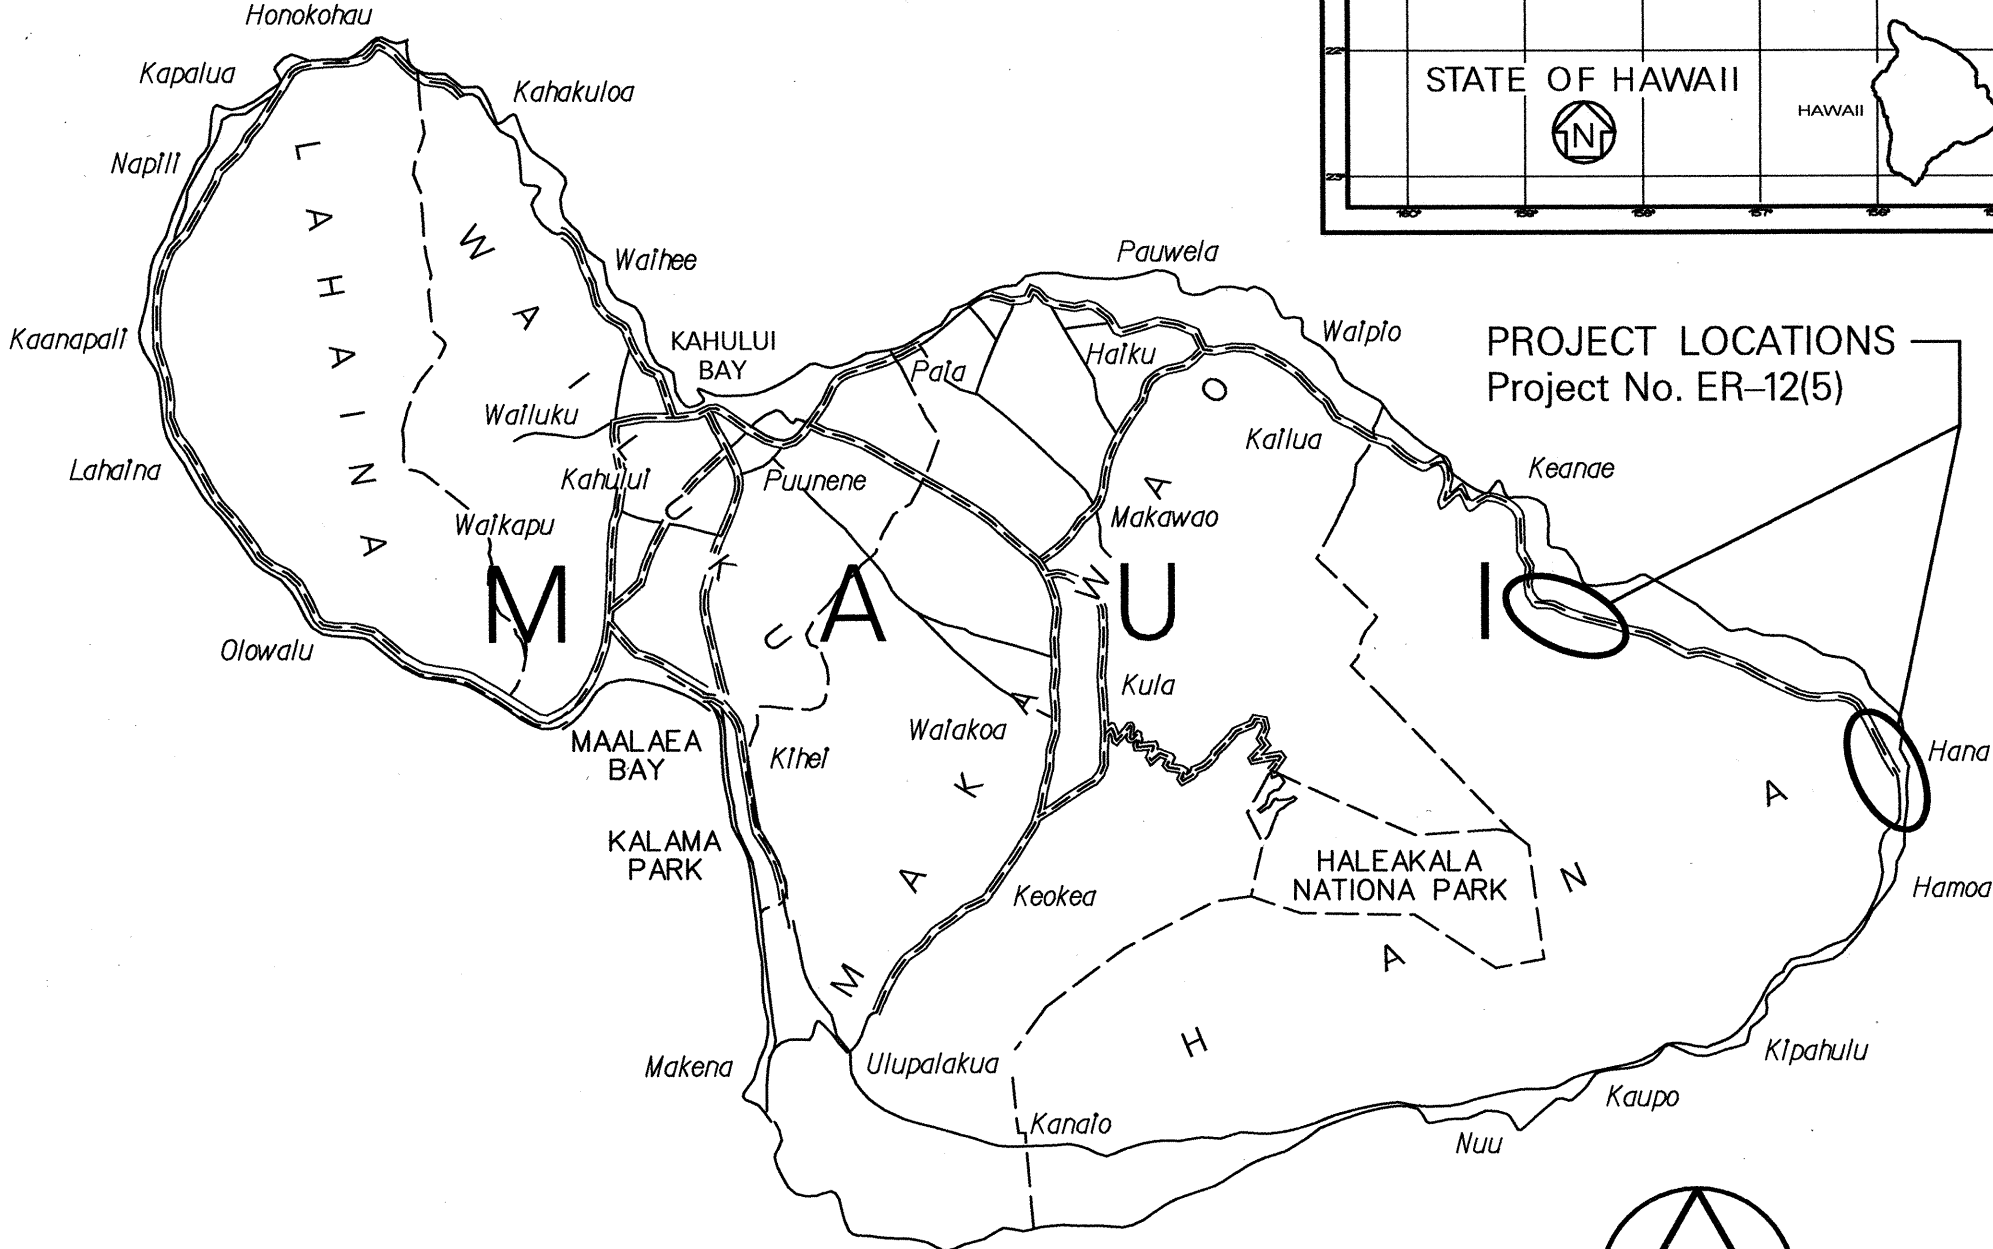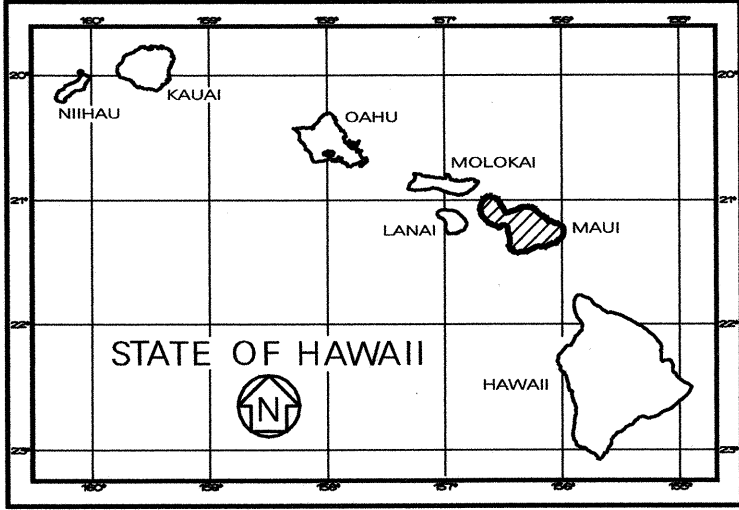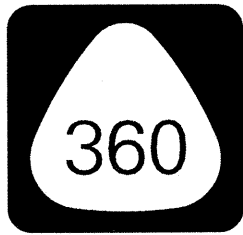

SCALE IN MILES

===== FEDERAL AID PROJECTS PREVIOUSLY CONSTRUCTED OR UNDER CONSTRUCTION

LOCATION 1: MILE POST 19.2
LOCATION 2: MILE POST 28.3
LOCATION 3: MILE POST 34.0

DESIGN DESIGNATION

CURRENT ADT (2001)	1,440
DESIGN ADT (2011)	1,630
DHV	190
D	85/15
T	1.5'
V (POSTED)	15 MPH
V (DESIGN)	20 MPH

NO SIGNIFICANT CHANGES WERE MADE SINCE CONSTRUCTION ON THESE PLANS EXCEPT CHANGES IN THE ORIGINAL THEORETICAL QUANTITIES. SEE ACTUAL QUANTITIES, REFER TO PROJECT DESIGN AND CONSTRUCTION BOOK.

[Signature] 5/11/03

DEPARTMENT OF TRANSPORTATION STATE OF HAWAII	
APPROVED:	
<i>[Signature]</i> FOR DIR. OF TRANSPORTATION	2-13-01 DATE


FEBRUARY 2001
DATE

873-3535
PHONE

HWY-M
P. S. & E. BY

R. T. TANAKA ENGINEERS, INC.
DESIGNED BY

DESIGNED BY	DATE
TRACED BY	
NOTE BOOK	
QUANTITIES BY	
CHECKED BY	

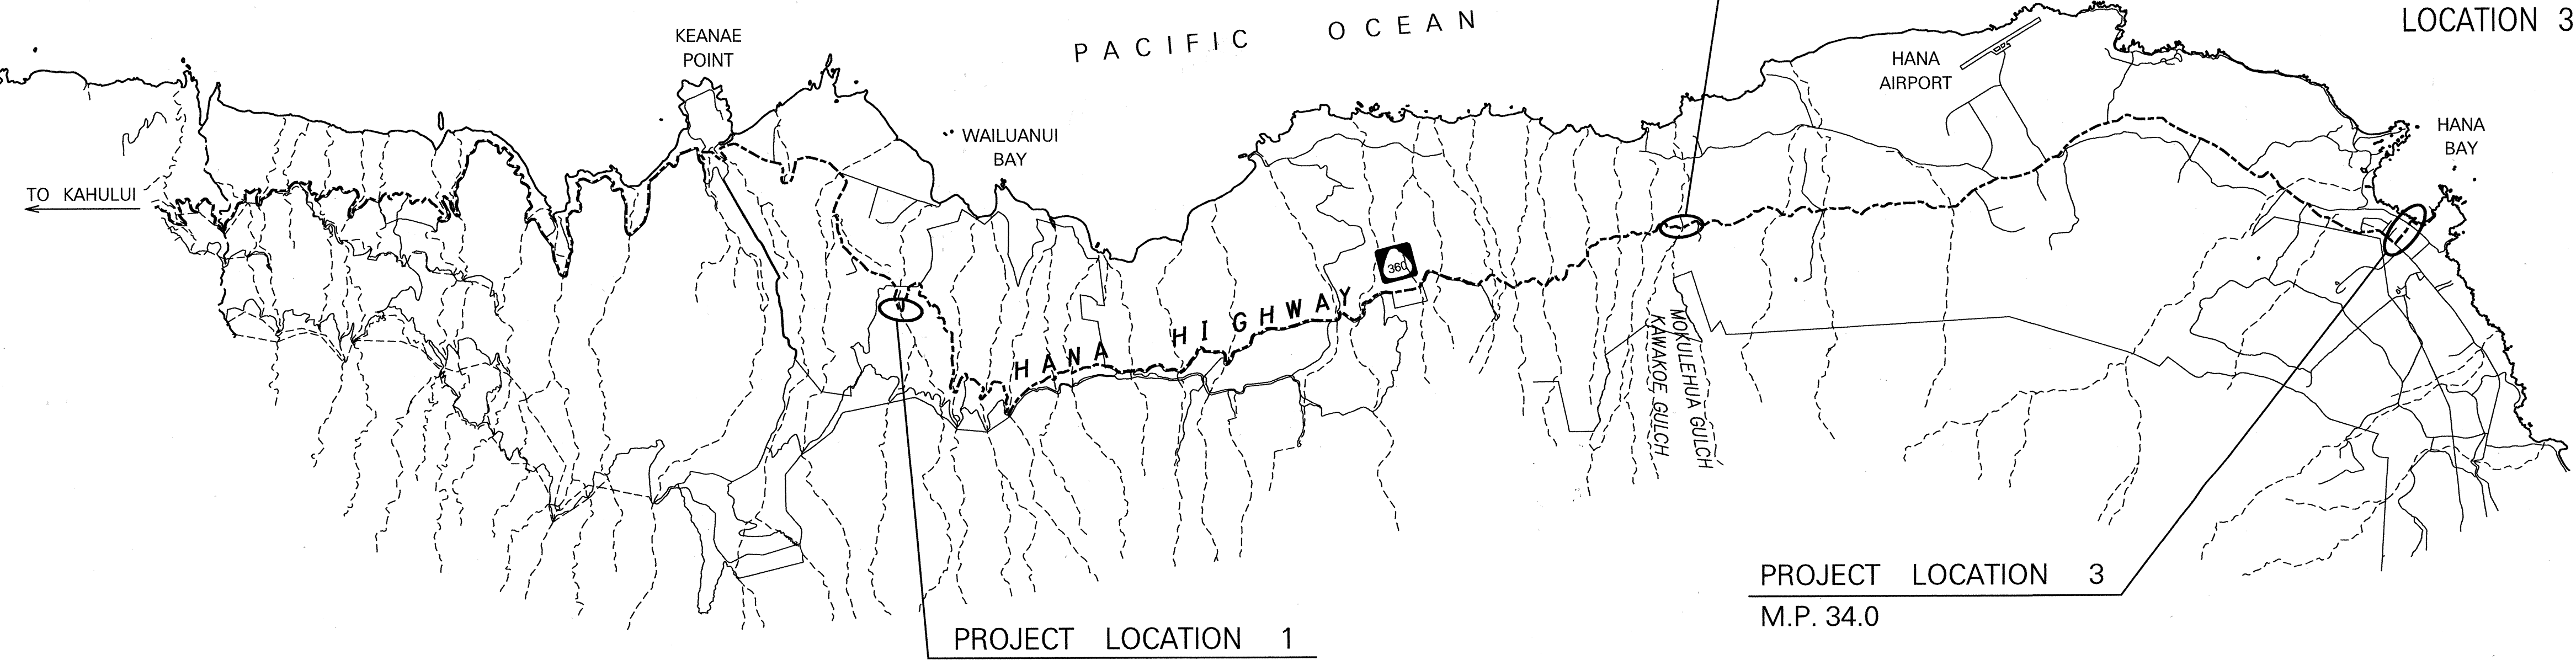

LAYOUT PLAN
NOT TO SCALE

