
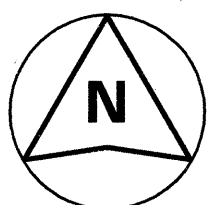
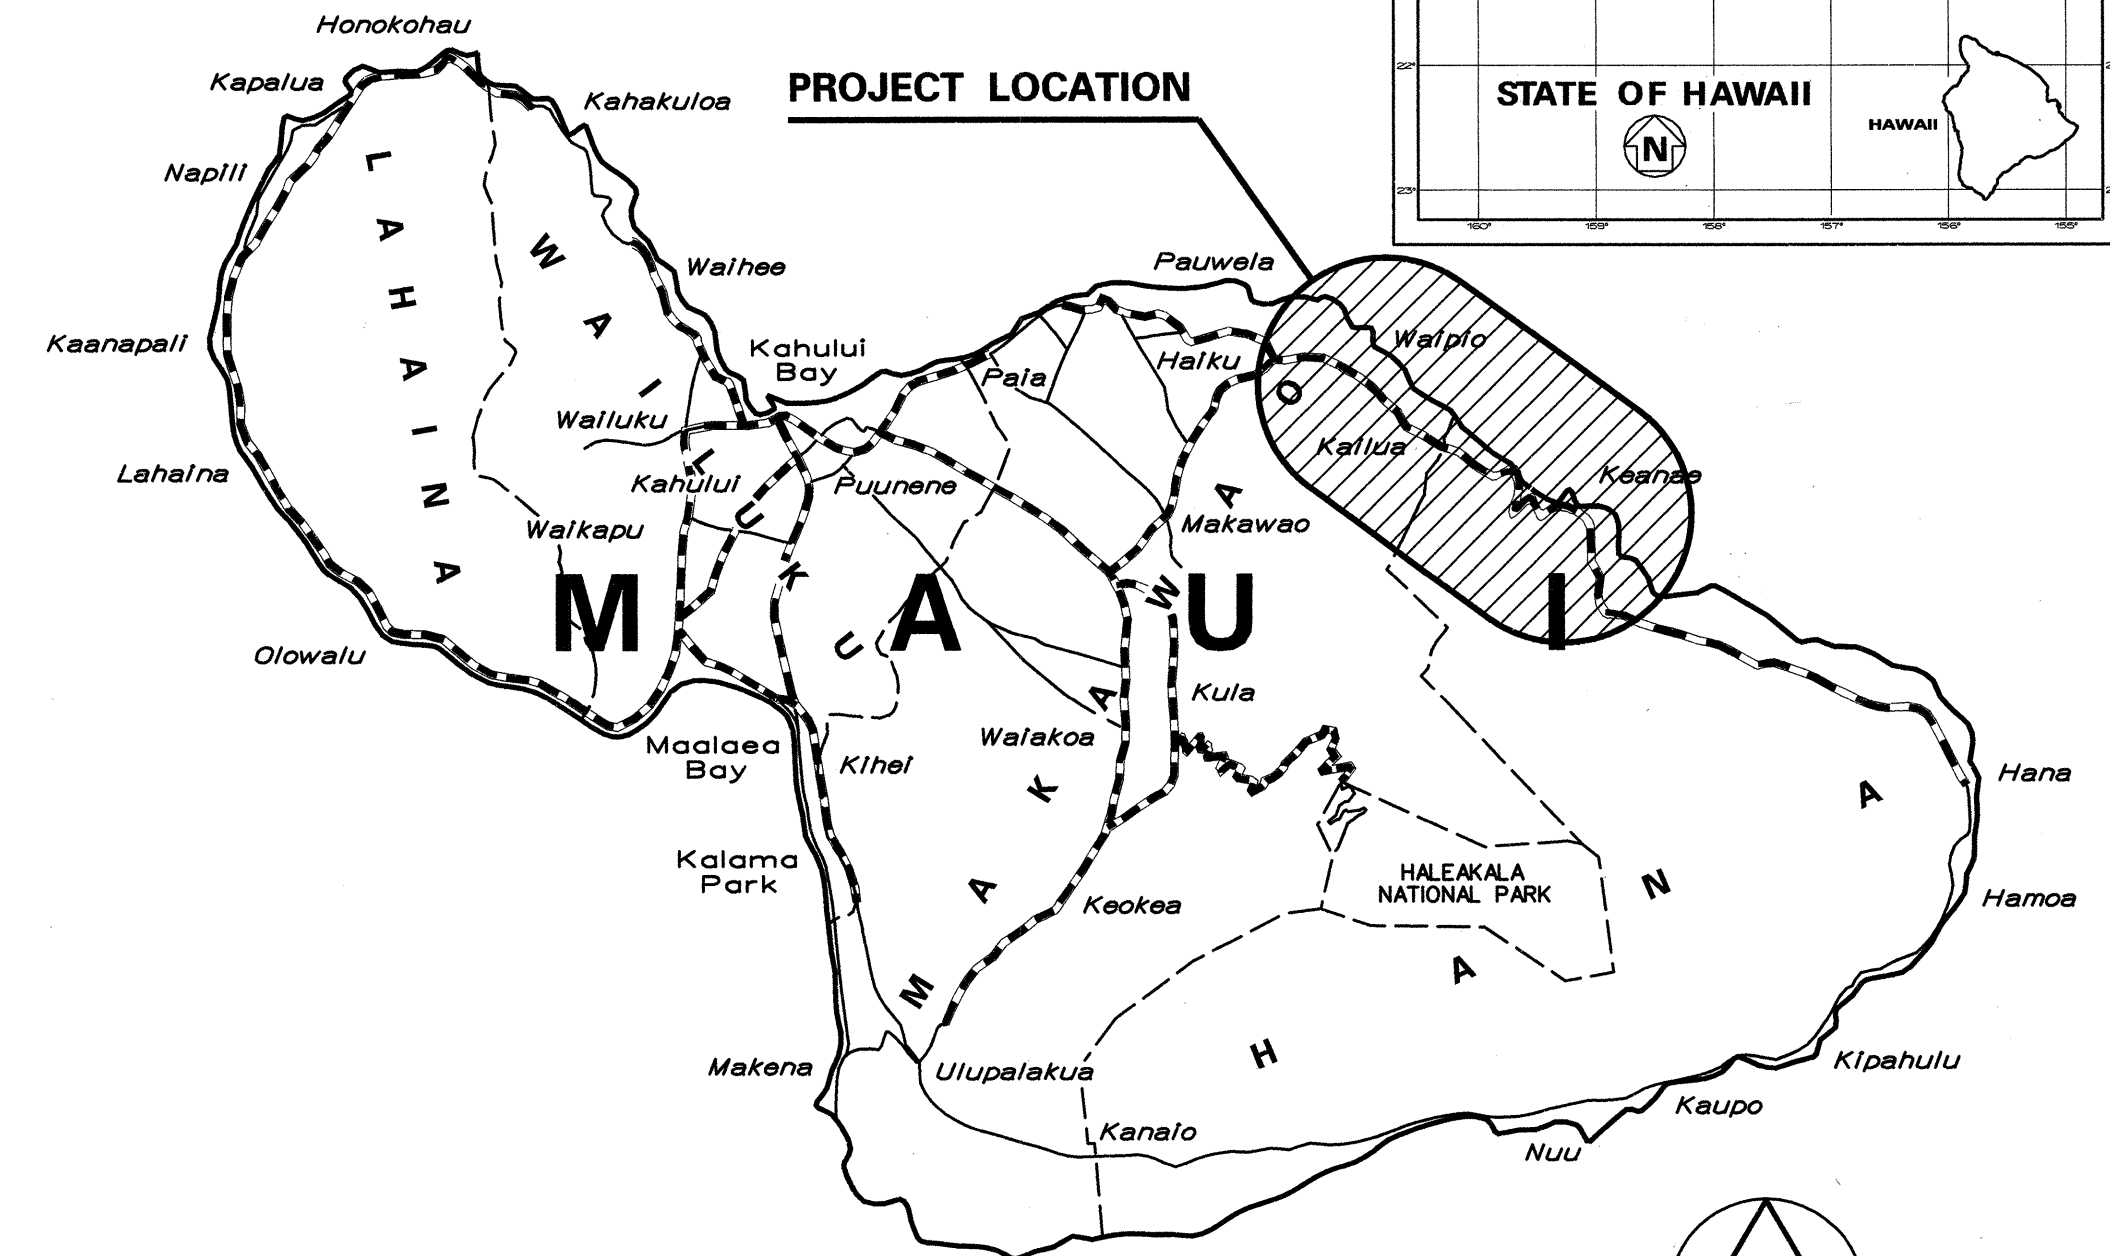
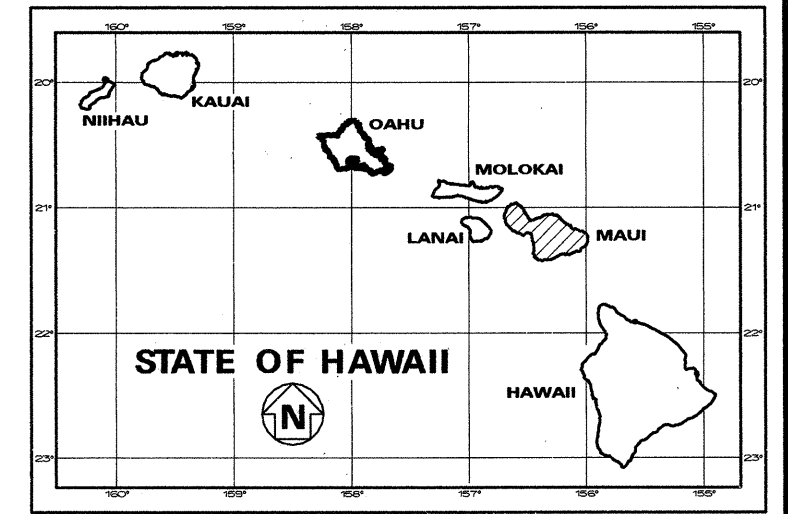


INDEX TO DRAWINGS	
SHEET NO.	DESCRIPTION
1	TITLE SHEET
2	STANDARD PLAN SUMMARY
3	GENERAL NOTES AND LEGEND
4	MISCELLANEOUS NOTES
5-6	WATER POLLUTION AND EROSION CONTROL NOTES
7-13	GUARDRAIL DETAILS
14-23	ROADWAY PLANS WITH DRAINAGE IMPROVEMENTS
24-37	TRAFFIC CONTROL PLANS
38	DRAINAGE SUMMARY
39-41	MISCELLANEOUS DETAILS

STATE OF HAWAII
DEPARTMENT OF TRANSPORTATION
HIGHWAYS DIVISION
HONOLULU, HAWAII
"AS-BUILT"
PLANS FOR
**ROUTE 360 HANA HIGHWAY
REPAIRS AND MAINTENANCE**
AT VARIOUS LOCATIONS, PHASE 2
PROJECT NO. 360AB-01-02M
DISTRICTS OF MAKAWAO AND HANA
ISLAND OF MAUI



FED. ROAD DIST. NO.	STATE	PROJ. NO.	FISCAL YEAR	SHEET NO.	TOTAL SHEETS
HAWAII	HAW.	360AB-01-02M	2002	1	41

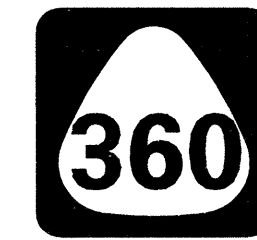

SCALE IN MILES

FEDERAL AID PROJECTS PREVIOUSLY CONSTRUCTED OR UNDER CONSTRUCTION

MILE POST 1.9 TO MILE POST 20.8

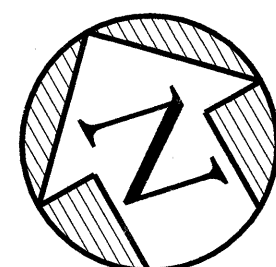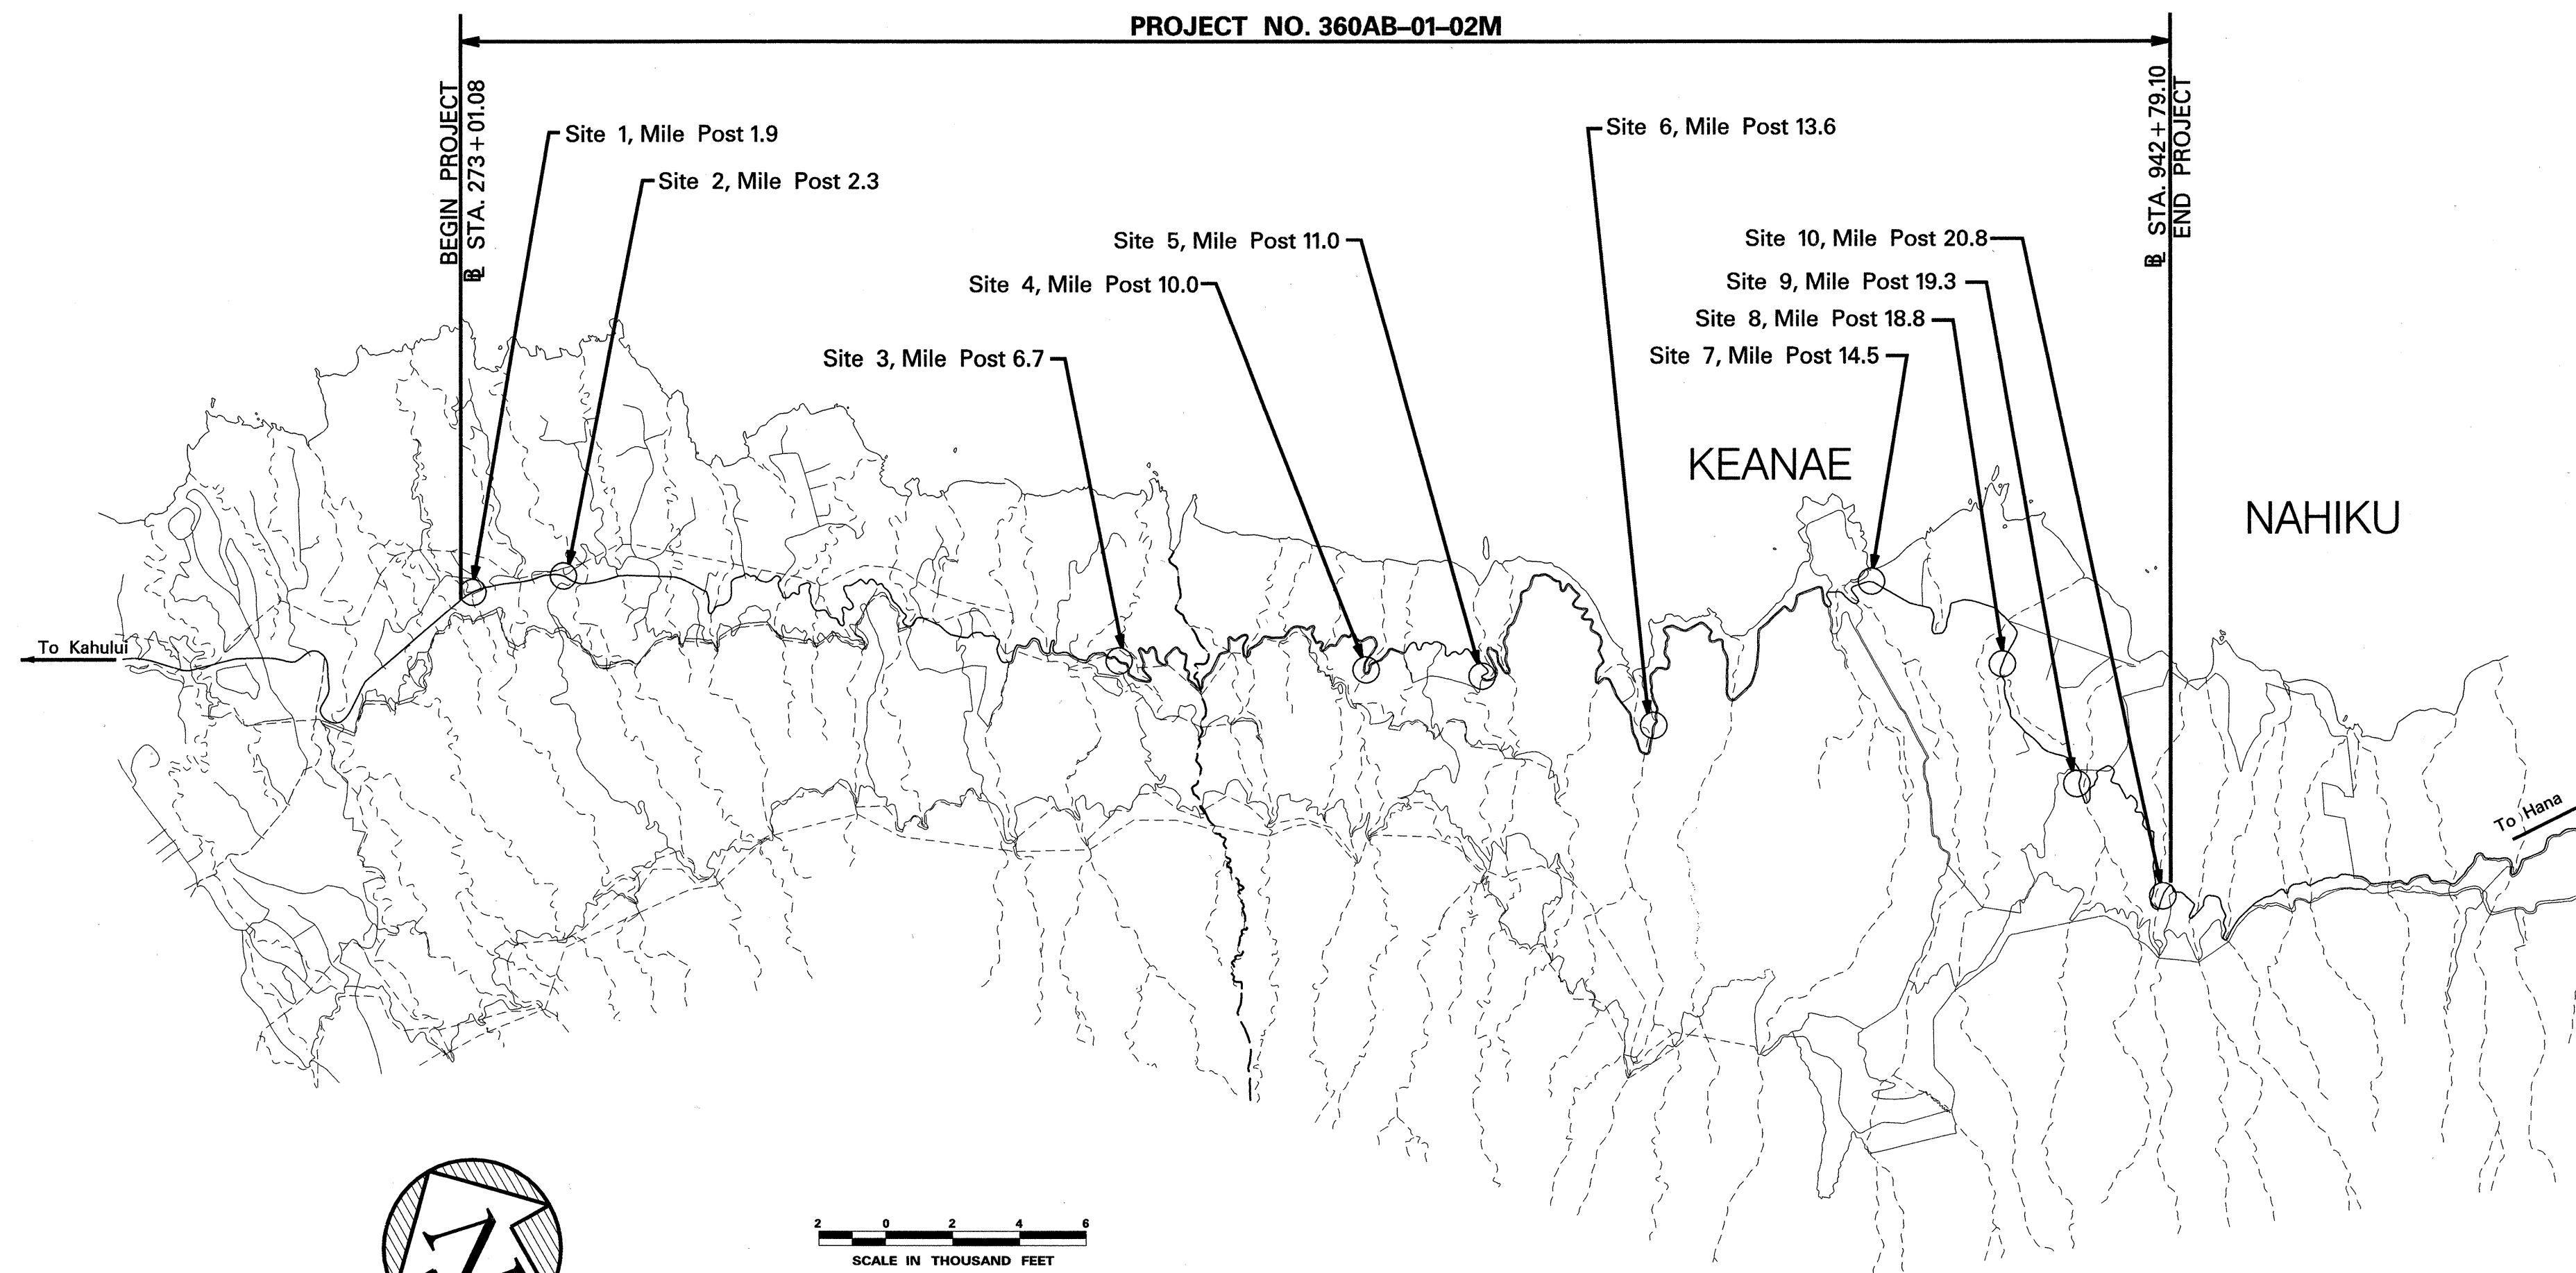

SCALE IN THOUSAND FEET

CHANGES MADE DURING CONSTRUCTION HAVE BEEN INCORPORATED ON THESE PLANS EXCEPT IN CHANGES IN THE ORIGINAL THEORETICAL QUANTITIES FOR ACTUAL QUANTITIES REFER TO PROJECT LENDER AND/OR CONSULTATION BOOK.

RESIDENT ENGINEER DATE

DEPARTMENT OF TRANSPORTATION
STATE OF HAWAII
APPROVED:
for DIR. OF TRANSPORTATION DATE

ORIGINAL PLAN	DATE
SURVEY PLOTTED BY	
DRAWN BY	
DESIGNED BY	
CHECKED BY	

DMIT Consulting Engineers
DESIGNED BY
S. Urada
P.S. & E. BY
692-7553
PHONE
April, 2002
DATE