


FED. ROAD DIST. NO.	STATE	PROJ. NO.	FISCAL YEAR	SHEET NO.	TOTAL SHEETS
HAWAII	HAW.	360AB-02-98, Phase I	2004	8	28

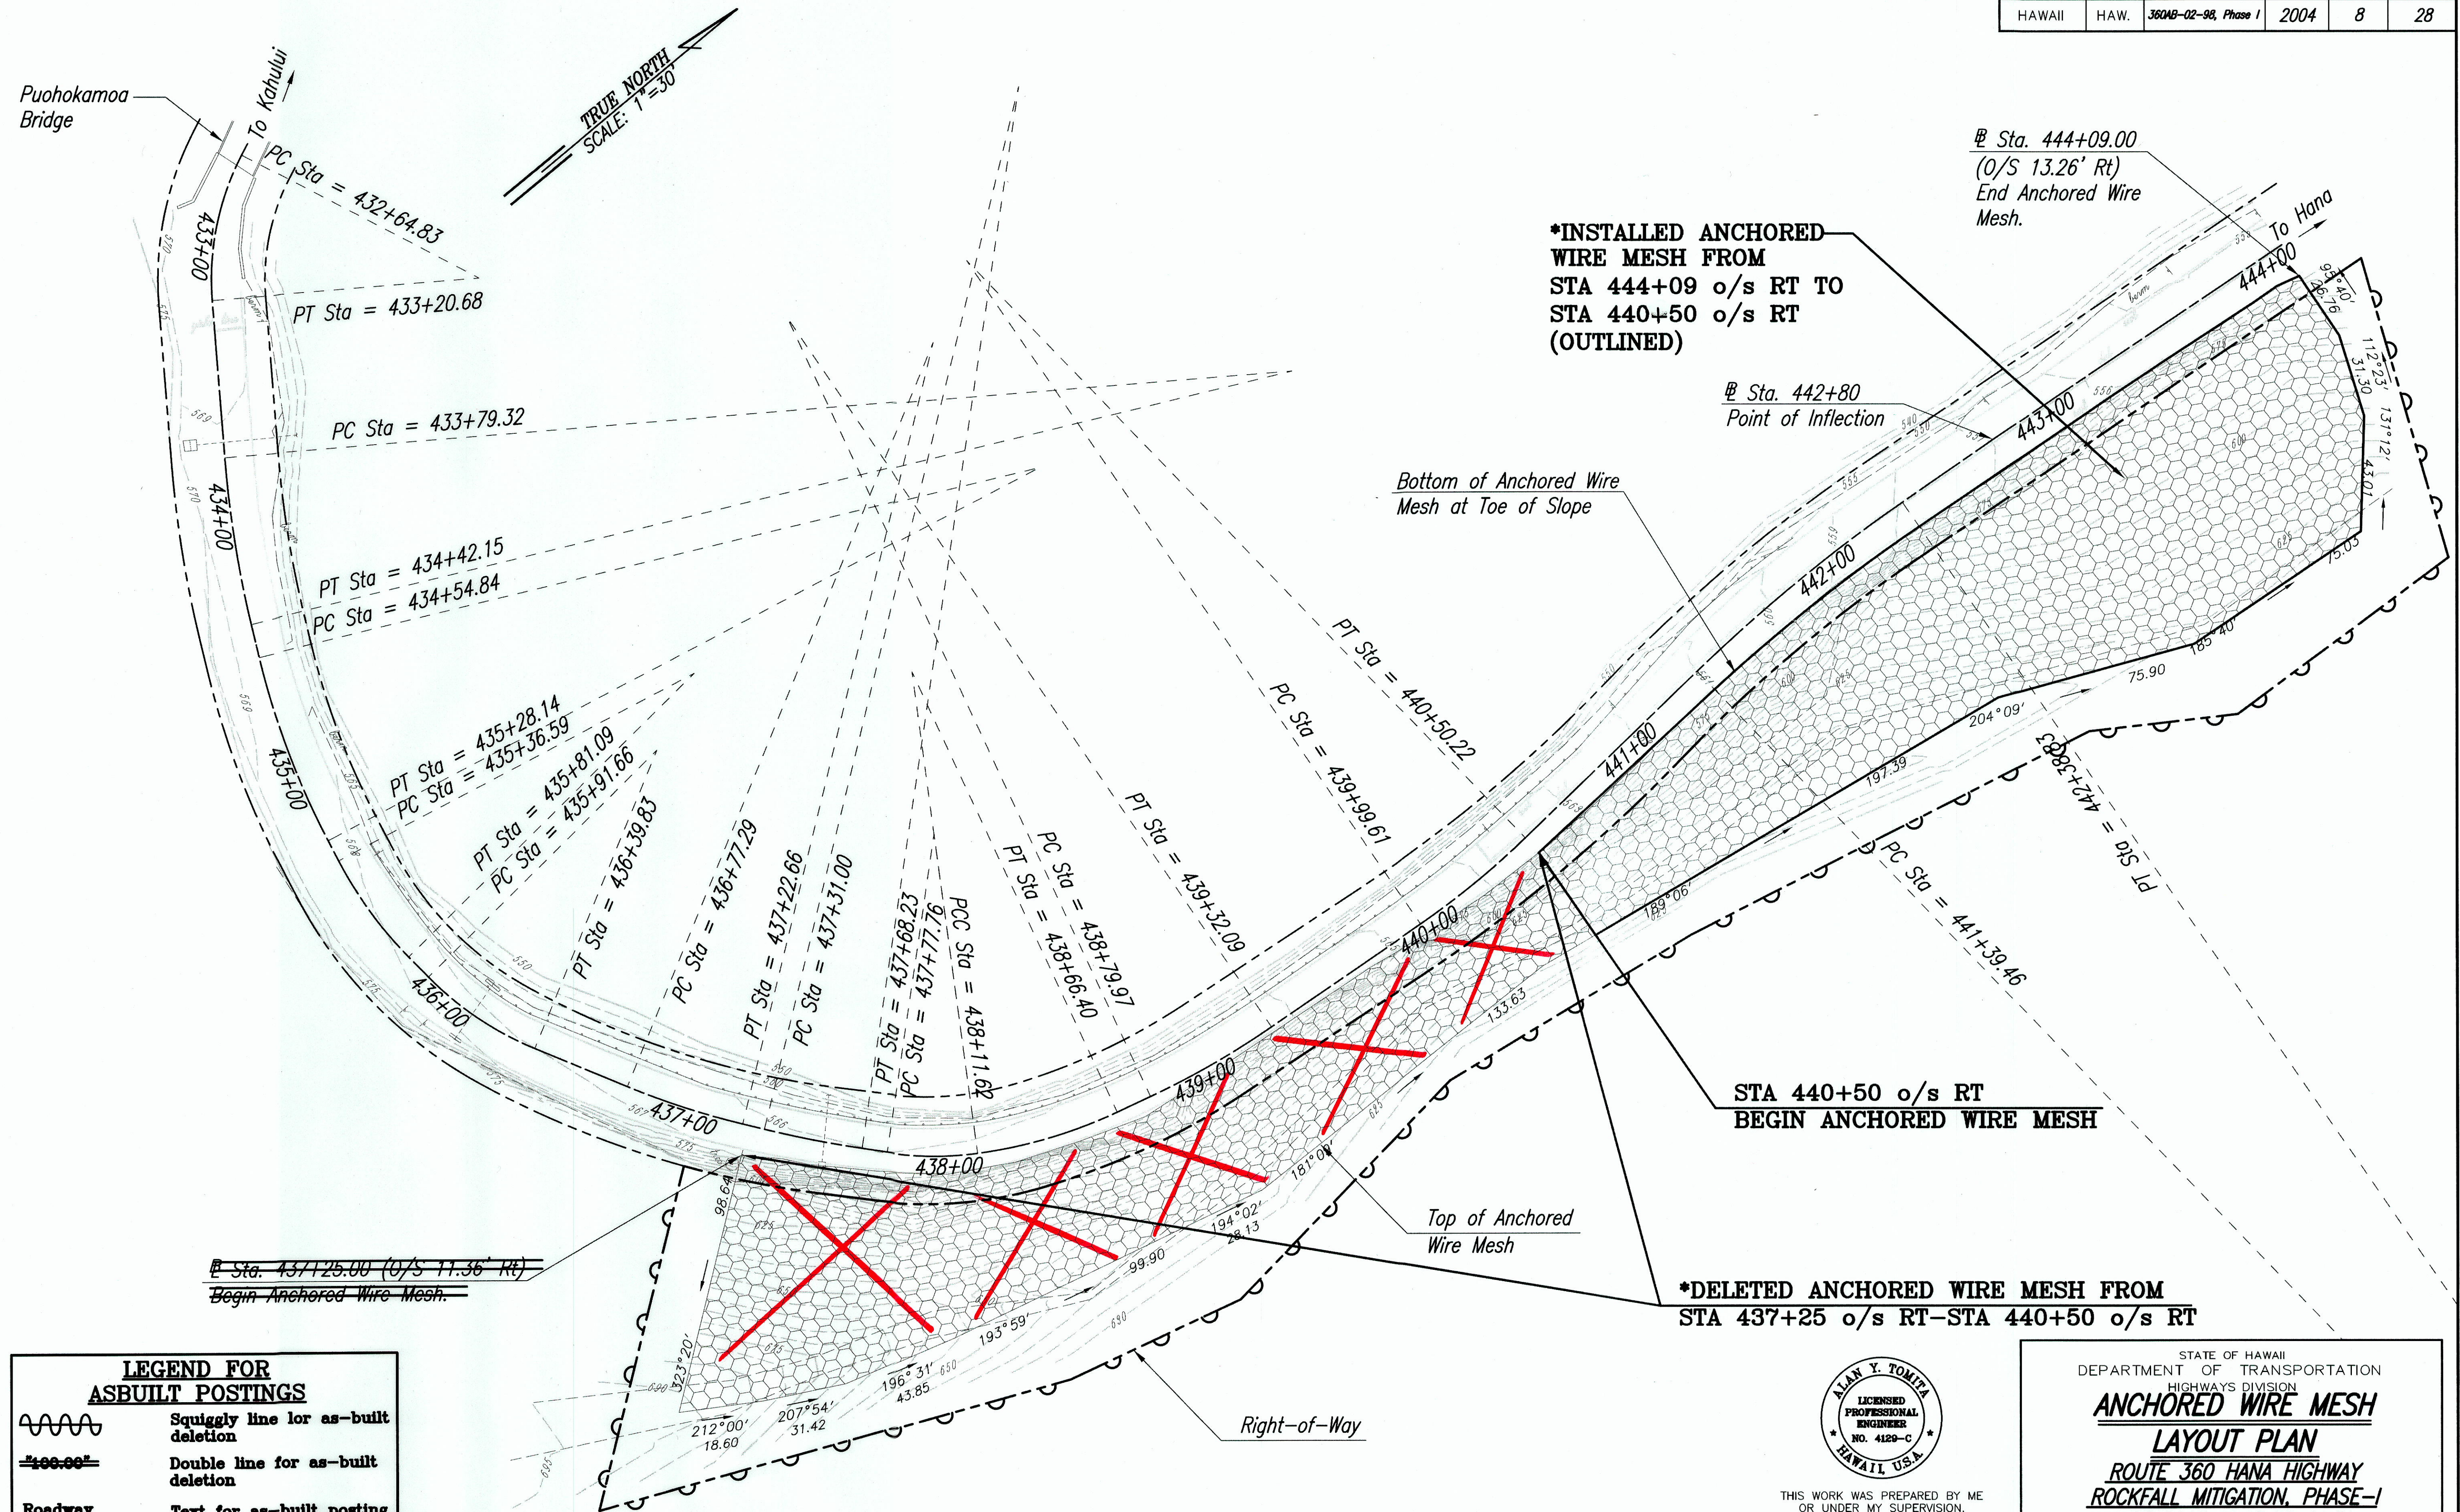

Wire Mesh Layout Plan
Scale: 1"=30'

ALAN Y. TOMITA
LICENSED PROFESSIONAL ENGINEER
NO. 4129-C
HAWAII, USA

THIS WORK WAS PREPARED BY ME OR UNDER MY SUPERVISION.

Alan Y. Tomita

STATE OF HAWAII
DEPARTMENT OF TRANSPORTATION
HIGHWAYS DIVISION

ANCHORED WIRE MESH LAYOUT PLAN

ROUTE 360 HANA HIGHWAY
ROCKFALL MITIGATION, PHASE-I
MILE POST 11.05 TO 11.31
Project No. 360AB-02-98, Phase I
Scale: 1"=30' Date: May 2004

SHEET No. 8 OF 28 SHEETS

"AS-BUILT"