

FED. ROAD DIST. NO.	STATE	PROJ. NO.	FISCAL YEAR	SHEET NO.	TOTAL SHEETS
HAWAII	HAW.	360AB-02-98, Phase I	2004	7	28

Baseline Curve Data

	①	②	③	④	⑤	⑥
Δ	32°00'	9°00'	14°00'	17°00'	23°00'	8°40'
R	100.00'	400.00'	300.00'	150.00'	120.00'	300.00'
T	28.67'	31.48'	36.84'	22.42'	24.41'	22.73'
C	55.13'	62.77'	73.12'	44.34'	47.85'	45.34'
Lc	55.85'	62.83'	73.30'	44.51'	48.17'	45.38'


	⑦	⑧	⑨	⑩	⑩	⑫
Δ	5°20'	16°10'	17°20'	9°20'	9°40'	9°20'
R	400.00'	120.00'	181.08'	320.00'	300.00'	610.00'
T	18.63'	17.04'	27.60'	26.12'	25.37'	49.79'
C	37.22'	33.75'	54.57'	52.07'	50.55'	99.26'
Lc	37.23'	33.86'	54.78'	52.13'	50.61'	99.37'

HH-3B
(1/2" PIPE)
12631.95 S.
34078.48 E.
ELEV.=555.33
REF. "KAPUAI"

Sta. 442+80
Point of Inflection

Sta. 444+09.00
(O/S 13.26' Rt)
End Anchored Wire Mesh.

HH-3D
(HUB)
12942.59 S.
34077.89 E.
ELEV.=564.36
REF. "KAPUAI"

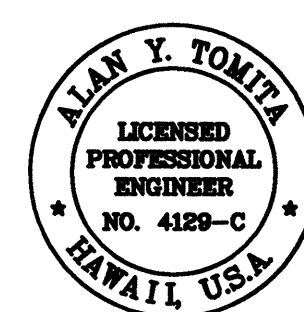

THIS WORK WAS PREPARED BY ME OR UNDER MY SUPERVISION.

Wang Senth

STATE OF HAWAII
DEPARTMENT OF TRANSPORTATION
HIGHWAYS DIVISION

SITE PLAN

ROUTE 360 HANA HIGHWAY
ROCKFALL MITIGATION, PHASE-I
MILE POST 11.05 TO 11.31
Project No. 360AB-02-98, Phase I
Scale: 1"=30' Date: May 2004

SHEET No. 7 OF 28 SHEETS

Site Plan
Scale: 1"=30'

ORIGINAL PLAN	DATE
SURVEY PLOTTED BY	
DESIGNED BY	
TRACED BY	
QUANTITIES BY	
CHECKED BY	
No.	

