
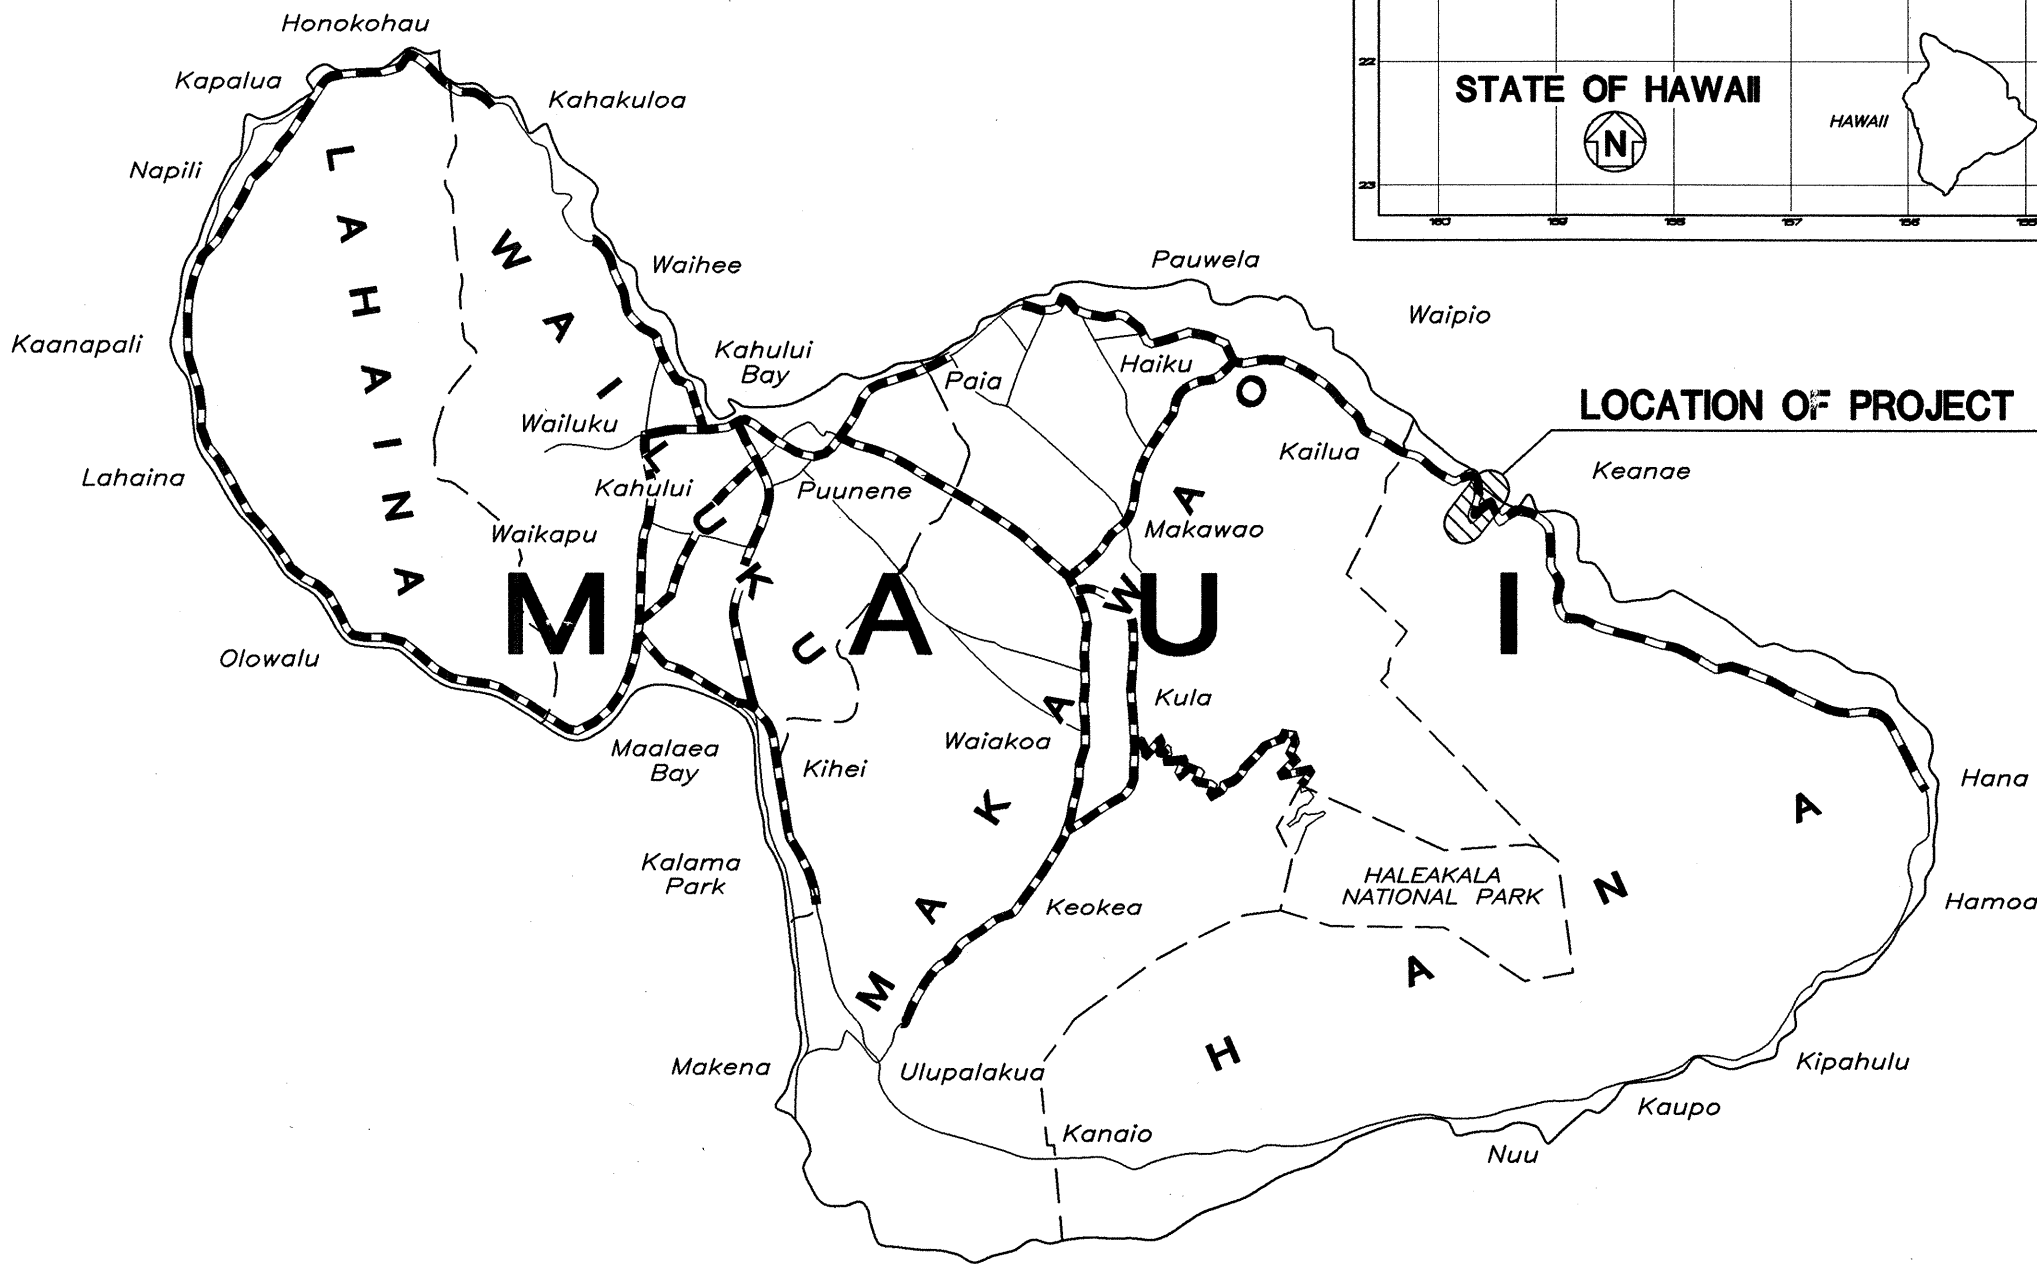



INDEX TO DRAWINGS	
SHEET NO.	DESCRIPTION
1	TITLE SHEET
2	STANDARD PLANS SUMMARY
3	GENERAL NOTES AND LEGEND
4	WATER POLLUTION & EROSION CONTROL NOTES
5	GEOTECHNICAL NOTES
6	LOCATION & GENERAL PLAN
7	SITE PLAN
8	ANCHORED WIRE MESH LAYOUT PLAN
9	ANCHOR LAYOUT AND DETAILS
10	HIGH STRENGTH WIRE MESH DETAILS
11	GROUTED ANCHORS
12-26	CROSS-SECTIONS
27-28	TRAFFIC CONTROL PLANS

STATE OF HAWAII
DEPARTMENT OF TRANSPORTATION
HIGHWAYS DIVISION
HONOLULU, HAWAII
PLANS FOR
**ROUTE 360 HANA HIGHWAY
ROCKFALL MITIGATION, PHASE-I
MILEPOST 11.05 TO 11.31**
PROJECT NO. 360AB-02-98, Phase I
DISTRICT OF HANA
ISLAND OF MAUI

FED. ROAD DIST. NO.	STATE	PROJ. NO.	FISCAL YEAR	SHEET NO.	TOTAL SHEETS
HAWAII	HAW.	360AB-02-98, Phase I	2003	1	28

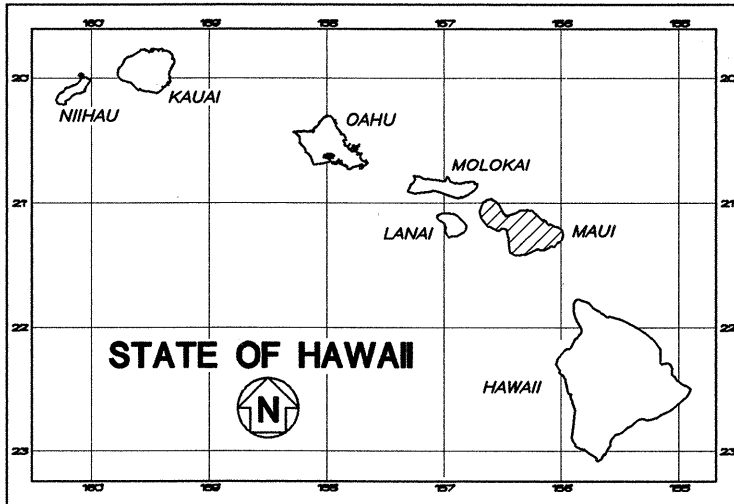

MILE POST 11.05 TO MILE POST 11.31

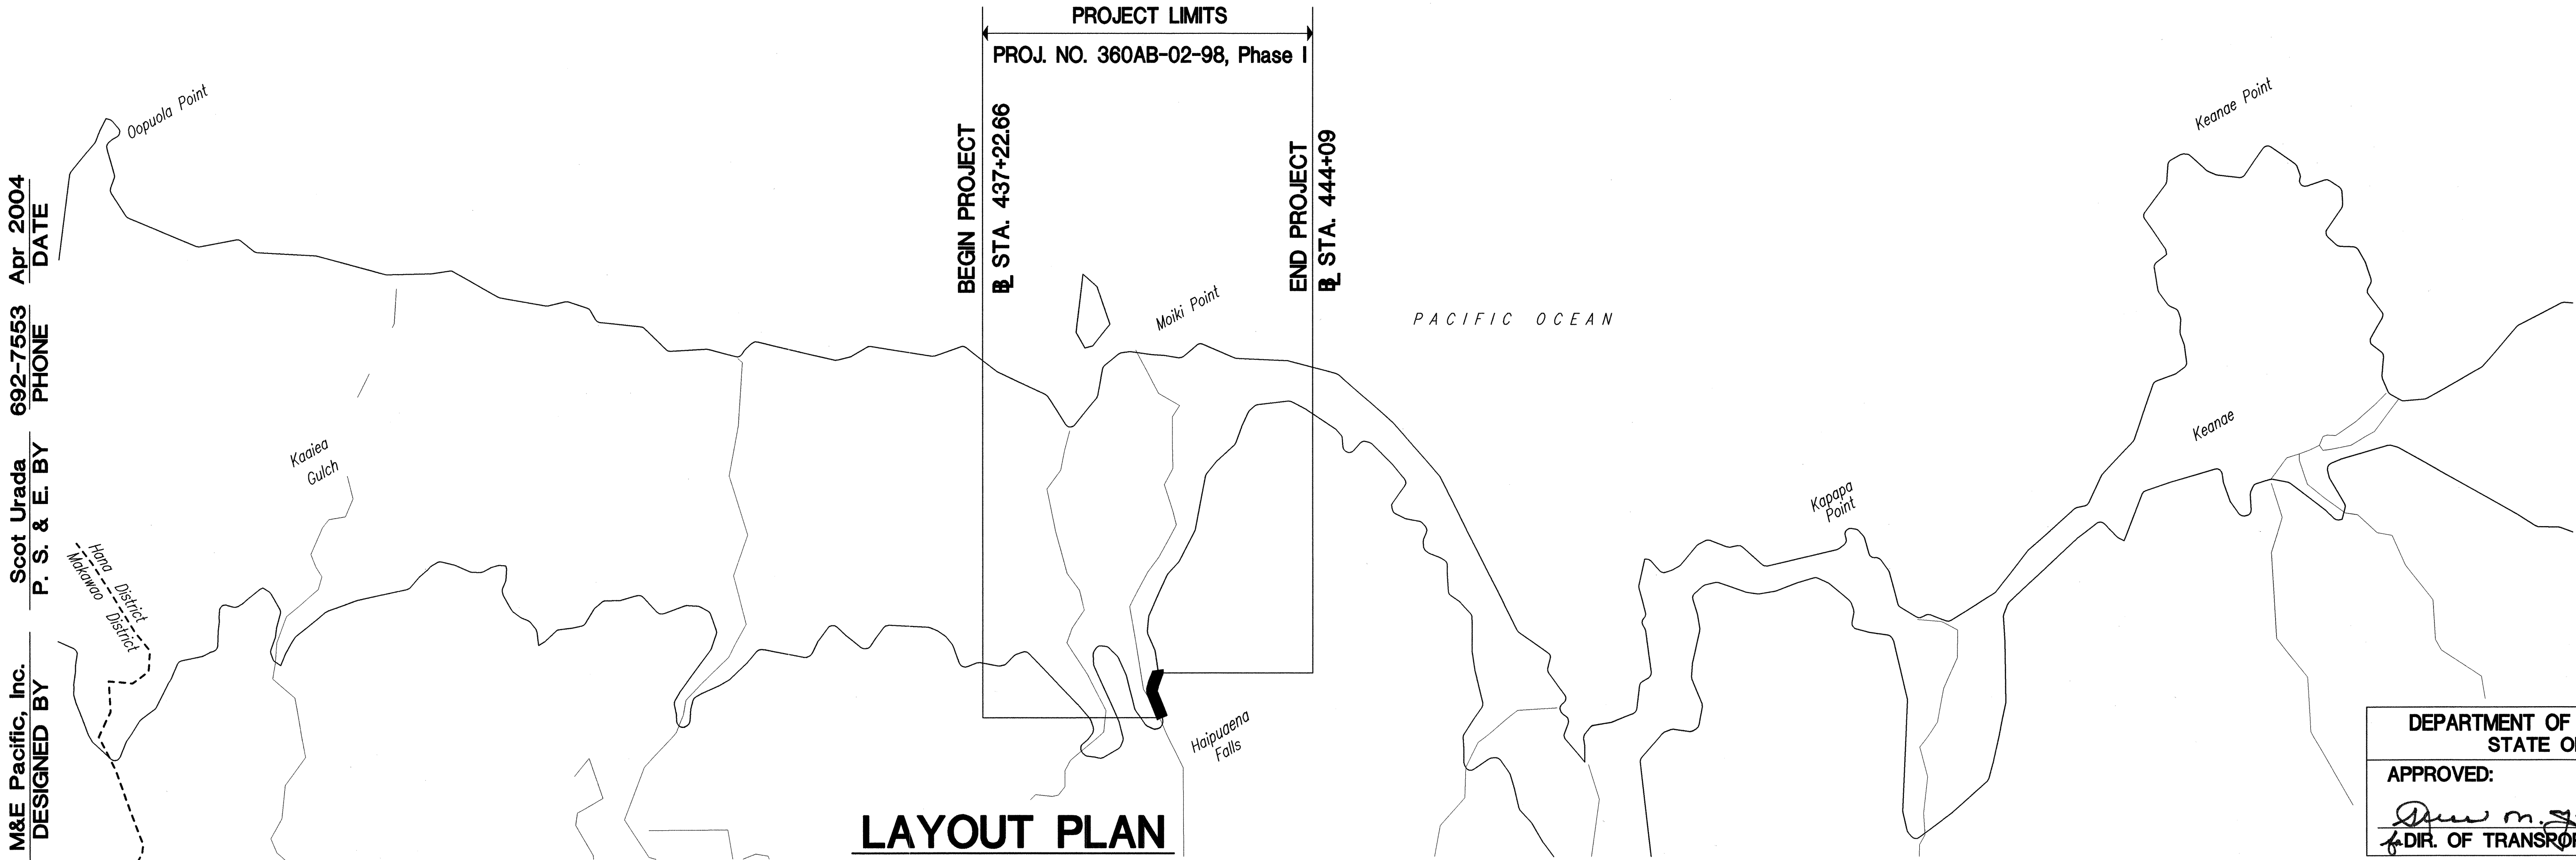

M&E Pacific, Inc. DESIGNED BY
Scot Urada P. S. & E. BY
692-7553 PHONE
Apr 2004 DATE

DEPARTMENT OF TRANSPORTATION
STATE OF HAWAII
APPROVED:
Dir. of Transportation 4-22-04
4 DIR. OF TRANSPORTATION DATE