

STATE OF HAWAII

DEPARTMENT OF TRANSPORTATION

HIGHWAYS DIVISION HONOLULU, HAWAII


"AS-BUNET"

PLANS FOR

HANA HIGHWAY RESURFACING

VICINITY OF WAIKAMOI BRIDGE TO HONOMANU BRIDGE PROJECT NO. 360A-02-05M

DISTRICT OF HANA
ISLAND OF MAUI

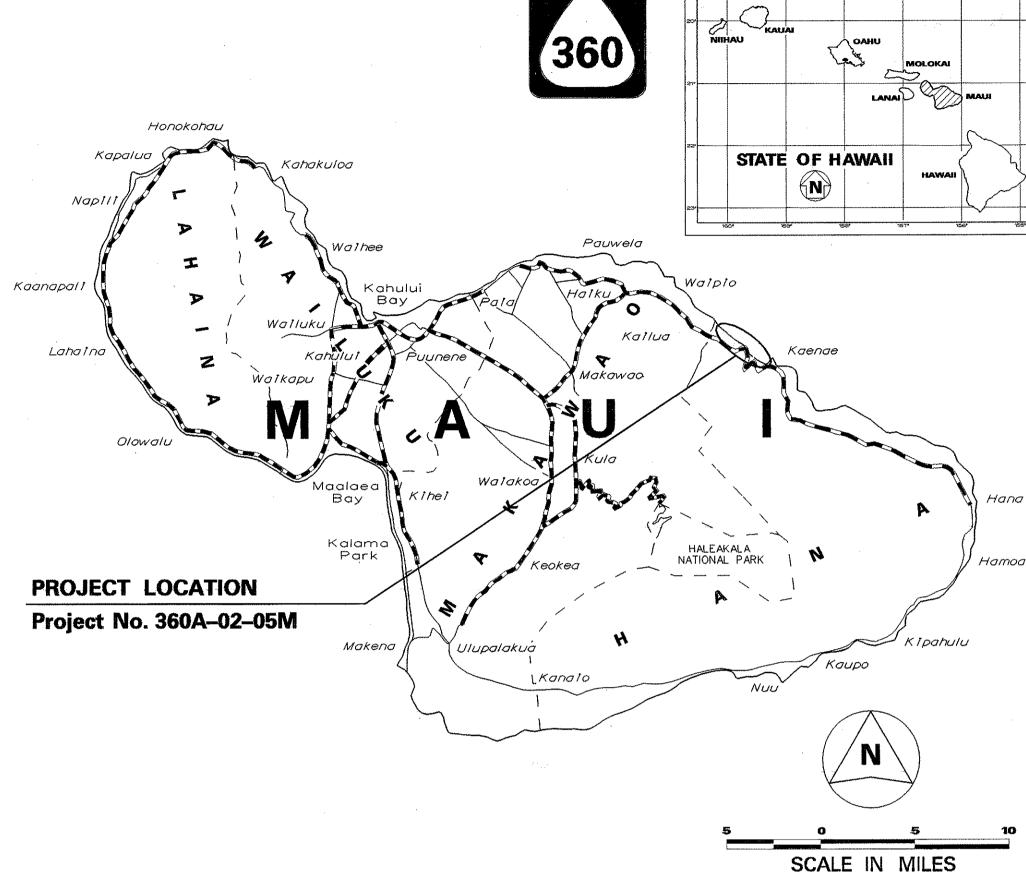

FEDERAL AID PROJECTS PREVIOUSLY CONSTRUCTED OR UNDER CONSTRUCTION

FISCAL SHEET YEAR NO.

PROJ. NO.

360A-02-05M 2005

MILE POST 9.40 TO MILE POST 13.96



CHANGES MADE DURING CONSTRUCTION HAVE BEEN INCORPORATED ON THESE PLANS EXCEPT CHANGES IN THE ORIGINAL THEORETICAL QUANTITIES. FOR ACTUAL QUANTITIES, REFER TO PROJECT LEDGER AND/OR COMPUTATION BOOK.

RESIDENT ENGINEER

10/30/07
DATE

DEPARTMENT OF TRANSPORTATION STATE OF HAWAII APPROVED:

John M. Jemi 4.28.05 Judir. OF TRANSPORTATION DATE

