



FED. ROAD DIST. NO.	STATE	PROJ. NO.	FISCAL YEAR	SHEET NO.	TOTAL SHEETS
HAWAII	HAW.	360AB-02-98	2008	7	16

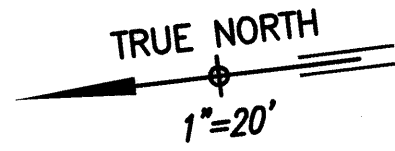

Note:
Contractor must adhere to time restrictions set forth in the Environmental Assessment.

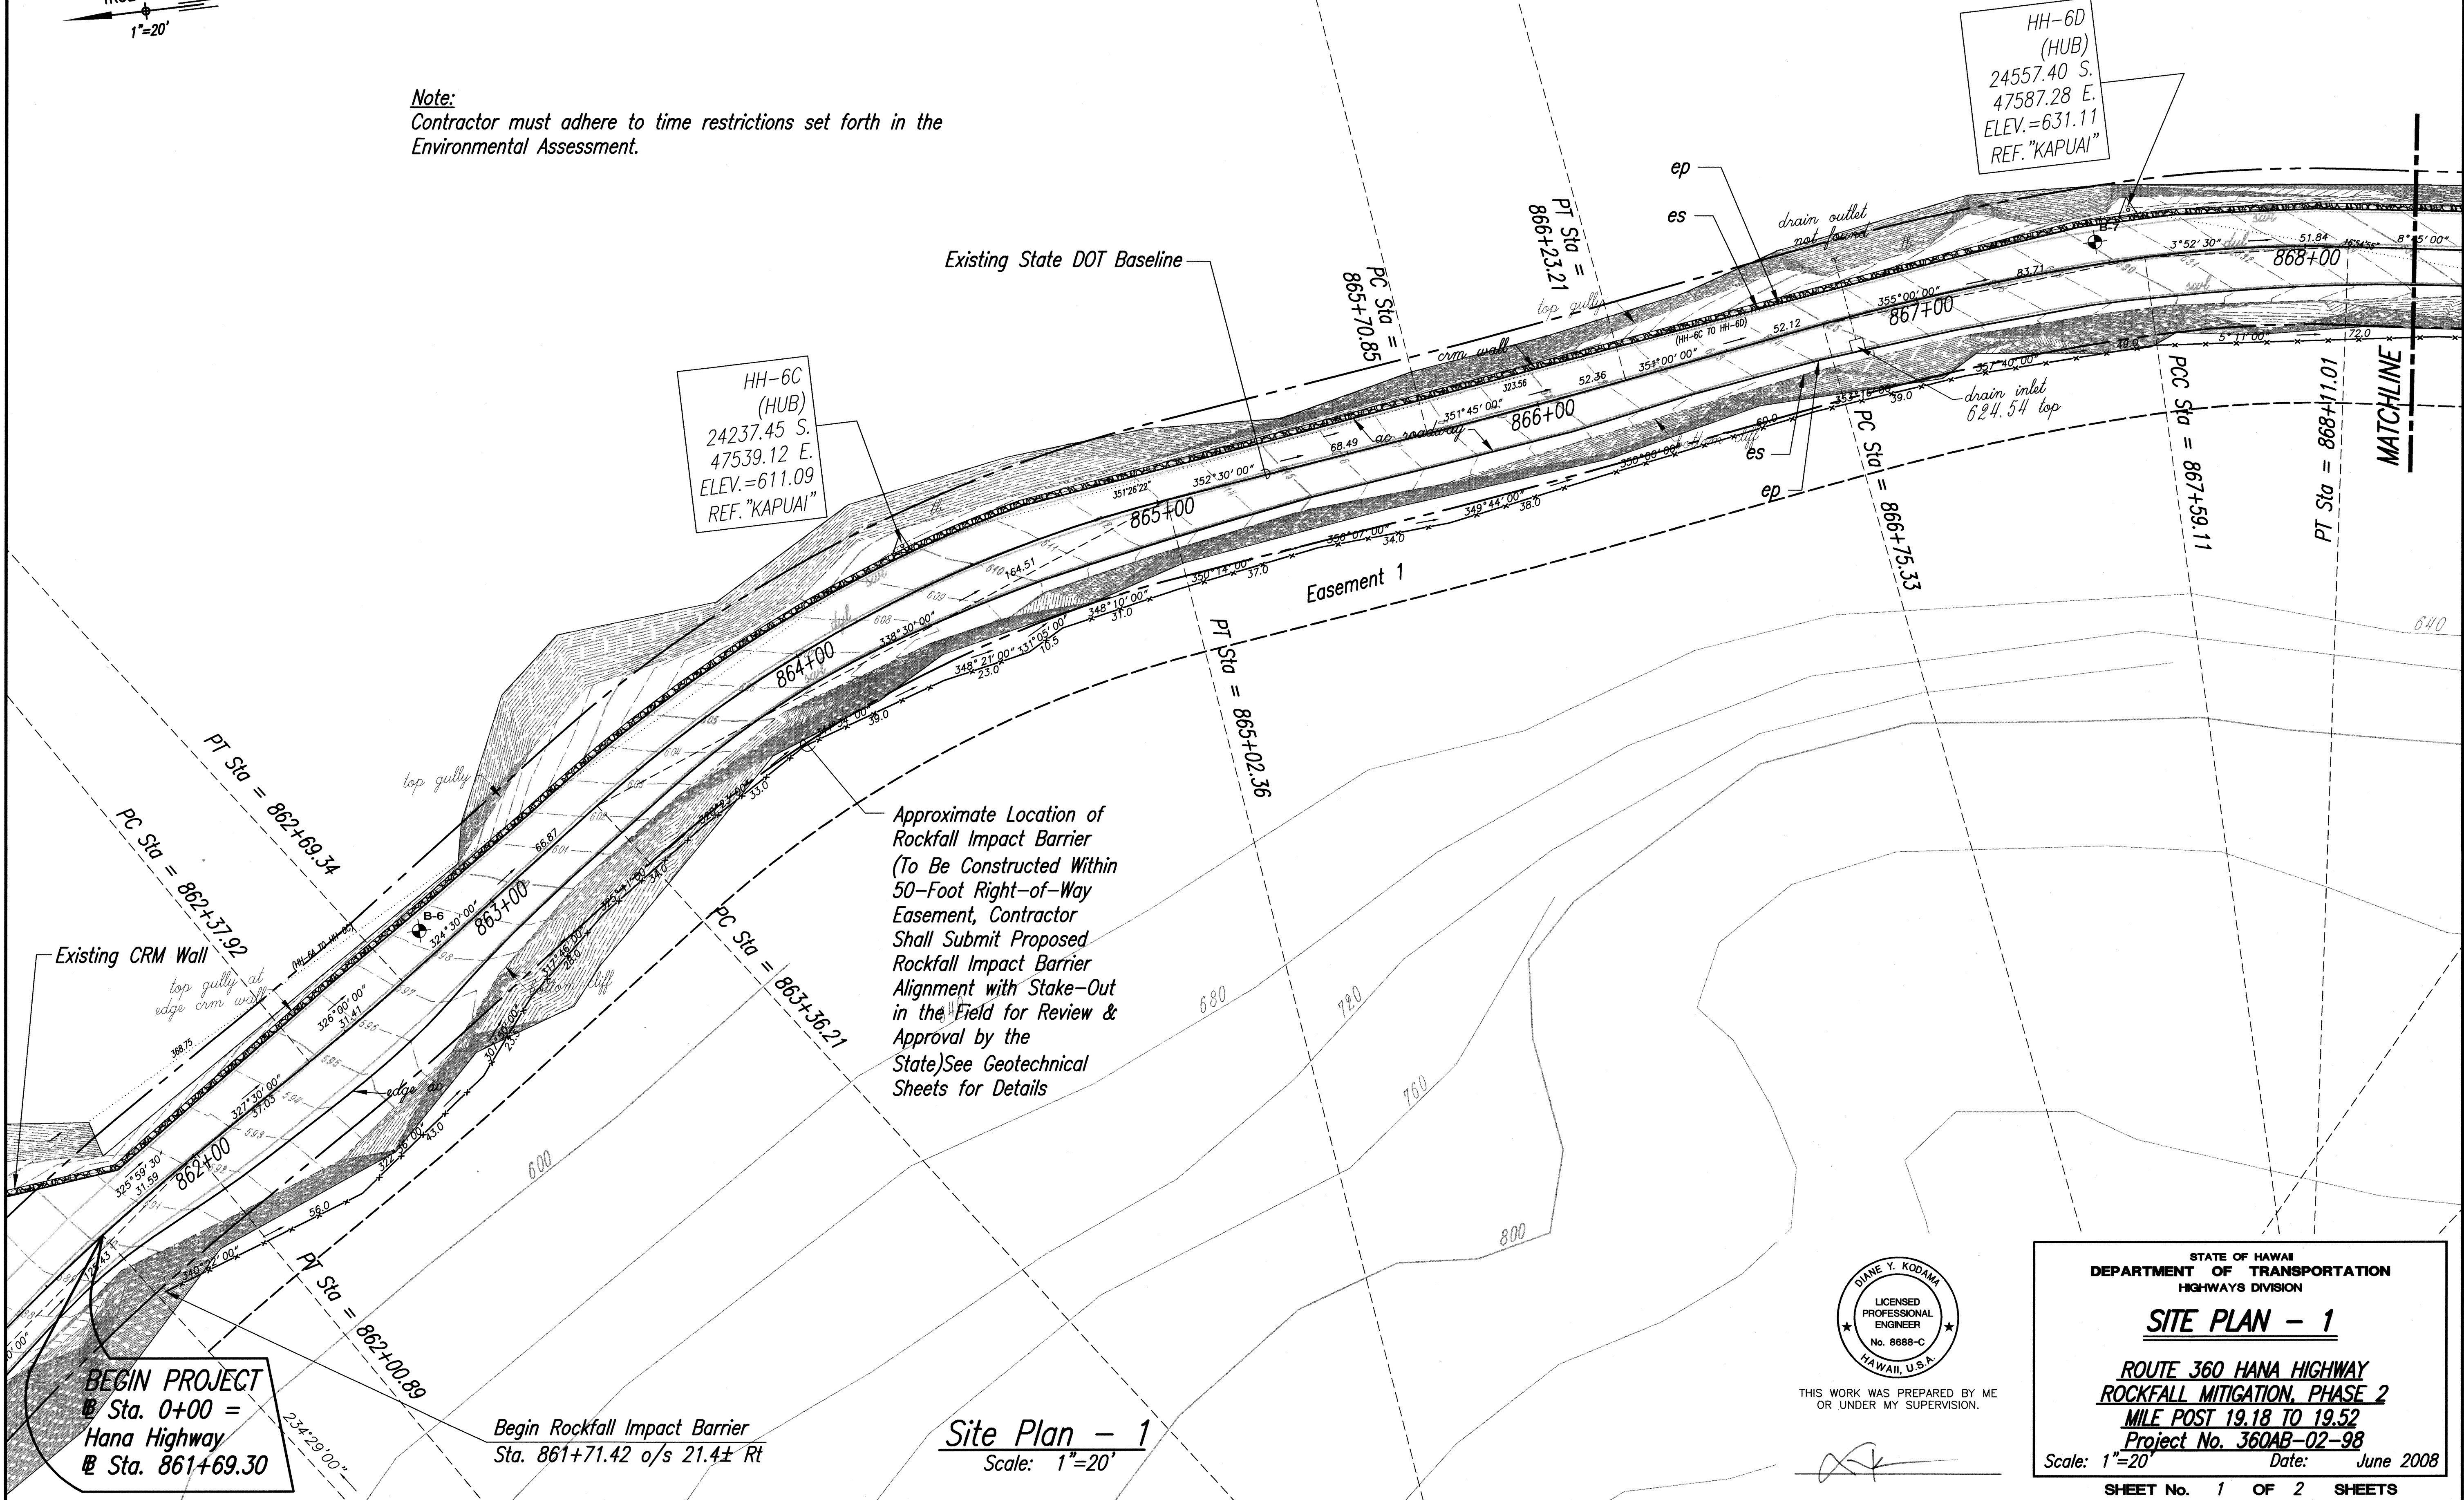


ORIGINAL PLAN	SURVEY PLOTTED BY	DATE
NOTE BOOK	DRAWN BY	
	TRACED BY	
	CHECKED BY	
	QUANTITIES BY	
	CHECKED BY	

BEGIN PROJECT
Sta. 0+00 =
Hana Highway
Sta. 861+69.30

Begin Rockfall Impact Barrier
Sta. 861+71.42 o/s 21.4± Rt

Site Plan - 1
Scale: 1"=20'

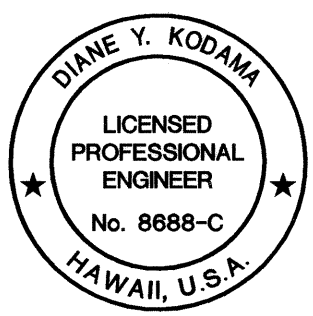

THIS WORK WAS PREPARED BY ME
OR UNDER MY SUPERVISION.

STATE OF HAWAII
DEPARTMENT OF TRANSPORTATION
HIGHWAYS DIVISION

SITE PLAN - 1

**ROUTE 360 HANA HIGHWAY
ROCKFALL MITIGATION, PHASE 2
MILE POST 19.18 TO 19.52
Project No. 360AB-02-98**

Scale: 1"=20' Date: June 2008

SHEET NO. 1 OF 2 SHEETS

FED. ROAD DIST. NO.	STATE	PROJ. NO.	FISCAL YEAR	SHEET NO.	TOTAL SHEETS
HAWAII	HAW.	360AB-02-98	2008	8	16

