
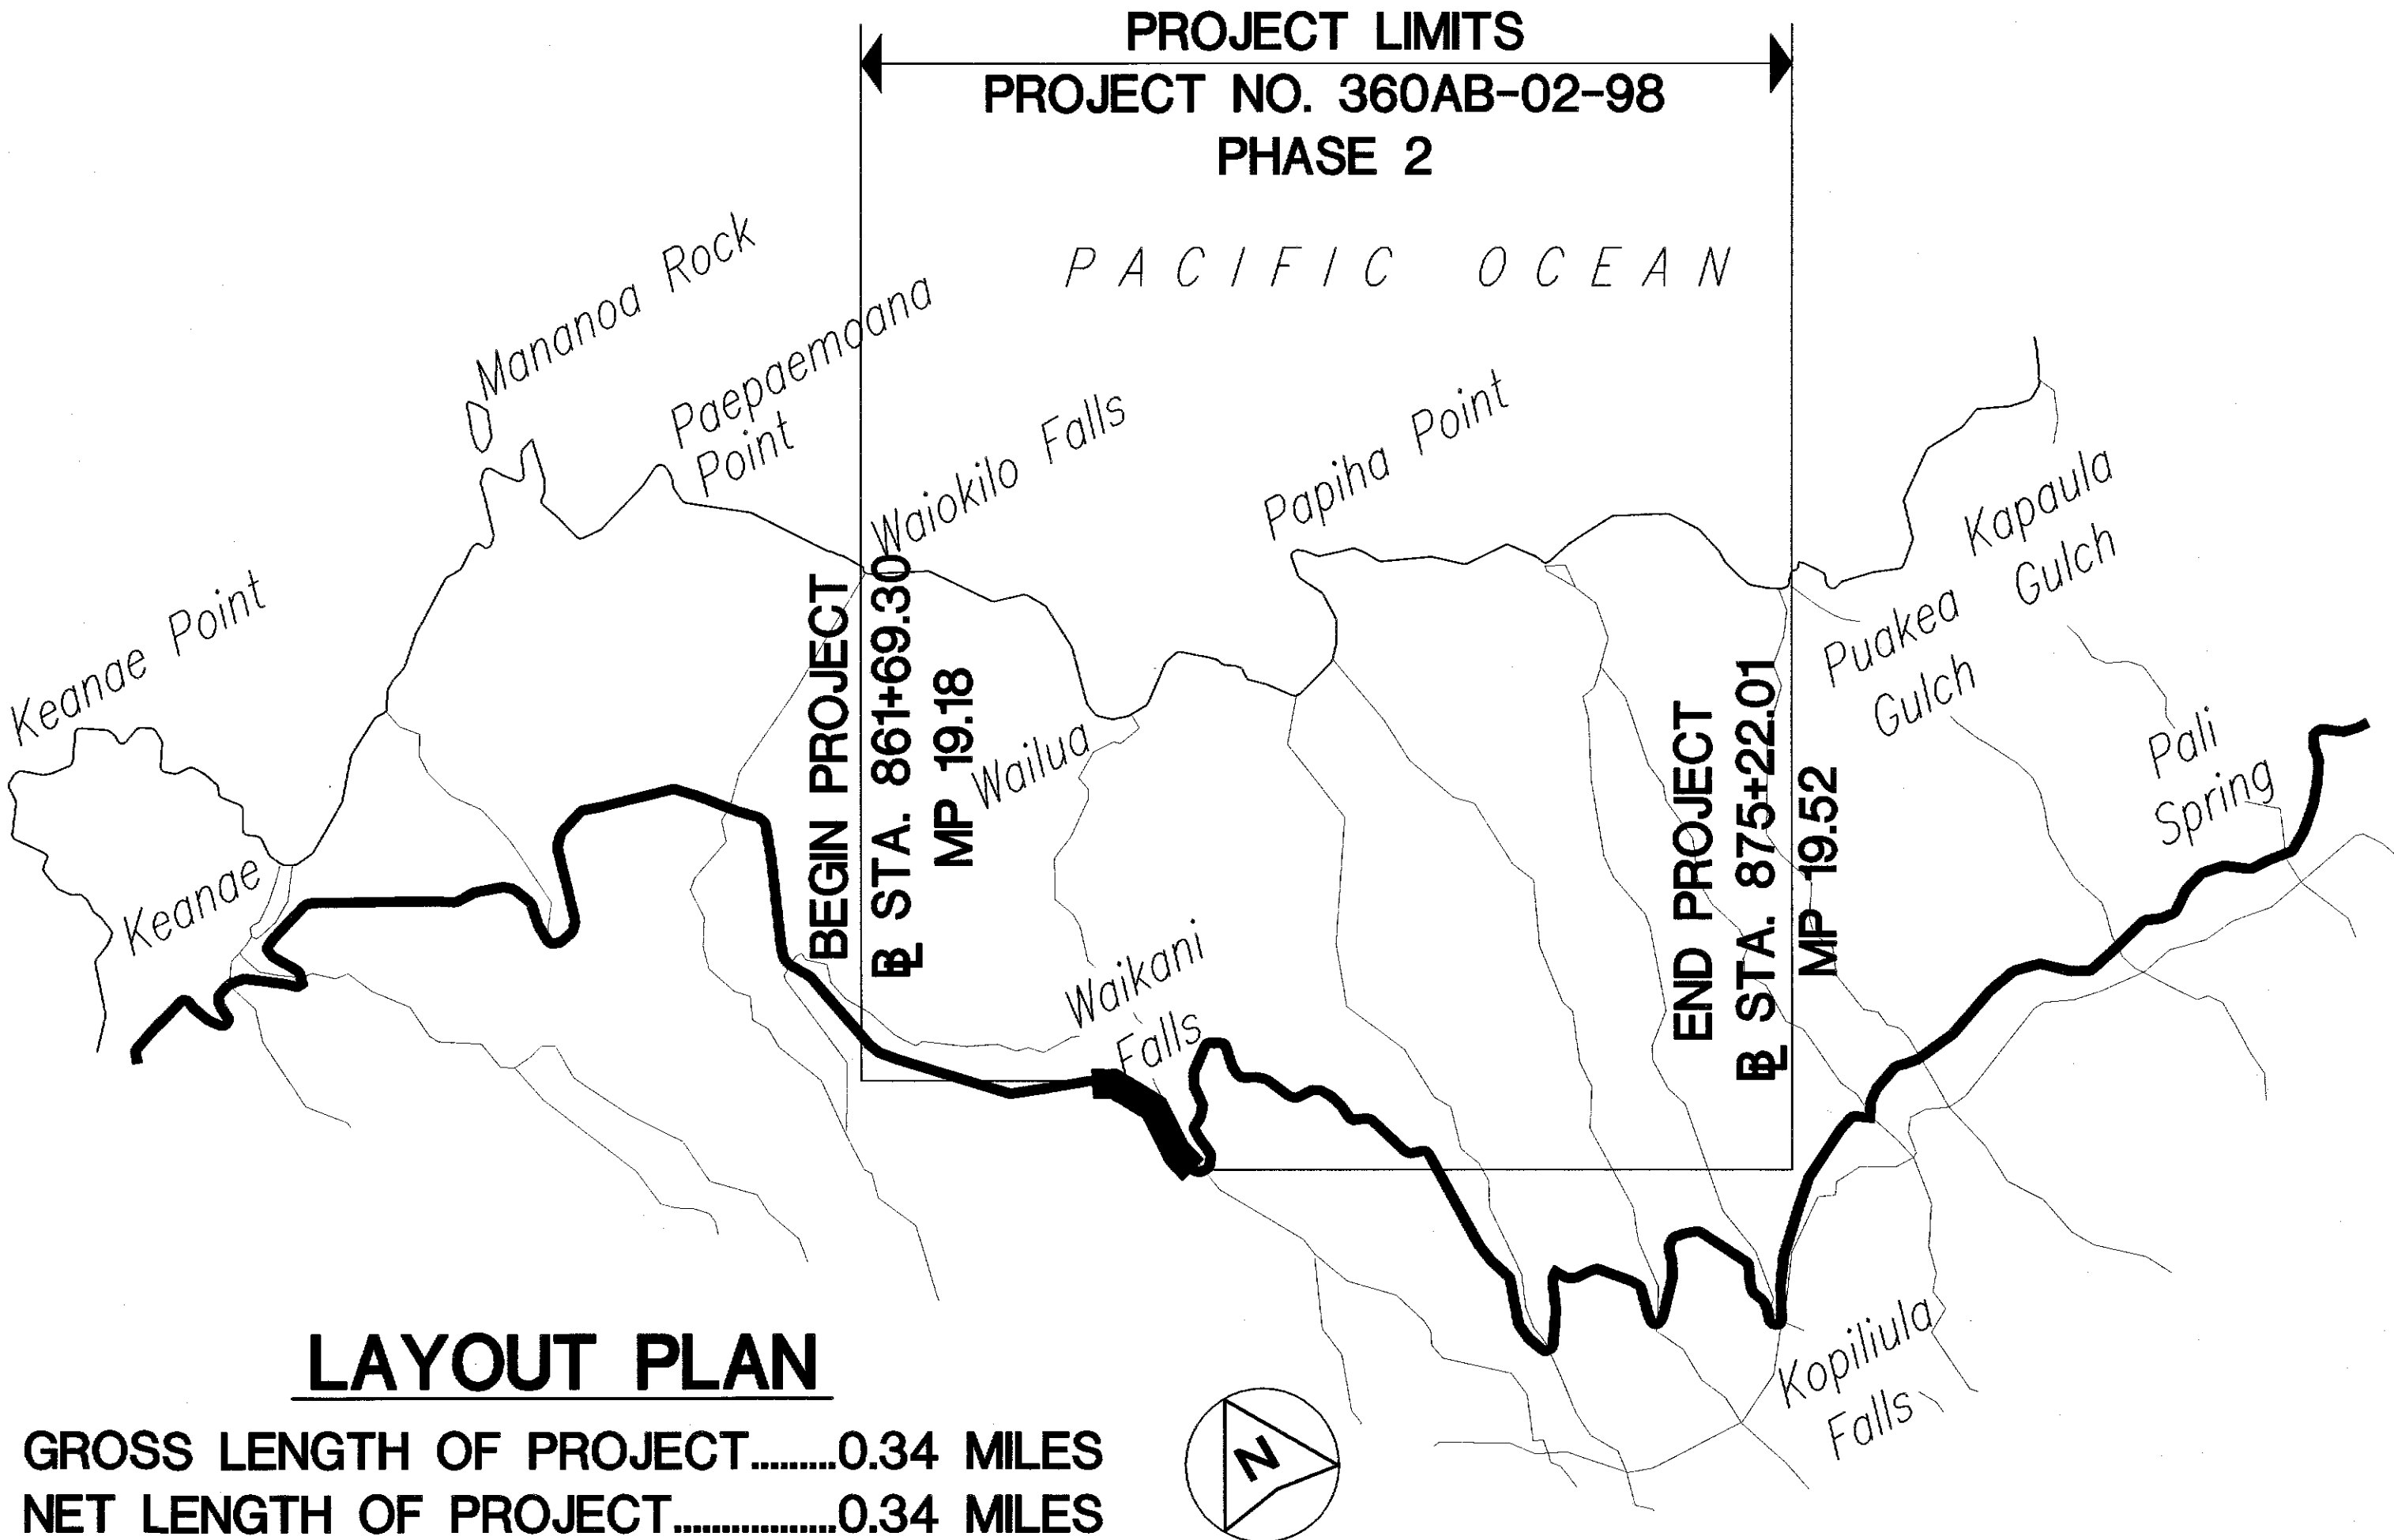
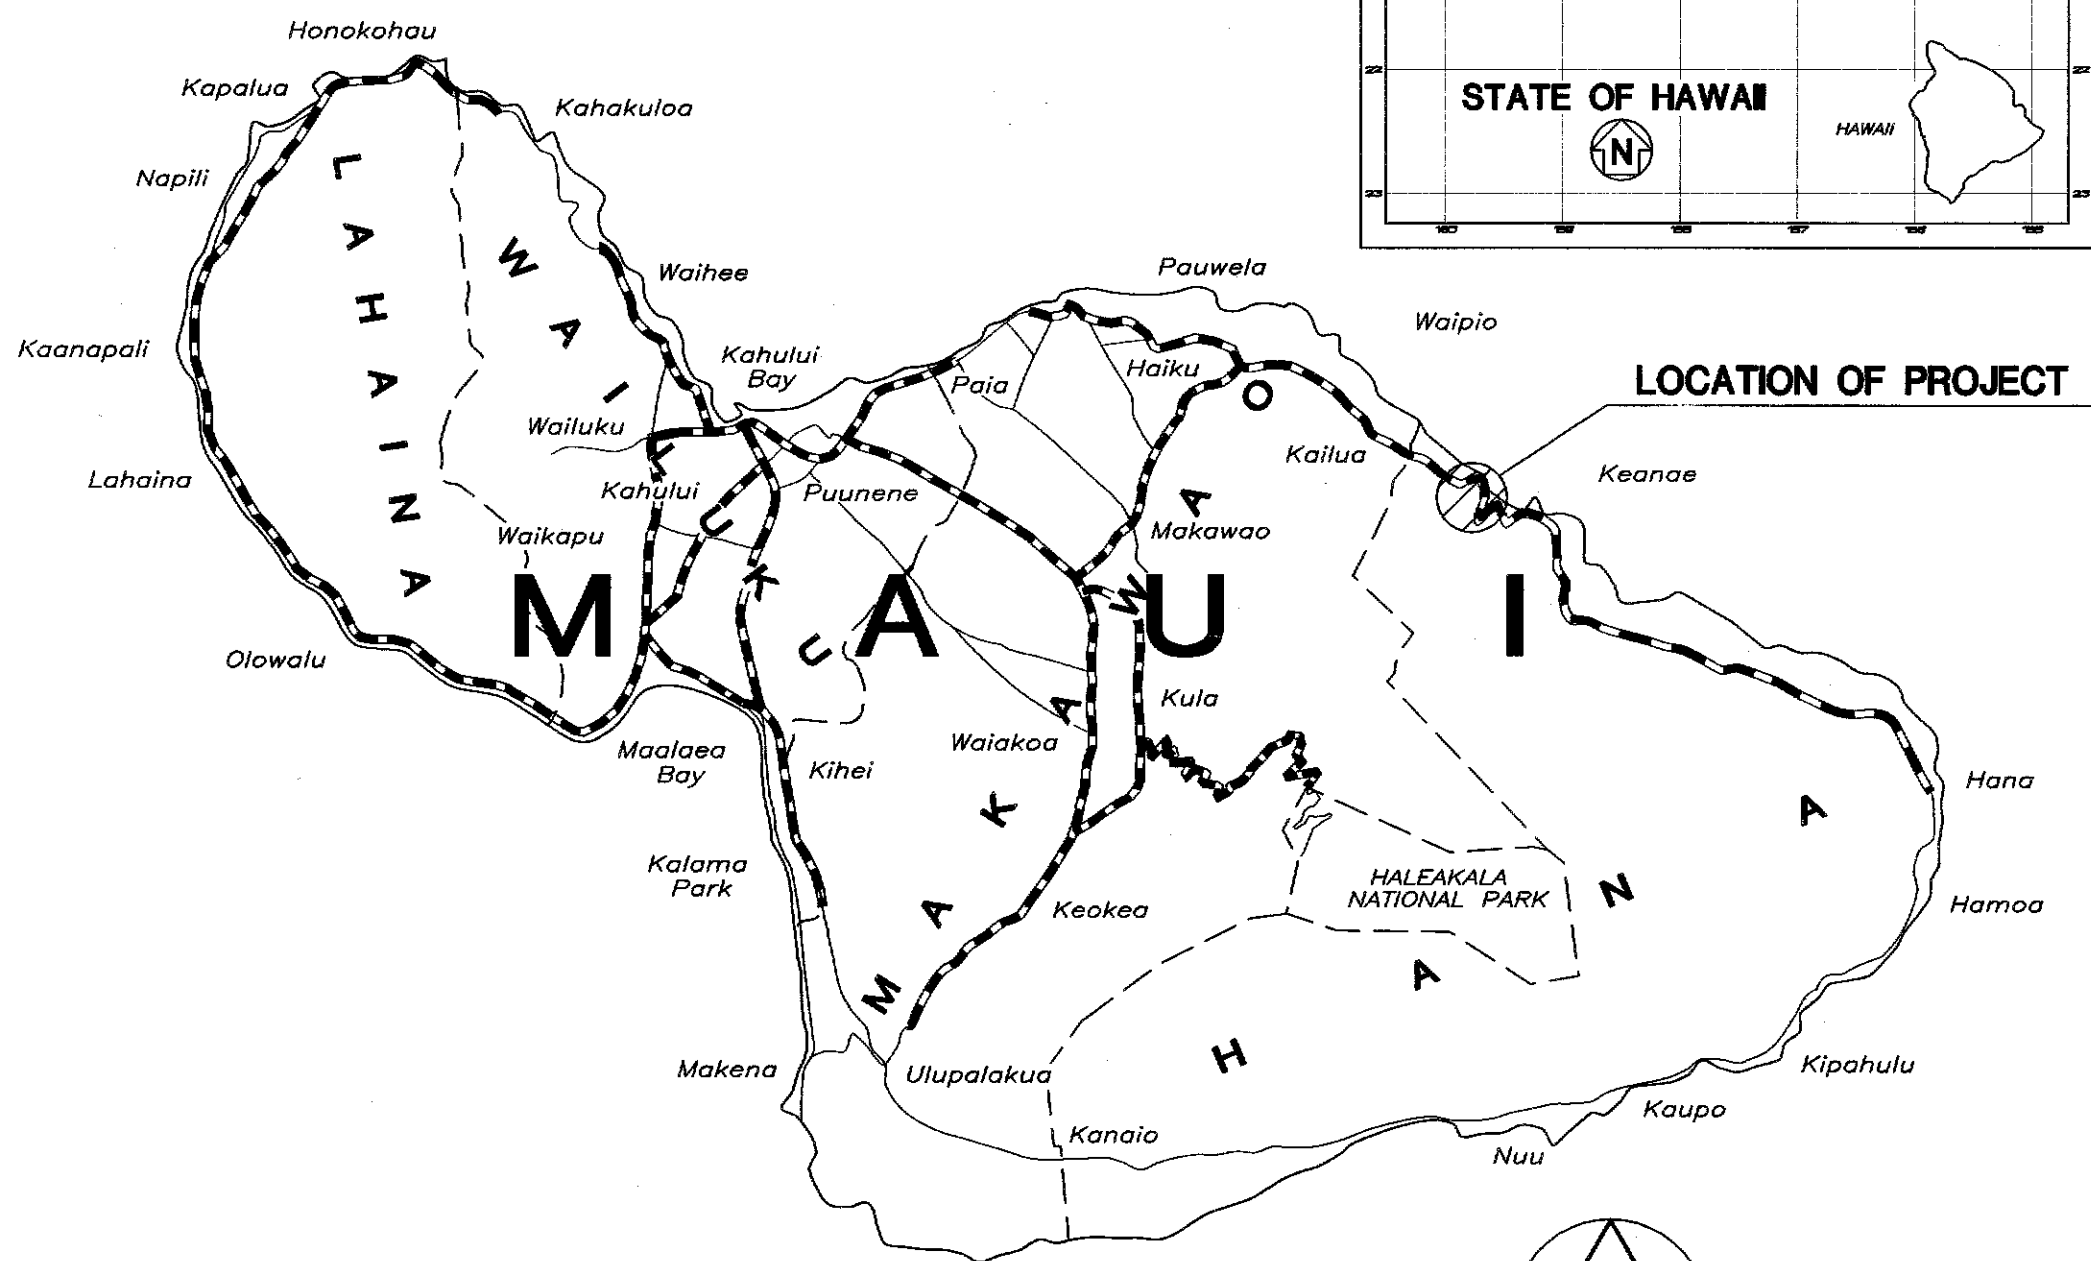


INDEX TO DRAWINGS	
SHEET NO.	DESCRIPTION
1	TITLE SHEET
2	STANDARD PLANS SUMMARY
3	GENERAL NOTES AND LEGEND
4	WATER POLLUTION & EROSION CONTROL NOTES
5	GENERAL PLAN
6	BASELINE GEOMETRIC PLAN
7 - 8	SITE PLANS
9	TRAFFIC CONTROL PLAN
10 - 16	GEOTECHNICAL PLANS

STATE OF HAWAII
DEPARTMENT OF TRANSPORTATION
HIGHWAYS DIVISION
HONOLULU, HAWAII
"AS-BUILT" PLANS FOR
ROUTE 360
HANA HIGHWAY
ROCKFALL MITIGATION PHASE 2
HUELO TO HANA
M.P. 19.18 TO M.P. 19.52
PROJECT NO. 360AB-02-98, Phase 2
DISTRICT OF HANA
ISLAND OF MAUI

FED. ROAD DIST. NO.	STATE	PROJ. NO.	FISCAL YEAR	SHEET NO.	TOTAL SHEETS
HAWAII	HAW.	360AB-02-98	2008	1	16

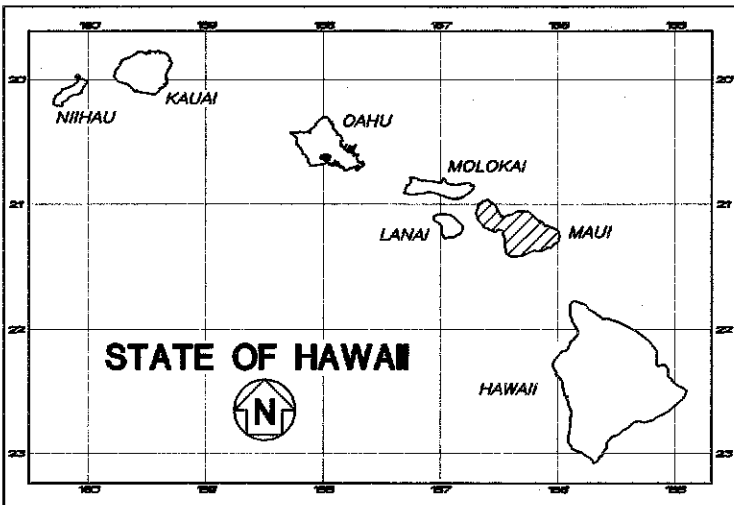

CHANGES MADE DURING CONSTRUCTION HAVE BEEN INCORPORATED ON THESE PLANS EXCEPT CHANGES IN THE ORIGINAL THEORETICAL QUANTITIES. FOR ACTUAL QUANTITIES, REFER TO PROJECT LEDGER AND/OR COMPUTATION BOOK.

[Signature]
RESIDENT ENGINEER

[Signature]
DATE

DEPARTMENT OF TRANSPORTATION
STATE OF HAWAII
APPROVED:
[Signature]
DIR. OF TRANSPORTATION
5-15-08
DATE

M&E Pacific, Inc. DESIGNED BY
HWY-DS 692-7544 June 2008
MANAGED BY PHONE DATE

LAYOUT PLAN
GROSS LENGTH OF PROJECT.....0.34 MILES
NET LENGTH OF PROJECT.....0.34 MILES