



P:\Drafting\2012-04-13\_2130 hana hwy\2130\_S4-1.dwg, 4/16/2012 11:51:52 AM, tamarah

DATE	_____
SURVEY PLOTTED BY	_____
DRAWN BY	_____
DESIGNED BY	_____
QUANTITIES BY	_____
CHECKED BY	_____
ORIGINAL PLAN	_____
NOTE BOOK	_____
No.	_____

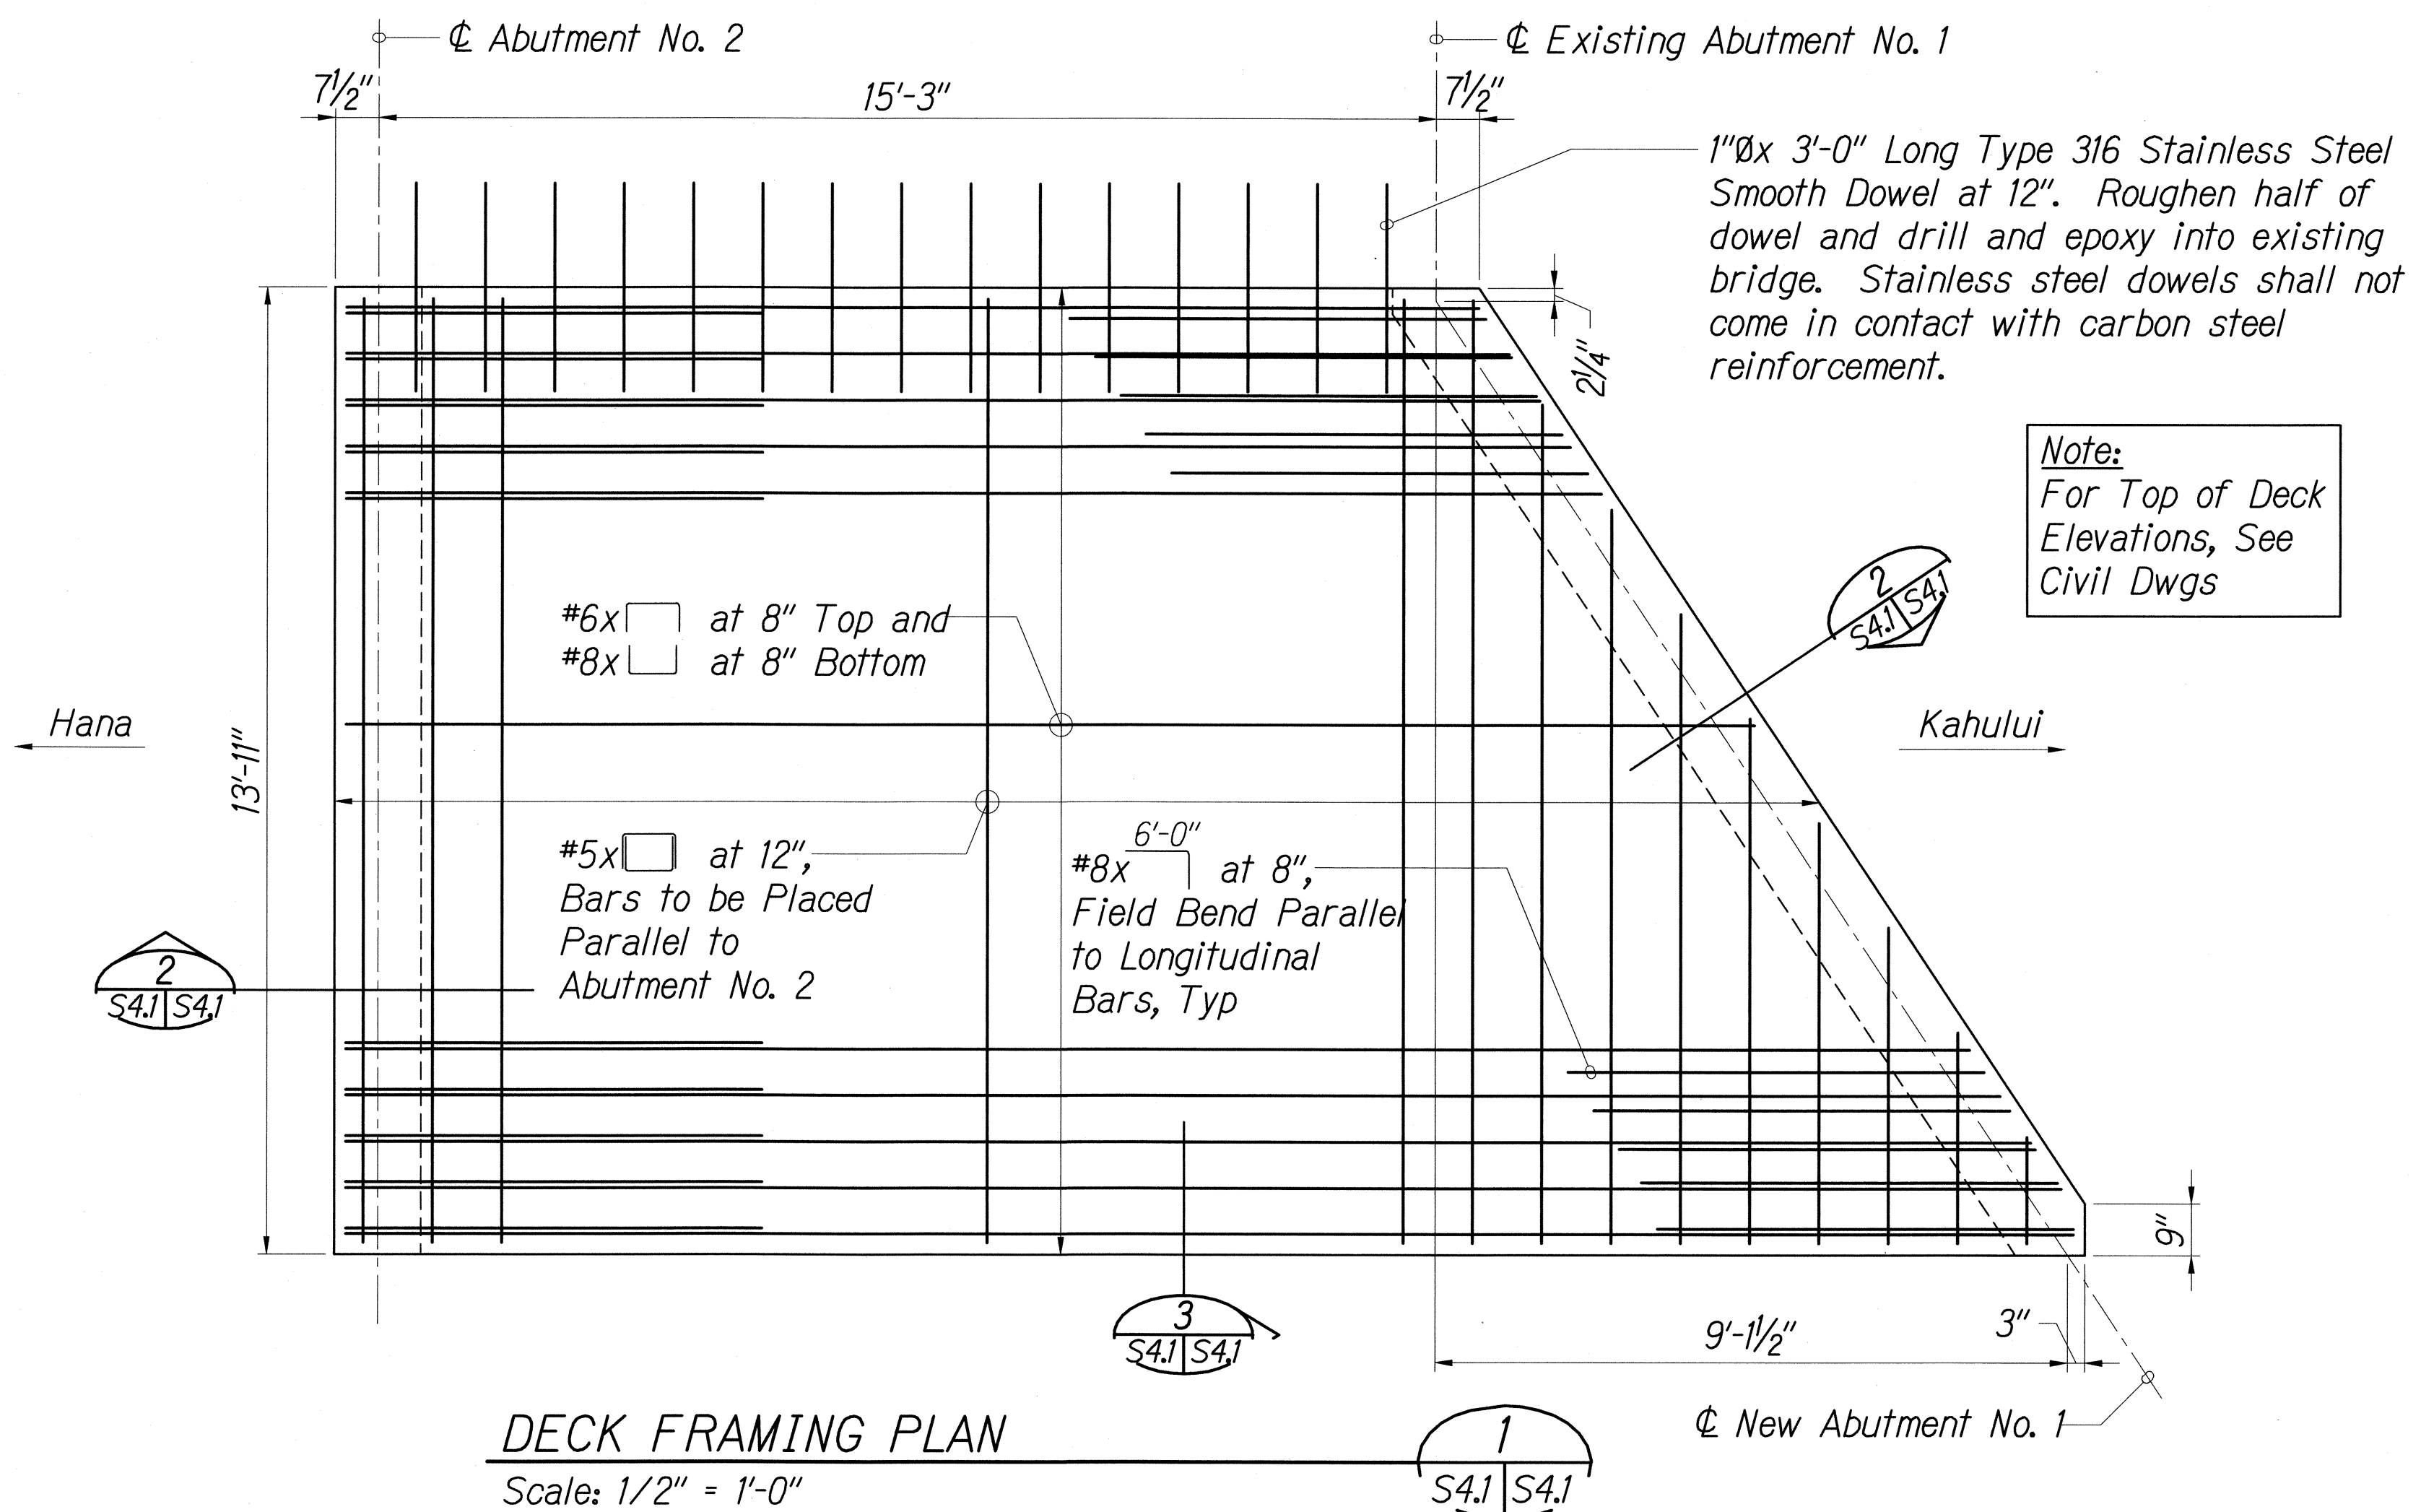


DECK FRAMING PLAN  
Scale: 1/2" = 1'-0"

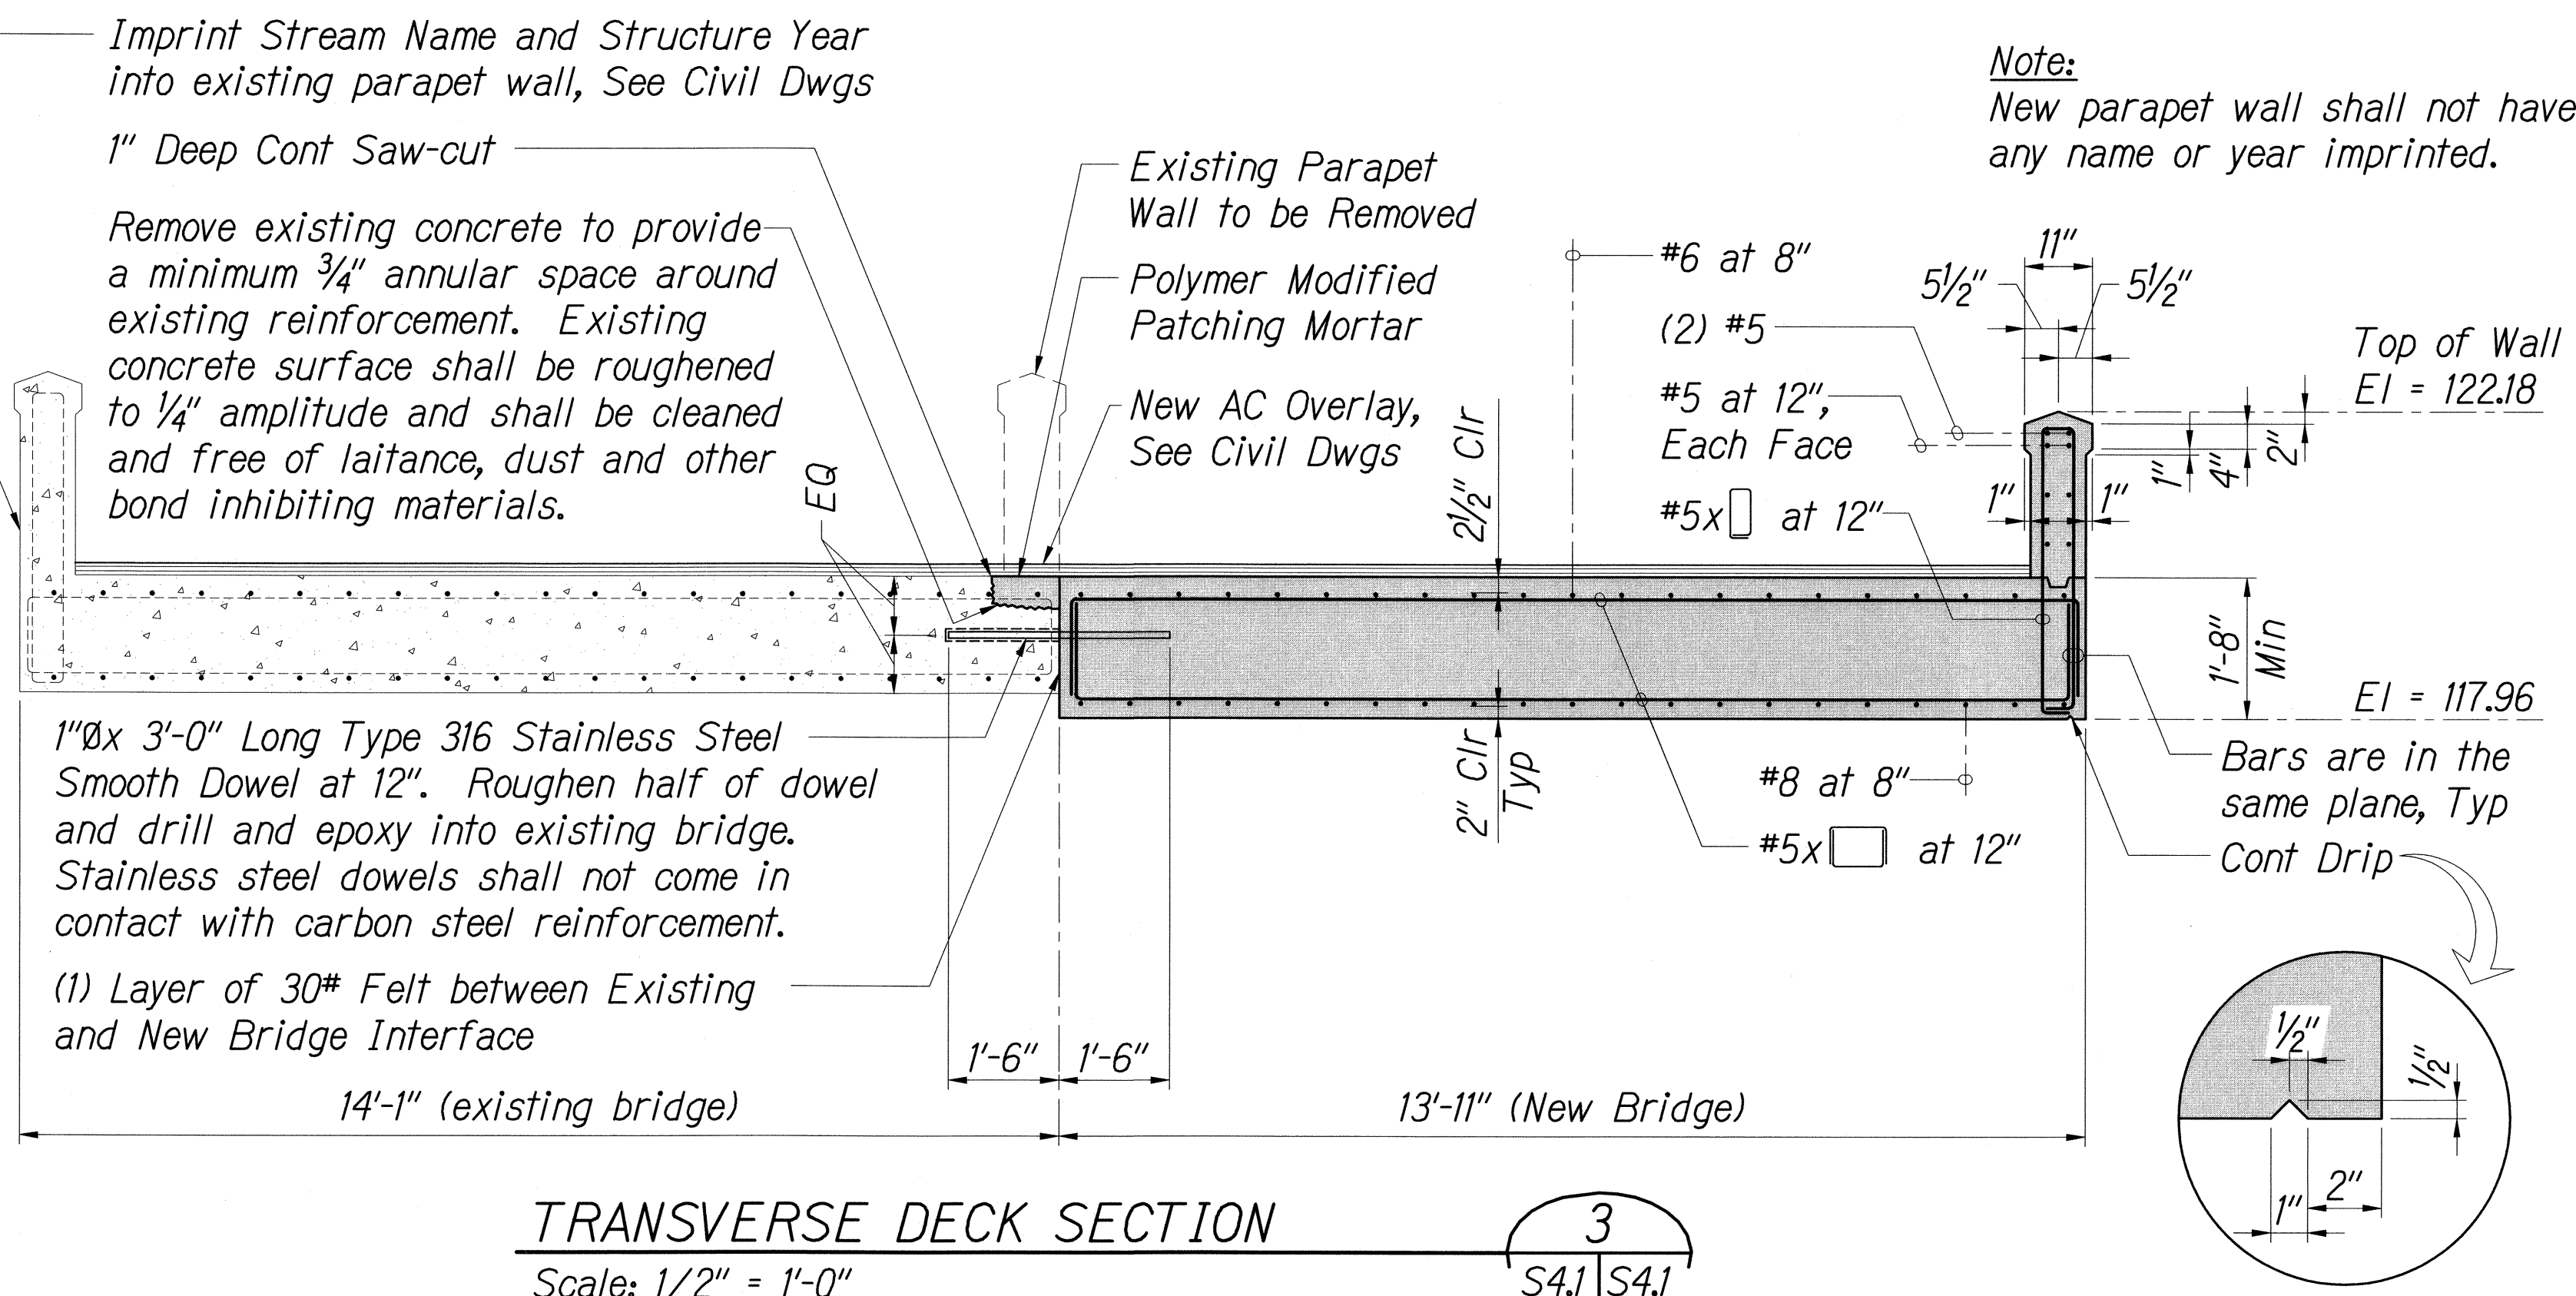


TRANSVERSE DECK SECTION  
Scale: 1/2" = 1'-0"

Legend

- Excavation Pay Limits
- Structural Backfill
- Impervious Backfill

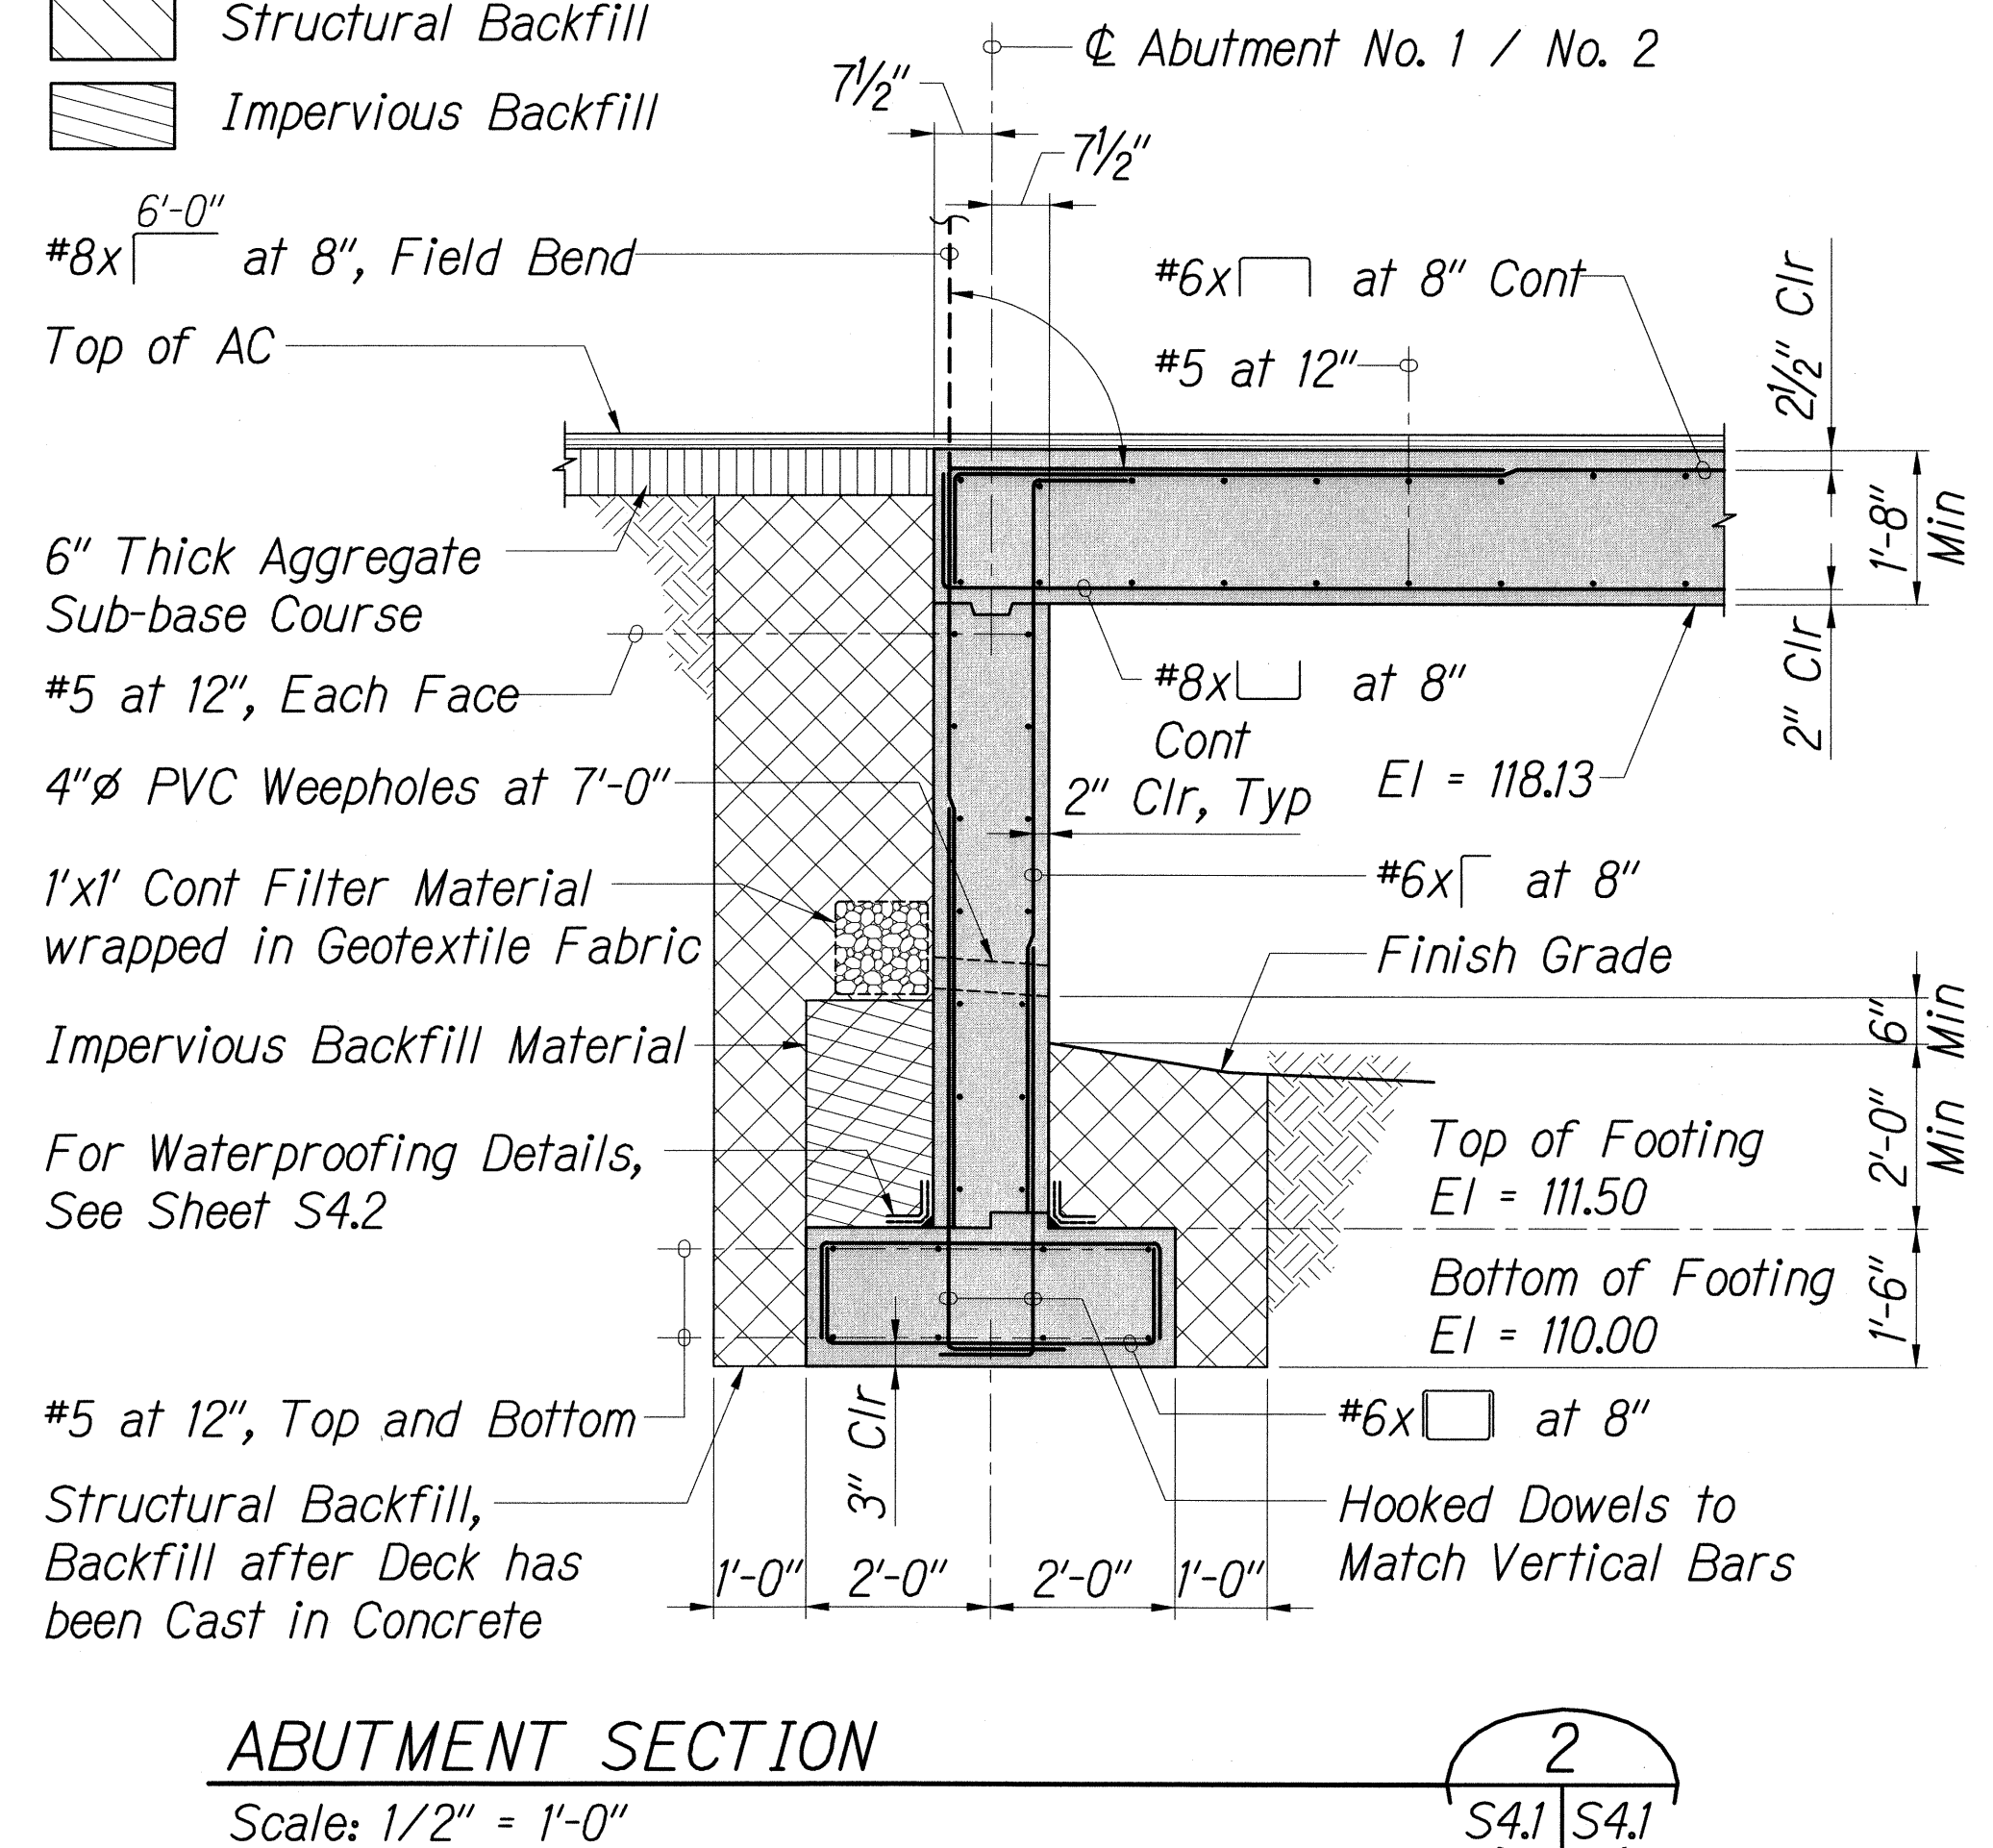

ABUTMENT SECTION  
Scale: 1/2" = 1'-0"

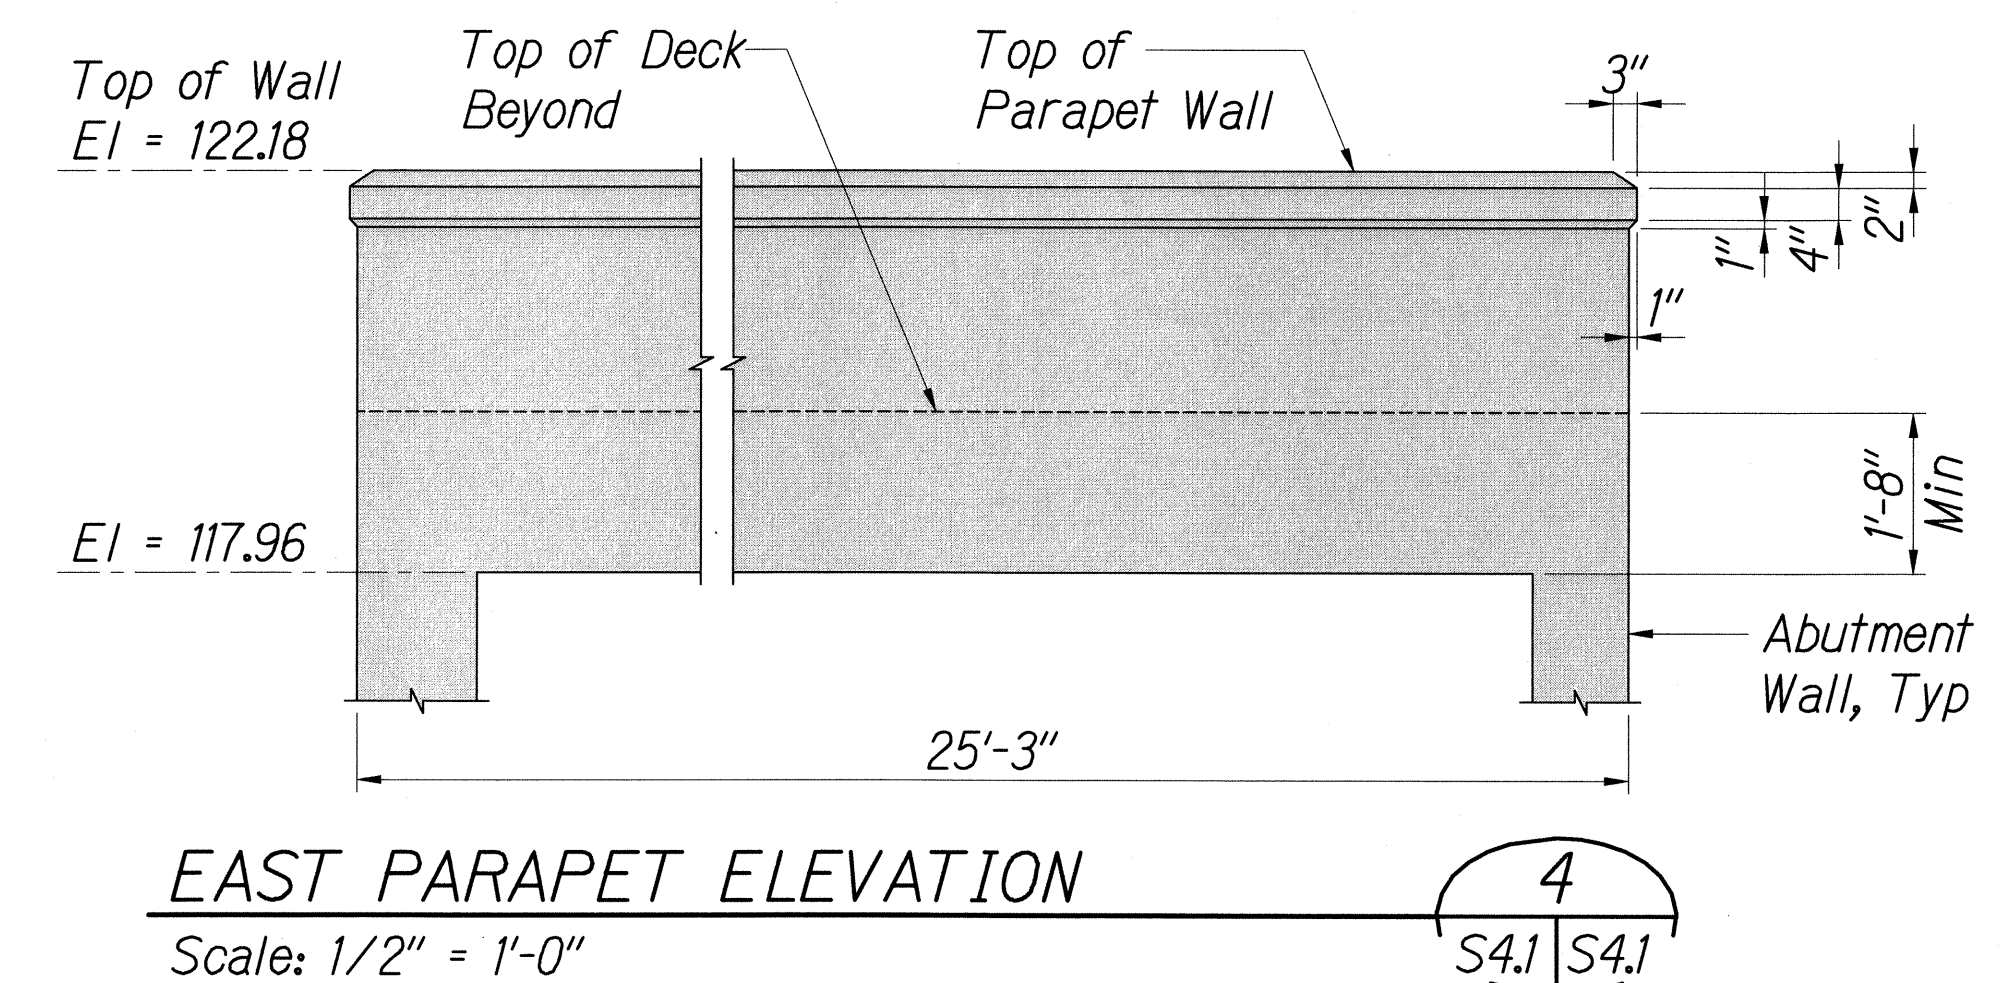

EAST PARAPET ELEVATION  
Scale: 1/2" = 1'-0"



EXPIRATION DATE OF THE LICENSE 4/30/2012  
THIS WORK WAS PREPARED BY  
ME OR UNDER MY SUPERVISION

STATE OF HAWAII  
DEPARTMENT OF TRANSPORTATION  
HIGHWAYS DIVISION

**SECTIONS AND DETAILS**

ROUTE 360 HANA HIGHWAY  
IMPROVEMENTS  
UAKEA ROAD TO KEAWA PLACE  
Project No. 360B-01-03



Scale: As Noted Date: December 2011

SHEET No. S4.1 OF 7 SHEETS




P:\Drafting\2012\04-13\_2130 hana hwy\2130\_S4-1.dwg, 4/16/2012 11:51:52 AM, tamarahs

DATE	_____
SURVEY PLOTTED BY	_____
DRAWN BY	_____
TRACED BY	_____
DESIGNED BY	_____
QUANTITIES BY	_____
CHECKED BY	_____
ORIGINAL PLAN	_____
NOTE BOOK	_____
No.	_____

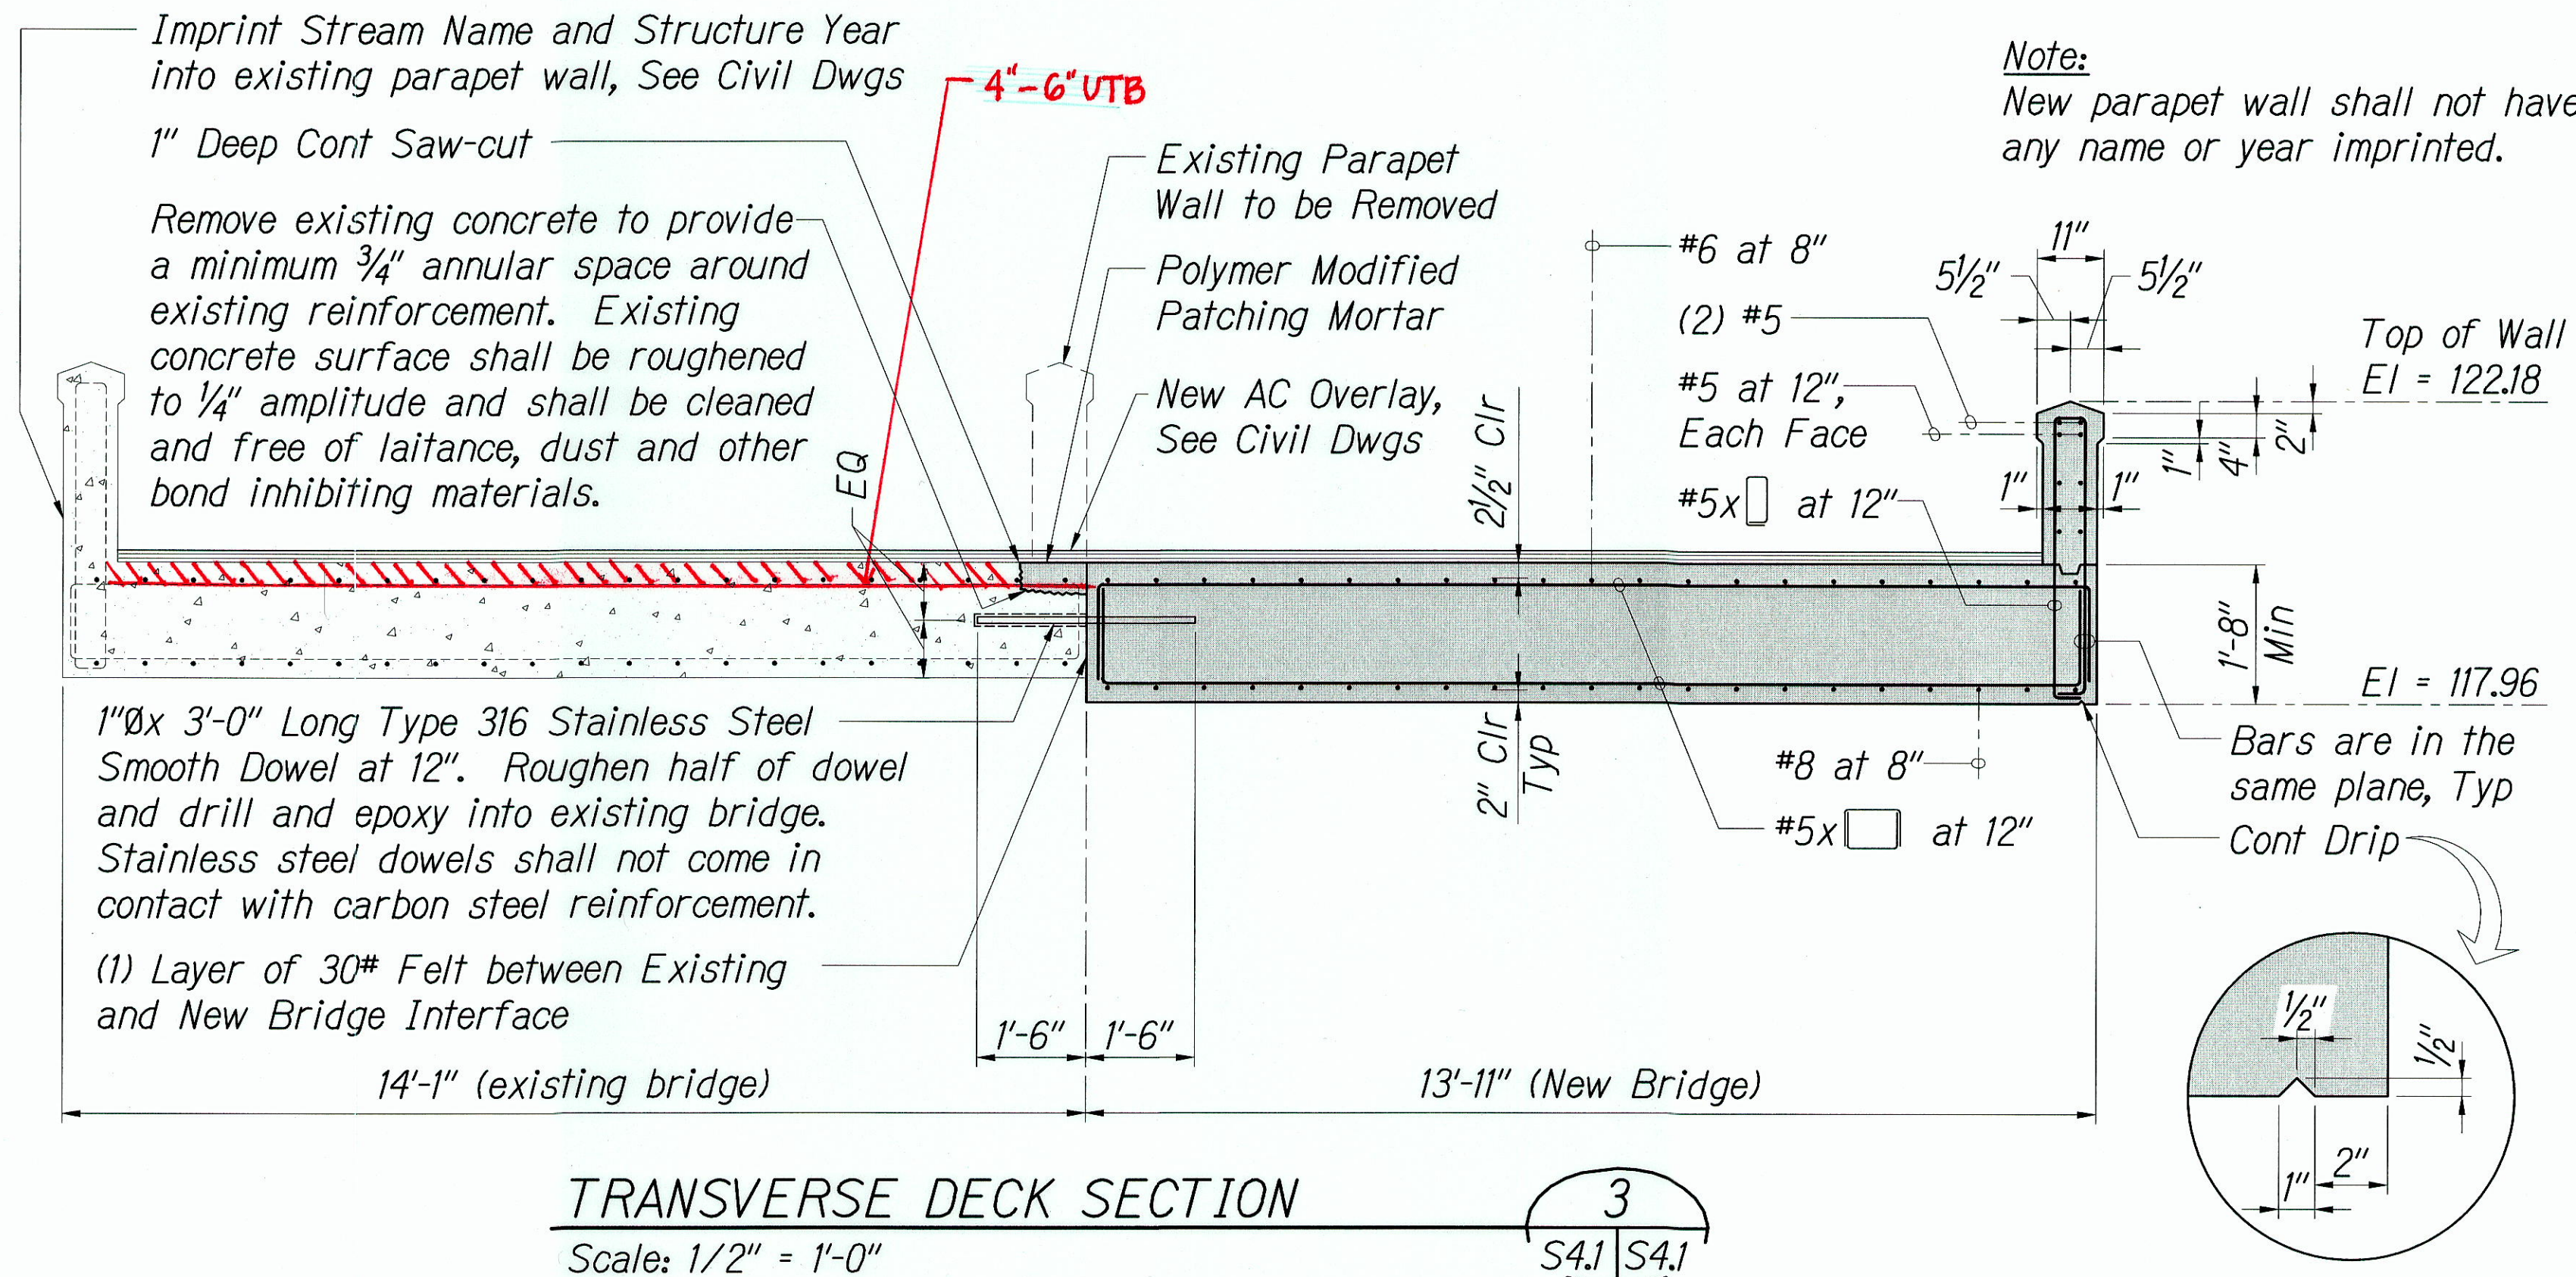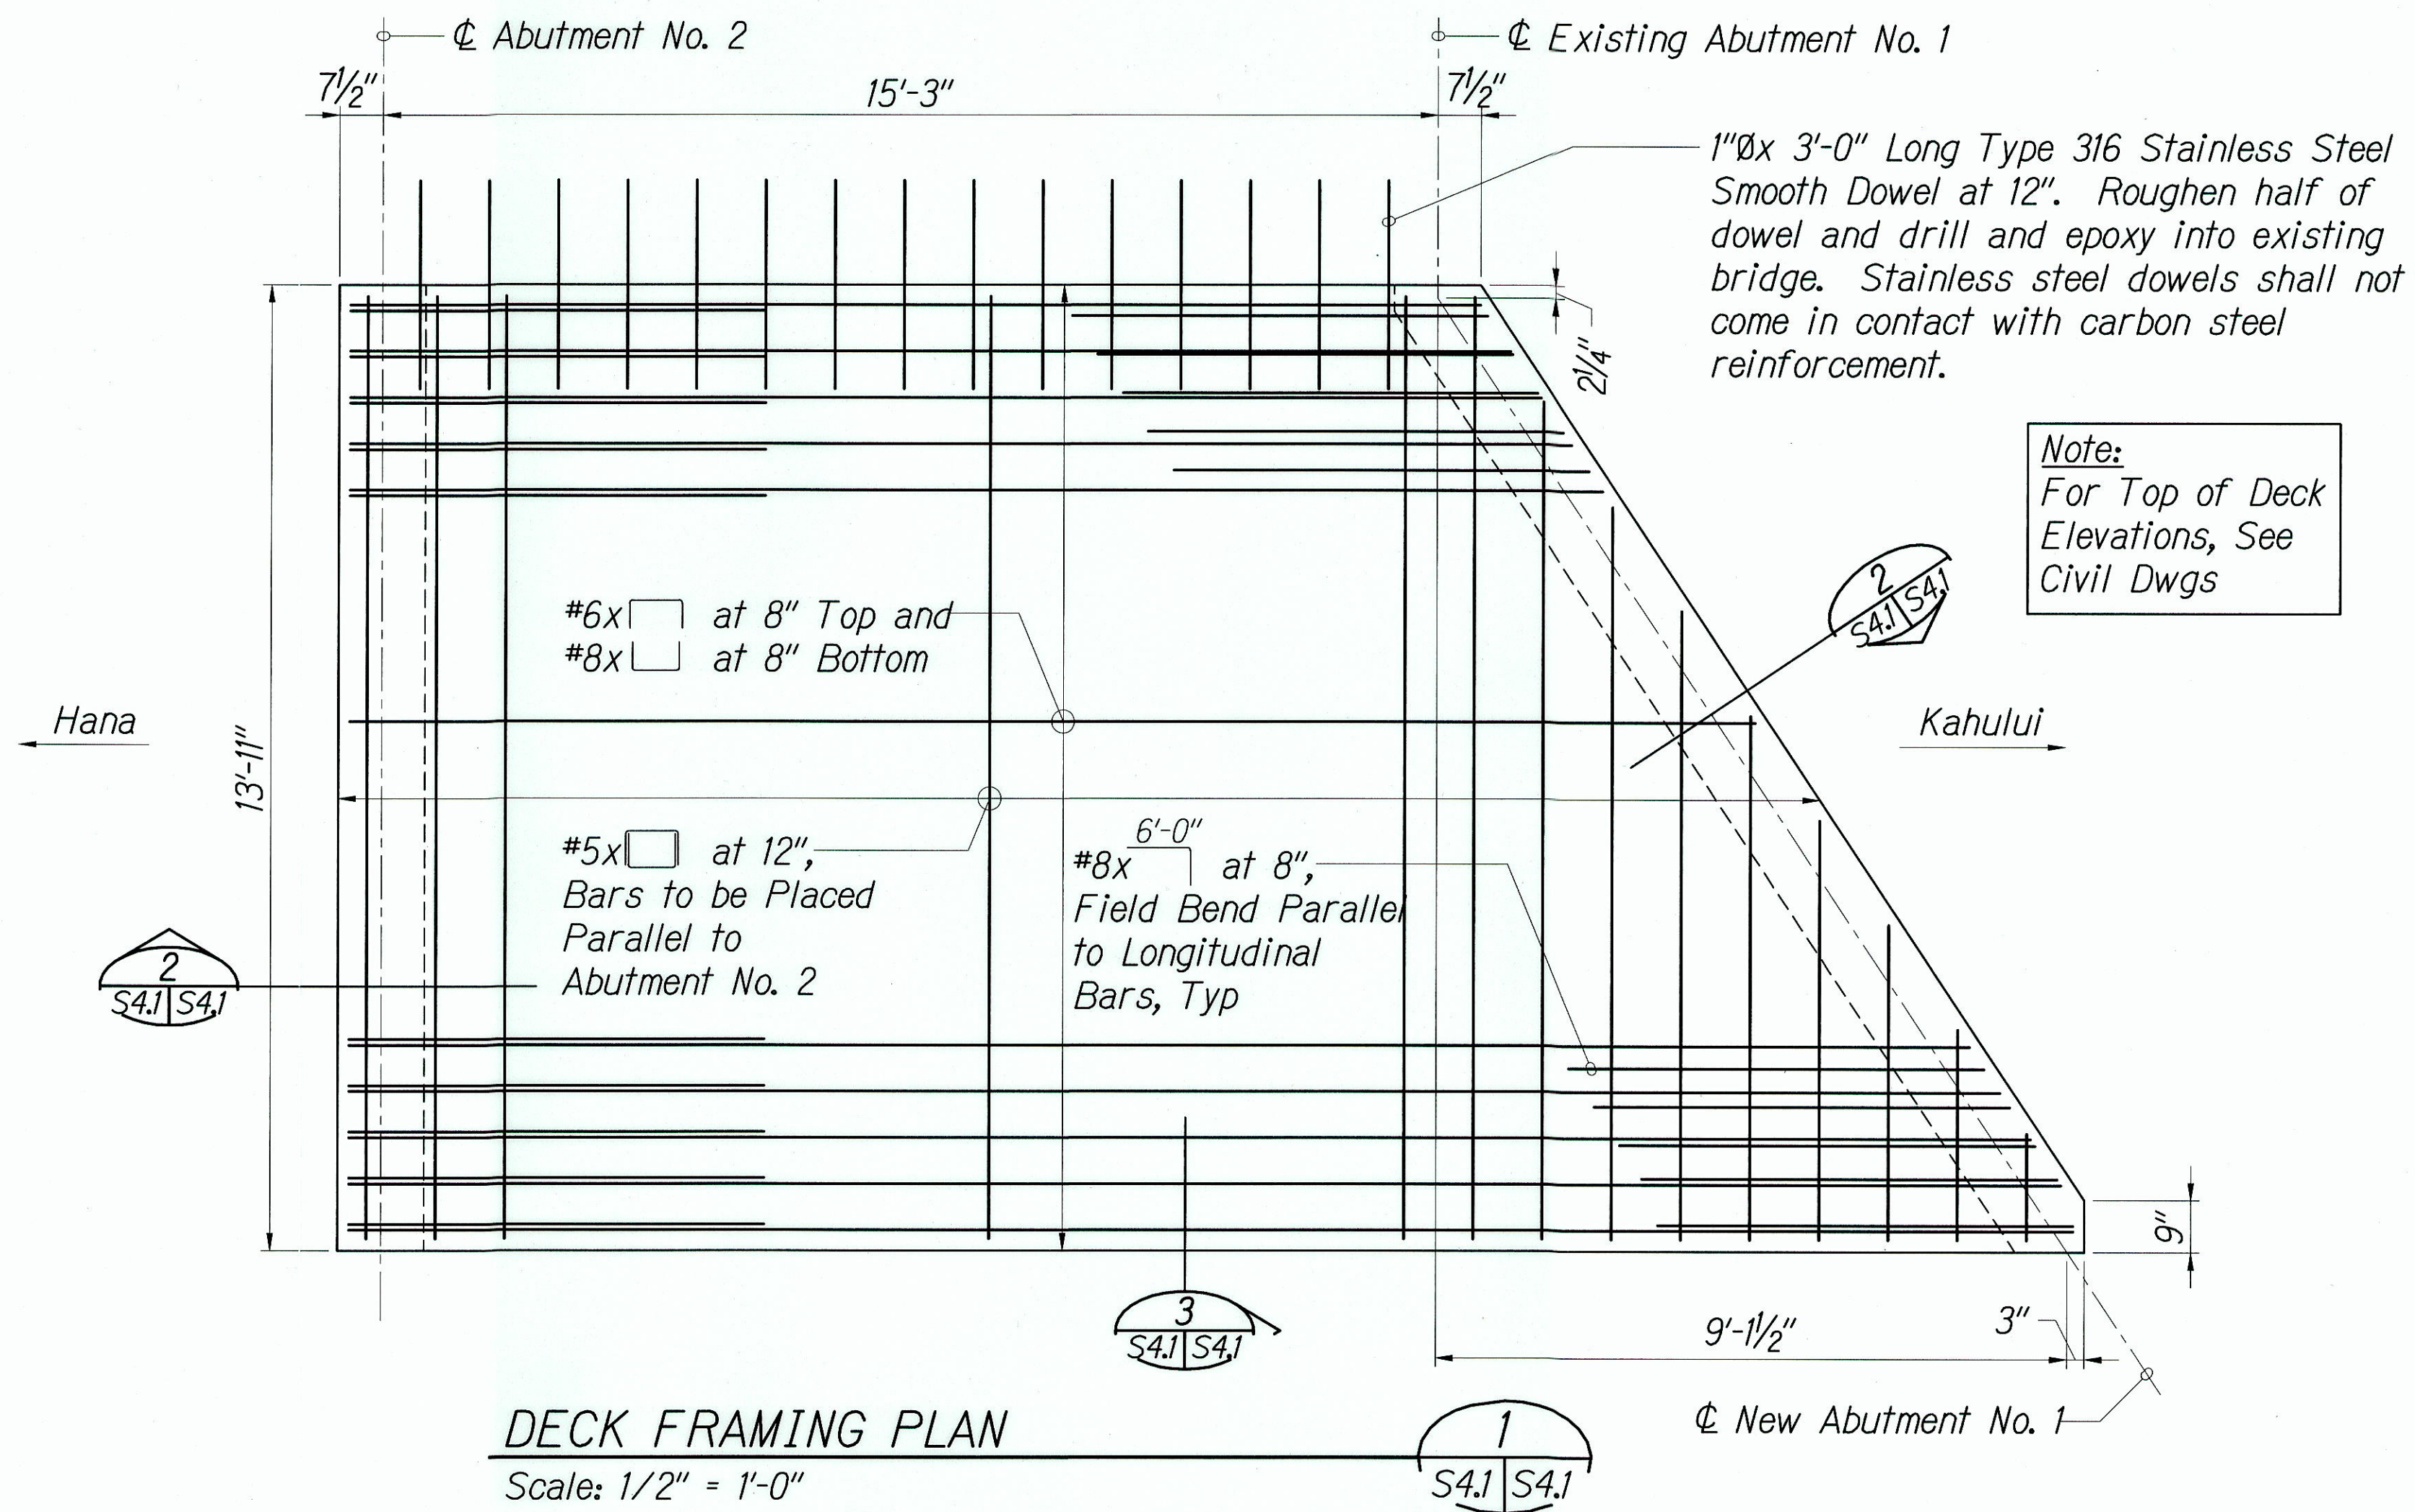


#### Legend

- Excavation Pay Limits
- Structural Backfill
- Impervious Backfill

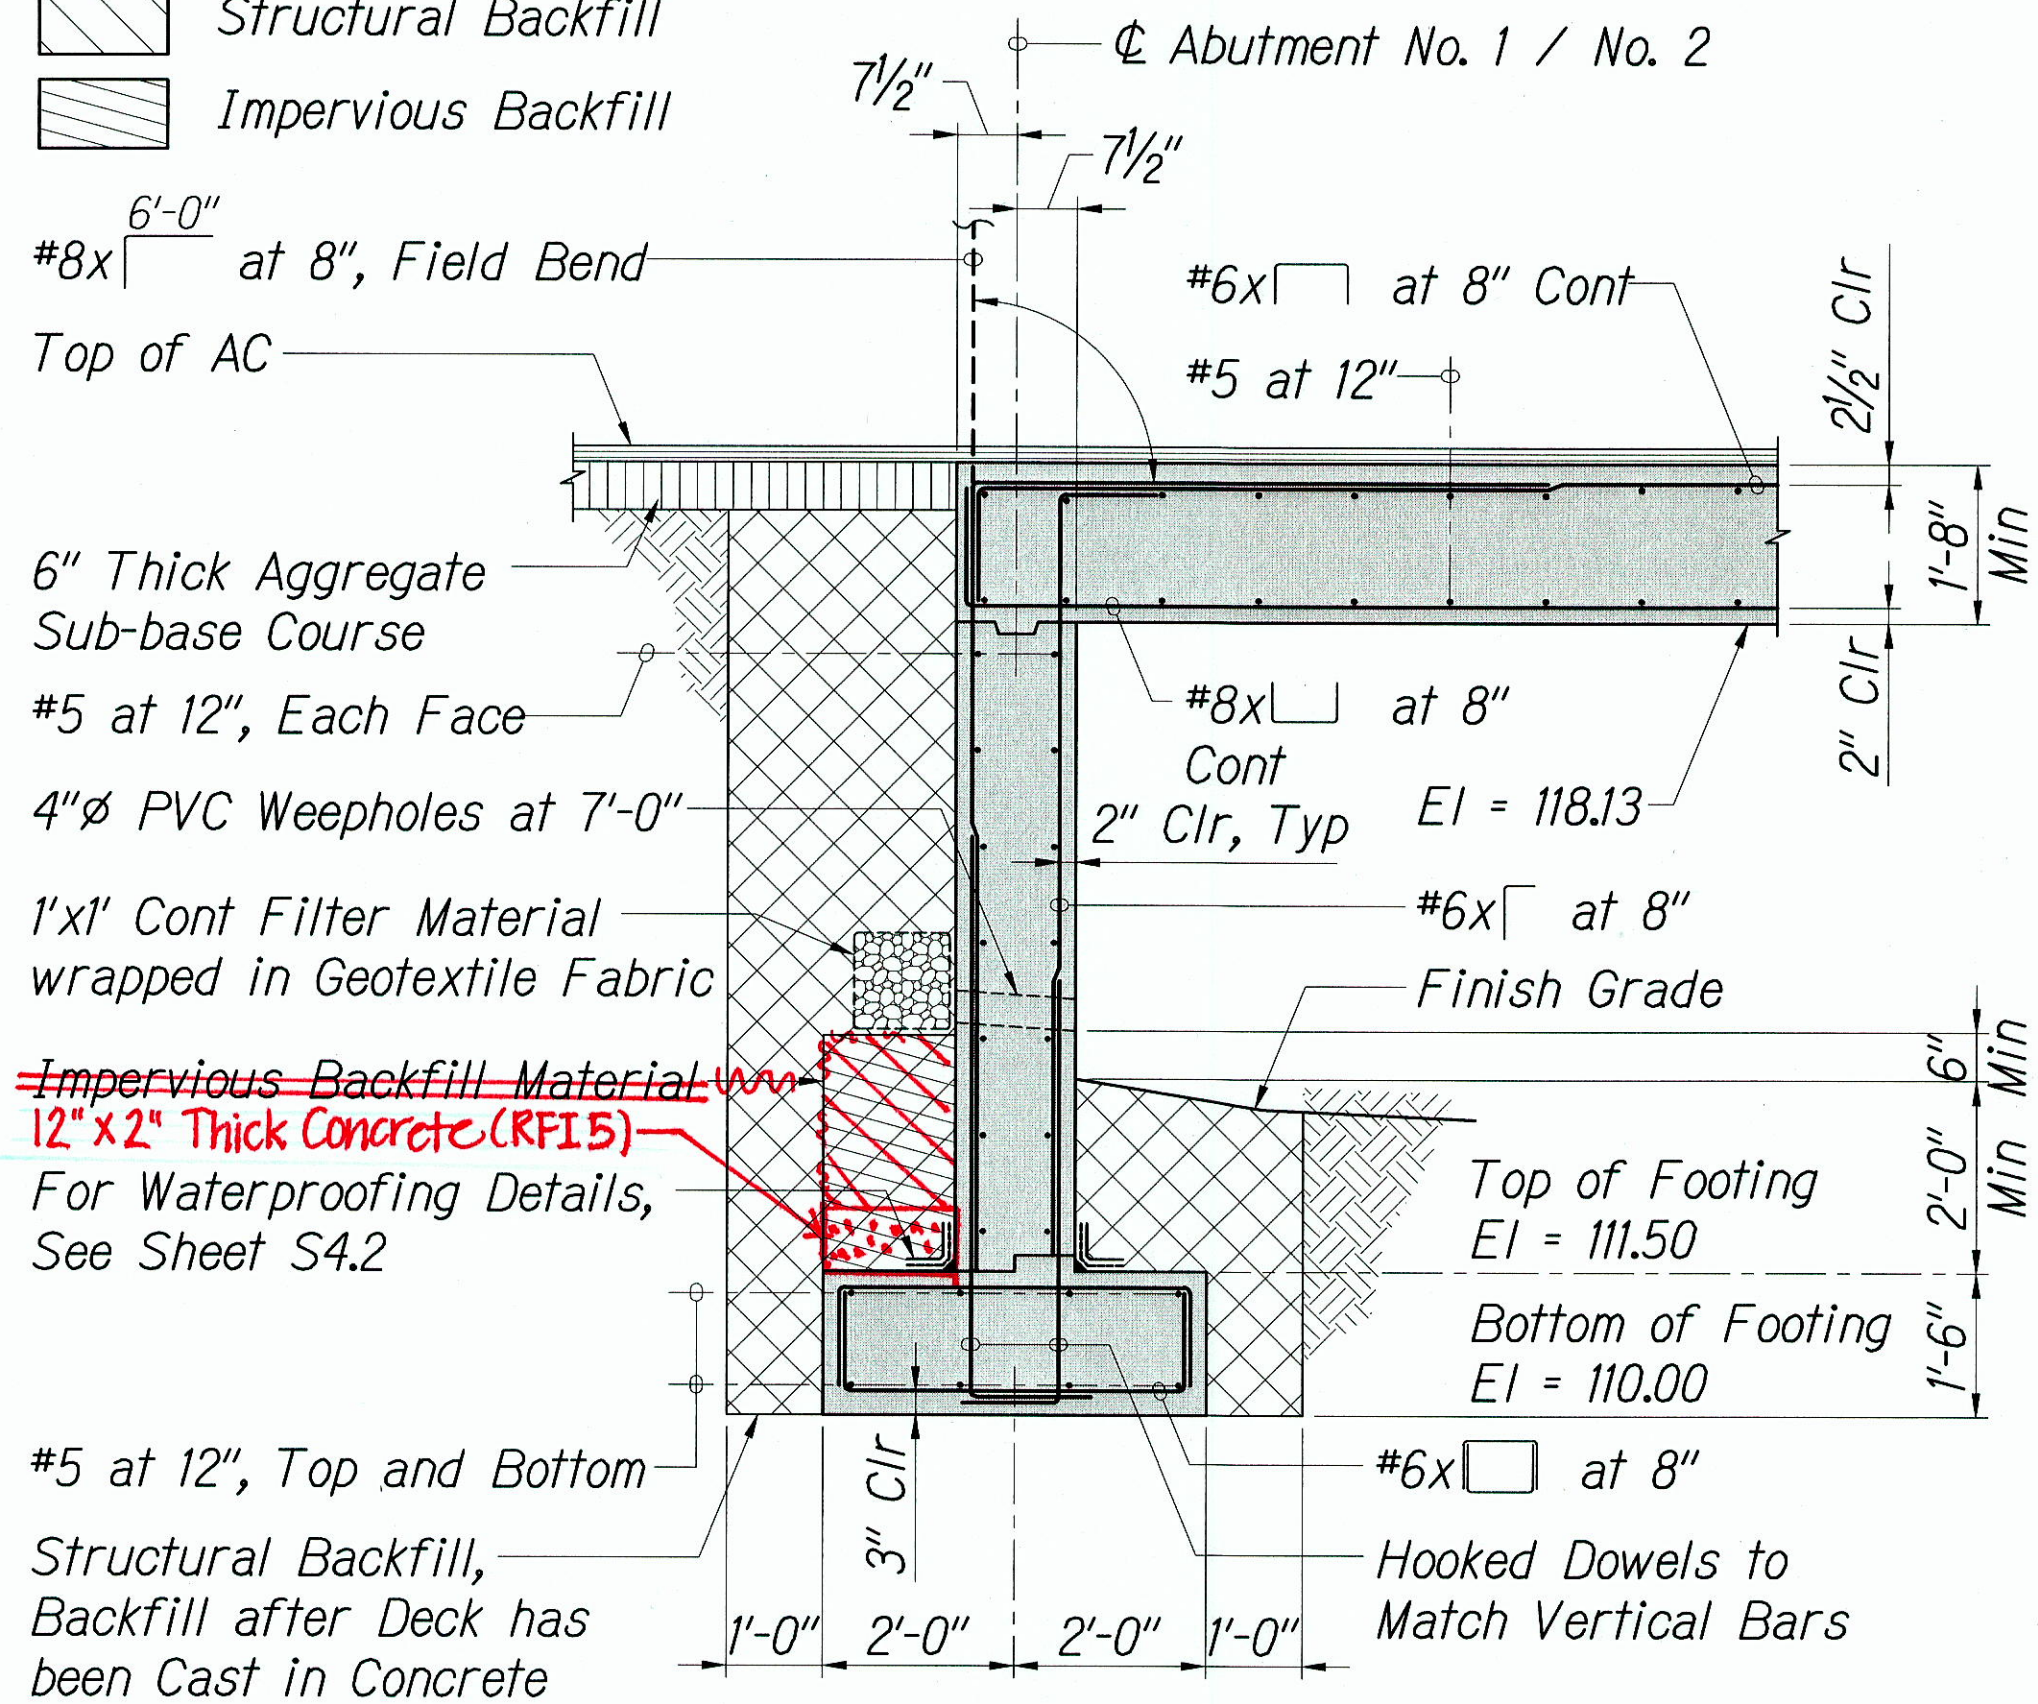

#### EAST PARAPET ELEVATION

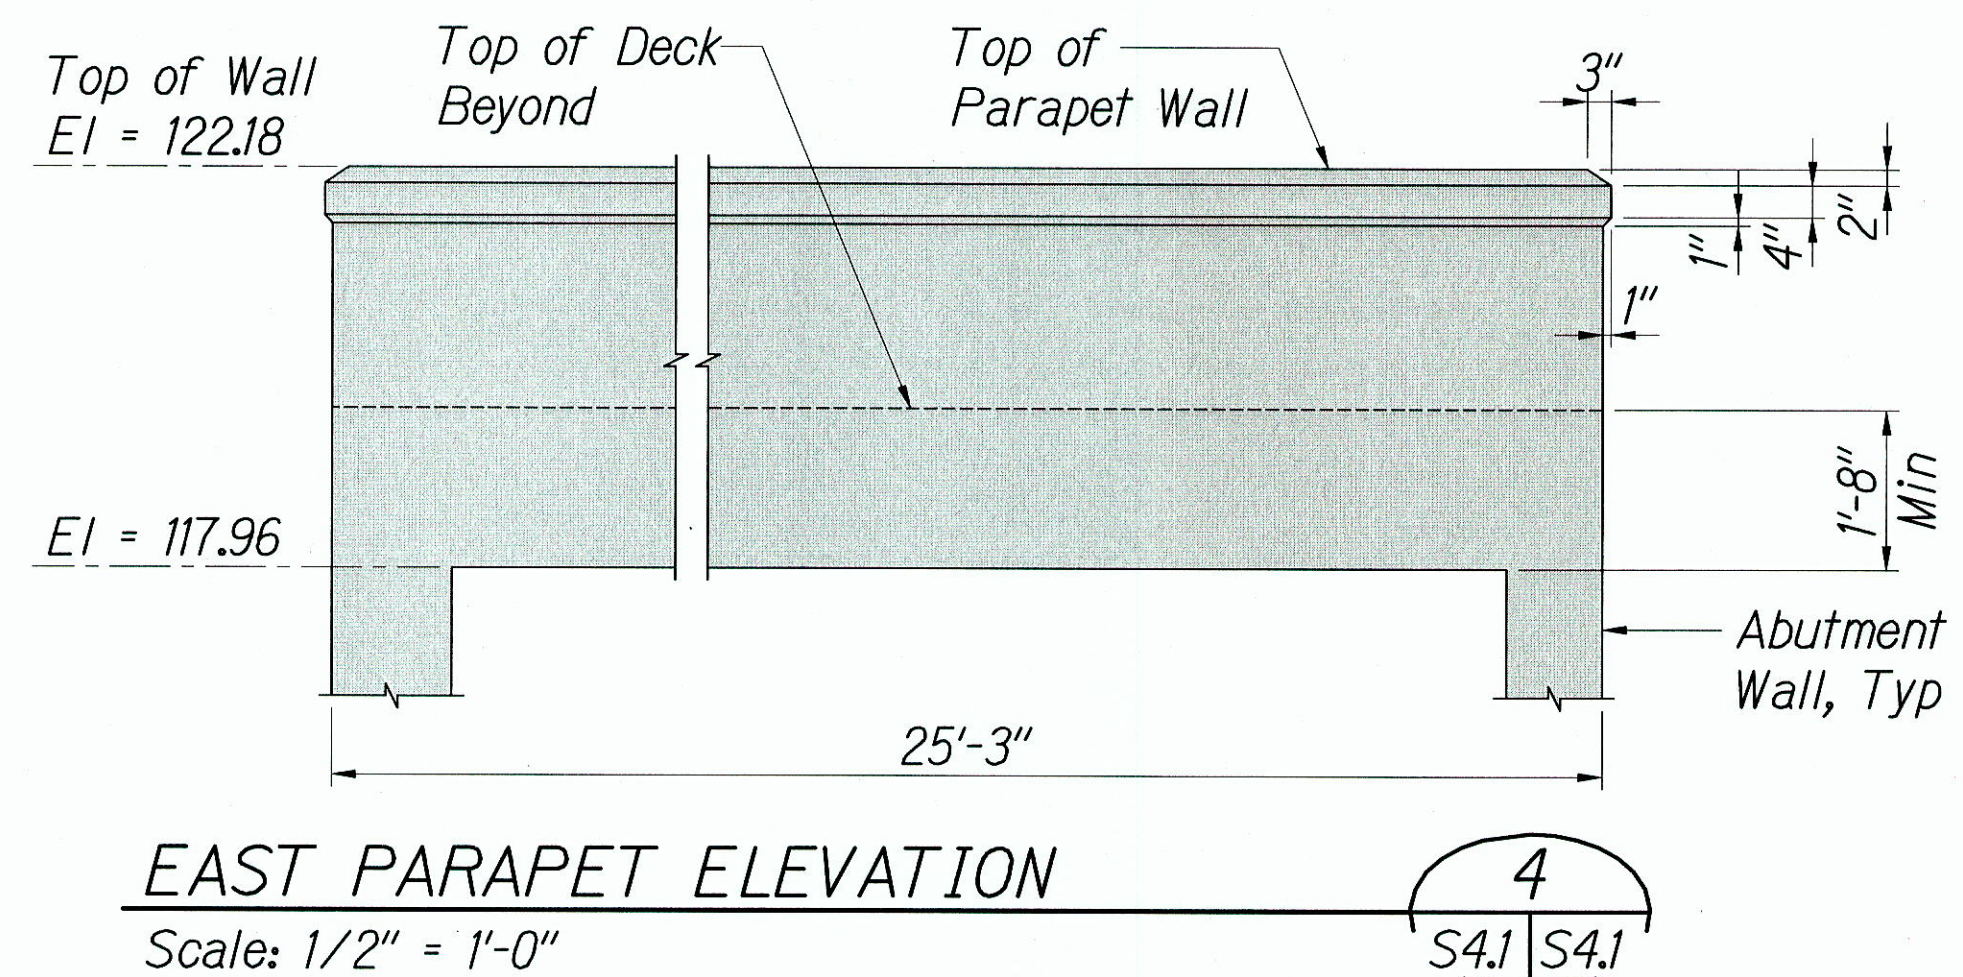

EXPIRATION DATE OF THE LICENSE 4/30/2012  
THIS WORK WAS PREPARED BY  
ME OR UNDER MY SUPERVISION

STATE OF HAWAII DEPARTMENT OF TRANSPORTATION HIGHWAYS DIVISION
SECTIONS AND DETAILS
ROUTE 360 HANA HIGHWAY IMPROVEMENTS UAKA ROAD TO KEAWA PLACE Project No. 360B-01-03
Scale: As Noted Date: December 2011
SHEET No. S4.1 OF 7 SHEETS

"AS-BUILT"