


FED. ROAD DIST. NO.	STATE	PROJ. NO.	FISCAL YEAR	SHEET NO.	TOTAL SHEETS
HAWAII	HAW.	360B-01-03	2012	8	20

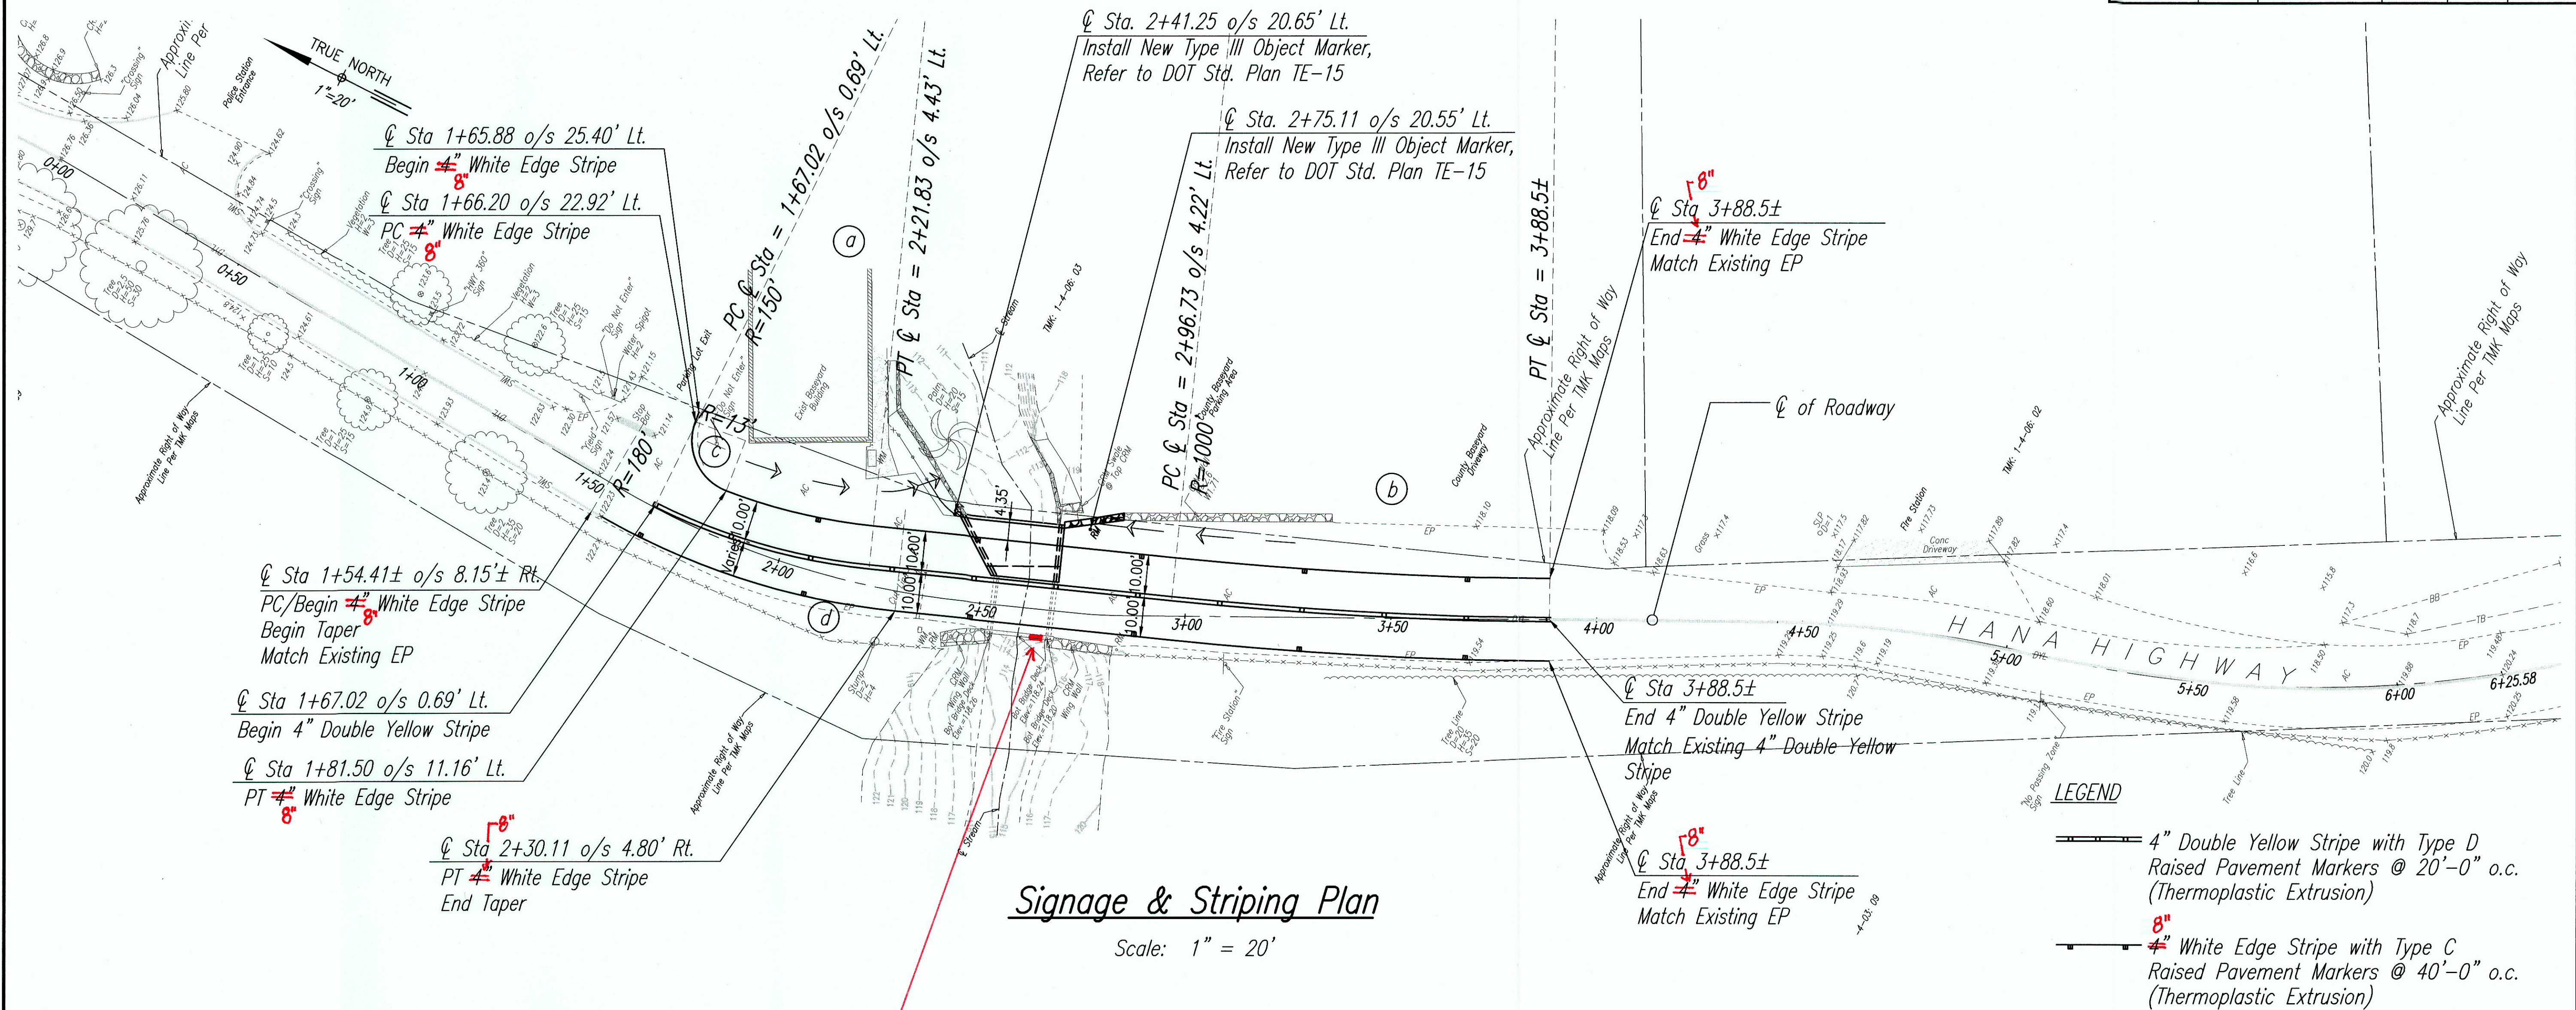


Signage & Striping Plan

Scale: 1" = 20'

LEGEND

- 4" Double Yellow Stripe with Type D Raised Pavement Markers @ 20'-0" o.c. (Thermoplastic Extrusion)
- 4" White Edge Stripe with Type C Raised Pavement Markers @ 40'-0" o.c. (Thermoplastic Extrusion)

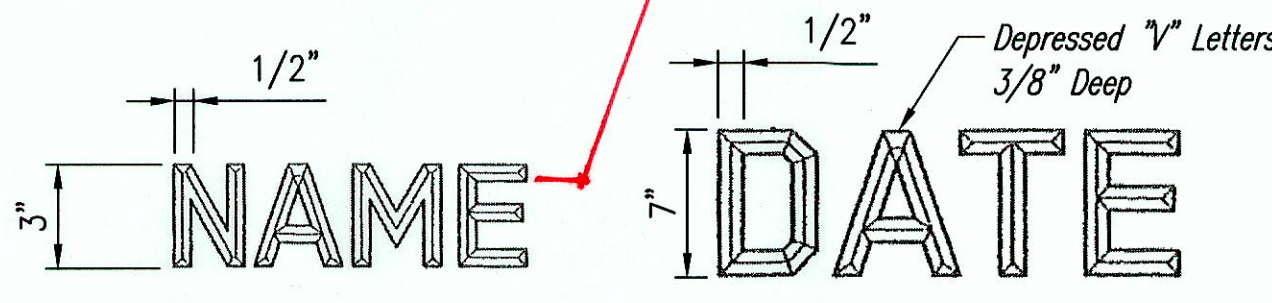

Name of Bridge Date of Year Built

- NOTES:**
- Exact details and spacing of letter and figures and location shall be as directed by the Engineer. Gothic letters and figures approximating the dimensions shown will be acceptable if approved by the Engineer.
 - Name & Date shall be etched on the existing parapet wall.
 - Unless otherwise directed by the Engineer, The name of the bridge shall be "Holoia wā wae Gulch". The date shall be 1915.
 - After Name & Date is etched, the Contractor shall apply a water based stain resistant sealer for concrete or masonry.


Saw cut 51-5/8" x 8"
Chip 1/2" deep
Precast Name and Date with Euco Patch 5000 psi
Press and Secure the Precast into the wall.
Apply "Glazen Seal"
(RFI 6)

DYL Curve Data

	(a)	(b)
Δ	20° 47' 12"	5° 16' 00"
Δ/2	10° 23' 36"	2° 38' 00"
R	150.00'	1000.00'
T	27.51'	45.99'
C	54.12'	91.89'
LC	54.42'	91.92'

SYL Curve Data

	(c)	(d)
Δ	89° 37' 17"	24° 54' 39"
Δ/2	44° 48' 38.5"	12° 27' 19.5"
R	13.00'	180.00'
T	12.91'	39.76'
C	18.32'	77.65'
LC	20.33'	78.26'

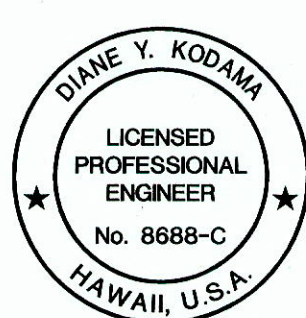

THIS WORK WAS PREPARED BY ME OR UNDER MY SUPERVISION.

STATE OF HAWAII
DEPARTMENT OF TRANSPORTATION
HIGHWAYS DIVISION

SIGNAGE & STRIPING PLAN

ROUTE 360 HANA HIGHWAY
IMPROVEMENTS
UAKA ROAD TO KEAWA PLACE
Project No. 360B-01-03

Scale: 1" = 20' Date: December 2011

SHEET No. 8 OF 13 SHEETS

"AS-BUILT"