


FED. ROAD DIST. NO.	STATE	PROJ. NO.	FISCAL YEAR	SHEET NO.	TOTAL SHEETS
HAWAII	HAW.	360B-01-03	2012	ADD. 7	20

Centerline Curve Data

	①	②	③	④
Δ	24° 34' 58"	5° 16'	12° 43' 00"	22° 00'
Δ/2	12° 17' 29"	2° 38'	6° 21' 30"	11° 00'
R	208.84'	98.39'	280.00'	300.00'
T	45.50'	4.53'	31.20'	58.31'
C	88.92'	9.04'	62.02'	114.49'
LC	89.60'	9.04'	62.15'	115.19'

BEGIN PROJECT
@ Sta. 1+50.00

END PROJECT
@ Sta. 4+50

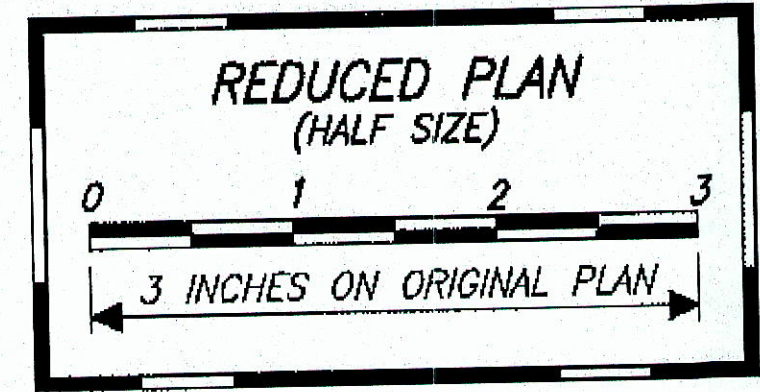

@ Sta. 1+50.00 Begin Cold Planing
Construct Smooth Riding Connection
Begin 1'-0" Min. Taper From Exist
AC to Meet New AC Overlay

@ Sta. 4+00.00 End Cold Planing
Construct Smooth Riding Connection
Begin 1'-0" Min. Taper From Exist
AC to Meet New AC Overlay

SEE SITE PLAN INSET BELOW

Site Plan

Scale: 1" = 20'

Note:

Reconstruct all AC Pavement within new travelway.


Legend:

- Pavement Cold Planing
- Pavement Widening
- Pavement Overlay
- 1'-0" Minimum Taper, See Sheet 11, Typical Section and Pavement Cold Planing Structure (Sta 1+50 and 4+00)


Survey Notes:

- Azimuths and Coordinates are referred to Government Survey Triangulation Station "Kauiki Δ". From found Monuments as shown on Hana House Lots No. 2, File Plan No. 1481.
- Map is compiled from records found at the State Survey Office, Real Property Tax Mapping Branch and Bureau of Conveyances. Recorded data has not been verified by an actual survey on the ground.
- Elevations are referred to "STA 6995-1" Elevation 127.38, as shown on the Topographic Survey Map of Lot 1 and a Portion of Lot 2 of the Hana Ranch Subdivision No. 3 dated March 24, 2008, by Newcomer-Lee Land Surveyors, Inc., and provided by DOT Highways.
- Date of Survey: April 02 - May 14, 2008.

DATE	
SURVEY PLOTTED BY	
DRAWN BY	
DESIGNED BY	
QUANTITIES BY	
CHECKED BY	
ORIGINAL PLAN	
NOTE BOOK	

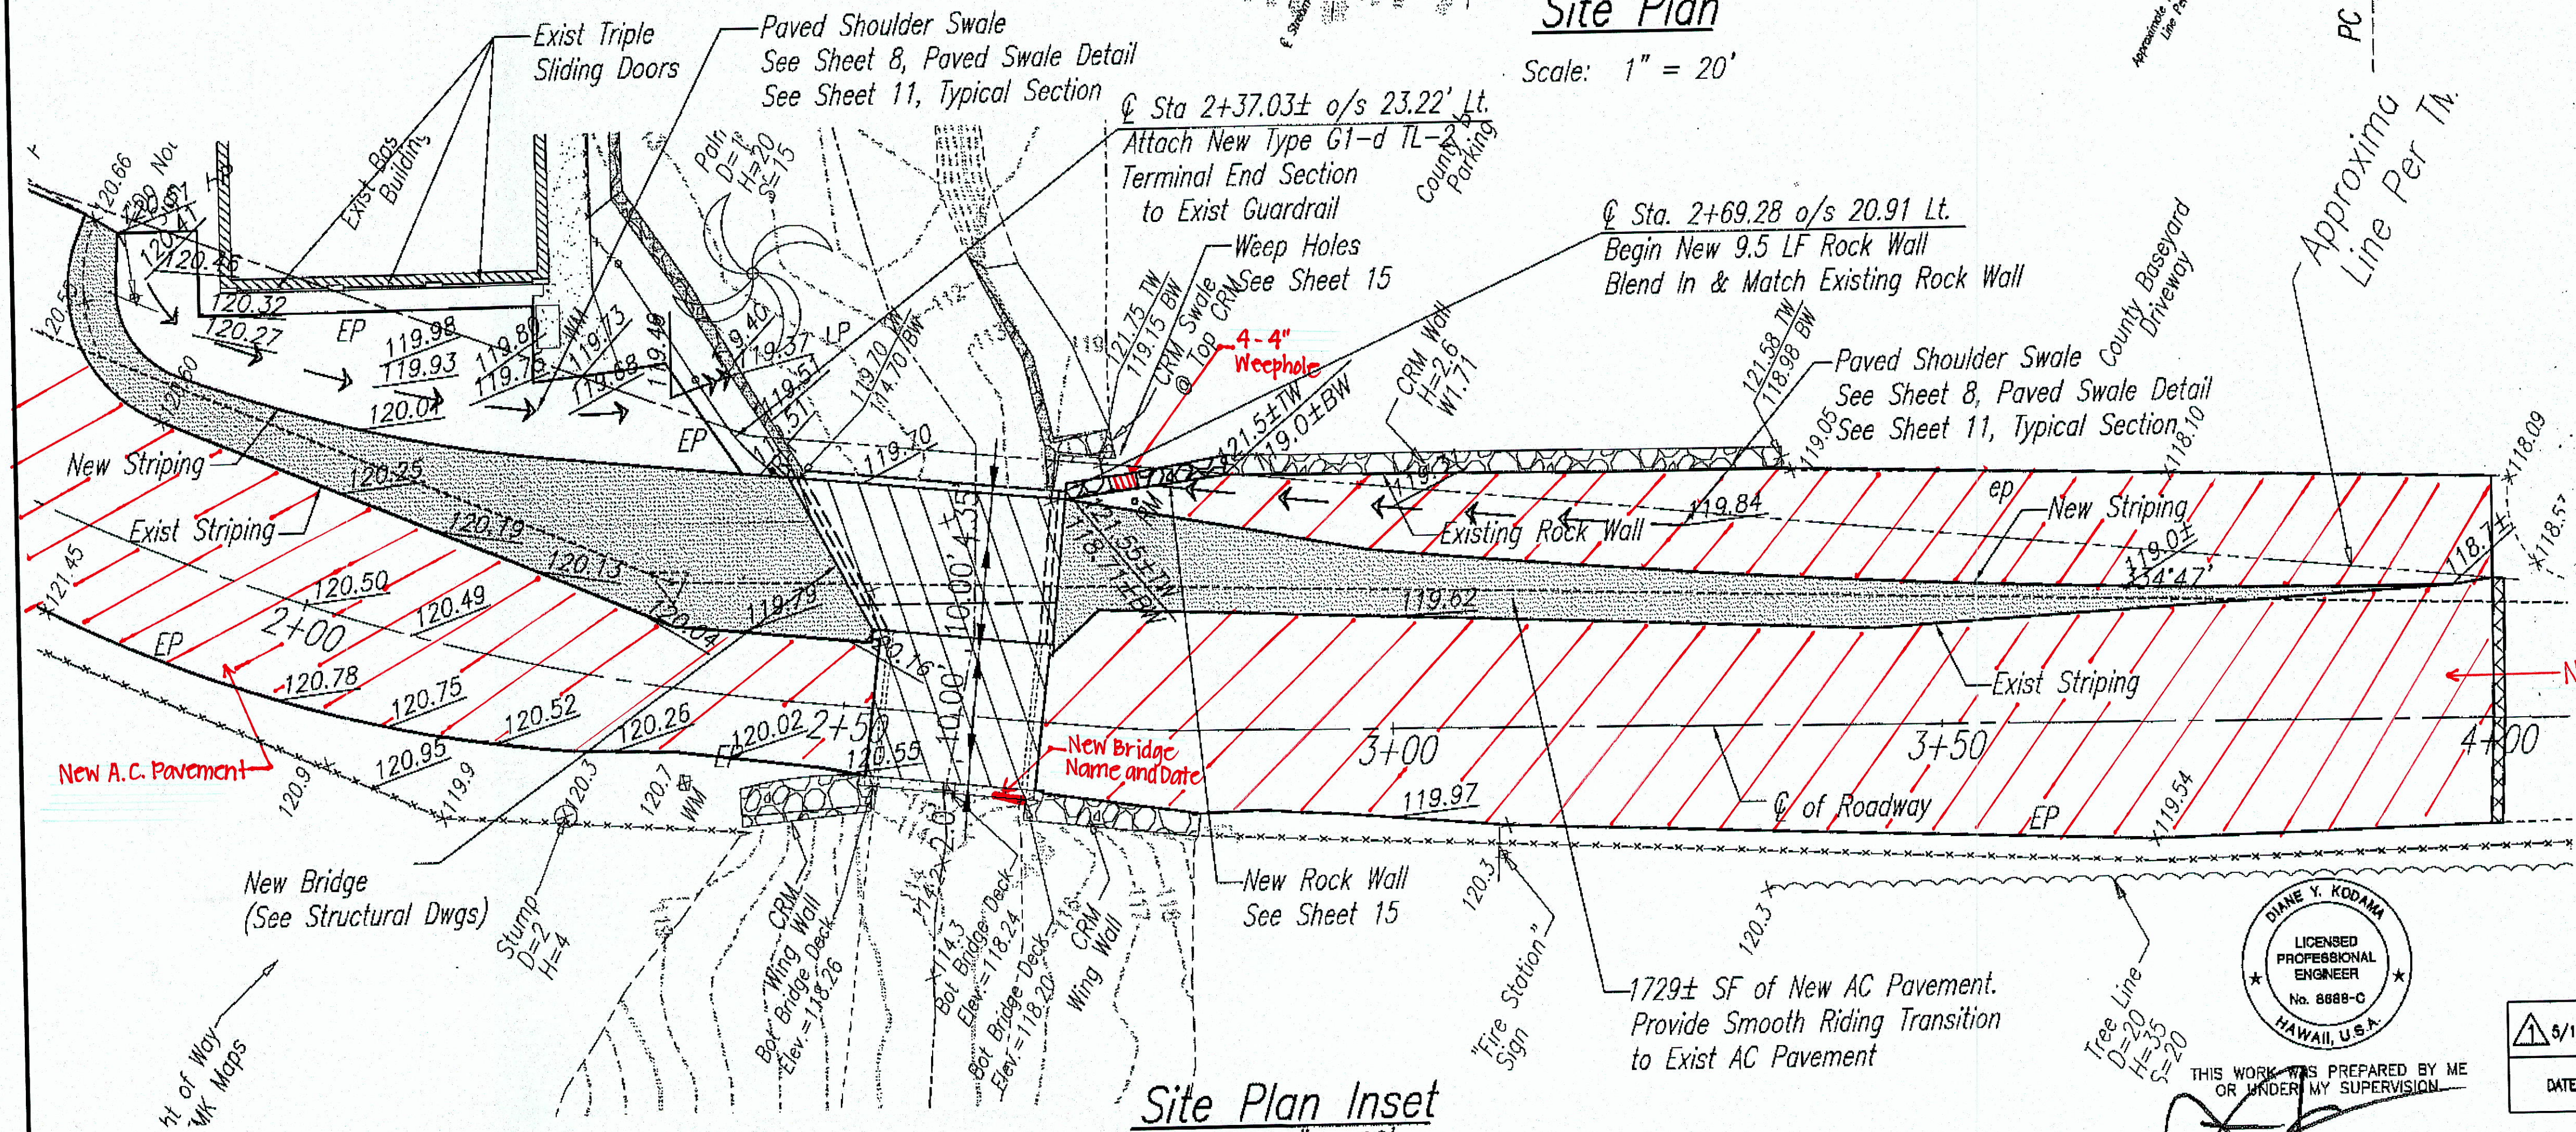

Site Plan Inset
Scale: 1" = 10'

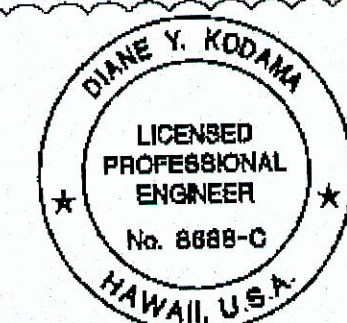

THIS WORK WAS PREPARED BY ME OR UNDER MY SUPERVISION

DATE	5/15/12
REVISION	EXPANDED AC SHOULDER WORK

STATE OF HAWAII
DEPARTMENT OF TRANSPORTATION
HIGHWAYS DIVISION

SITE PLAN

ROUTE 360 HANA HIGHWAY
IMPROVEMENTS
UAEKA ROAD TO KEAWA PLACE
Project No. 360B-01-03

Scale: 1" = 20' Date: December 2011

SHEET No. 7 OF 13 SHEETS

"AS-BUILT"