



FED. ROAD DIST. NO.	STATE	PROJ. NO.	FISCAL YEAR	SHEET NO.	TOTAL SHEETS
MAUI	HAW.	360B-02-06M	2009	11	34

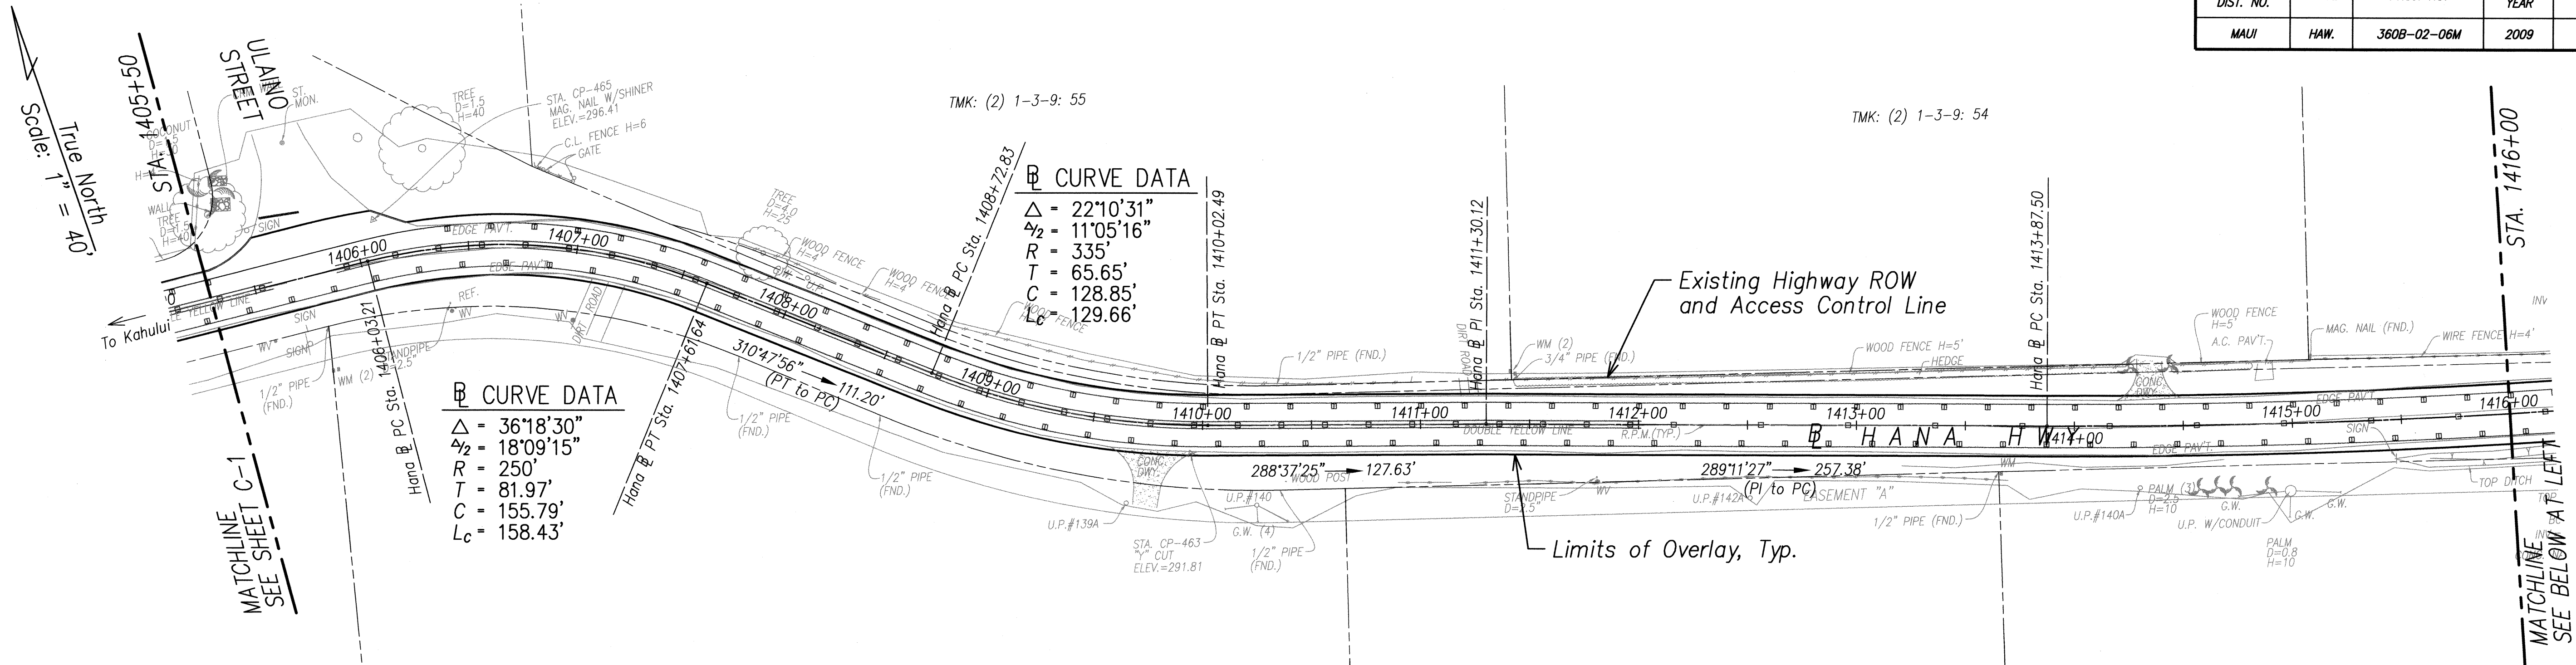


ROADWAY PLAN - 2 (STATION 1405+50 TO STATION 1416+00)
Scale: 1"=40'

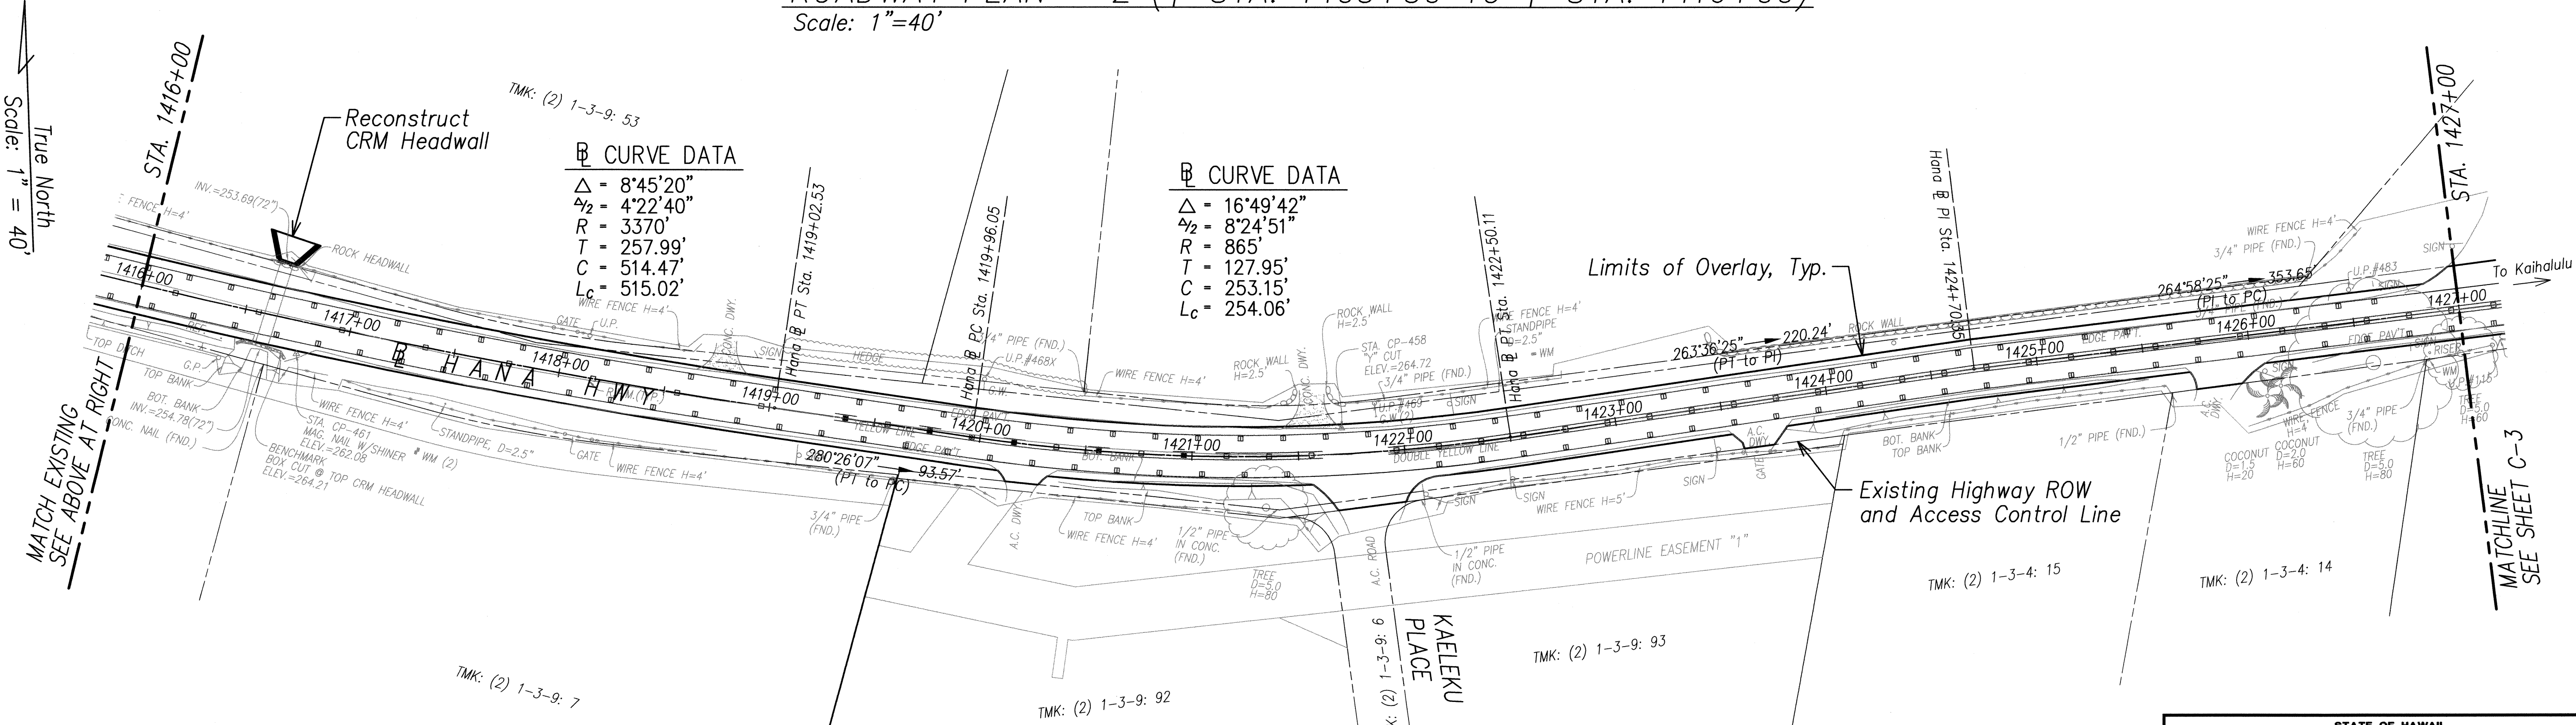

ROADWAY PLAN - 2 (STATION 1416+00 TO STATION 1427+00)
Scale: 1"=40'

DATE	_____
SURVEY PLOTTED BY	_____
DESIGNED BY	_____
TRACED BY	_____
NOTED BY	_____
CHECKED BY	_____
ORIGINAL PLAN	_____
NOTE BOOK	_____
No.	_____

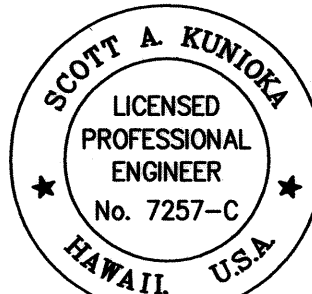

THIS WORK WAS PREPARED BY ME
OR UNDER MY SUPERVISION
Scott A. Kunioka
SHIMABUKURO, ENDO & YOSHIKAWA, INC.
1126 12TH Avenue
Honolulu, Hawaii 96816

STATE OF HAWAII
DEPARTMENT OF TRANSPORTATION
HIGHWAYS DIVISION


ROADWAY PLAN 2
(STATION 1405+50 TO STATION 1427+00)

HANA HIGHWAY RESURFACING
Route 360, Kalahu to Hana
Project No. 360B-02-06M


Scale: 1" = 40'-0" Date: May 2009

SHEET No. C-2 OF C-12 SHEETS

FED. ROAD DIST. NO.	STATE	PROJ. NO.	FISCAL YEAR	SHEET NO.	TOTAL SHEETS
MAUI	HAW.	360B-02-06M	2009	12	34

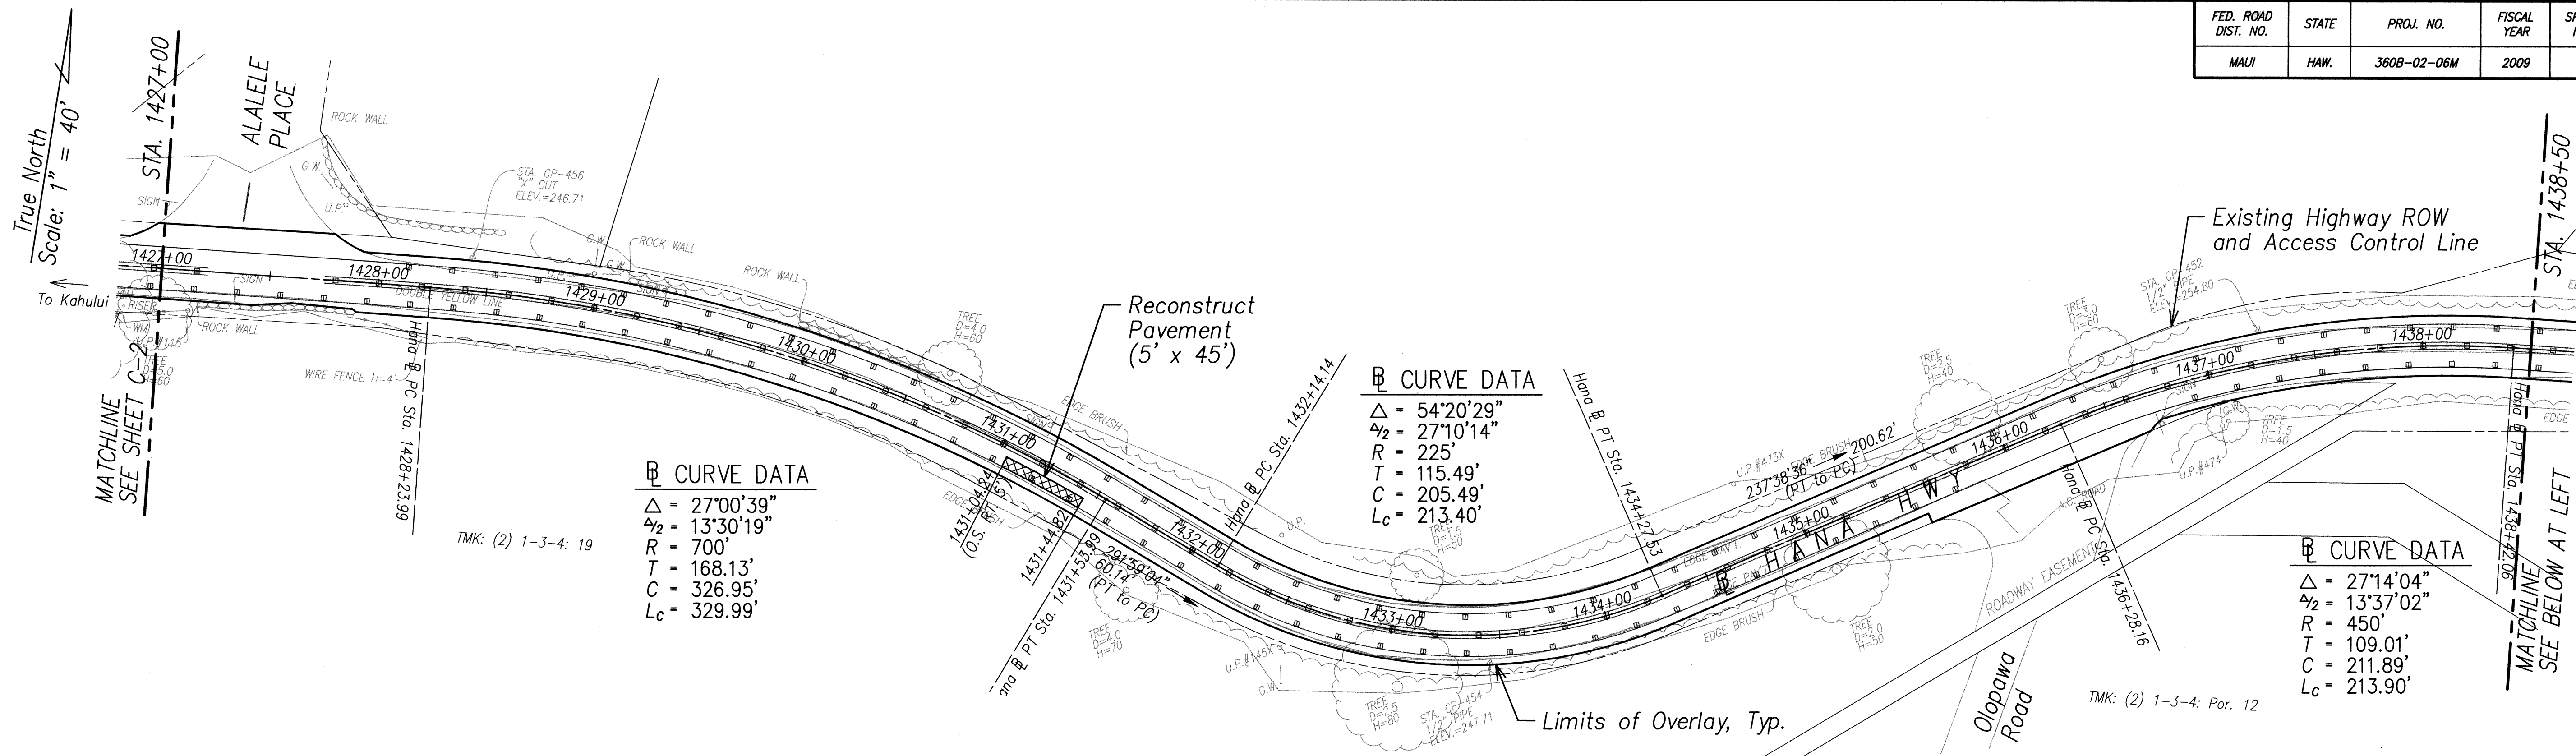

ROADWAY PLAN - 3 (STATION 1427+00 TO STATION 1438+50)
Scale: 1"=40'

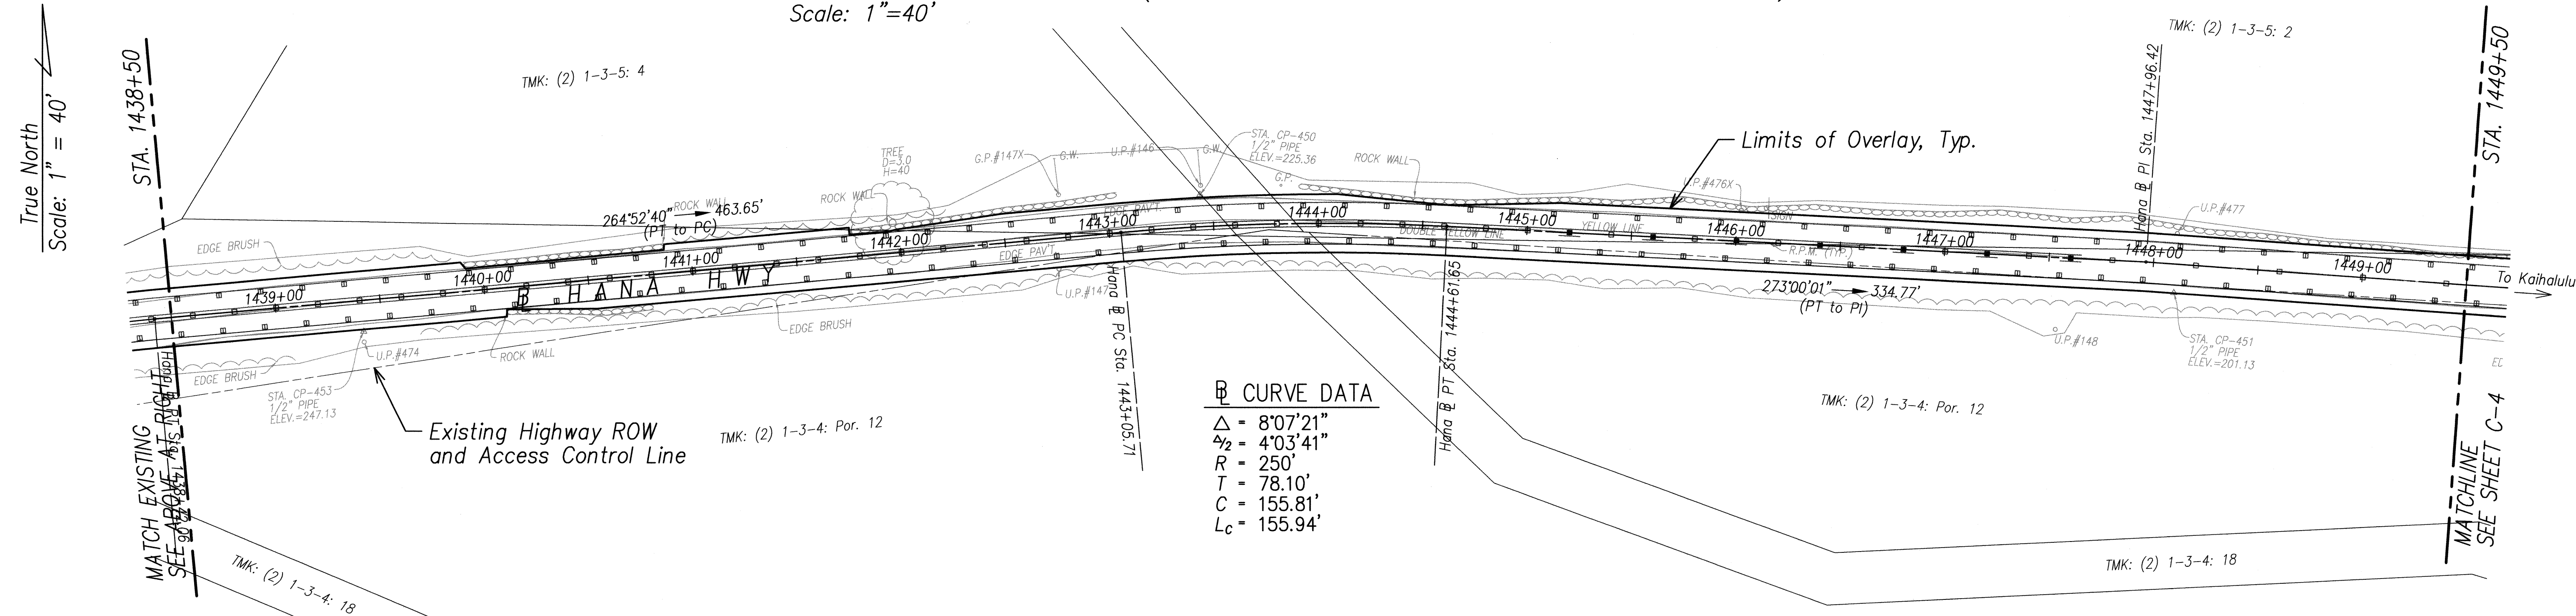

ROADWAY PLAN - 3 (STATION 1438+50 TO STATION 1449+50)
Scale: 1"=40'

ORIGINAL PLAN	DATE
DESIGNED BY	
TRACED BY	
NOTED BY	
CHECKED BY	
DATE	

THIS WORK WAS PREPARED BY ME
OR UNDER MY SUPERVISION

Scott A. Kunikida

SHIMABUKURO, ENDO & YOSHIZAKI, INC.
1126 12TH Avenue
Honolulu, Hawaii 96816

STATE OF HAWAII
DEPARTMENT OF TRANSPORTATION
HIGHWAYS DIVISION

ROADWAY PLAN 3



(STATION 1427+00 TO STATION 1449+50)

HANA HIGHWAY RESURFACING
Route 360, Kalahu to Hana
Project No. 360B-02-06M

Scale: 1" = 40'-0" Date: May 2009

SHEET No. C-3 OF C-12 SHEETS

FED. ROAD DIST. NO.	STATE	PROJ. NO.	FISCAL YEAR	SHEET NO.	TOTAL SHEETS
MAUI	HAW.	360B-02-06M	2009	13	34

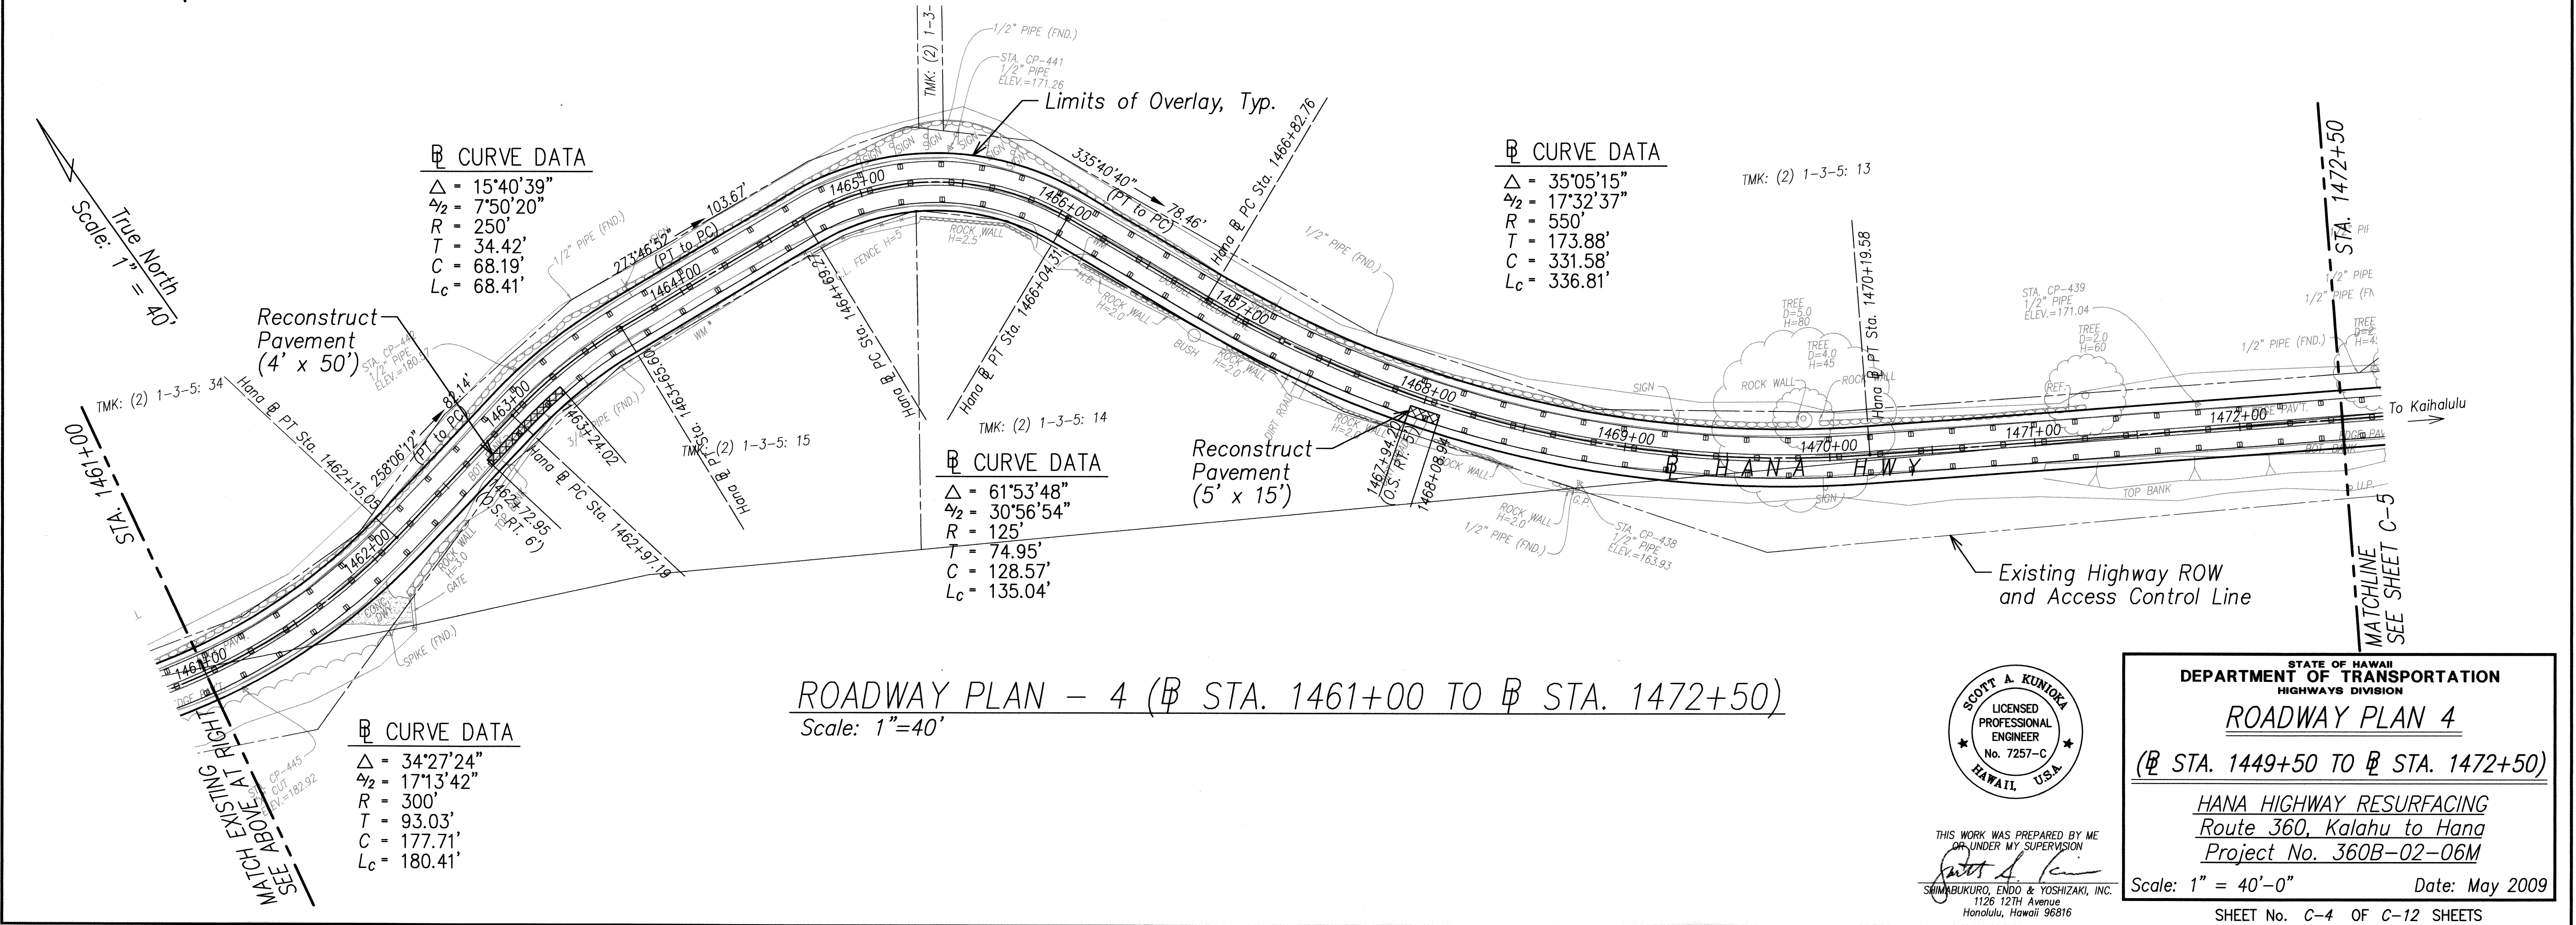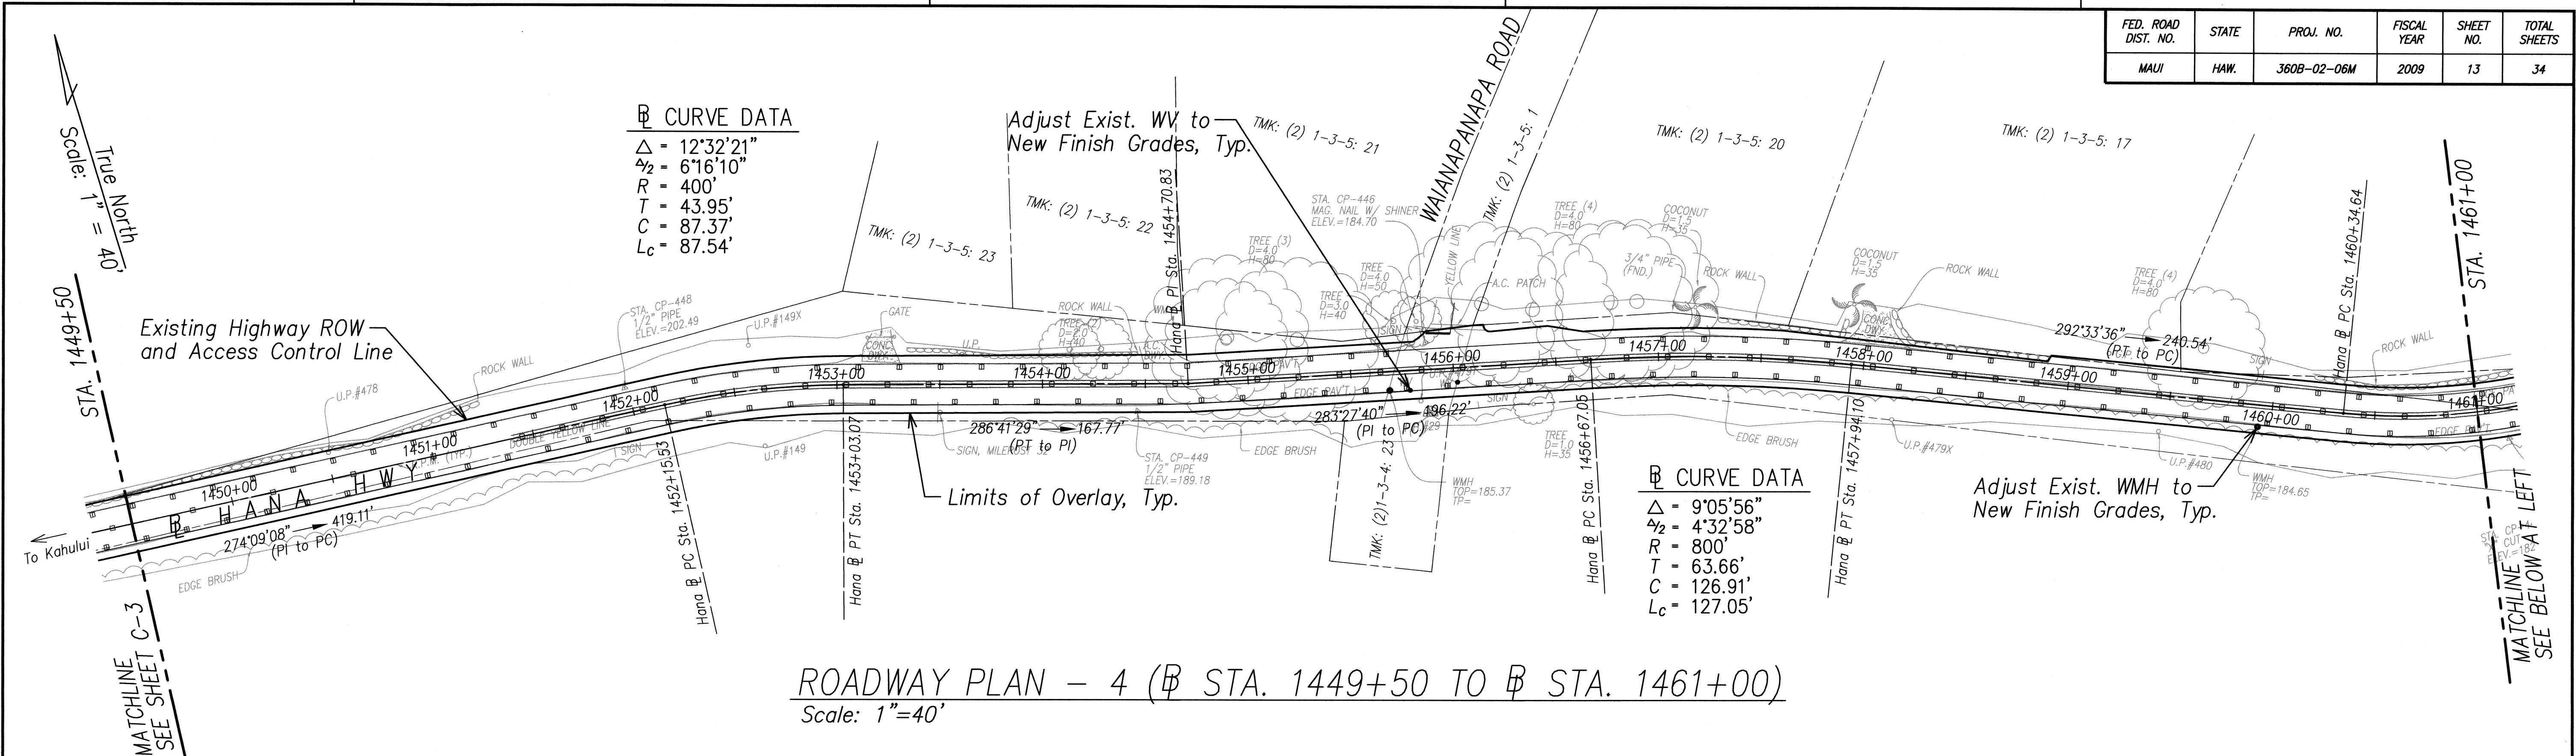

DATE	____
SURVEY PLOTTED BY	____
DESIGNED BY	____
CHECKED BY	____
NO.	____

SCOTT A. KUNIOKA

LICENSED PROFESSIONAL ENGINEER

No. 7257-C

HAWAII, U.S.A.

THIS WORK WAS PREPARED BY ME OR UNDER MY SUPERVISION

Scott A. Kuniooka

SHIMABUKURO, ENDO & YOSHIZAKI, INC.

1126 12TH Avenue

Honolulu, Hawaii 96816

STATE OF HAWAII

DEPARTMENT OF TRANSPORTATION

HIGHWAYS DIVISION

ROADWAY PLAN 4

(B STA. 1449+50 TO B STA. 1472+50)

HANA HIGHWAY RESURFACING

Route 360, Kalahu to Hana


Project No. 360B-02-06M

Scale: 1" = 40'-0"


Date: May 2009

SHEET No. C-4 OF C-12 SHEETS

FED. ROAD DIST. NO.	STATE	PROJ. NO.	FISCAL YEAR	SHEET NO.	TOTAL SHEETS
MAUI	HAW.	360B-02-06M	2009	14	34

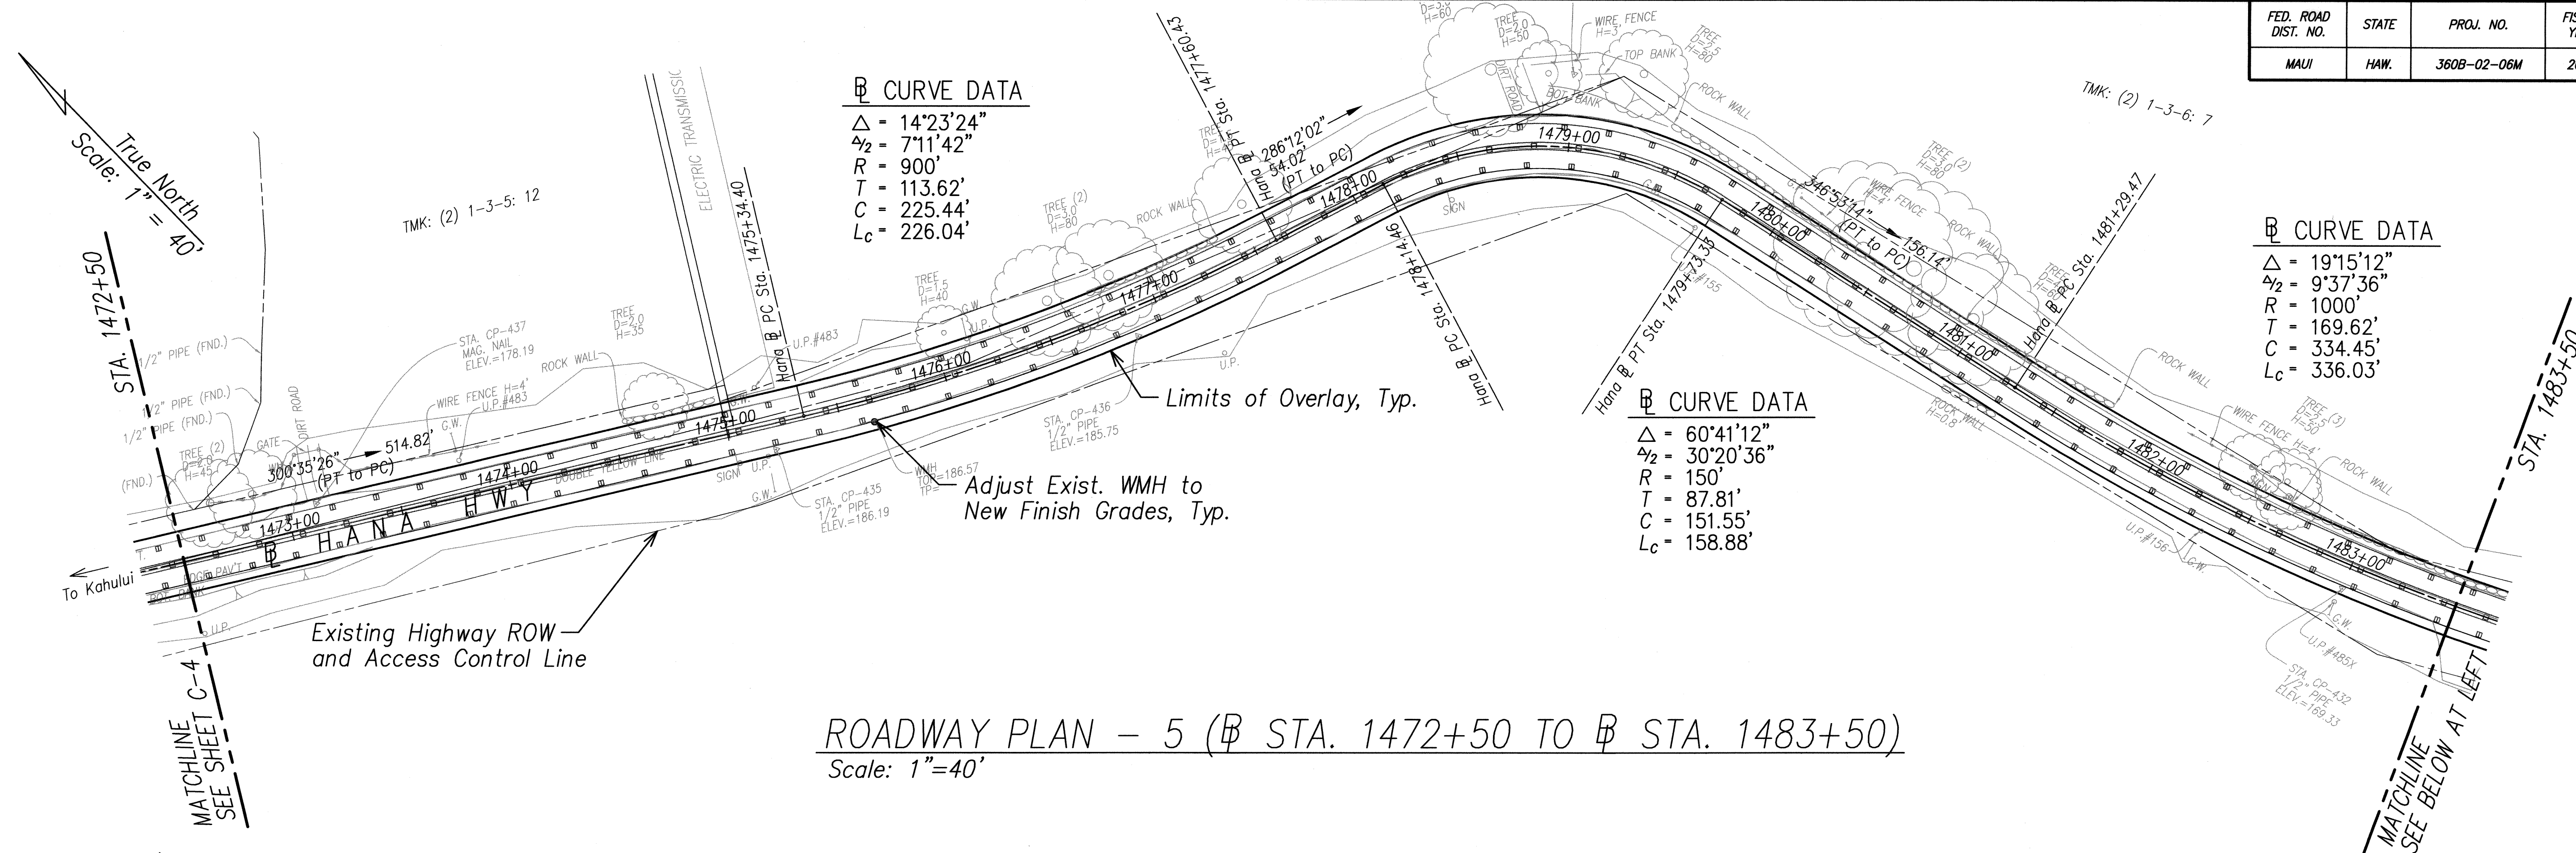


ROADWAY PLAN - 5 (STATION 1472+50 TO STATION 1483+50)
Scale: 1"=40'

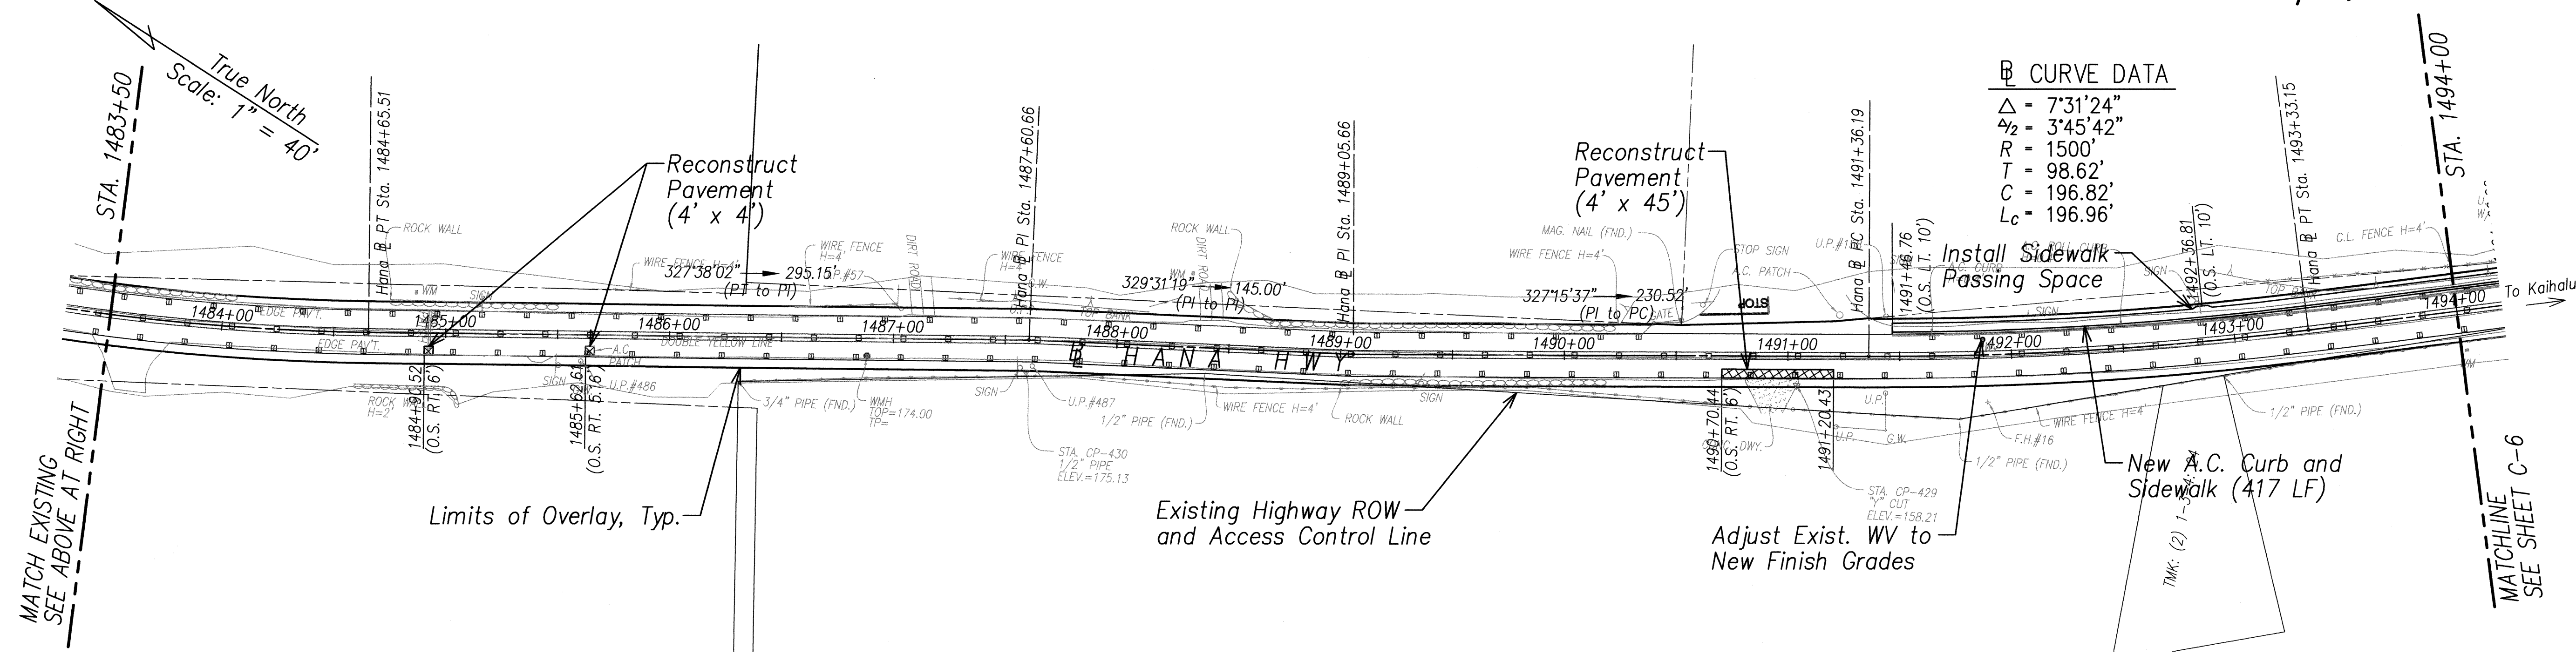

ROADWAY PLAN - 5 (STATION 1483+50 TO STATION 1494+00)
Scale: 1"=40'

ORIGINAL PLAN	DATE
SURVEY PLOTTED BY	
DRAWN BY	
DESIGNED BY	
QUANTITIES BY	
CHECKED BY	

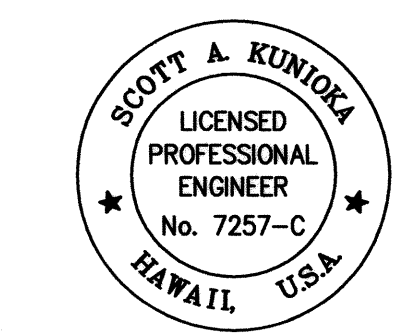

THIS WORK WAS PREPARED BY ME
OR UNDER MY SUPERVISION
SHIMABUKURO, ENDO & YOSHIZAKI, INC.
1126 12TH AVENUE
HONOLULU, HAWAII 96816

STATE OF HAWAII
DEPARTMENT OF TRANSPORTATION
HIGHWAYS DIVISION


ROADWAY PLAN 5
(STATION 1472+50 TO STATION 1494+00)

HANA HIGHWAY RESURFACING
Route 360, Kalahu to Hana
Project No. 360B-02-06M


Scale: 1" = 40'-0" Date: May 2009

SHEET No. C-5 OF C-12 SHEETS

FED. ROAD DIST. NO.	STATE	PROJ. NO.	FISCAL YEAR	SHEET NO.	TOTAL SHEETS
MAUI	HAW.	360B-02-06M	2009	16	34

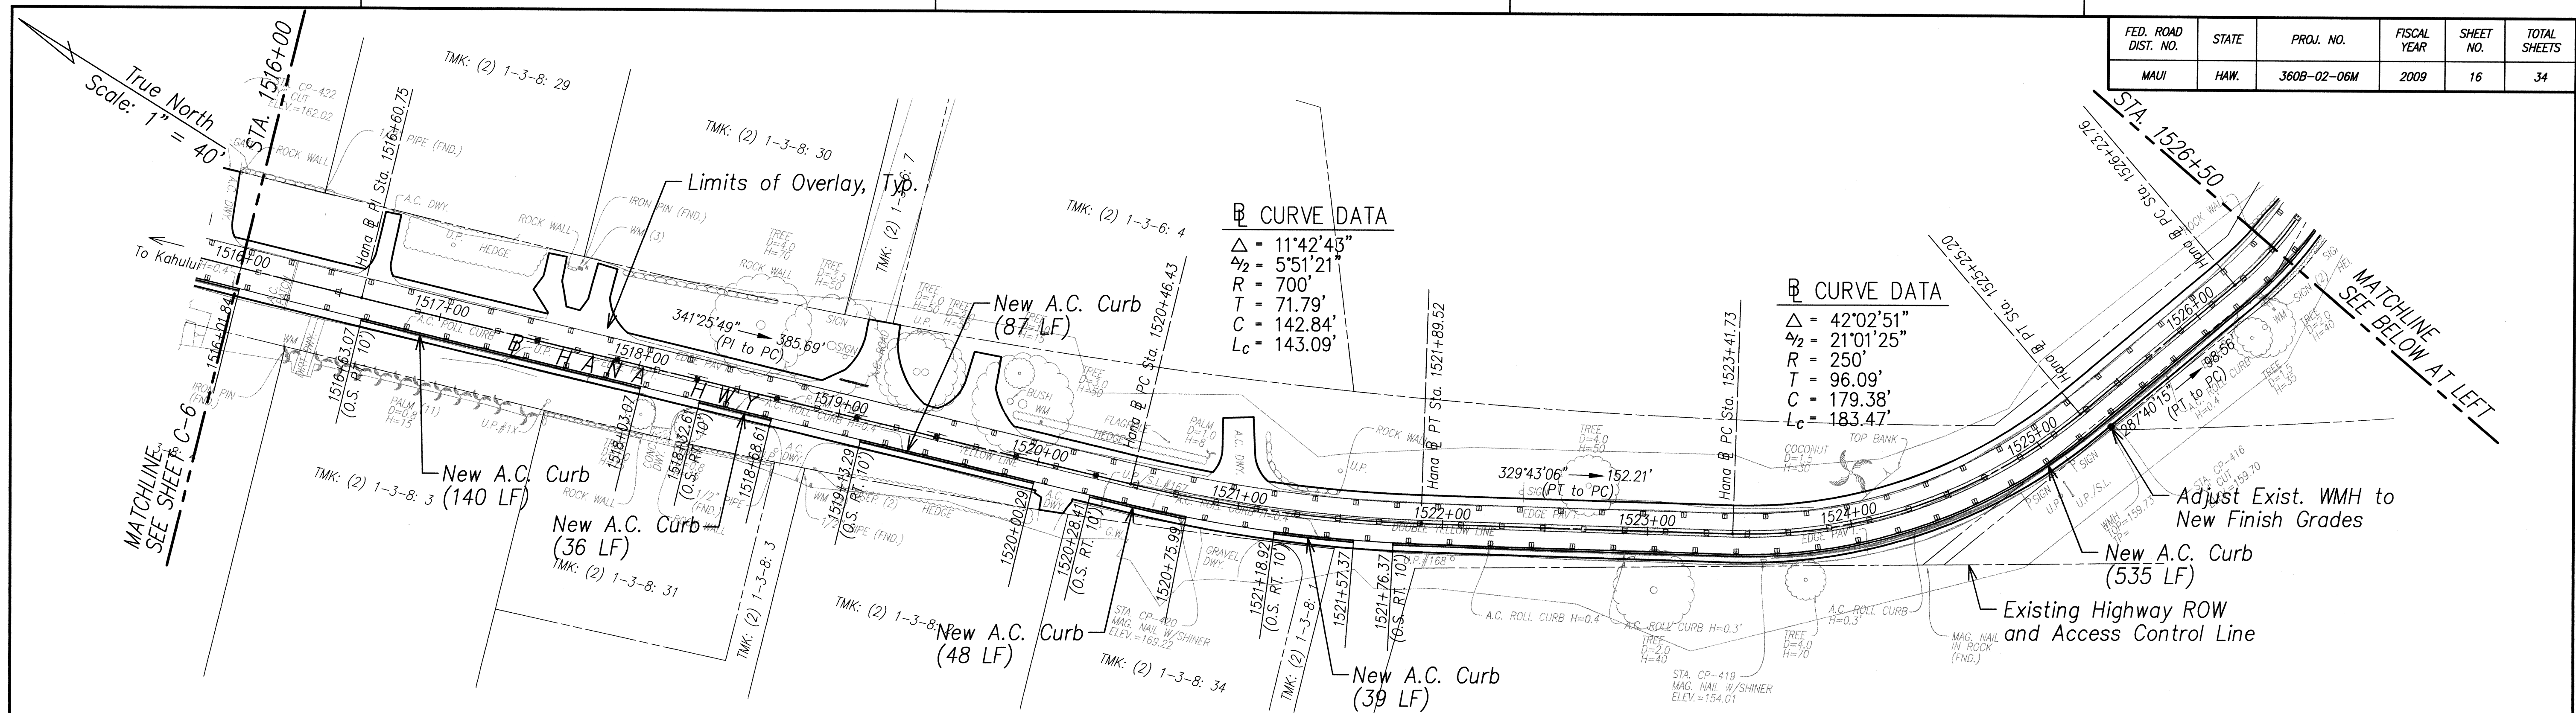

ROADWAY PLAN - 7 (B STA. 1516+00 TO B STA. 1526+50)

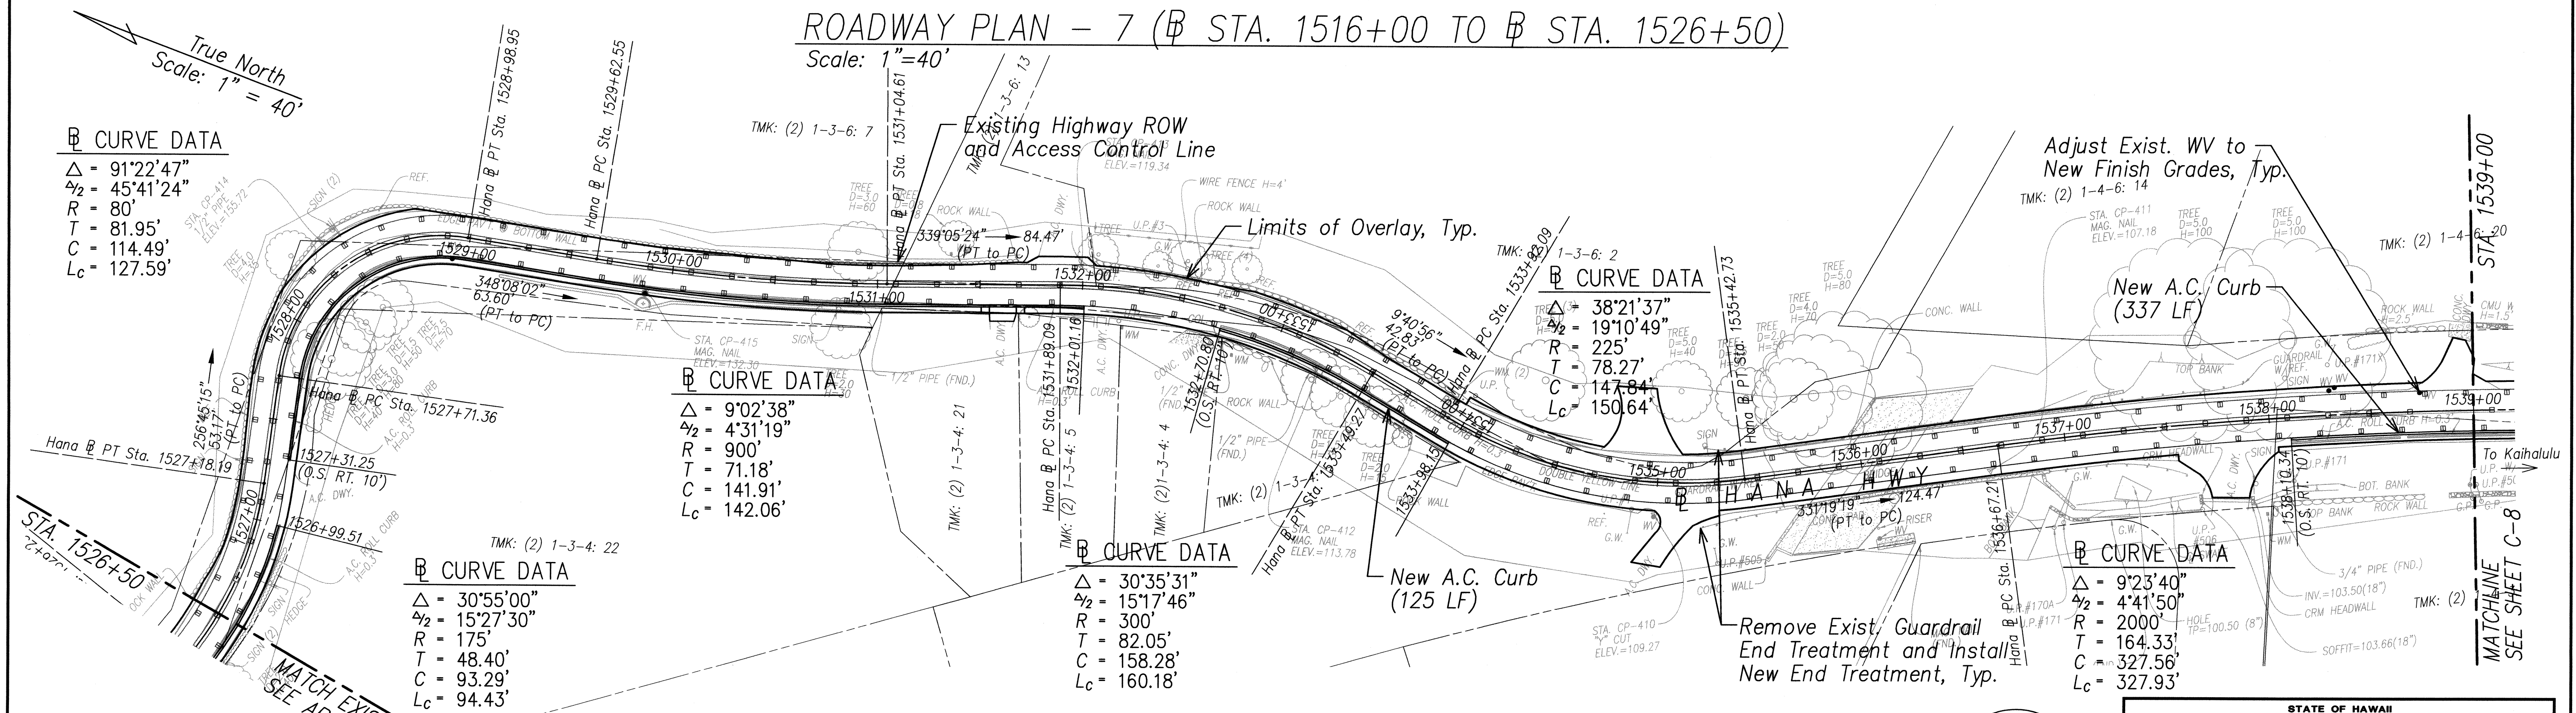

ROADWAY PLAN - 7 (B STA. 1526+50 TO B STA. 1539+00)

DATE	_____
SURVEY PLOTTED BY	_____
DRAWN BY	_____
DESIGNED BY	_____
CHECKED BY	_____
NOTE BOOK	_____
No.	_____

THIS WORK WAS PREPARED BY ME OR UNDER MY SUPERVISION

Scott A. Kunzika

SHIMABUKURO, ENDO & YOSHIZAKI, INC.
1126 12TH Avenue
Honolulu, Hawaii 96816

STATE OF HAWAII
DEPARTMENT OF TRANSPORTATION
HIGHWAYS DIVISION

ROADWAY PLAN 7


(B STA. 1516+00 TO B STA. 1539+00)




HANA HIGHWAY RESURFACING
Route 360, Kalahu to Hana
Project No. 360B-02-06M

Scale: 1" = 40'-0" Date: May 2009

SHEET No. C-7 OF C-12 SHEETS

16

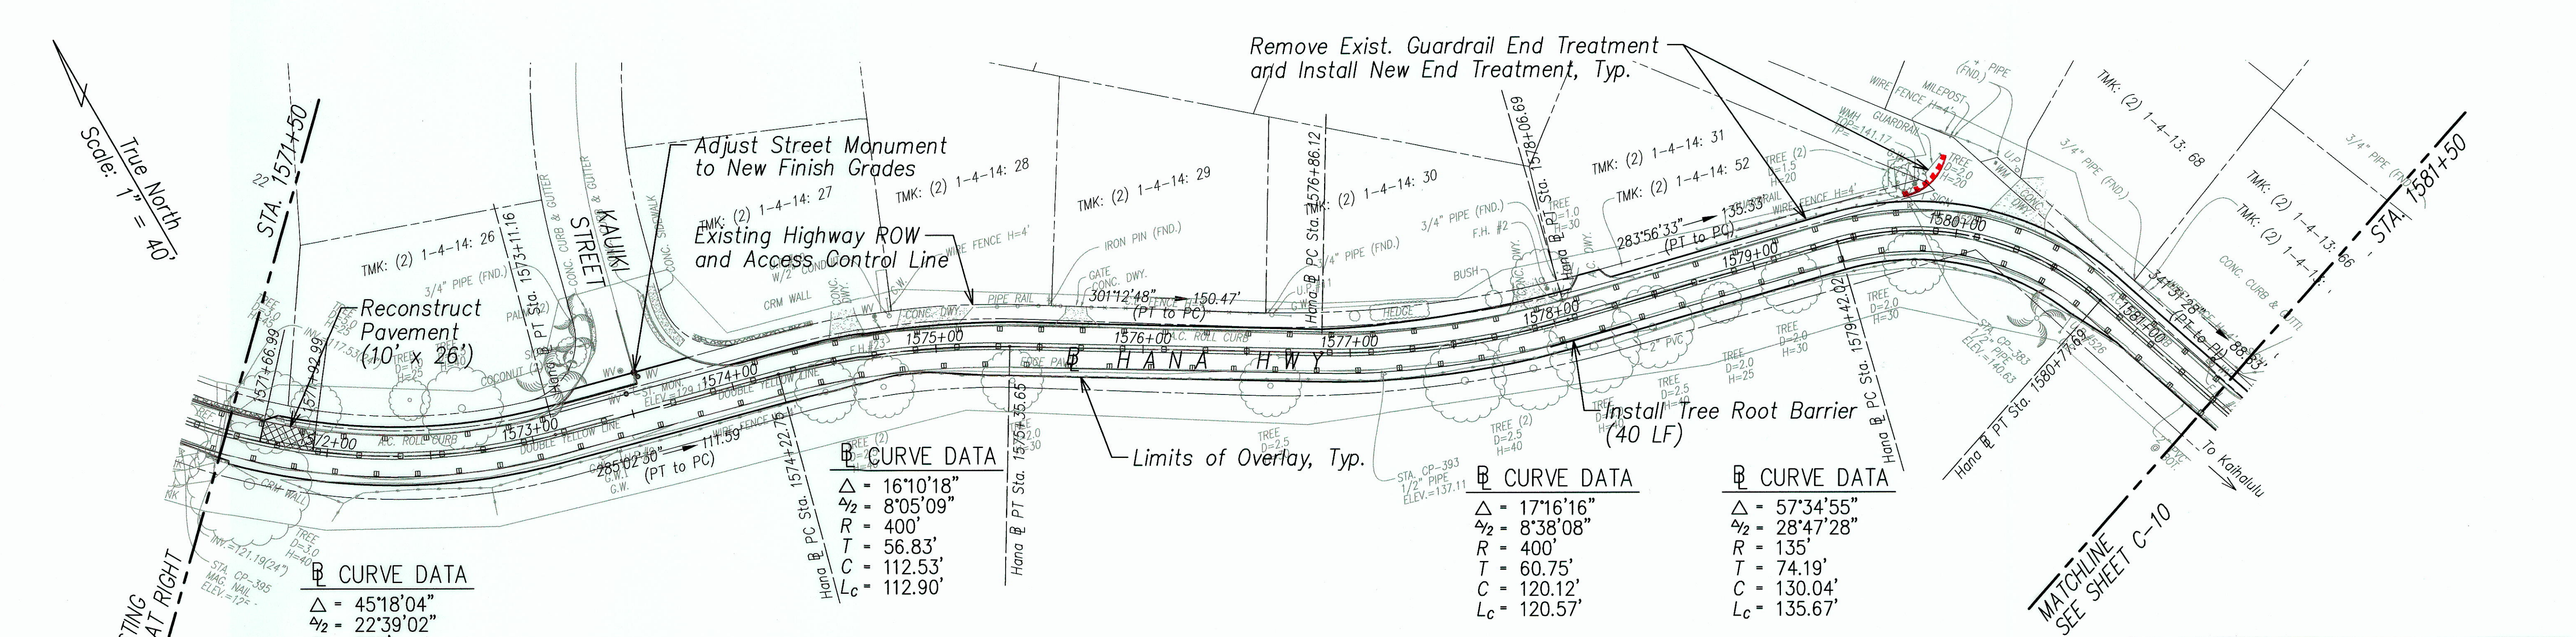

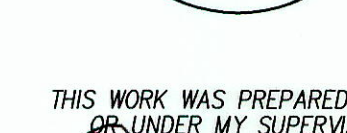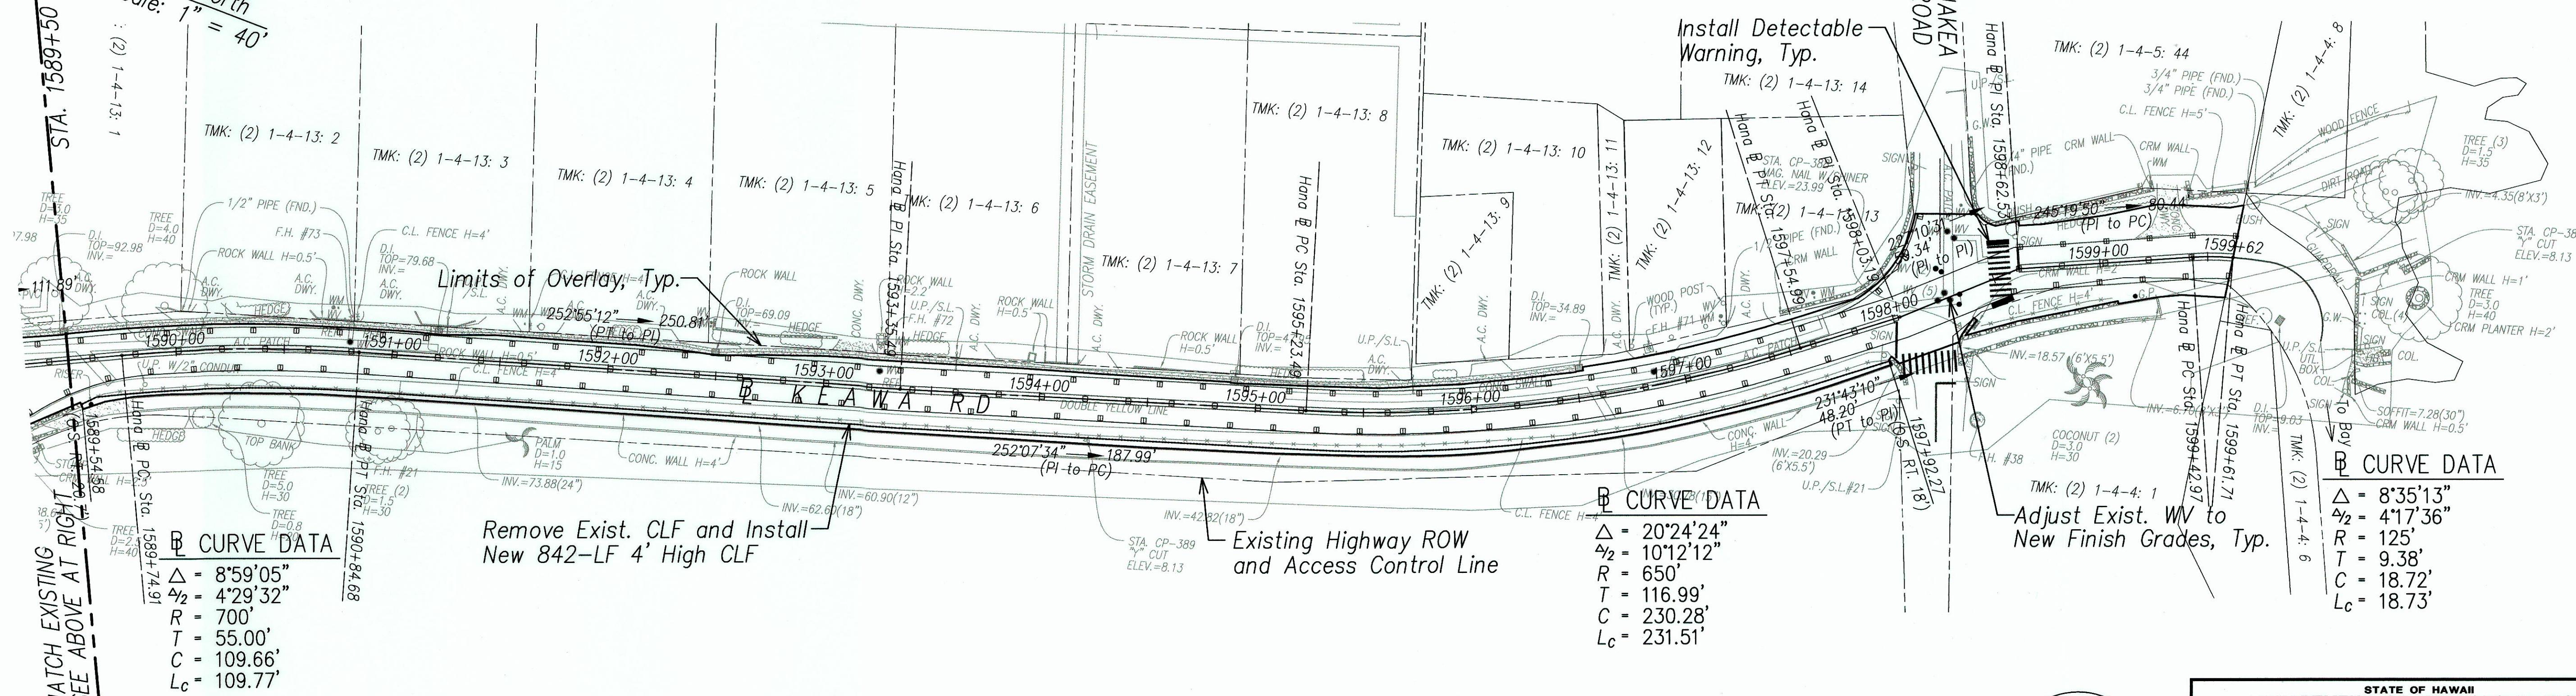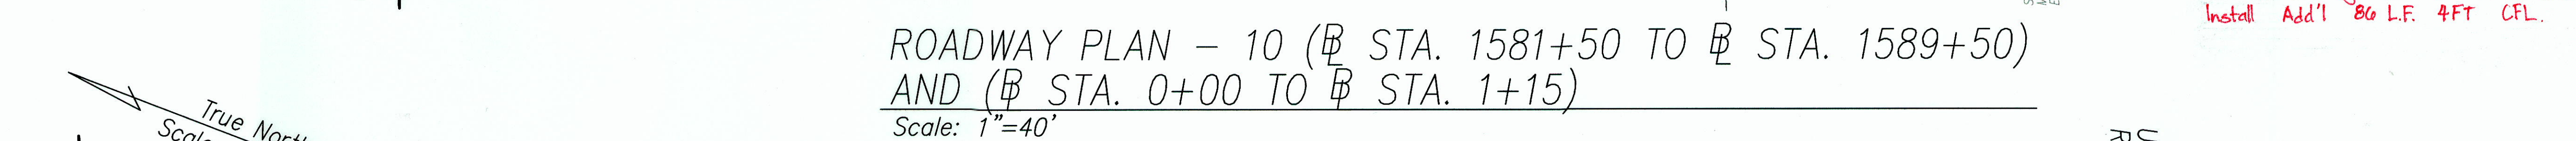[illegible]

--	--

SHEET No. C-10 OF C-12 SHEETS

19