
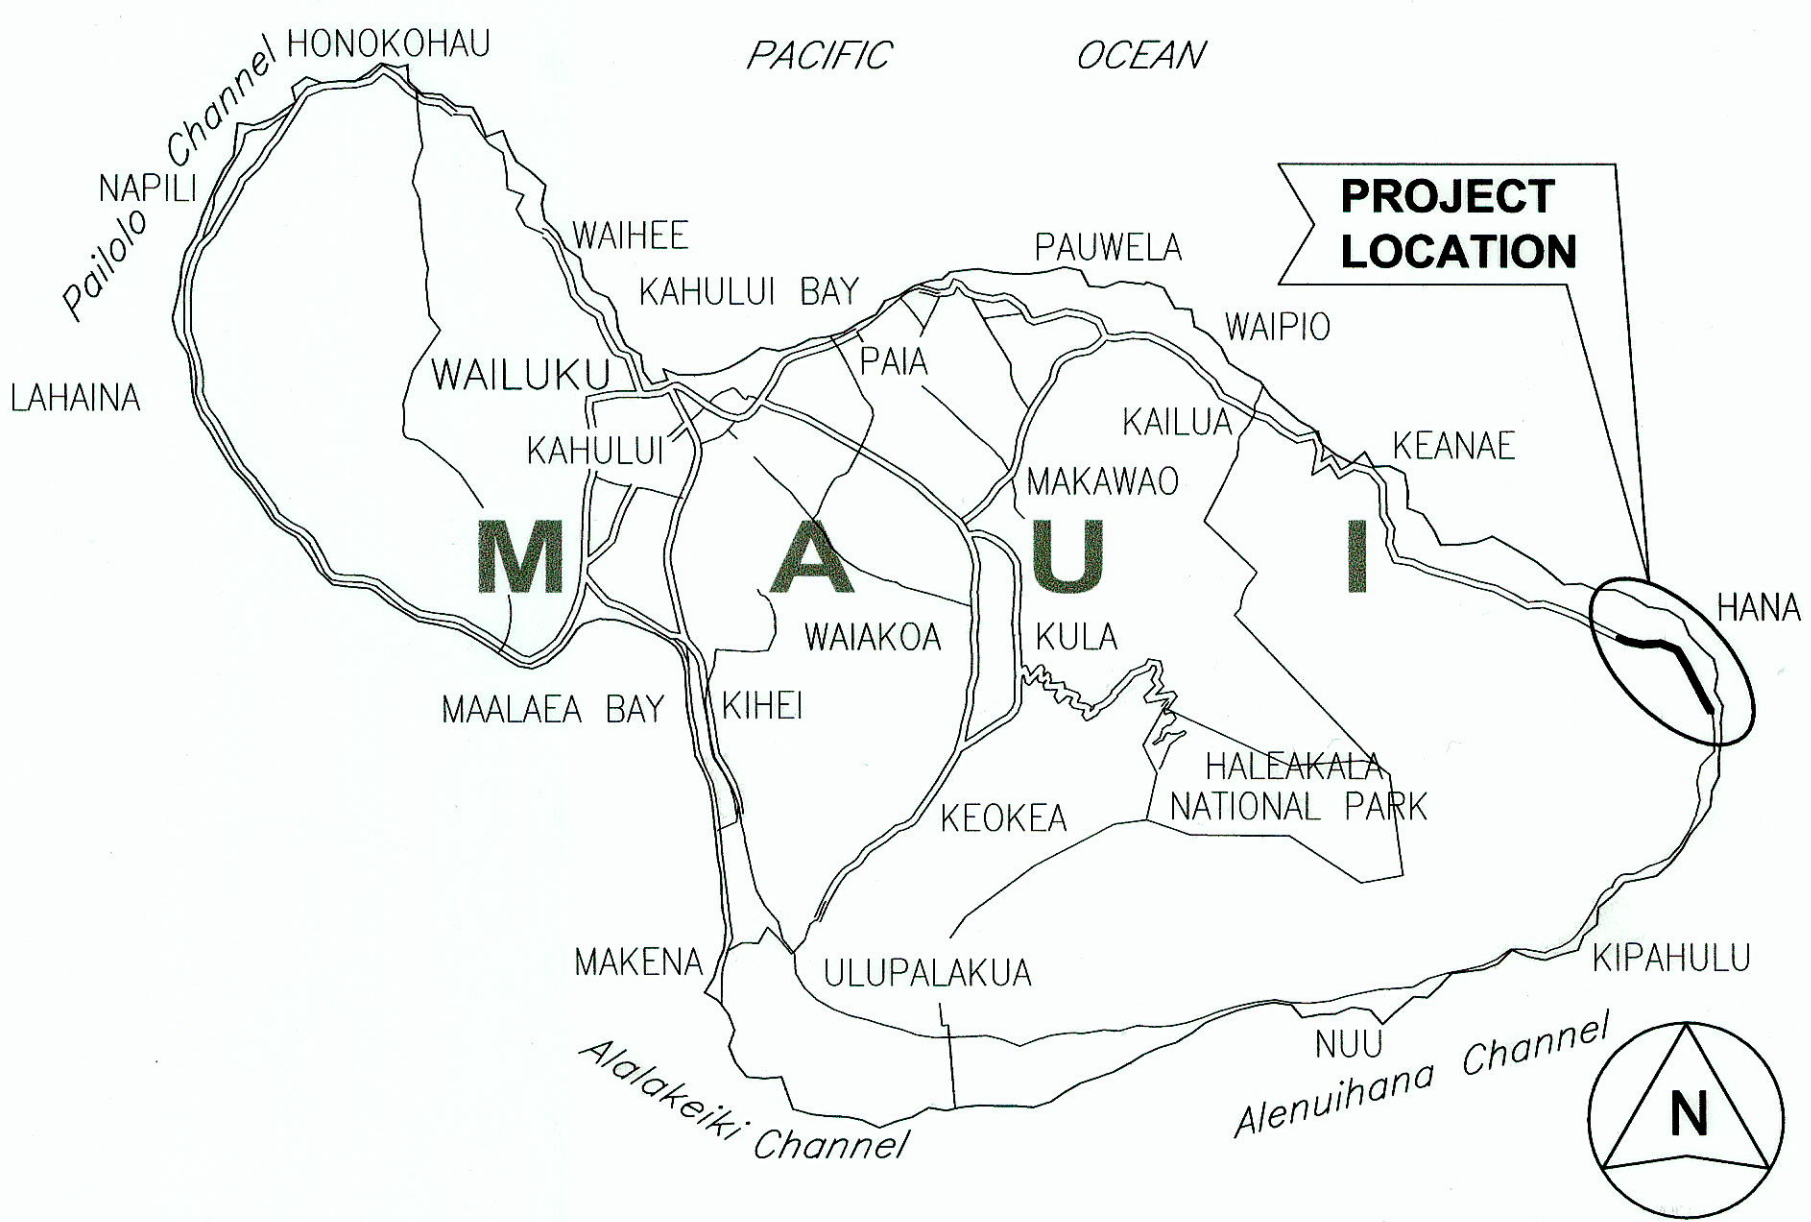


INDEX TO DRAWINGS	
SHEET NO.	DESCRIPTION
1	TITLE SHEET
2	STANDARD PLANS SUMMARY
3-6	GENERAL NOTES AND LEGEND
7-8	TYPICAL SECTIONS
9	GENERAL PLAN
10-19	ROADWAY PLANS
20	CURB RAMP & MISC. DETAIL
21	MISCELLANEOUS DETAILS
22-31	SIGNING AND STRIPING PLANS
32	STRIPING NOTES & LEGEND
33	WORK ZONE SIGNING PLAN, NOTES & DETAILS
34	SIGN SUMMARY


STATE OF HAWAII
DEPARTMENT OF TRANSPORTATION
HIGHWAYS DIVISION
HONOLULU, HAWAII
"AS-BUILT"
PLANS FOR
HANA HIGHWAY RESURFACING

KALAHU TO HANA BAY
PROJECT NO. 360B-02-06M
DISTRICT OF HANA
ISLAND OF MAUI

FED. ROAD DIST. NO.	STATE	PROJ. NO.	FISCAL YEAR	SHEET NO.	TOTAL SHEETS
MAUI	HAW.	360B-02-06M	2009	1	34

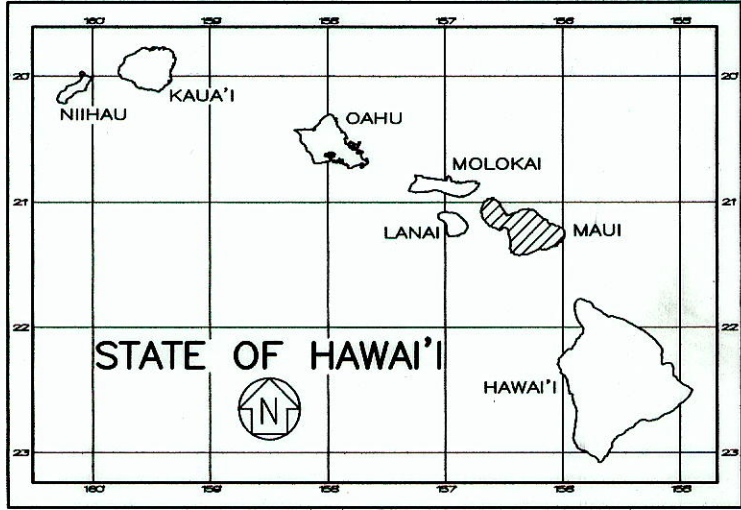

ISLAND OF MAUI
NOT TO SCALE

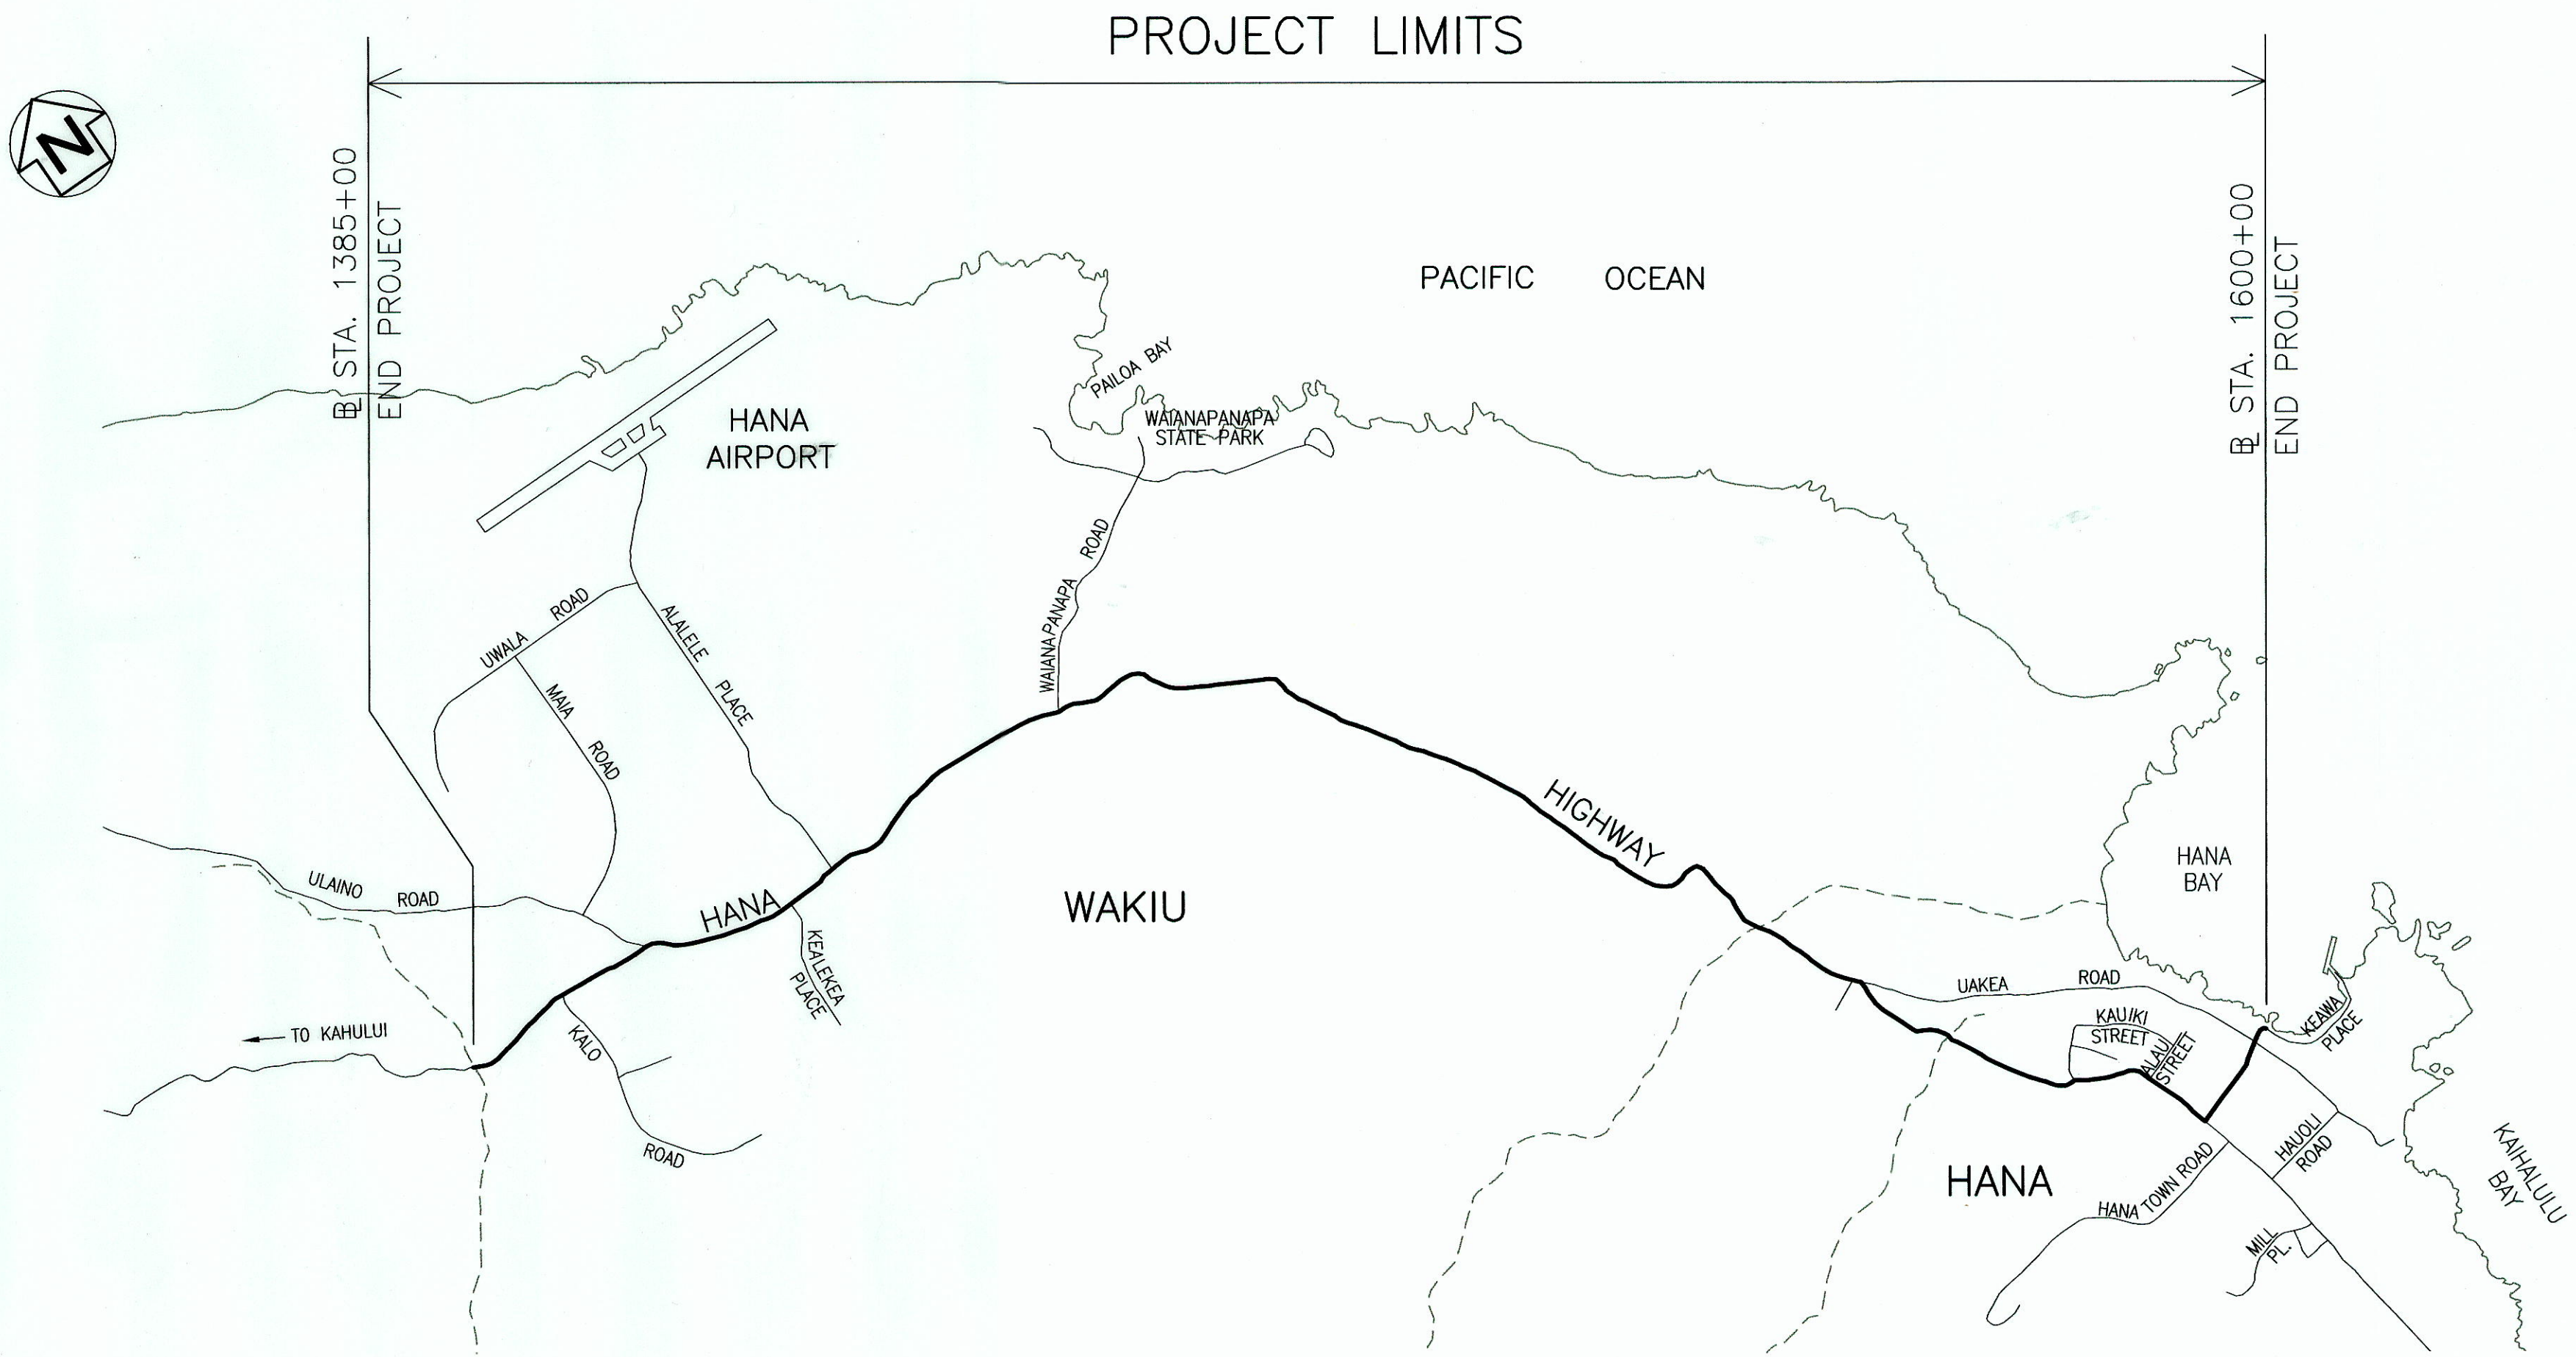

LAYOUT PLAN
GROSS LENGTH OF PROJECT.....4.00 MILES
NET LENGTH OF PROJECT.....4.00 MILES

CHANGES MADE DURING CONSTRUCTION HAVE BEEN INCORPORATED ON THESE PLANS EXCEPT CHANGES IN THE ORIGINAL THEORETICAL QUANTITIES. FOR ACTUAL QUANTITIES, REFER TO PROJECT LEDGER AND/OR COMPUTATION BOOK.

Blamm 9/17/13
RESIDENT ENGINEER DATE

DEPARTMENT OF TRANSPORTATION
STATE OF HAWAII
APPROVED:
for [Signature] 5-18-09
DIR. OF TRANSPORTATION DATE

SURVEY PLOTTED BY	DATE
DRAWN BY	DATE
DESIGNED BY	DATE
CHECKED BY	DATE

SHIMABUKURO, ENDO & YOSHIZAKI, INC. FERDINAND CAJIGAL 873-3535 MAY 2009
DESIGNED BY MANAGED BY PHONE DATE