



FED. ROAD DIST. NO.	STATE	PROJ. NO.	FISCAL YEAR	SHEET NO.	TOTAL SHEETS
HAWAII	HAW.	360B-01-09M	2009	8	21

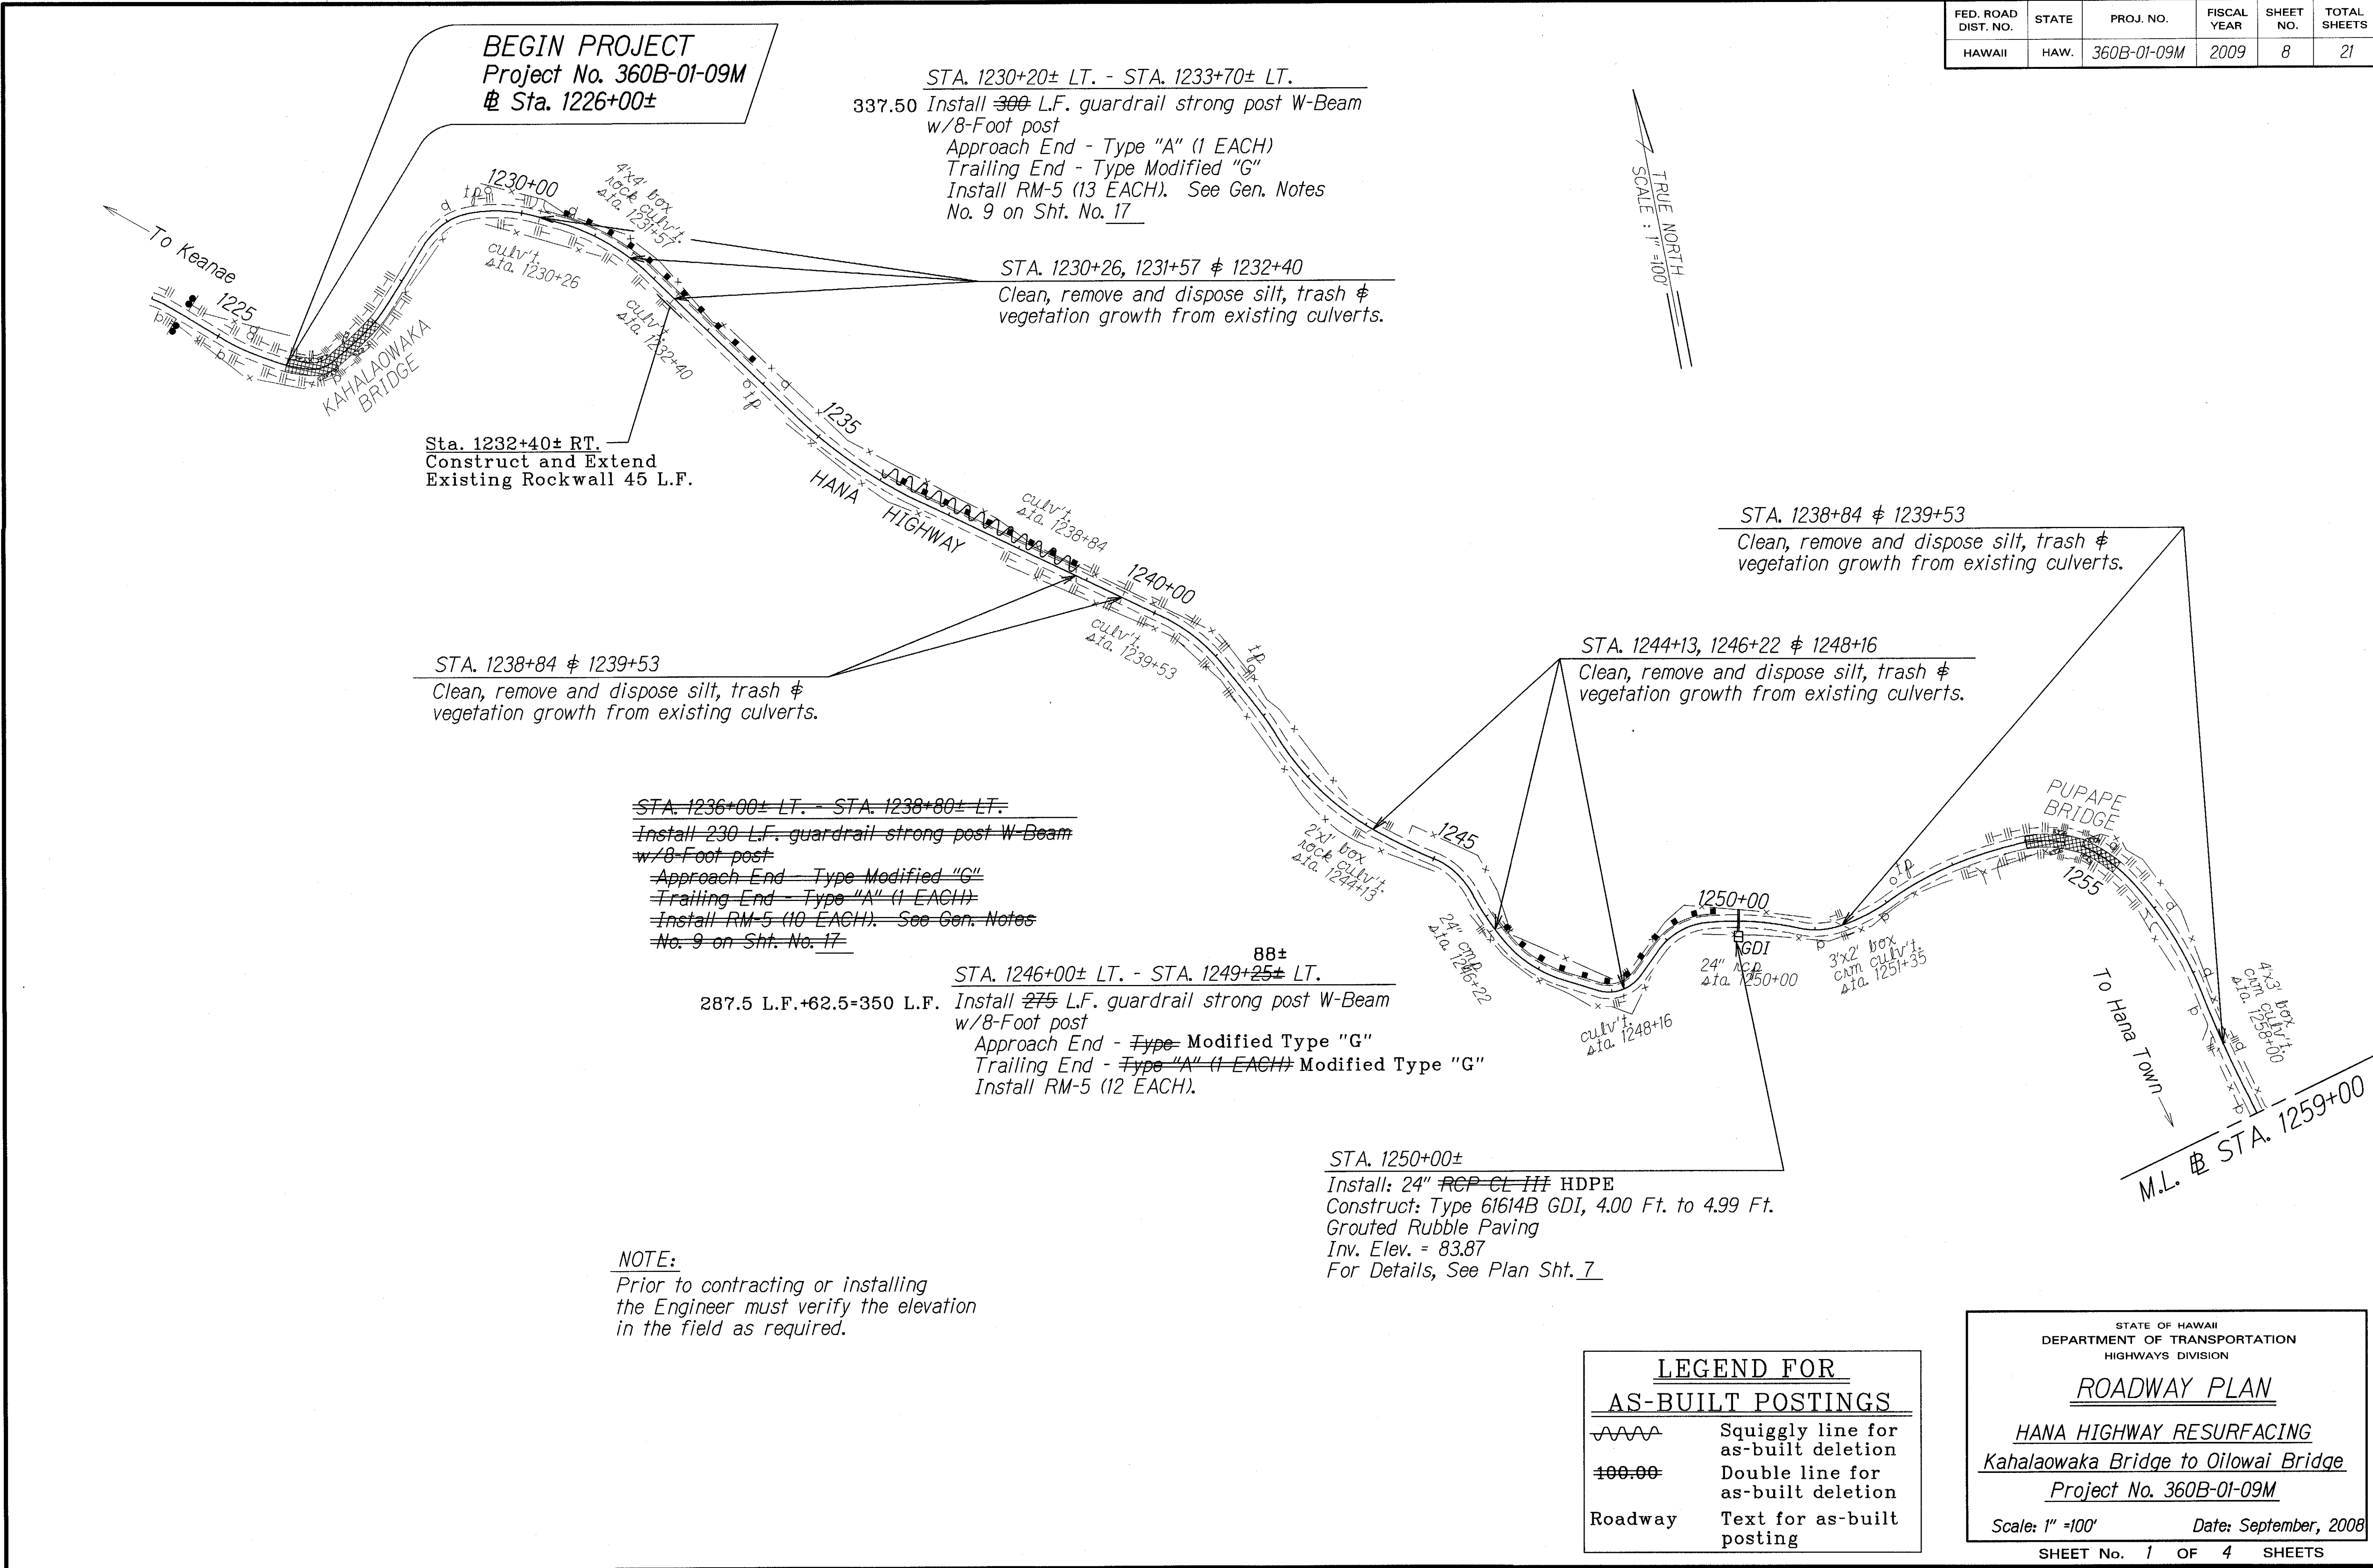

"AS-BUILT"

FED. ROAD DIST. NO.	STATE	PROJ. NO.	FISCAL YEAR	SHEET NO.	TOTAL SHEETS
HAWAII	HAW.	360B-01-09M	2009	9	21

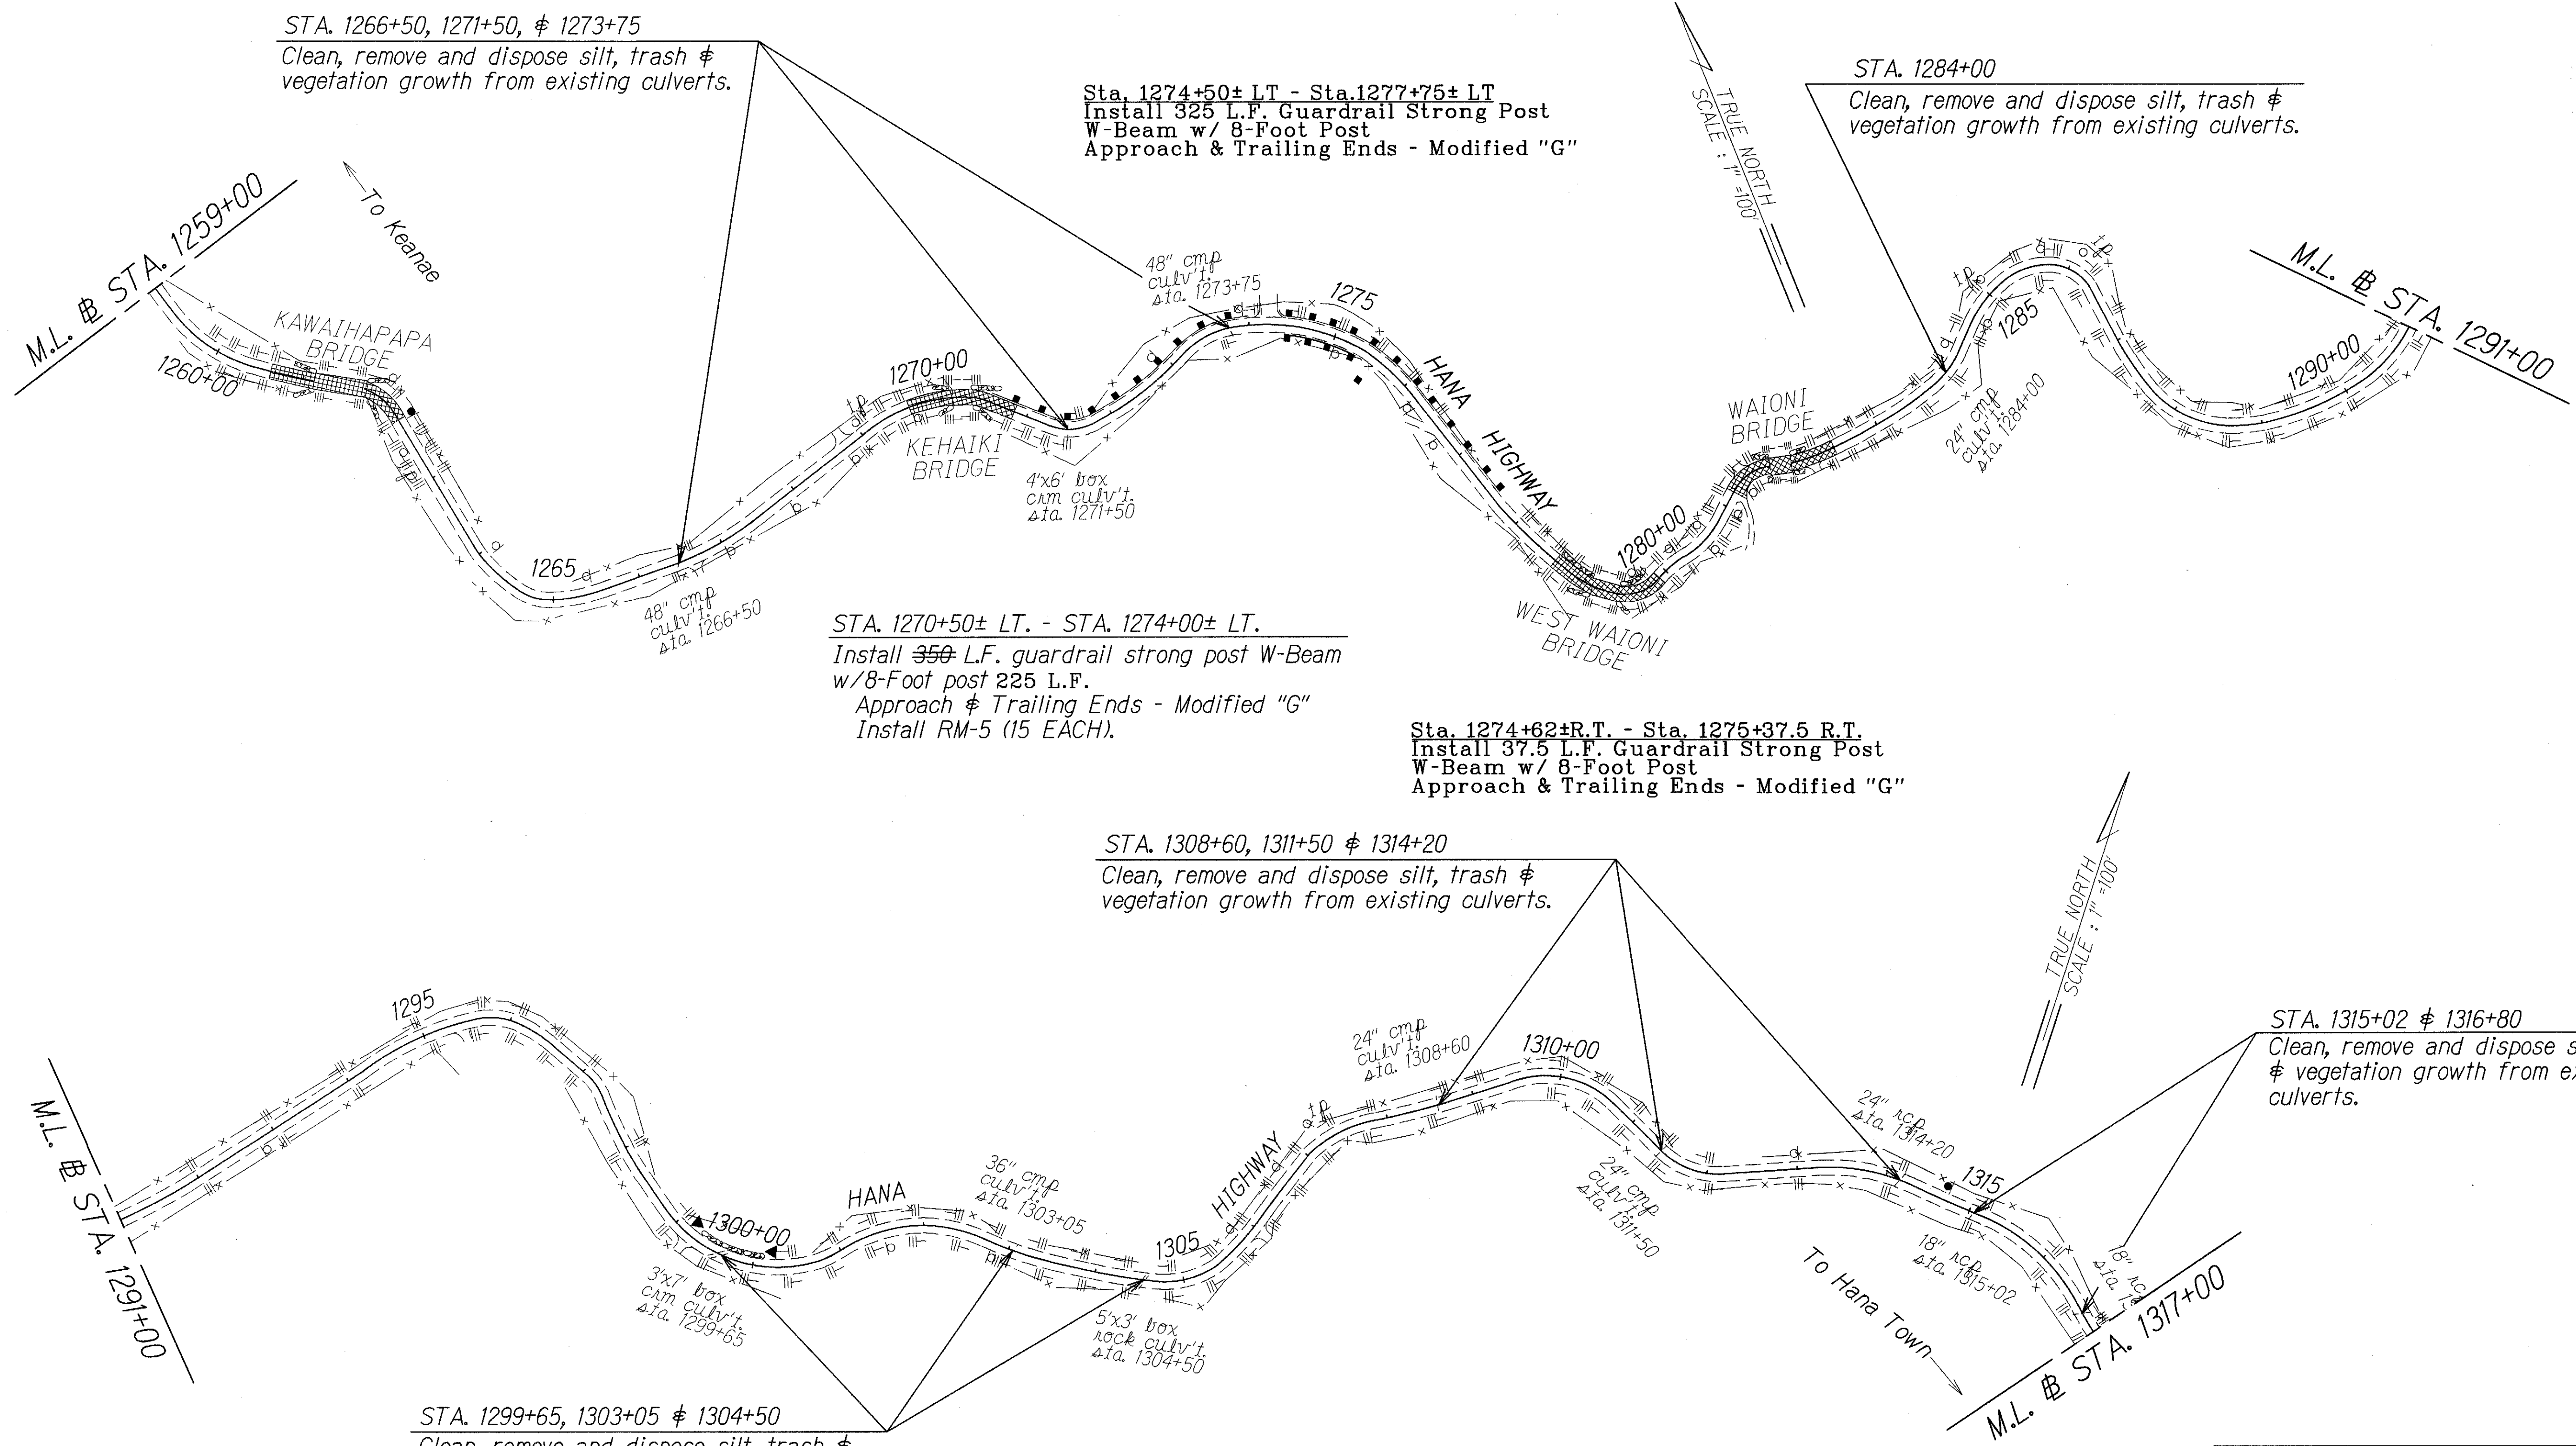

LEGEND FOR AS-BUILT POSTINGS	
	Squiggly line for as-built deletion
	Double line for as-built deletion
Roadway	Text for as-built posting

STATE OF HAWAII
DEPARTMENT OF TRANSPORTATION
HIGHWAYS DIVISION

ROADWAY PLAN

HANA HIGHWAY RESURFACING
Kahalaowaka Bridge to Oilowai Bridge
Project No. 360B-01-09M


Scale: 1" = 100' Date: September, 2008

SHEET No. 2 OF 4 SHEETS

ORIGINAL PLAN	DATE
DRAWN BY	09/08
CHECKED BY	
NOTED BY	
QUANTITIES BY	
CHECKED BY	


"AS-BUILT"

FED. ROAD DIST. NO.	STATE	PROJ. NO.	FISCAL YEAR	SHEET NO.	TOTAL SHEETS
HAWAII	HAW.	360B-01-09M	2008	10	21

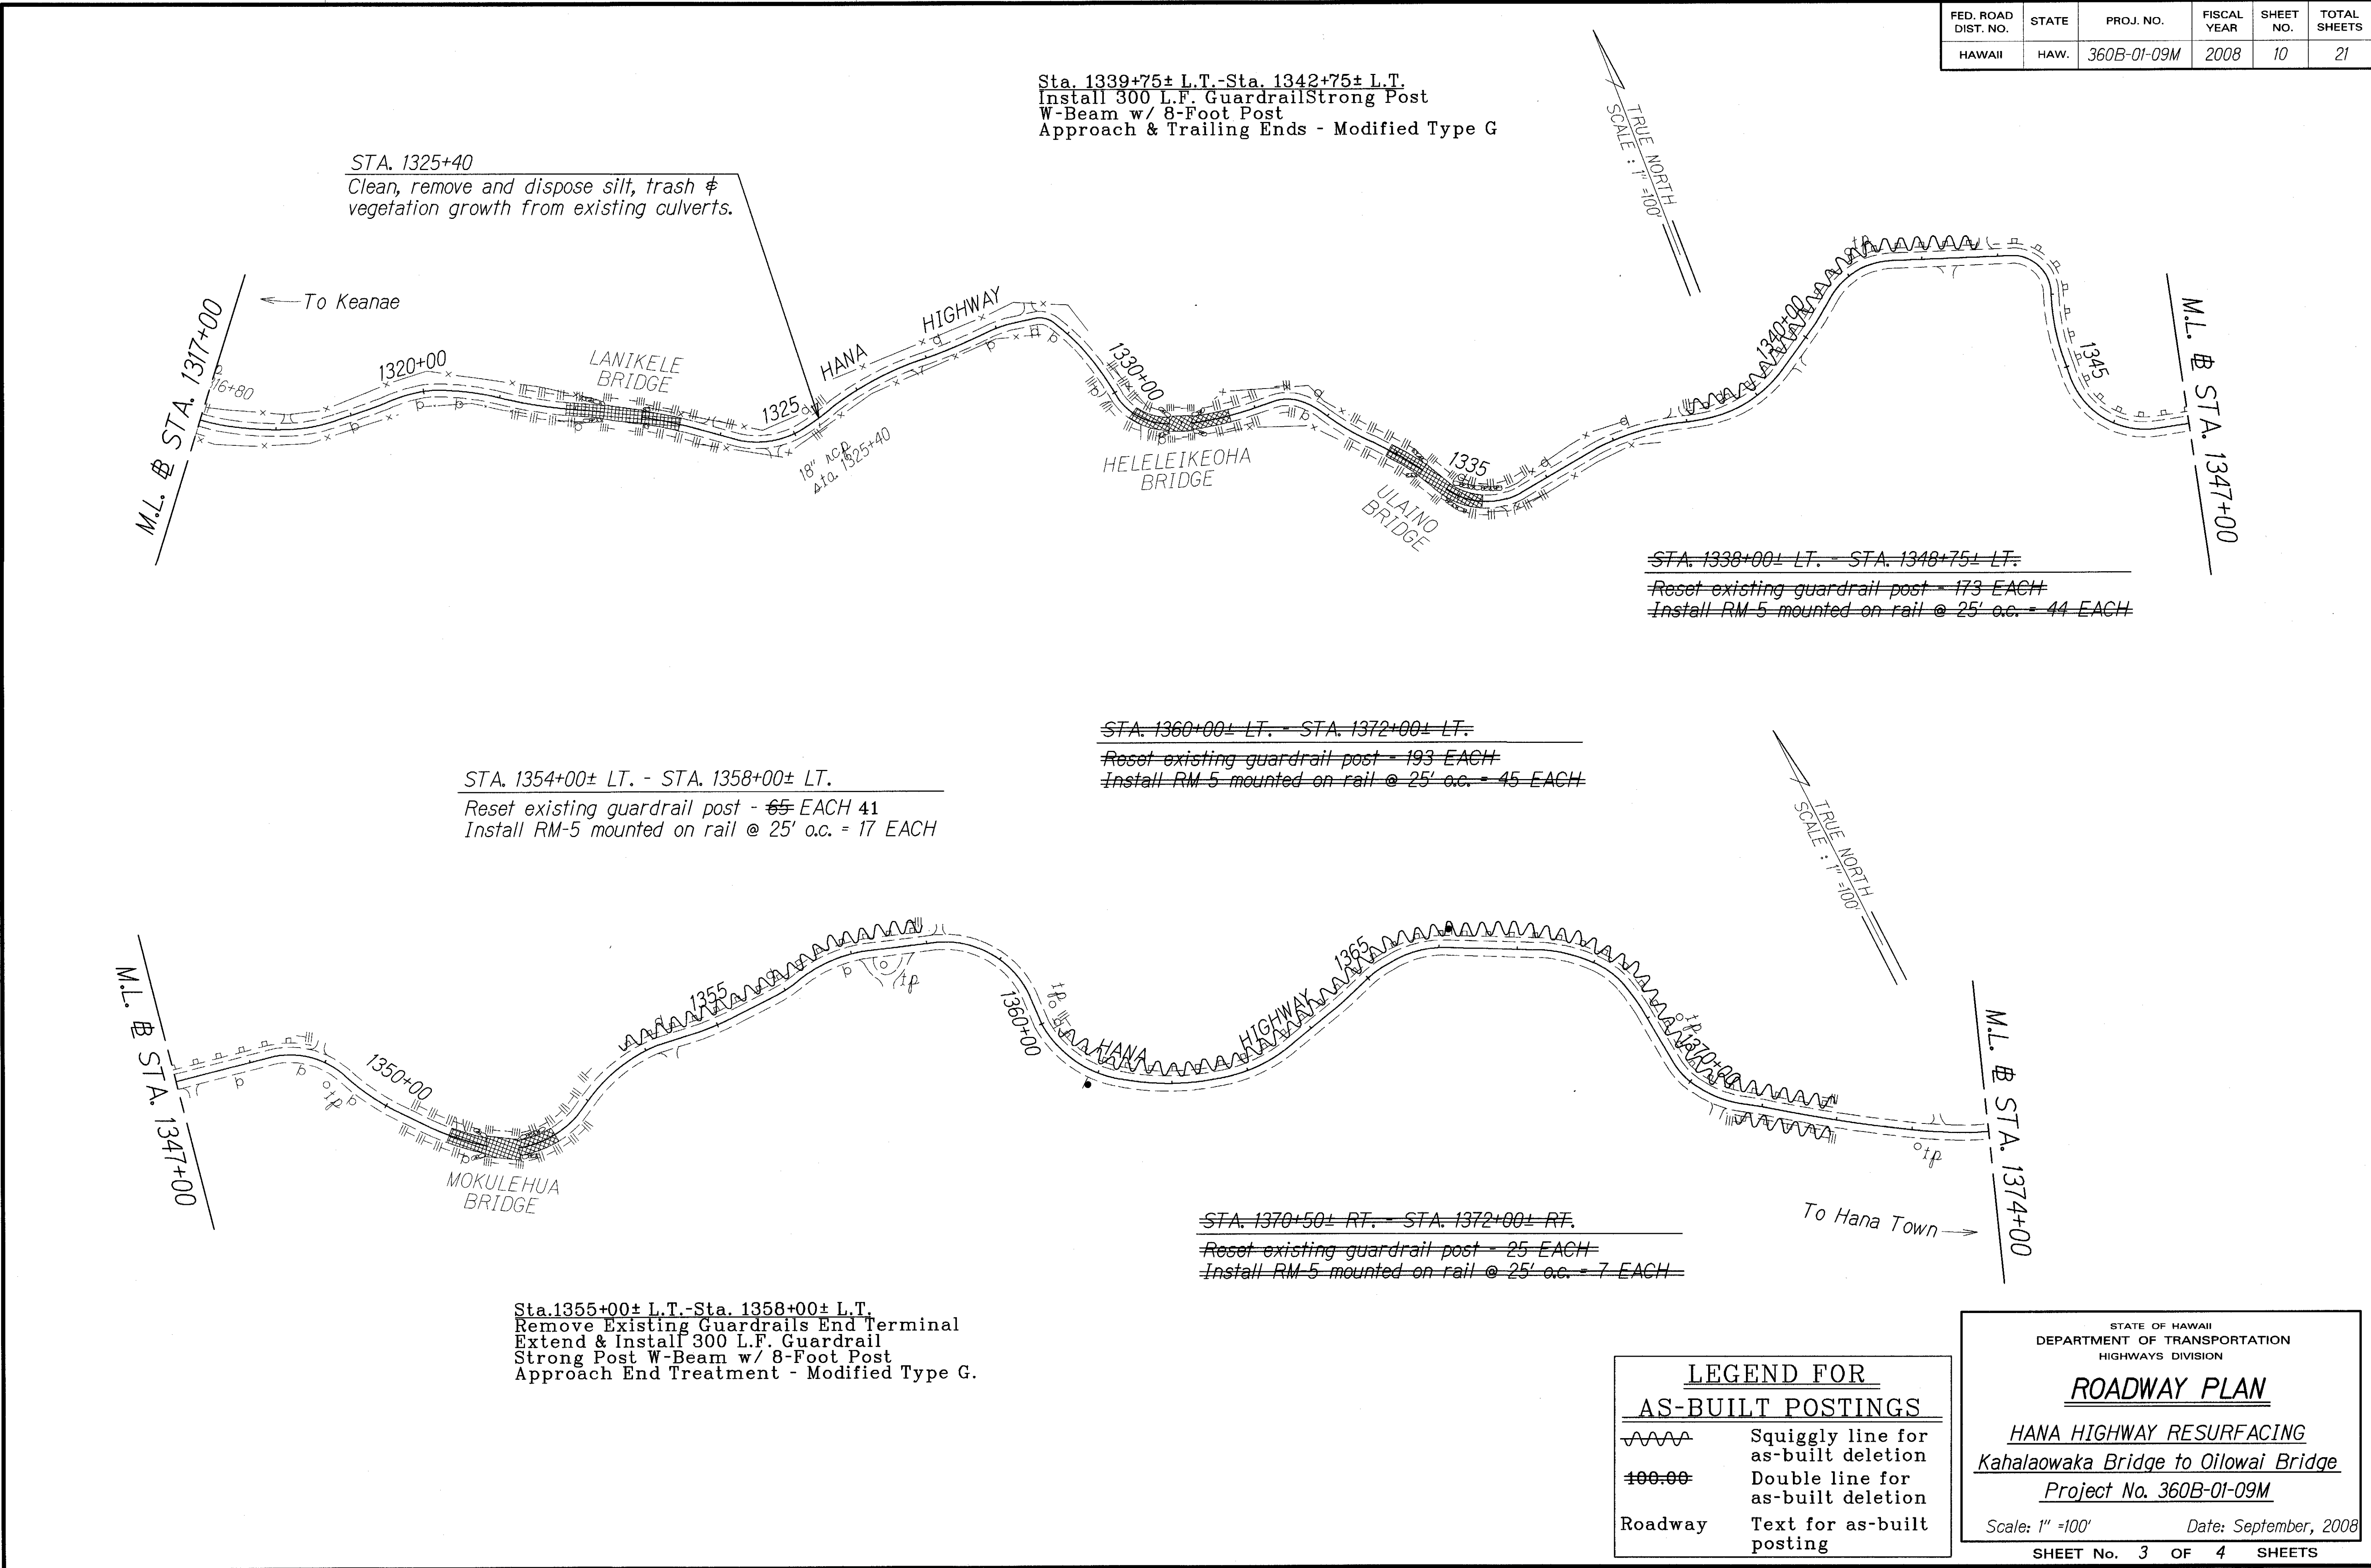

"AS-BUILT"

FED. ROAD DIST. NO.	STATE	PROJ. NO.	FISCAL YEAR	SHEET NO.	TOTAL SHEETS
HAWAII	HAW.	360B-01-09M	2008	11	21

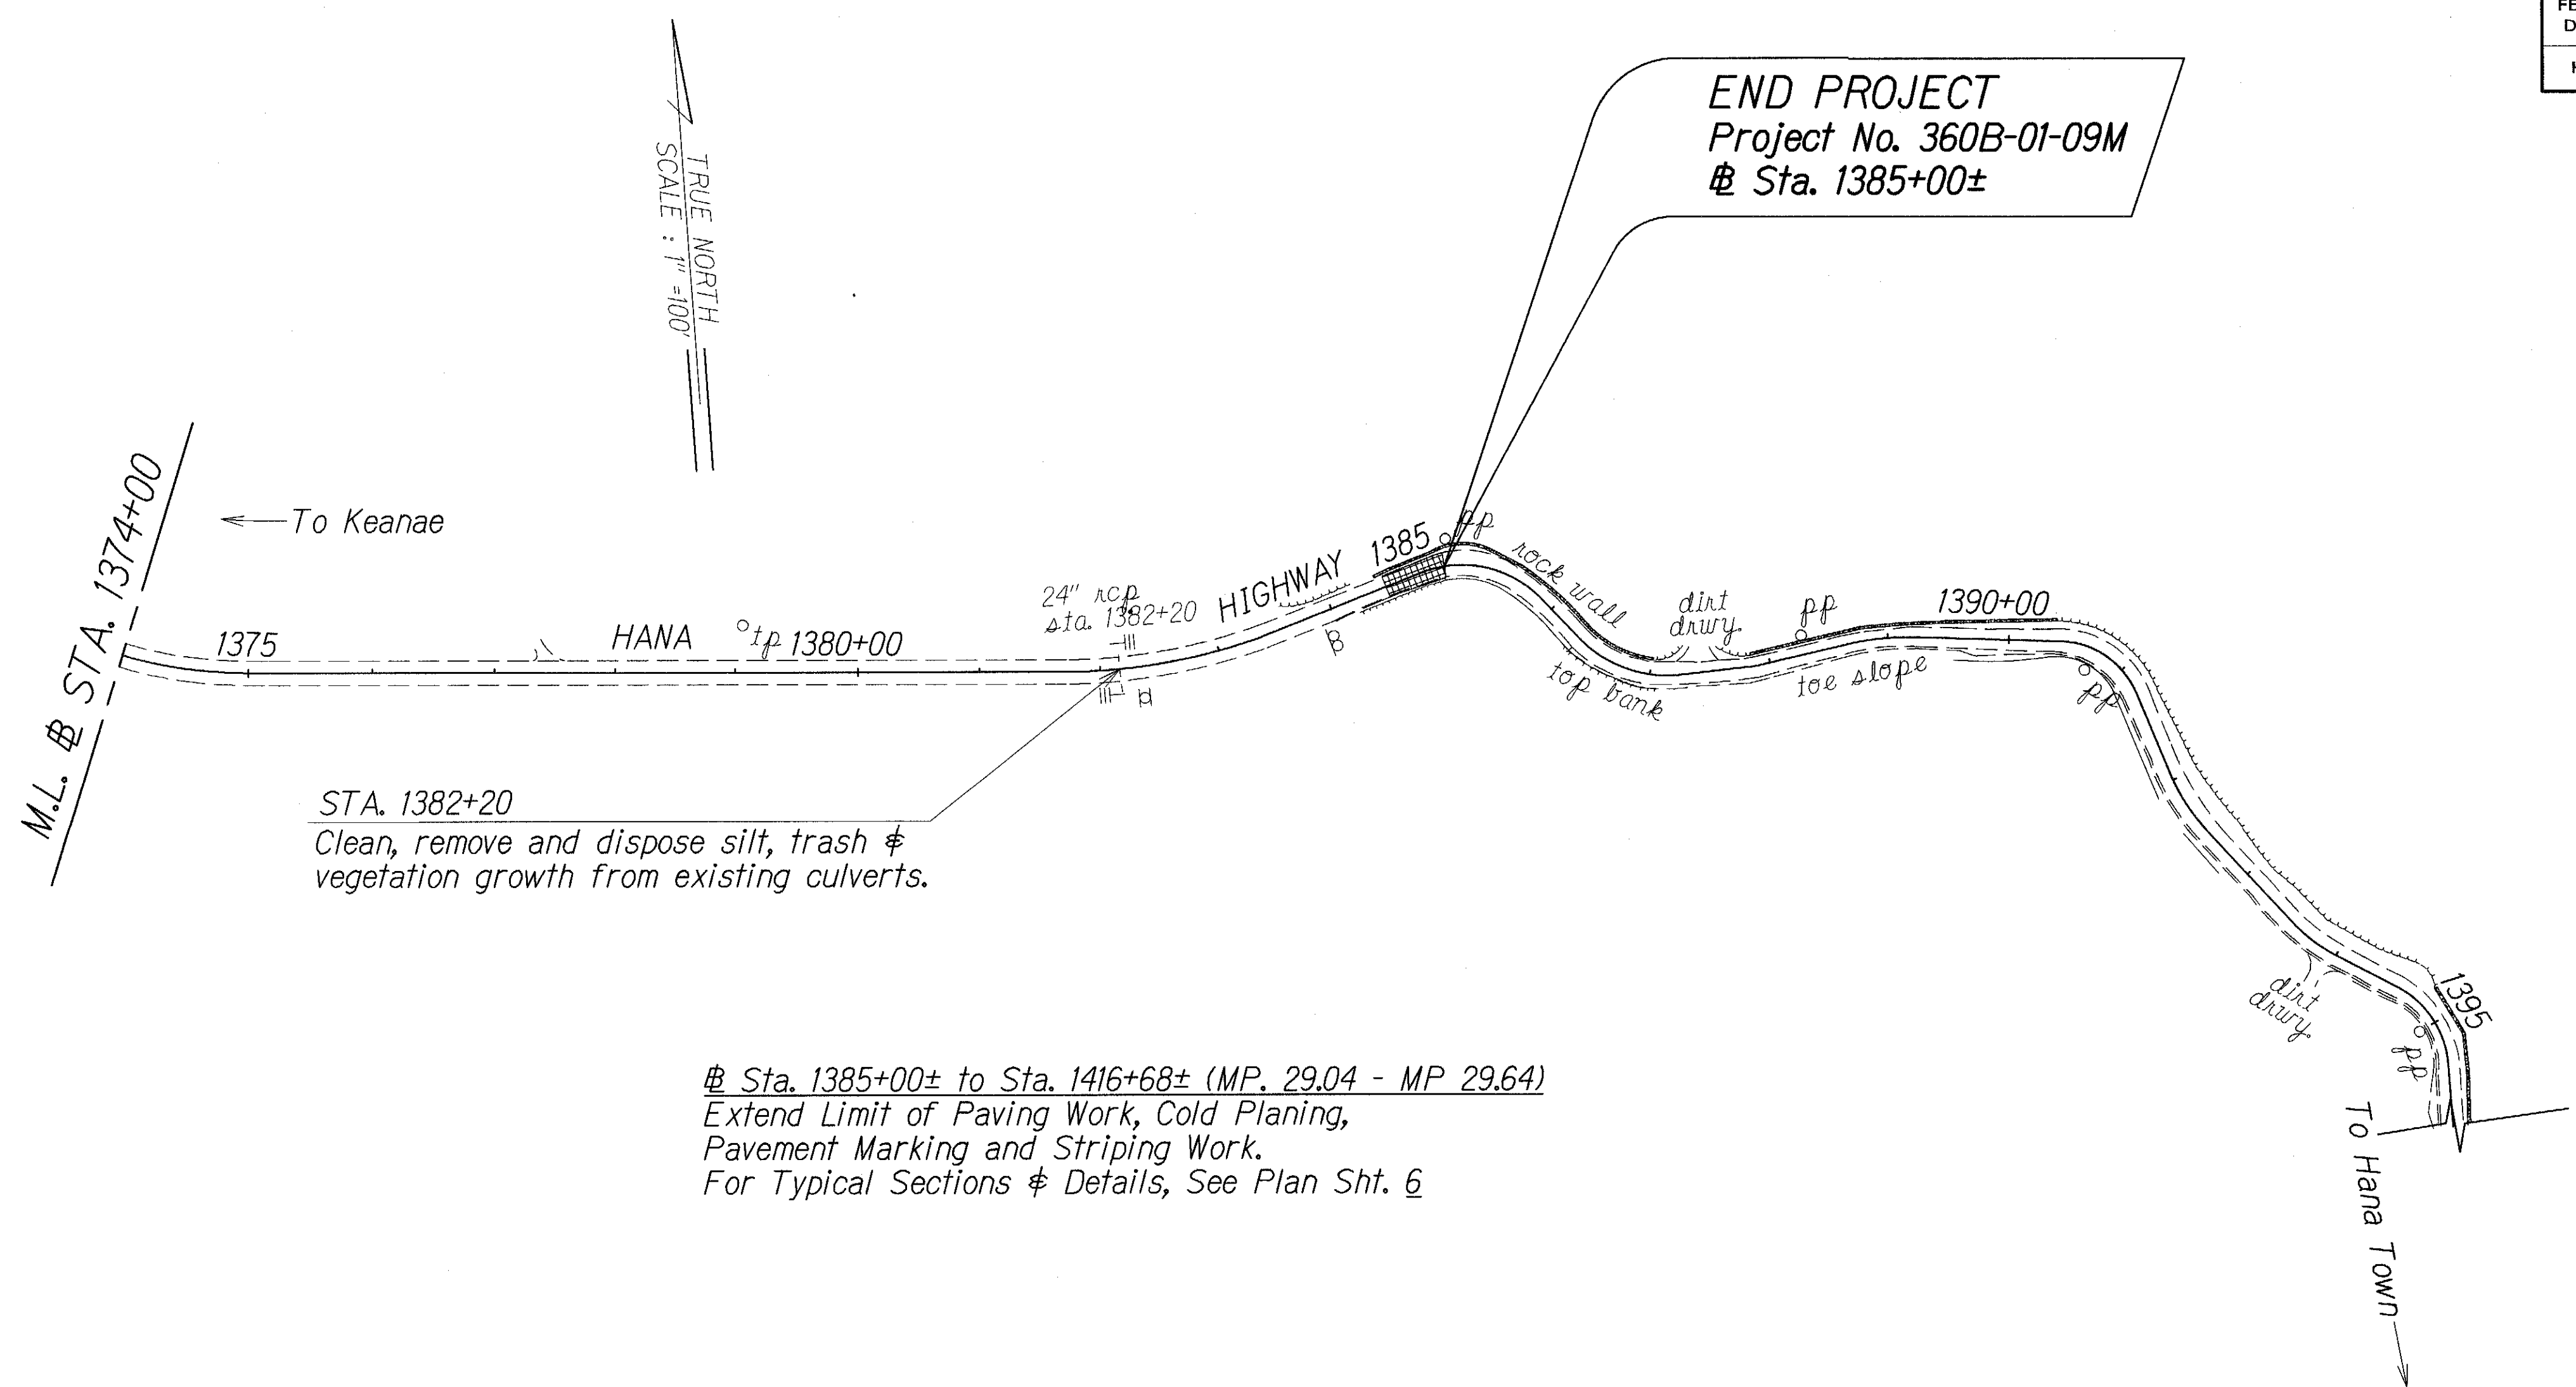

@ Sta. 1385+00± to Sta. 1416+68± (MP. 29.04 - MP 29.64)
Extend Limit of Paving Work, Cold Planing,
Pavement Marking and Striping Work.
For Typical Sections & Details, See Plan Sht. 6

ORIGINAL PLAN	SURVEY PLOTTED BY	DATE
NOTE BOOK	DRAWN BY	02/08
QUANTITIES BY	DESIGNED BY	
CHECKED BY	CHECKED BY	

LEGEND FOR AS-BUILT POSTINGS	
	Squiggly line for as-built deletion
	Double line for as-built deletion
Roadway	Text for as-built posting

STATE OF HAWAII
DEPARTMENT OF TRANSPORTATION
HIGHWAYS DIVISION

ROADWAY PLAN

HANA HIGHWAY RESURFACING
Kahalaowaka Bridge to Olowai Bridge
Project No. 360B-01-09M

Scale: 1" = 100' Date: September, 2008

SHEET No. 4 OF 4 SHEETS

"AS-BUILT"